


PROFILE

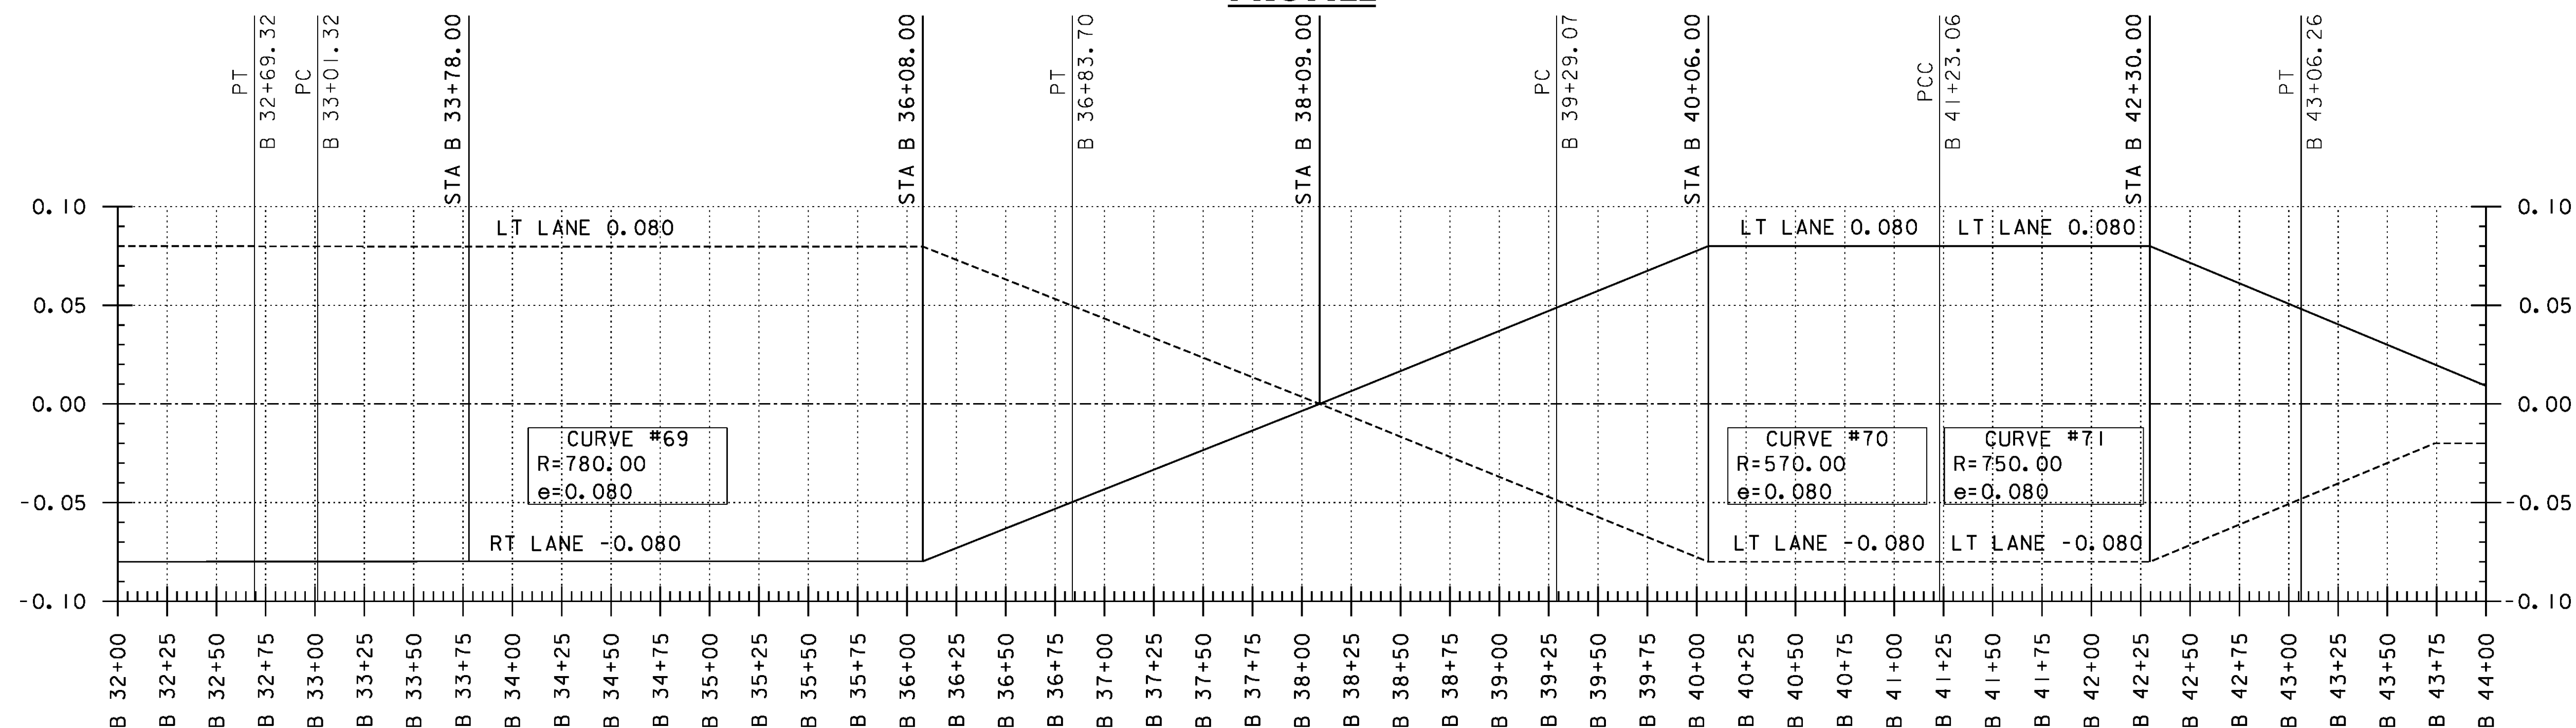

BANKING DIAGRAM

THE GRADES SHOWN TO THE NEAREST TENTH OF A FOOT ARE THE ORIGINAL GROUND ELEVATIONS ALONG THE PROPOSED ALIGNMENT. THE GRADES SHOWN TO THE NEAREST HUNDRETH OF A FOOT ARE FINISH GRADES FOR THE PROPOSED ALIGNMENT. SUPERELEVATIONS ARE SHOWN IN PERCENTAGES.

PROJECT NAME:	WARDSBORO-JAMAICA
PROJECT NUMBER:	ER STP 013-K(17)
FILE NAME:	d12b236_pro_bnk
PROJECT LEADER:	K. UPMAL
DESIGNED BY:	B. KIPP
VT 100 PROFILE & BANKING DIAGRAM	
PLOT DATE:	2/26/2014
DRAWN BY:	B. KIPP
CHECKED BY:	A. KEMPTON
SHEET	124 OF 444