


**PROFILE**

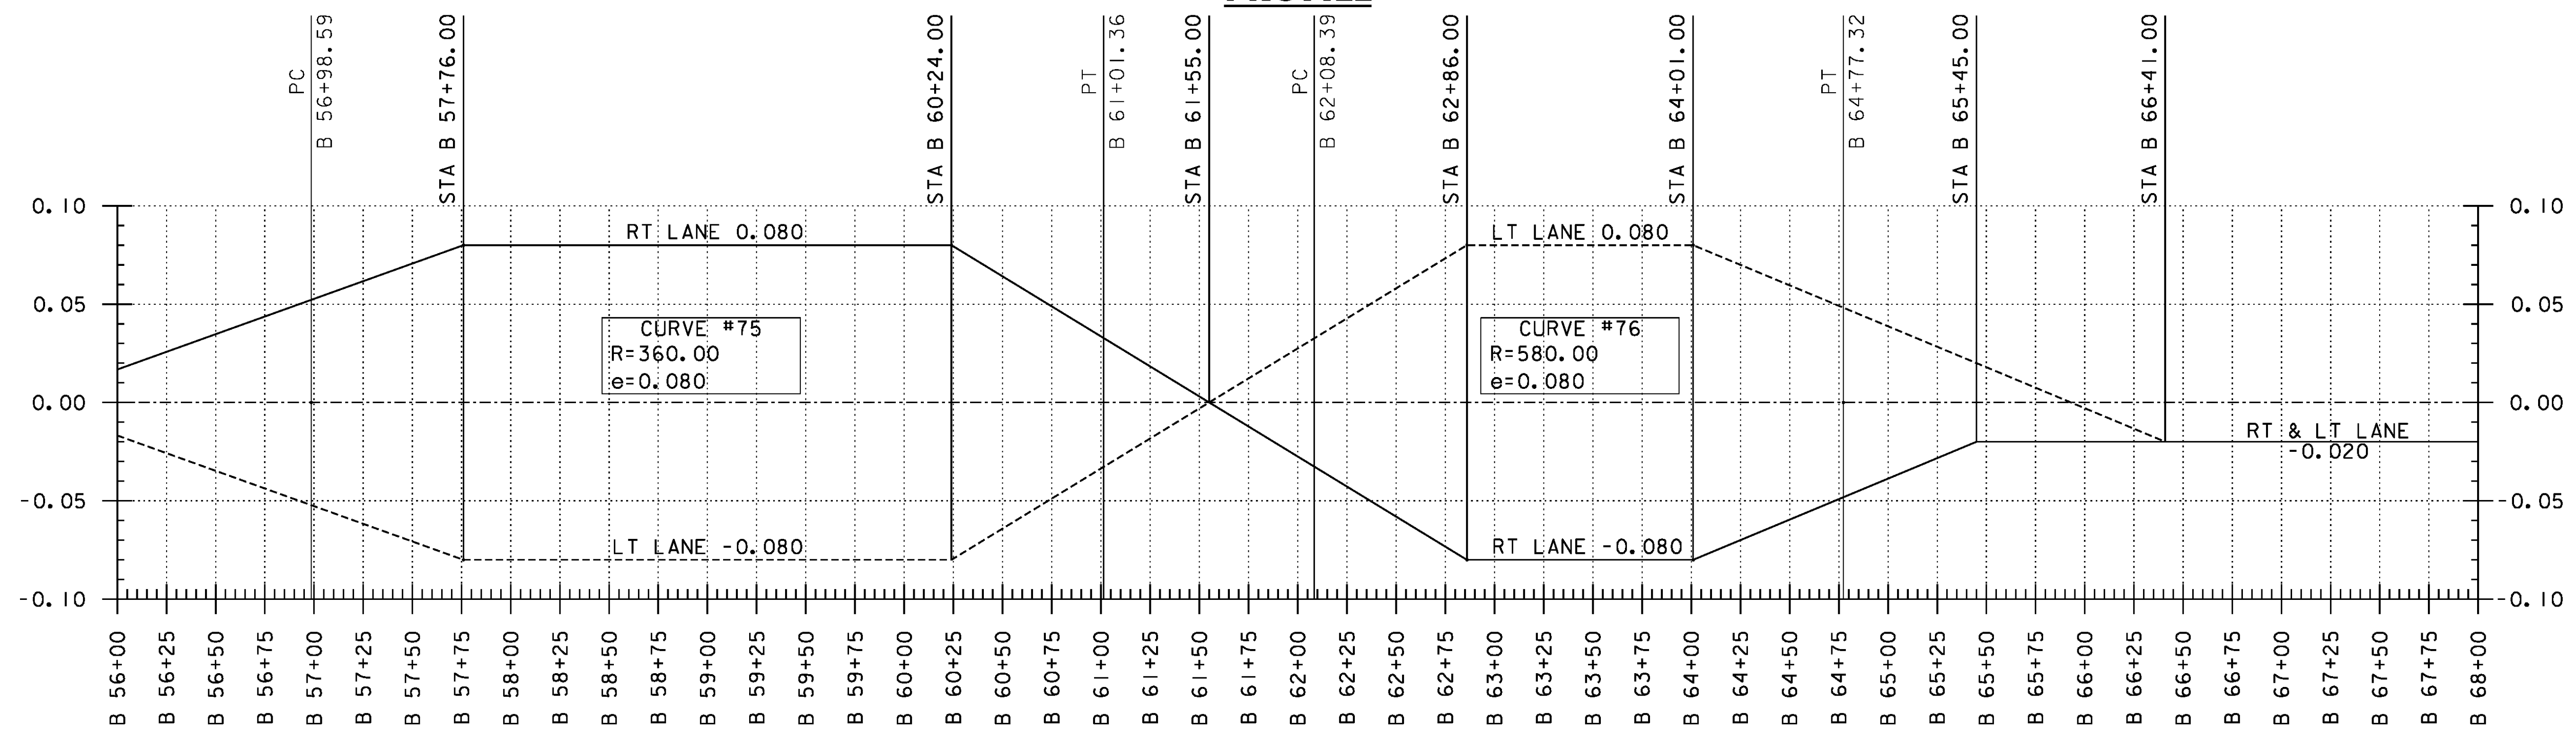

**BANKING DIAGRAM**

THE GRADES SHOWN TO THE NEAREST TENTH OF A FOOT ARE THE ORIGINAL GROUND ELEVATIONS ALONG THE PROPOSED ALIGNMENT. THE GRADES SHOWN TO THE NEAREST HUNDRETH OF A FOOT ARE FINISH GRADES FOR THE PROPOSED ALIGNMENT. SUPERELEVATIONS ARE SHOWN IN PERCENTAGES.

PROJECT NAME: WARDBORO-JAMAICA

PROJECT NUMBER: ER STP 013-K(17)

FILE NAME: d12b236\_pro\_bnk

PROJECT LEADER: K. UPMAL

DESIGNED BY: B. KIPP

VT 100 PROFILE & BANKING DIAGRAM

PLOT DATE: 2/26/2014

DRAWN BY: B. KIPP

CHECKED BY: A. KEMPTON

SHEET 128 OF 444