


PROFILE

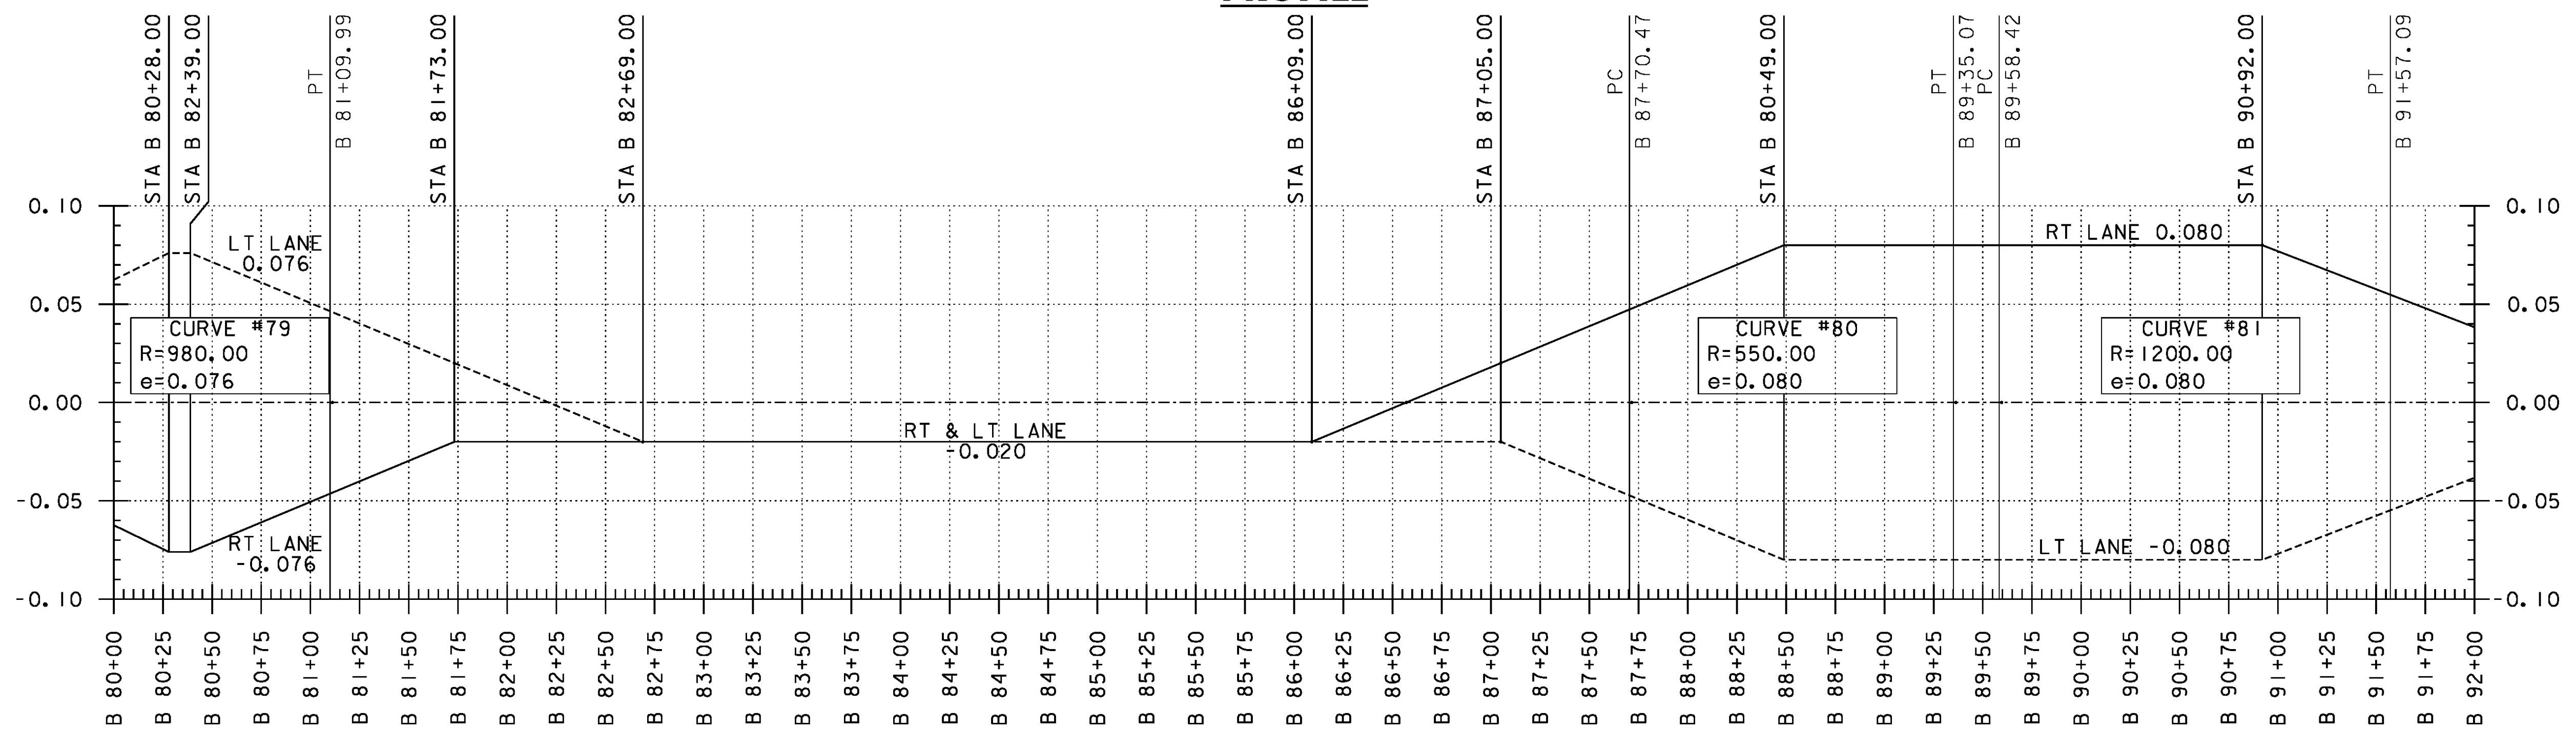

BANKING DIAGRAM

THE GRADES SHOWN TO THE NEAREST TENTH OF A FOOT ARE THE ORIGINAL GROUND ELEVATIONS ALONG THE PROPOSED ALIGNMENT. THE GRADES SHOWN TO THE NEAREST HUNDRETH OF A FOOT ARE FINISH GRADES FOR THE PROPOSED ALIGNMENT. SUPERELEVATIONS ARE SHOWN IN PERCENTAGES.

PROJECT NAME: WARDBORO-JAMAICA
 PROJECT NUMBER: ER STP 013-K(17)

FILE NAME: d12b236_pro_bnk
 PROJECT LEADER: K. UPMAL
 DESIGNED BY: B. KIPP
 VT 100 PROFILE & BANKING DIAGRAM

PLOT DATE: 2/26/2014
 DRAWN BY: B. KIPP
 CHECKED BY: A. KEMPTON
 SHEET 132 OF 444