

STEEL BEAM GUARDRAIL, GALVANIZED W/ 8 FT POSTS
 STA B 104+37 - STA B 113+87 LT
 STA B 112+51 - STA B 113+87 RT

REMOVE AND DISPOSE OF GUARDRAIL
 STA B 104+88 - STA B 111+20 LT

STEEL BEAM GUARDRAIL, GALVANIZED
 STA B 104+24 - STA B 104+37 LT
 STA B 112+38 - STA B 112+51 RT
 STA B 113+87 - STA B 114+00 RT
 STA B 113+87 - STA B 114+00 LT



STONE FILL, TYPE I
~~STA B 111+00 - STA B 113+76 LT~~
~~STA B 113+00 - STA B 114+00 RT~~
STA B 11+64 - STA B 113+50 LT

ANCHOR FOR STEEL BEAM RAIL
 STA B 104+33 LT
 STA B 112+47 RT
 STA B 113+91 RT
 STA B 113+91 LT

GRUBBING MATERIAL
 STA B 111+00 - STA B 113+75 LT
 STA B 113+00 - STA B 114+00 RT

DELINEATOR WITH STEEL POSTS
 STA B 104+24 RT
 STA B 112+38 RT
 STA B 114+00 RT
 STA B 114+00 LT

GEOTEXTILE FOR SILT FENCE
 STA B 111+00 - STA B 113+75 LT
 STA B 113+00 - STA B 114+00 RT

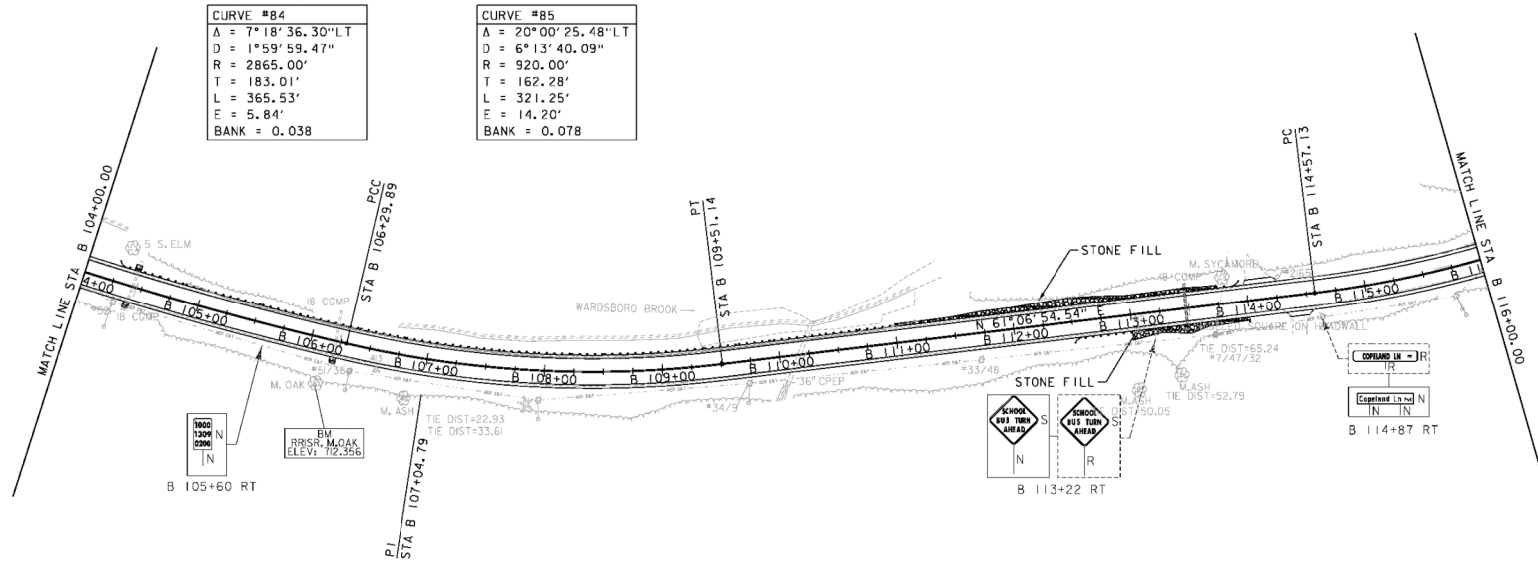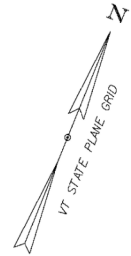

DURABLE 4 INCH WHITE LINE (SEE OPTION ITEMS)
 STA A 373+69 - STA B 119+24 (SOLID LT)
 STA A 346+96 - STA B 118+68 (SOLID RT)

DURABLE 4 INCH YELLOW LINE (SEE OPTION ITEMS)
 STA A 373+76 - STA B 118+58 (SOLID LT + RT)

TEMPORARY 4 INCH WHITE LINE
 STA A 373+69 - STA B 119+24 (SOLID LT)
 STA A 346+96 - STA B 118+68 (SOLID RT)

TEMPORARY 4 INCH YELLOW LINE
 STA A 373+76 - STA B 118+58 (SOLID LT + RT)



SIGN LEGEND
 R = REMOVE
 S = SALVAGE
 N = NEW
 RET = RETAIN
 T&T = THINNING & TRIMMING
 B-B = BACK TO BACK
 EXISTING
 NEW

PROJECT NAME:	WARDSBORO-JAMAICA
PROJECT NUMBER:	ER STP 013-1(17)
FILE NAME:	d2b236_bdr.dgn
PROJECT LEADER:	K. UPWAL
DESIGNED BY:	B. KIPP
PLAN SHEET 42	
PLOT DATE:	2/26/2014
DRAWN BY:	B. KIPP
CHECKED BY:	A. KEMPTON
SHEET	135 OF 444