

STEEL BEAM GUARDRAIL, GALVANIZED W/ 8 FT POSTS  
 STA B 171+27 - STA B 176+25 RT  
 STA B 173+78 - STA B 179+61 LT

STEEL BEAM GUARDRAIL, GALVANIZED  
 STA B 171+14 - STA B 171+27 RT  
 STA B 173+65 - STA B 173+78 LT

ANCHOR FOR STEEL BEAM RAIL  
 STA B 171+23 RT  
 STA B 173+74 RT

DELINEATOR WITH STEEL POSTS  
 STA B 171+14 RT  
 STA B 173+65 LT



REMOVE AND DISPOSE OF GUARDRAIL  
 STA B 171+15 - STA B 176+33 RT  
 STA B 173+64 - STA B 179+61 LT

STONE FILL, TYPE I  
 STA B 172+50 - STA B 174+75 RT

GRUBBING MATERIAL  
 STA B 172+50 - STA B 174+75 RT

GEOTEXTILE FOR SILT FENCE  
 STA B 172+50 - STA B 174+75 RT

RELOCATE MAILBOX, SINGLE SUPPORT  
 STA B 166+08 LT

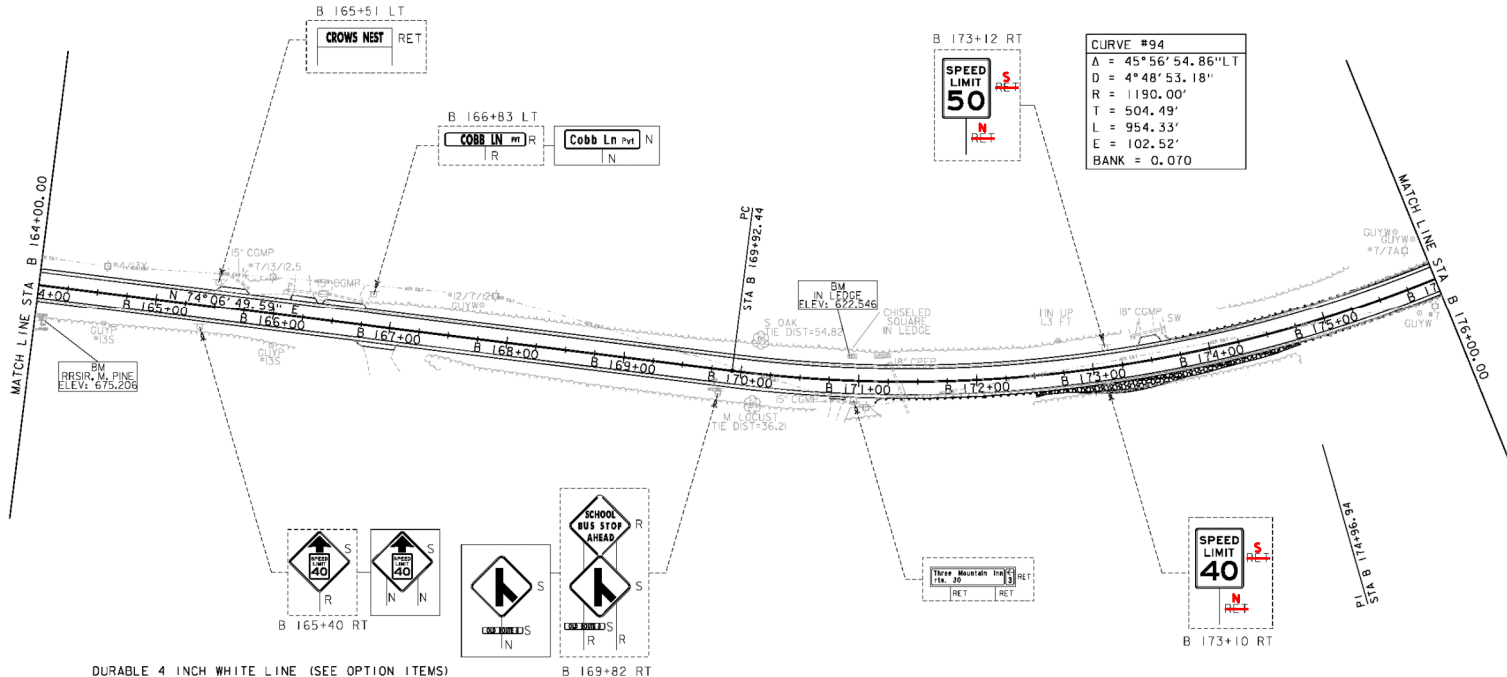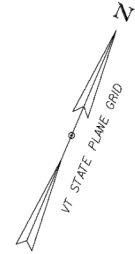

DURABLE 4 INCH WHITE LINE (SEE OPTION ITEMS)  
 STA B 123+92 - STA B 179+62 (SOLID LT)  
 STA B 133+01 - STA B 176+30 (SOLID RT)  
 DURABLE 4 INCH YELLOW LINE (SEE OPTION ITEMS)  
 STA B 132+92 - STA B 176+45 (SOLID LT + RT)

TEMPORARY 4 INCH WHITE LINE  
 STA B 123+92 - STA B 179+62 (SOLID LT)  
 STA B 133+01 - STA B 176+30 (SOLID RT)

TEMPORARY 4 INCH YELLOW LINE  
 STA B 132+92 - STA B 176+45 (SOLID LT + RT)



**SIGN LEGEND**  
 R = REMOVE  
 S = SALVAGE  
 N = NEW  
 RET = RETAIN  
 T&T = THINNING & TRIMMING  
 B-B = BACK TO BACK  
 EXISTING  
 NEW

PROJECT NAME:	WARDSBORO-JAMAICA
PROJECT NUMBER:	ER STP 013-1(17)
FILE NAME:	d2b236_bdr.dgn
PROJECT LEADER:	K, UPWAL
DESIGNED BY:	B, KIPP
PLAN SHEET 47	
PLOT DATE:	2/26/2014
DRAWN BY:	B, KIPP
CHECKED BY:	A, KEMPTON
SHEET	145 OF 444