



STEEL BEAM GUARDRAIL, GALVANIZED W/ 8 FT POSTS
 STA B 171+27 - STA B 176+25 RT
 STA B 173+78 - STA B 179+61 LT
 STA B 176+54 - STA B 179+55 RT

STEEL BEAM GUARDRAIL, GALVANIZED
 STA B 176+25 - STA B 176+38 RT

ANCHOR FOR STEEL BEAM RAIL
 STA B 176+29 RT

DELINEATOR WITH STEEL POSTS
 STA B 176+29 RT

REMOVE AND DISPOSE OF GUARDRAIL
 STA B 171+06 - STA B 176+37 RT
 STA B 173+64 - STA B 179+61 LT
 STA B 176+54 - STA B 179+55 RT

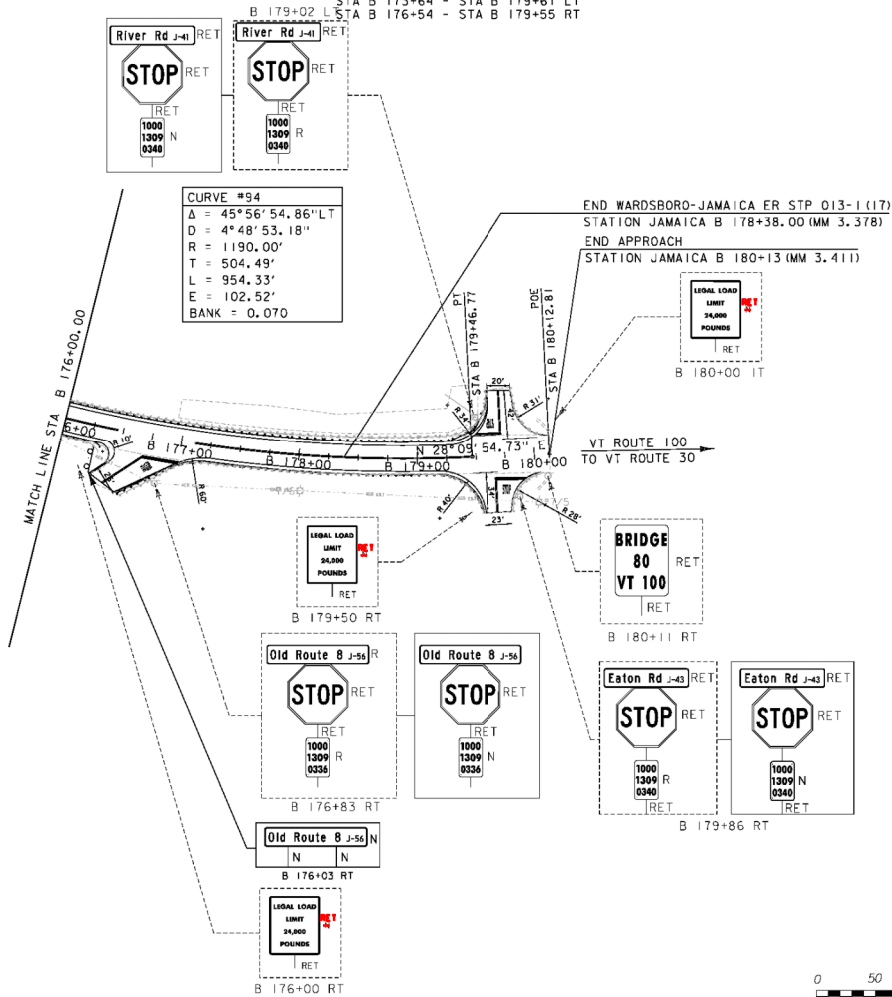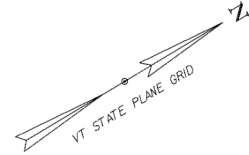

END WARDSBORO-JAMAICA ER STP 013-1 (17)
 STATION JAMAICA B 178+38.00 (MM 3.378)
 END APPROACH
 STATION JAMAICA B 180+13 (MM 3.411)

CURVE #94
 $\Delta = 45^\circ 56' 54.86''$ LT
 $D = 4^\circ 48' 53.18''$
 $R = 1190.00'$
 $T = 504.49'$
 $L = 954.33'$
 $E = 102.52'$
 $BANK = 0.070$

DURABLE 4 INCH WHITE LINE (SEE OPTION ITEMS)
 STA B 123+92 - STA B 179+62 (SOLID LT)
 STA B 133+01 - STA B 176+30 (SOLID RT)
 STA B 176+51 - STA B 179+56 (SOLID RT)

DURABLE 24 IN STOP BAR (SEE OPTION ITEMS)
 STA B 176+75 RT
 STA B 179+46 LT
 STA B 179+66 RT

DURABLE 4 INCH YELLOW LINE (SEE OPTION ITEMS)
 STA B 132+92 - STA B 176+45 (SOLID LT + RT)
 STA B 177+11 - STA B 179+44 (SOLID LT + RT)

DURABLE LETTER OR SYMBOL (SEE OPTION ITEMS)
 STA B 176+75 RT "STOP"
 STA B 179+66 LT "STOP"
 STA B 179+75 RT "STOP"

TEMPORARY 4 INCH WHITE LINE
 STA B 123+92 - STA B 179+62 (SOLID LT)
 STA B 133+01 - STA B 176+30 (SOLID RT)
 STA B 176+51 - STA B 179+56 (SOLID RT)

TEMPORARY 4 INCH YELLOW LINE
 STA B 132+92 - STA B 176+45 (SOLID LT)
 STA B 177+11 - STA B 179+44 (SOLID RT)

SIGN LEGEND

- R = REMOVE
- S = SALVAGE
- N = NEW
- RET = RETAIN
- T&T = THINNING & TRIMMING
- B-B = BACK TO BACK
- EXISTING = EXISTING
- NEW = NEW



PROJECT NAME:	WARDSBORO-JAMAICA
PROJECT NUMBER:	ER STP 013-1(I17)
FILE NAME:	d2b236.bdr.dgn
PROJECT LEADER:	K. UPWAL
DESIGNED BY:	B. KIPP
PLAN SHEET 48	
PLOT DATE:	2/26/2014
DRAWN BY:	B. KIPP
CHECKED BY:	A. KEMPTON
SHEET	147 OF 444