



A 16+00

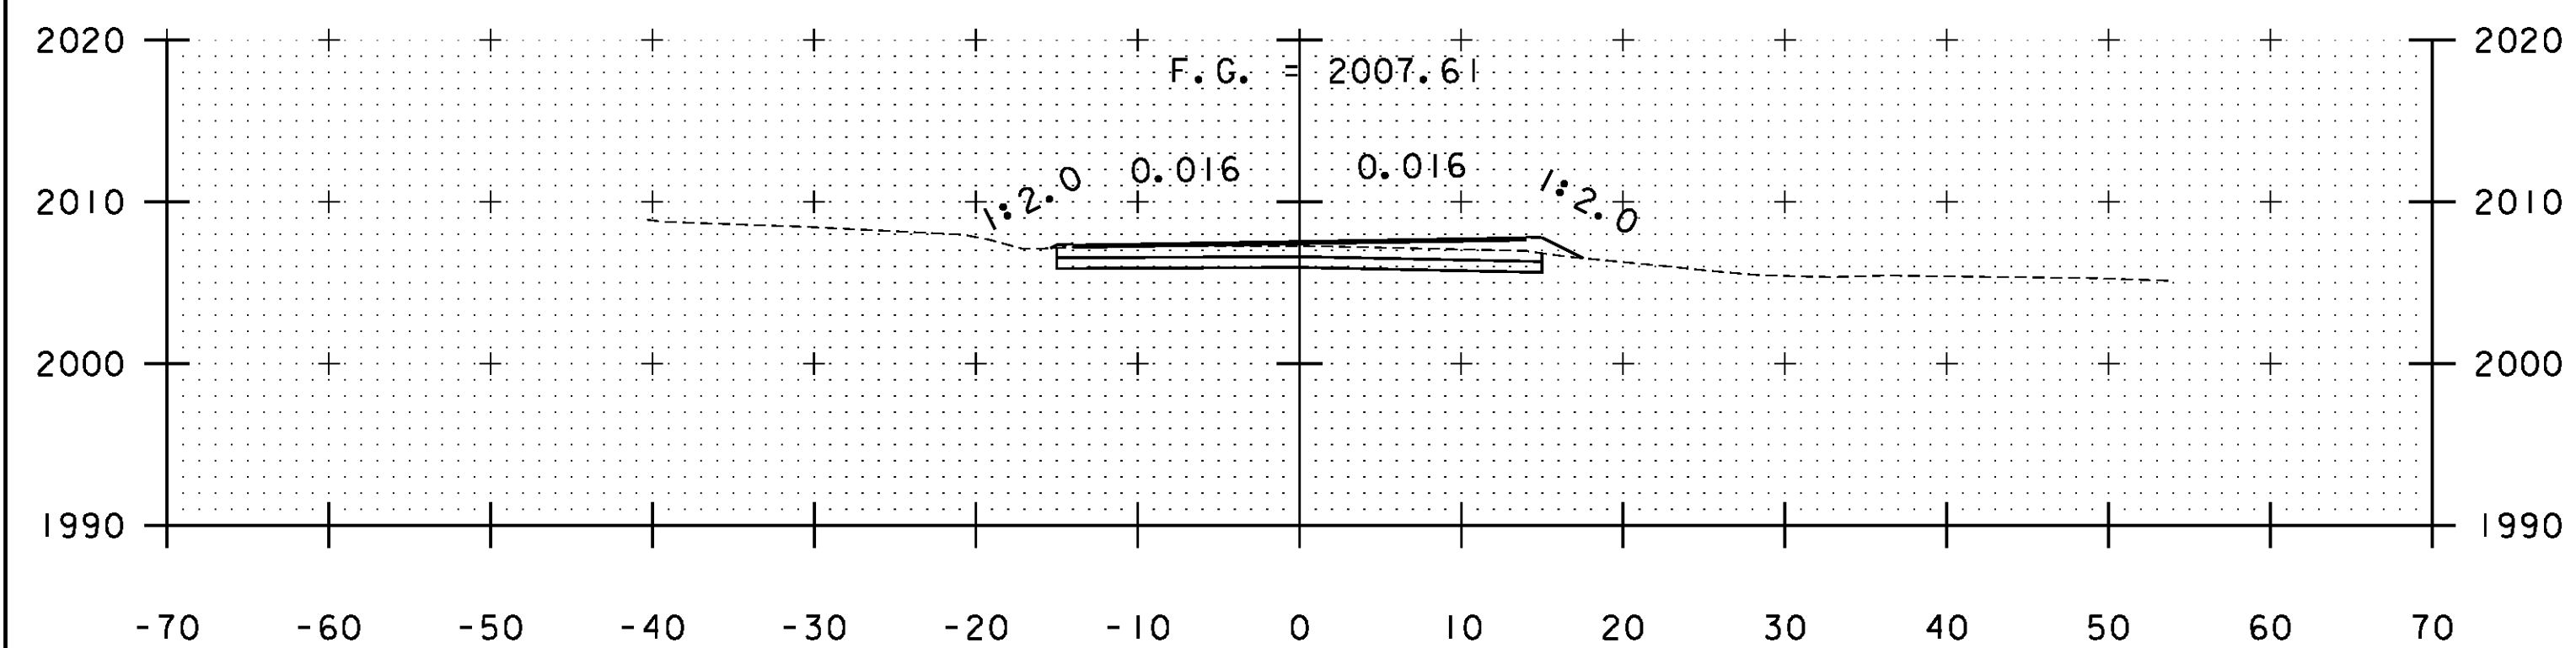

A 15+50

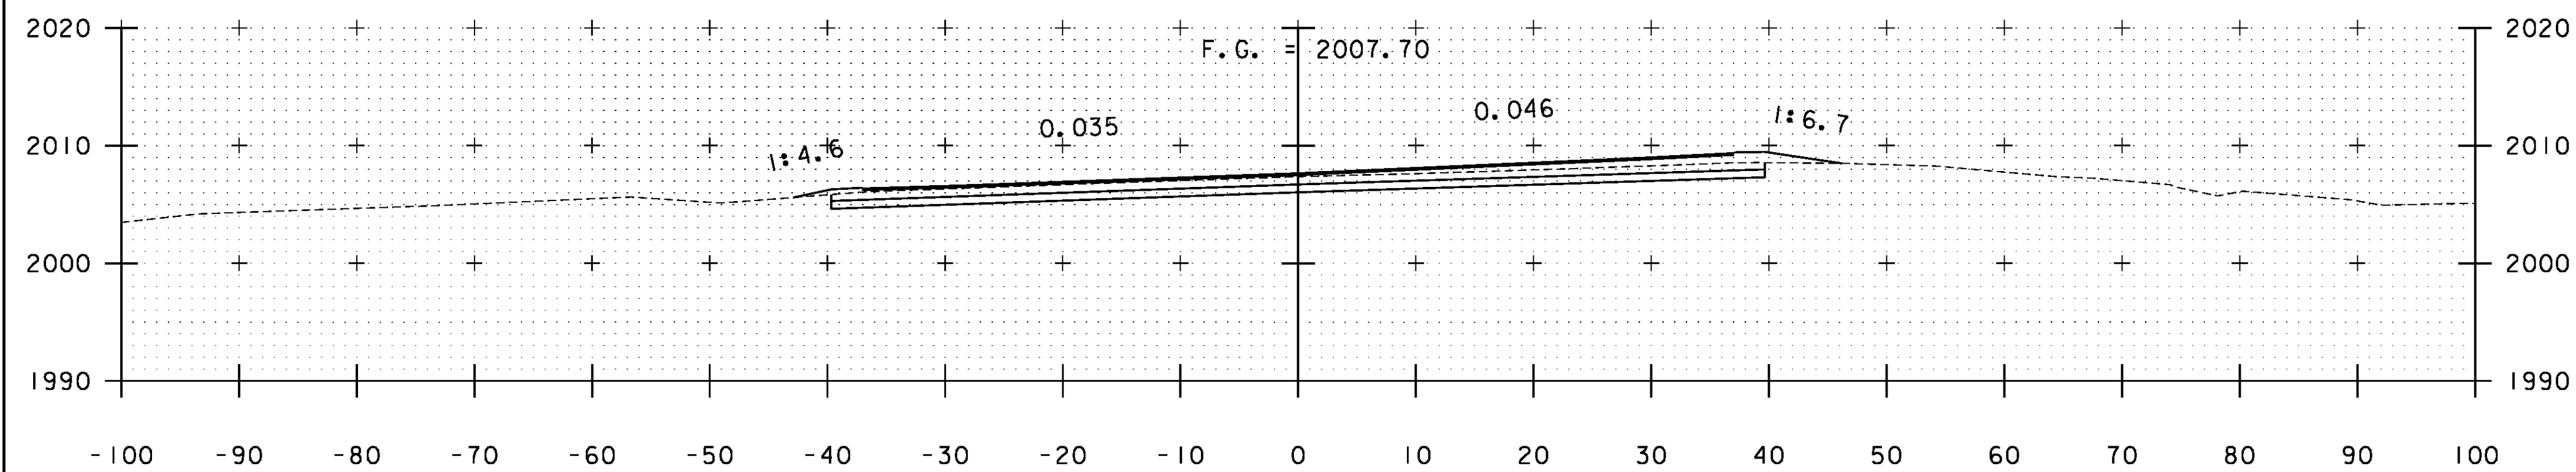

A 15+48

STA. A 15+48 TO STA. A 16+00

PROJECT NAME: WARDBORO-JAMAICA	PLOT DATE: 2/26/2014
PROJECT NUMBER: ER STP 013-1(17)	DRAWN BY: B. KIPP
FILE NAME: xs.dgn	CHECKED BY: HSD
PROJECT LEADER: K. UPMAL	SHEET 177 OF 444
DESIGNED BY: B. KIPP	CROSS SECTIONS