




A 19+00

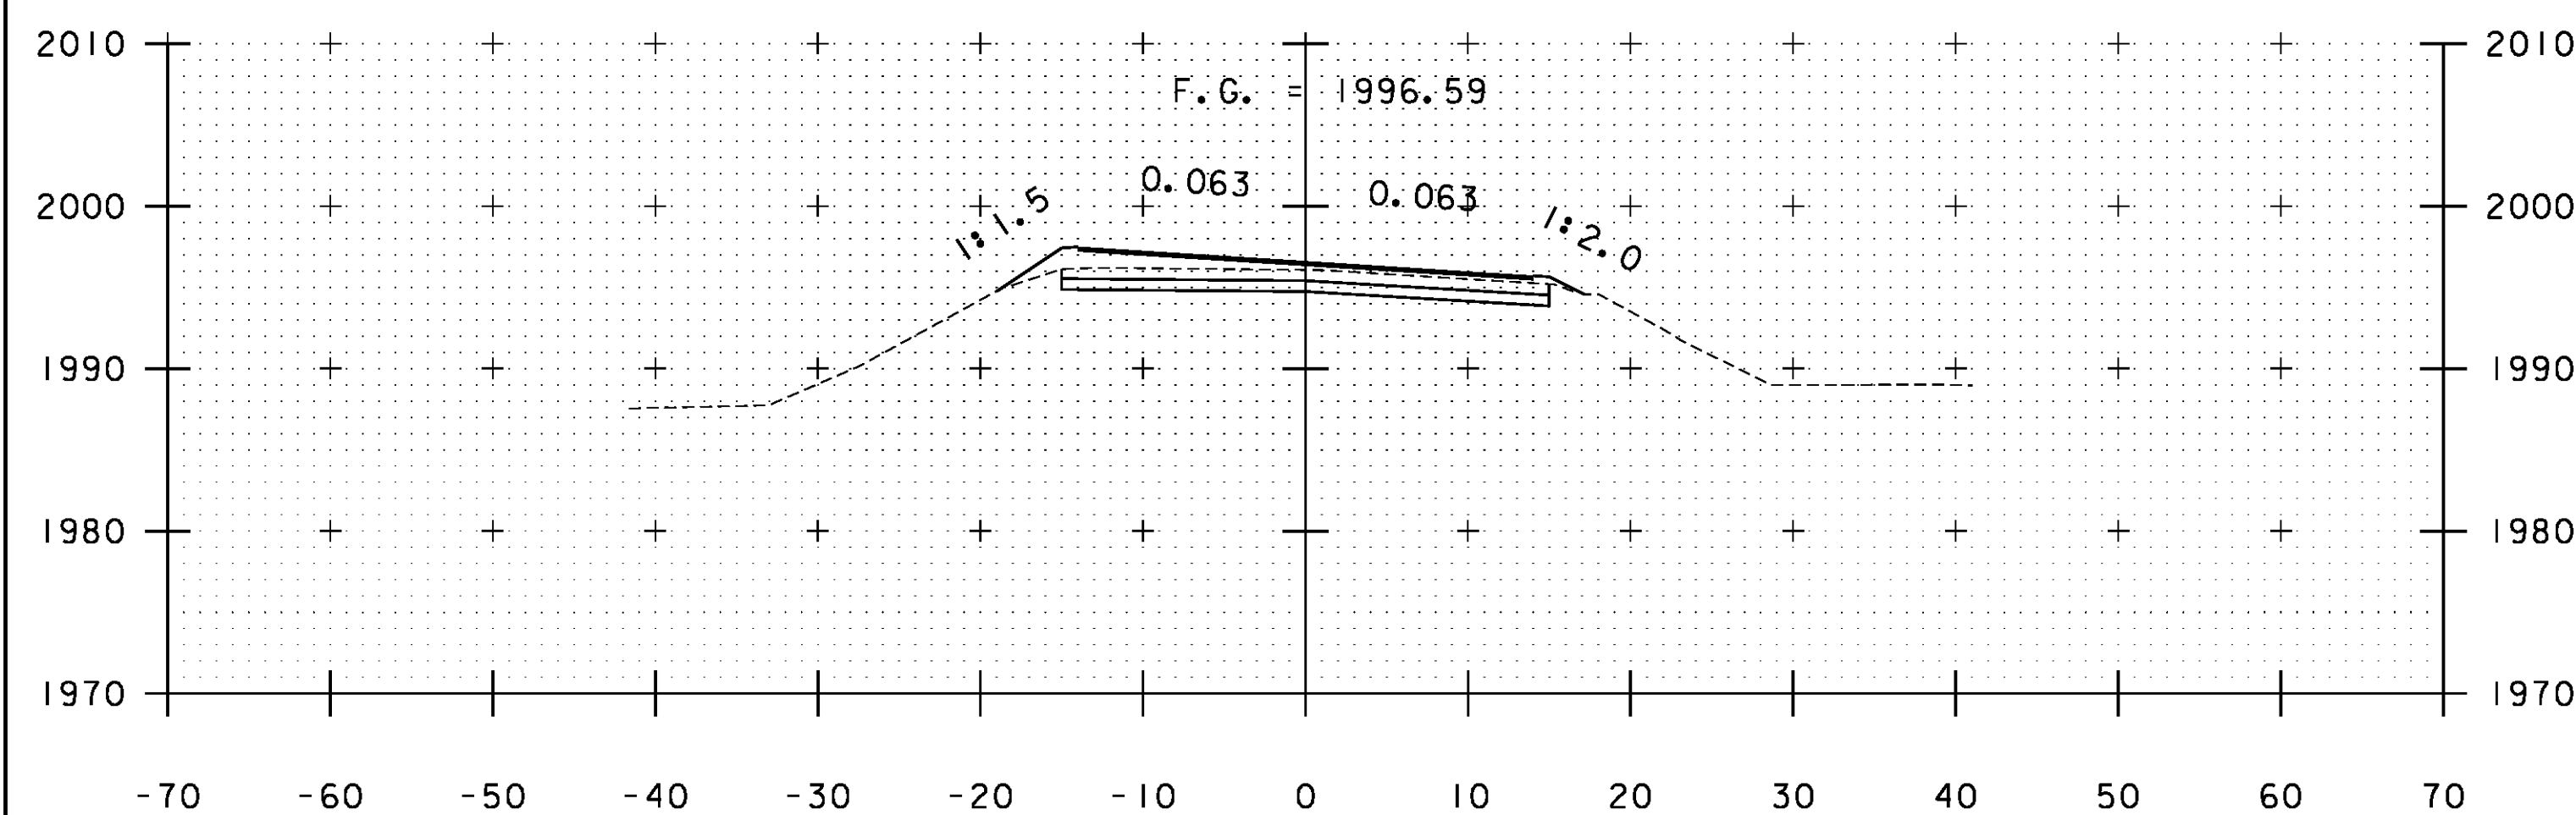

A 18+50

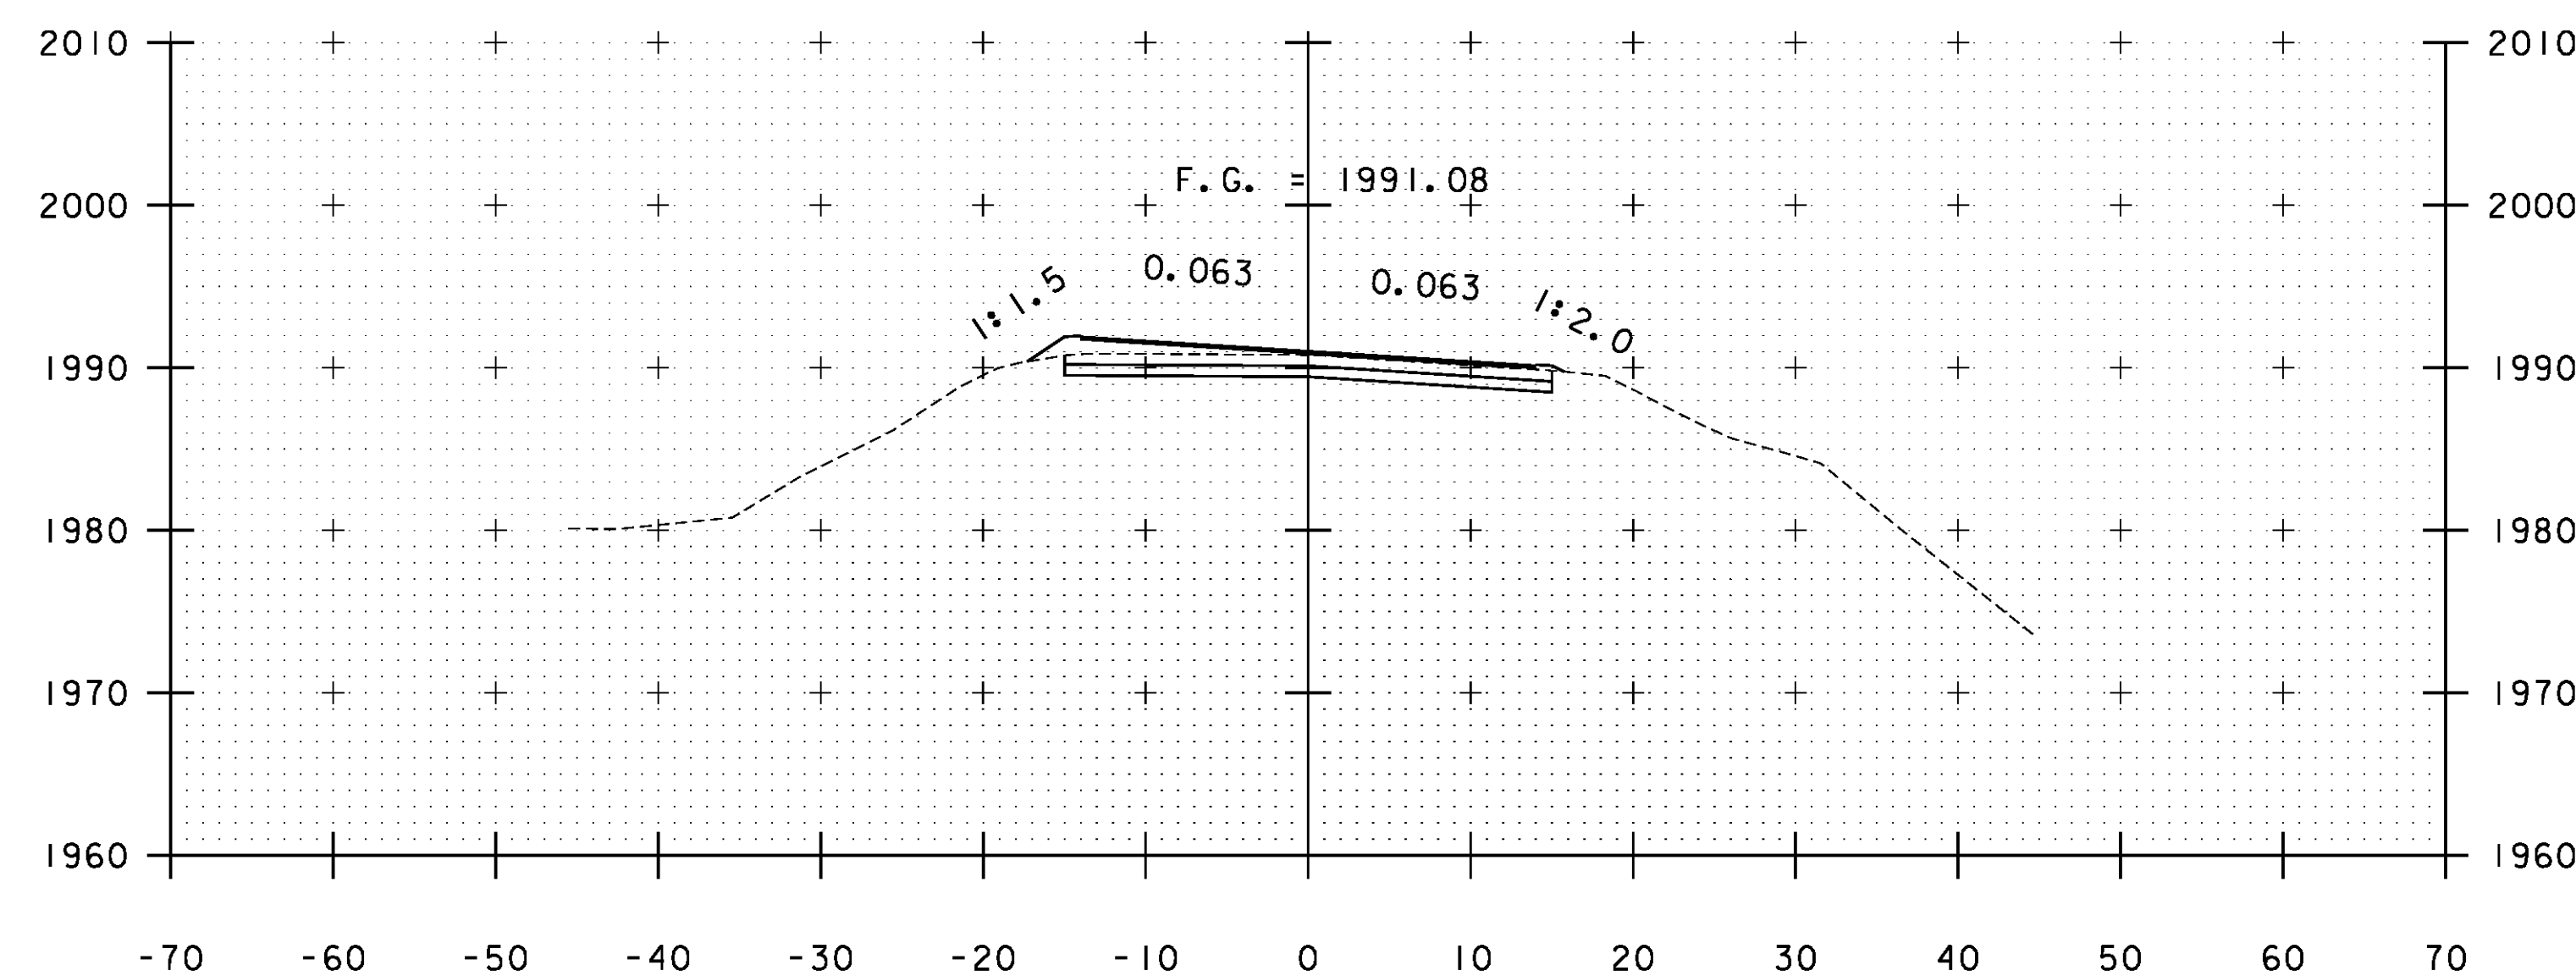

A 20+00

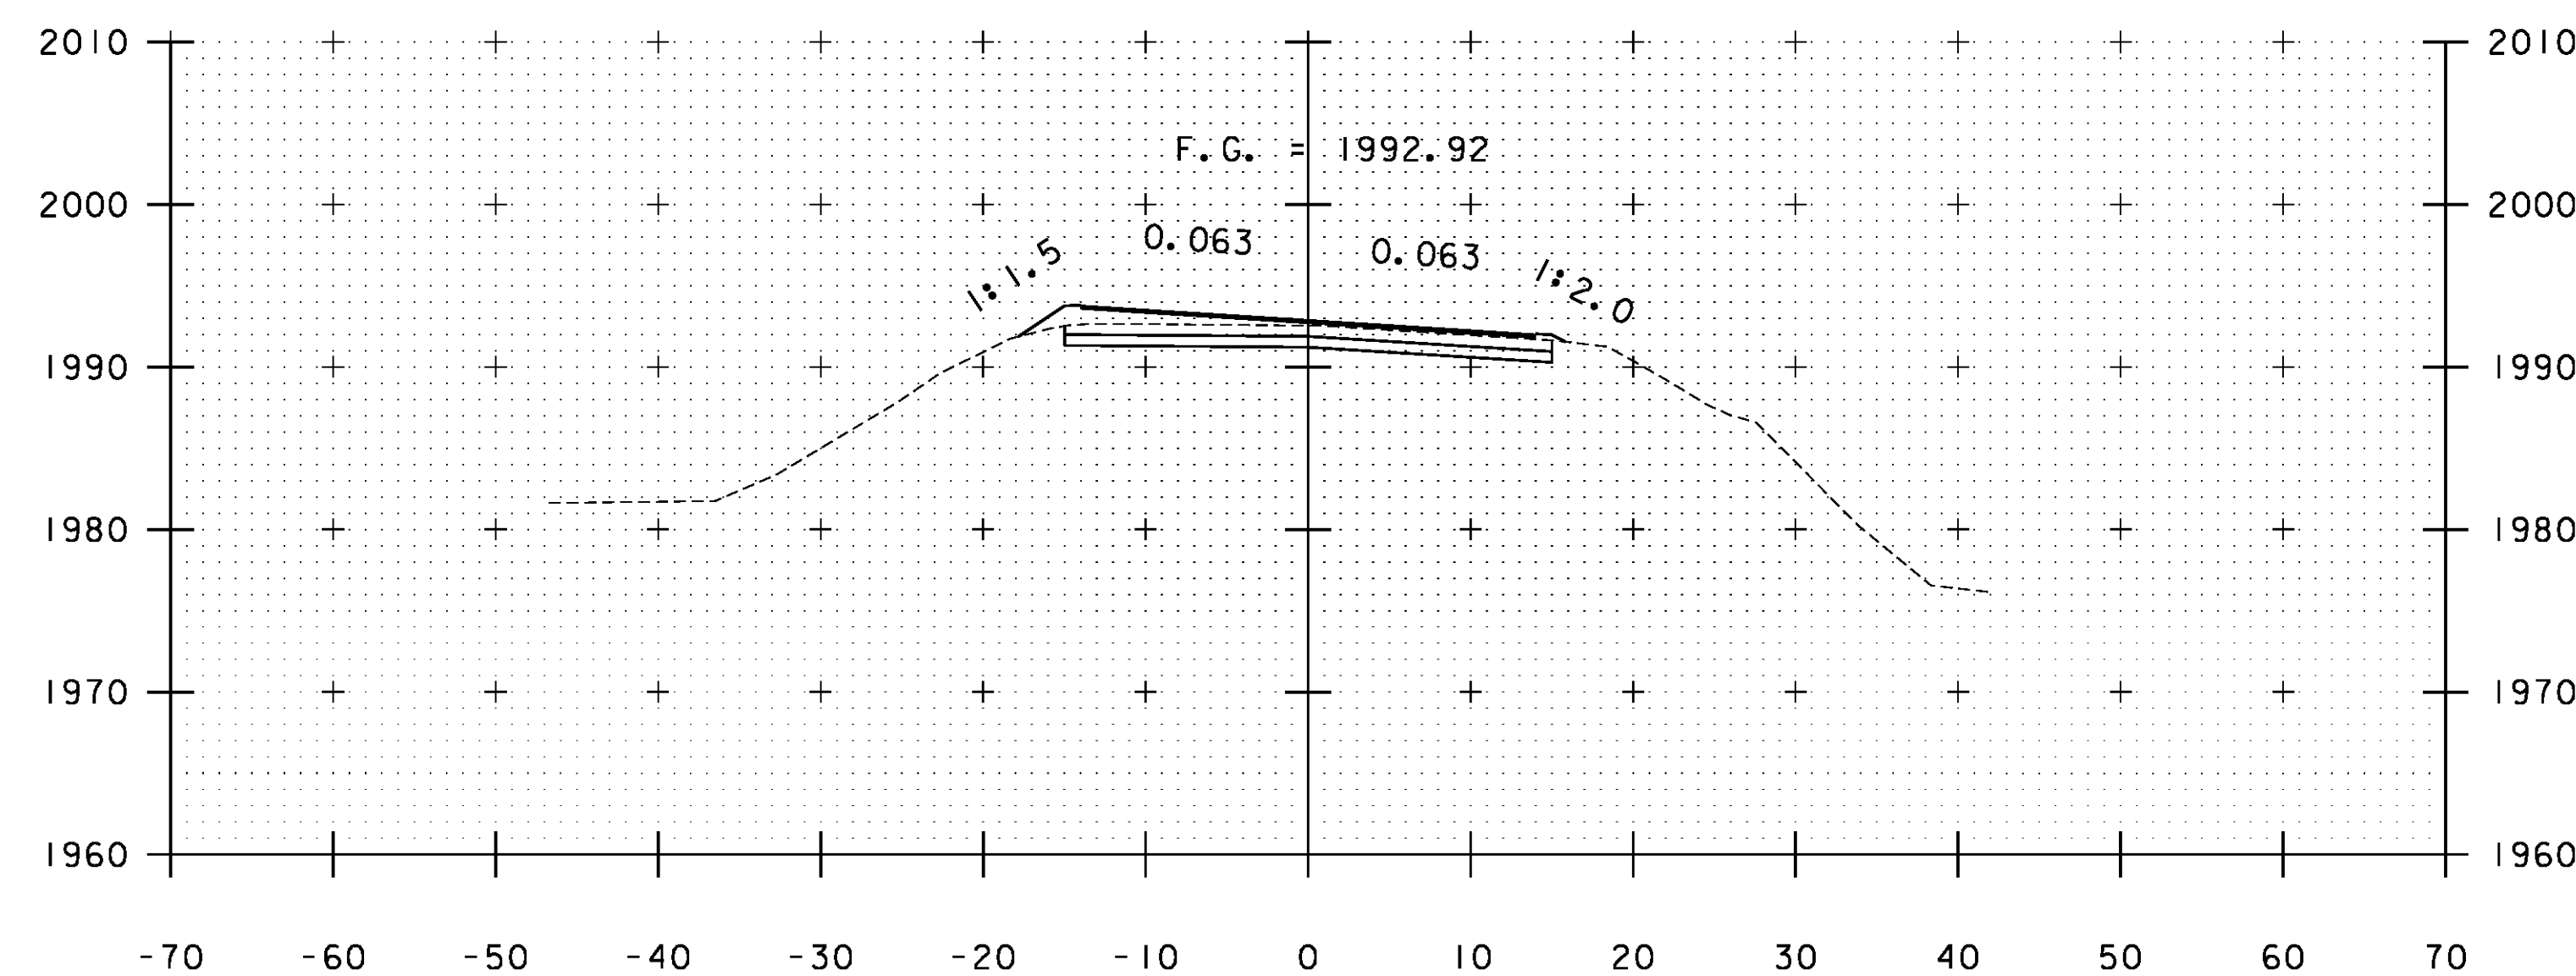

A 19+50

STA. A 18+50 TO STA. A 20+00

PROJECT NAME:	WARDSBORO-JAMAICA
PROJECT NUMBER:	ER STP 013-1(17)
FILE NAME:	xs.dgn
PROJECT LEADER:	K. UPMAL
DESIGNED BY:	B. KIPP
CROSS SECTIONS	
PLOT DATE:	2/26/2014
DRAWN BY:	B. KIPP
CHECKED BY:	HSD
SHEET	179 OF 444