




A 21+00

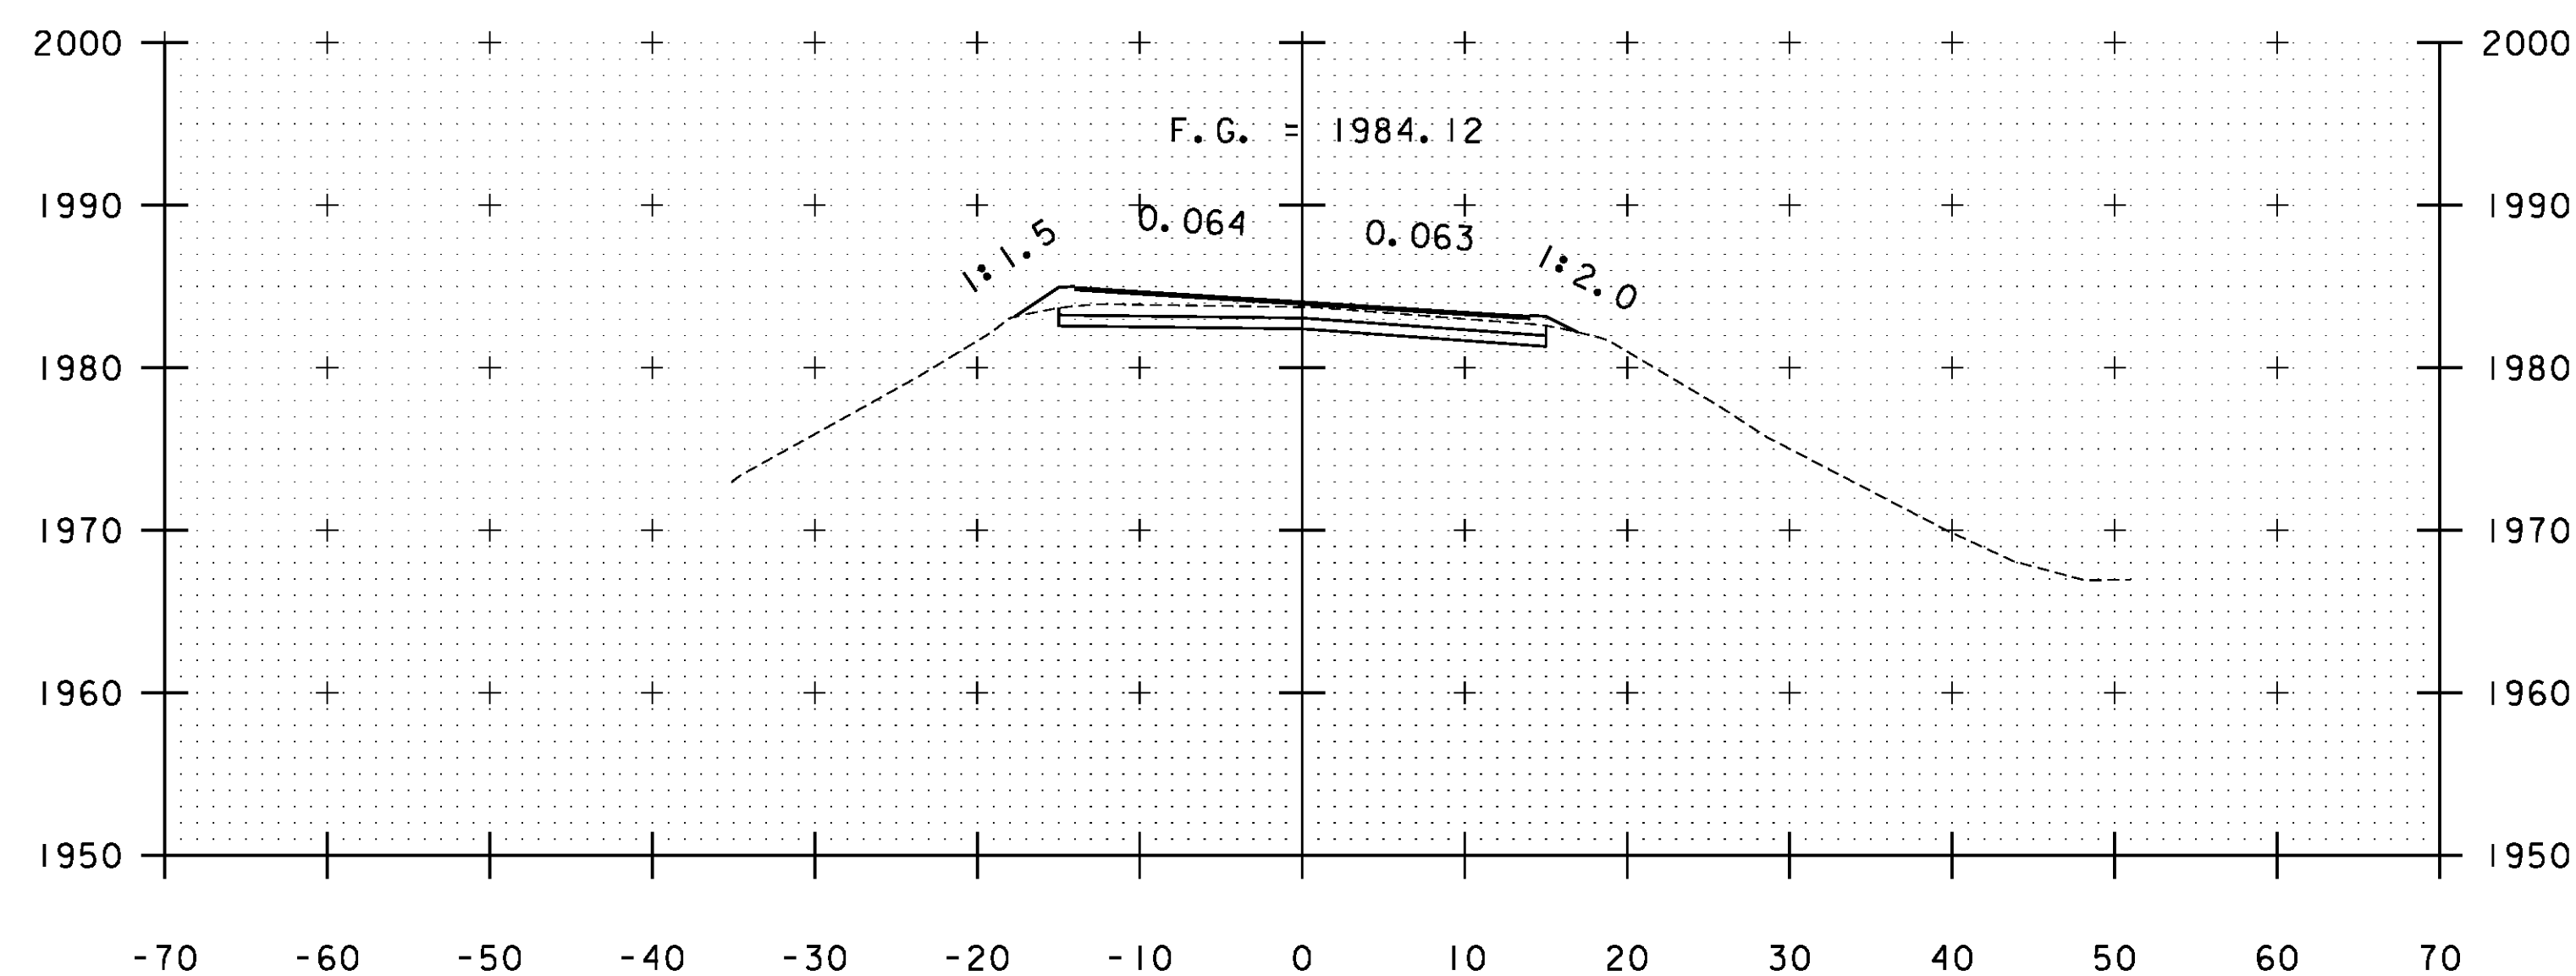

A 22+00

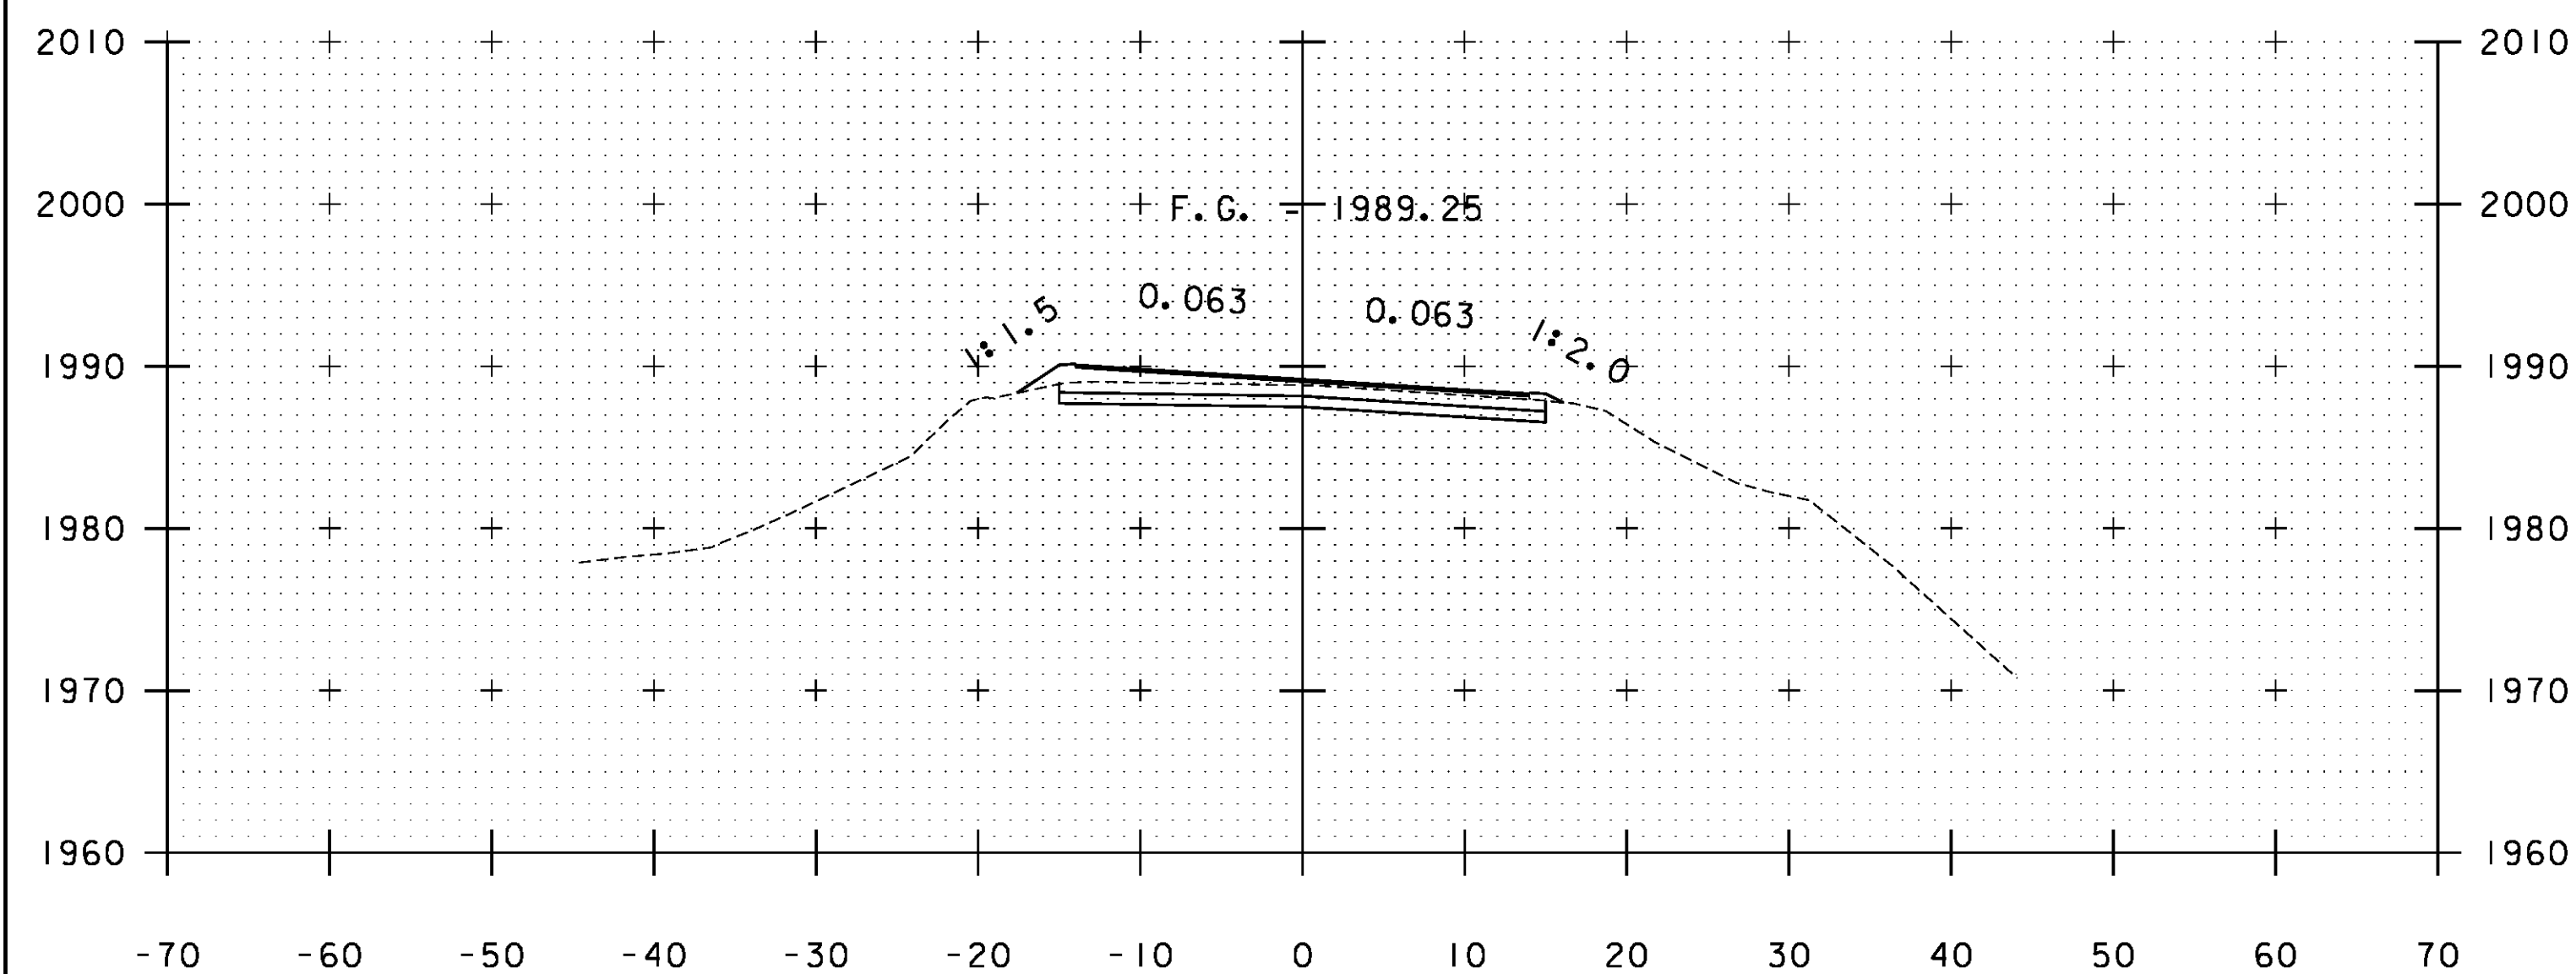

A 20+50

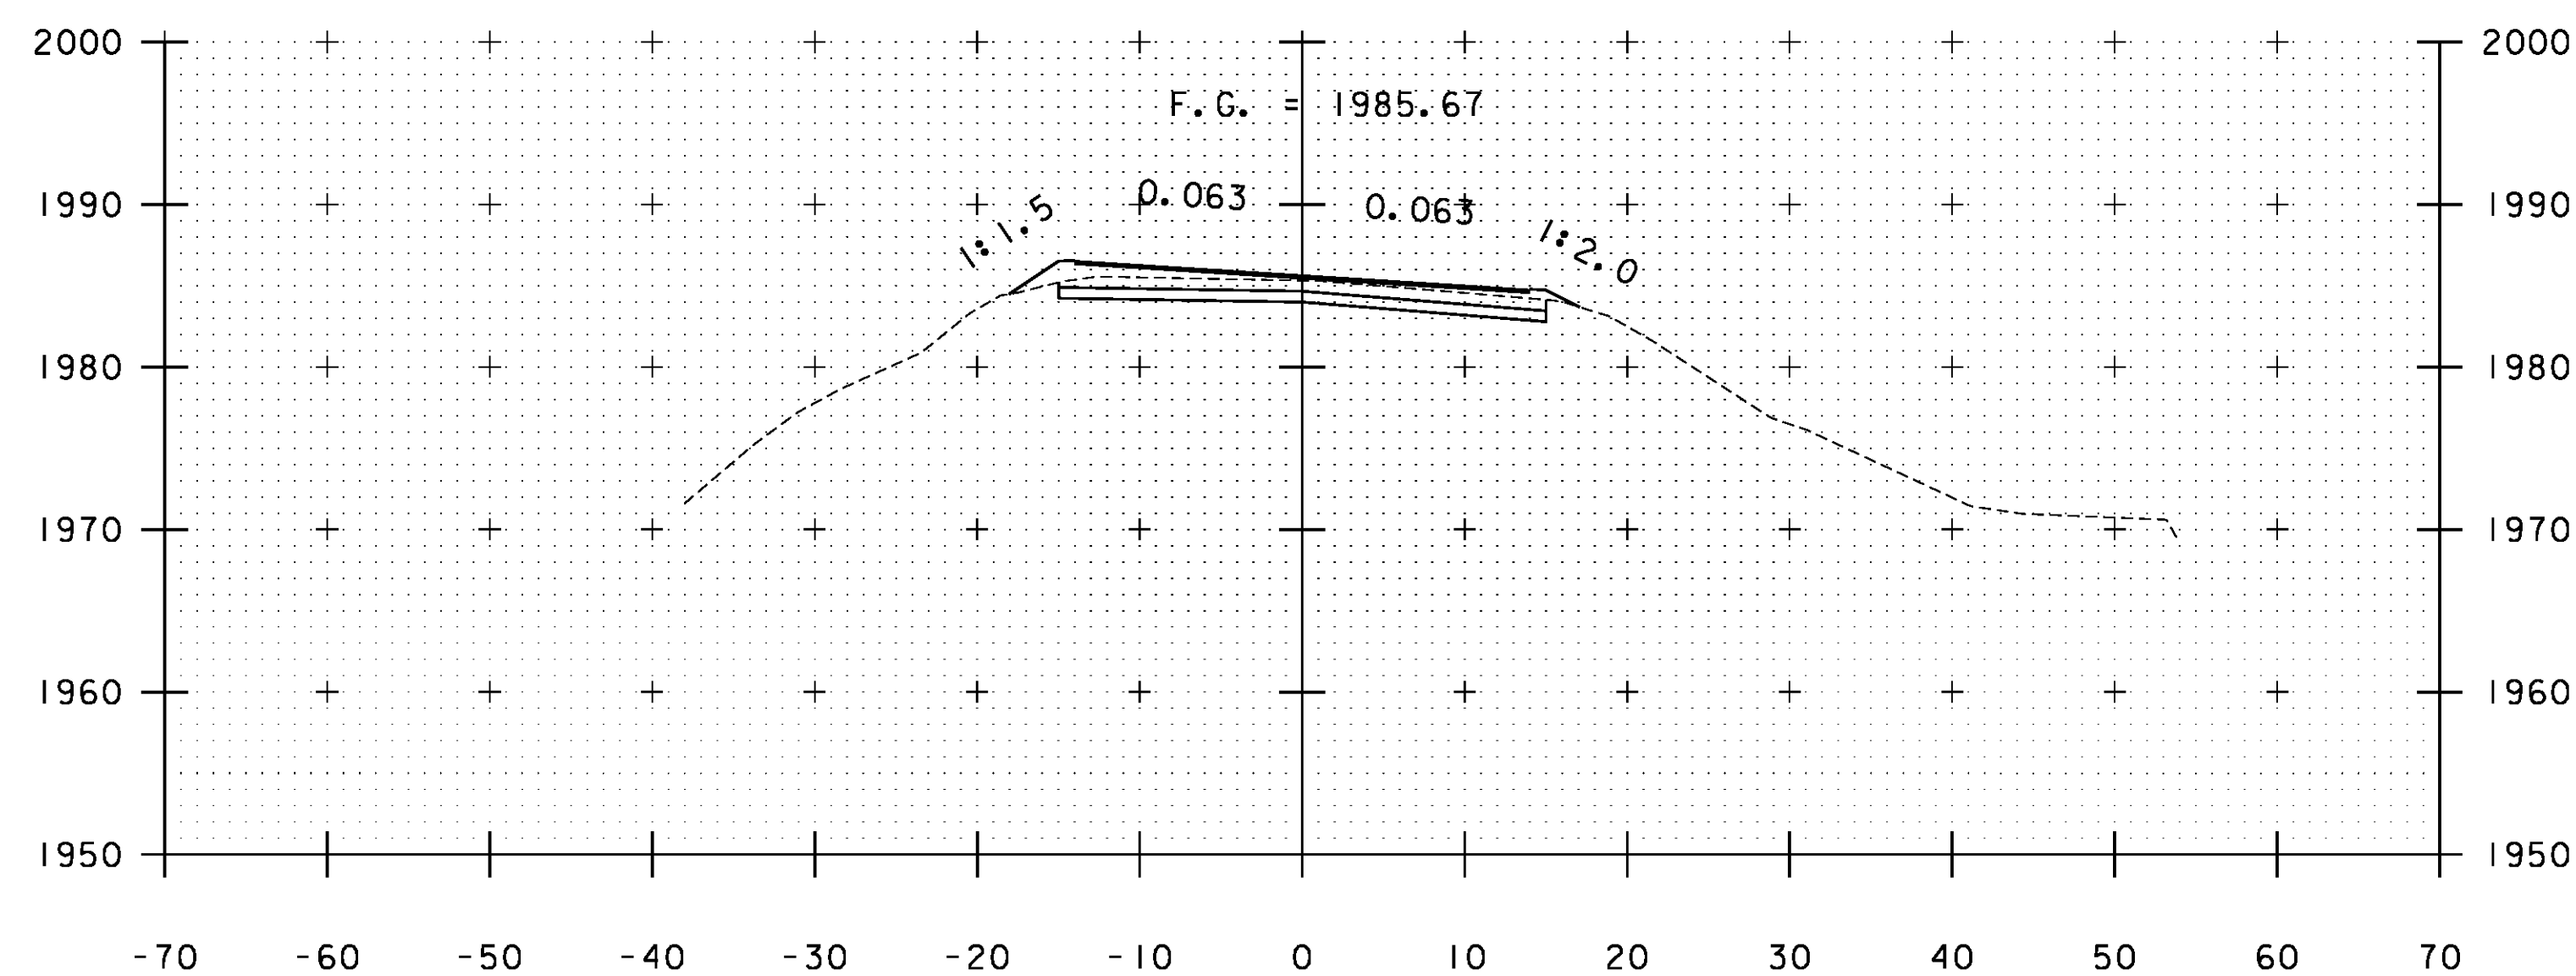

A 21+50

STA. A 20+50 TO STA. A 22+00

PROJECT NAME: WARDBORO-JAMAICA	PLOT DATE: 2/26/2014
PROJECT NUMBER: ER STP 013-1(17)	DRAWN BY: B. KIPP
FILE NAME: xs.dgn	CHECKED BY: HSD
PROJECT LEADER: K. UPMAL	SHEET 180 OF 444
DESIGNED BY: B. KIPP	
CROSS SECTIONS	