




A 22+67

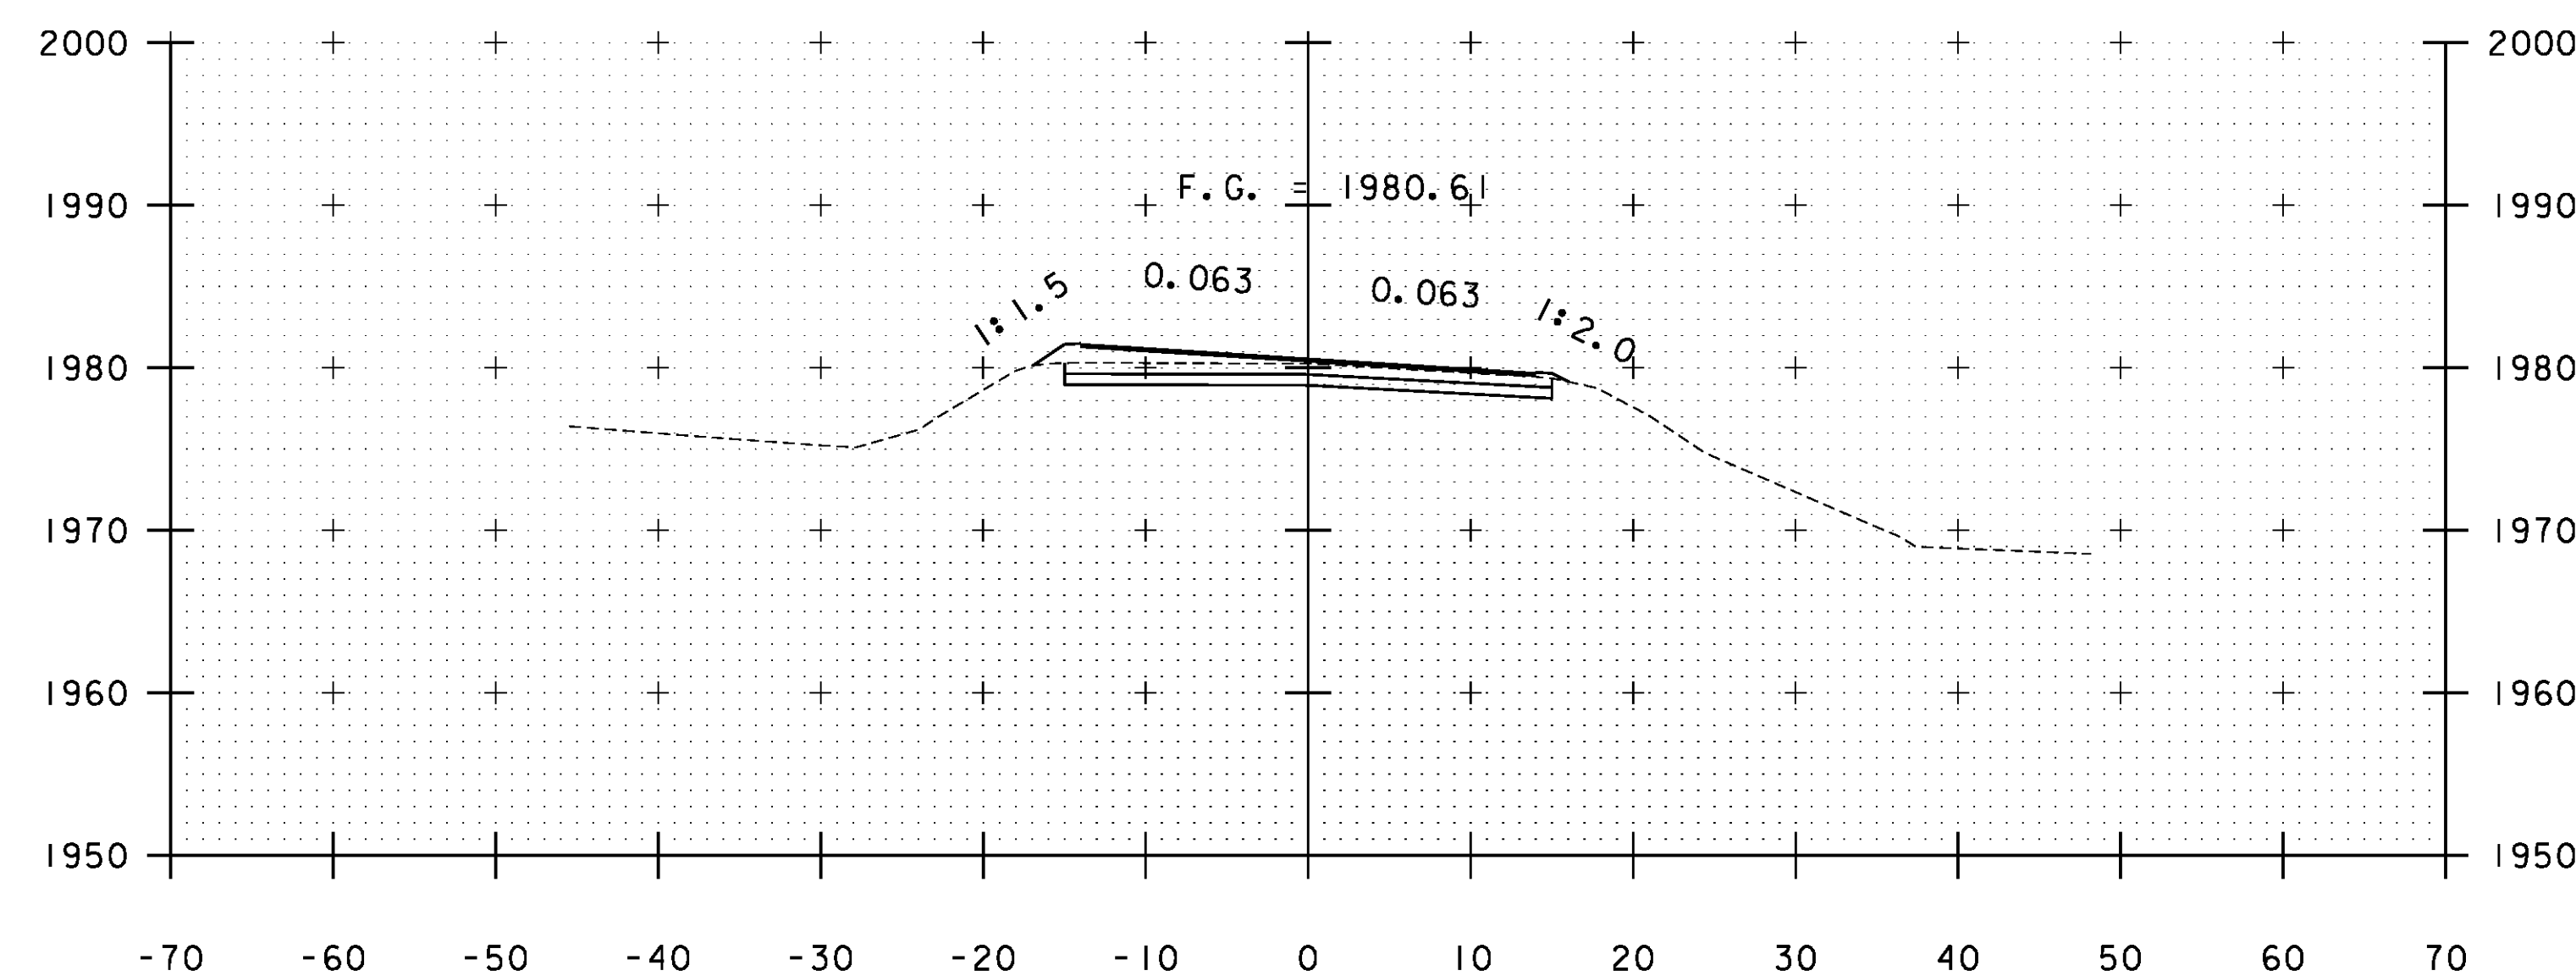

A 23+50

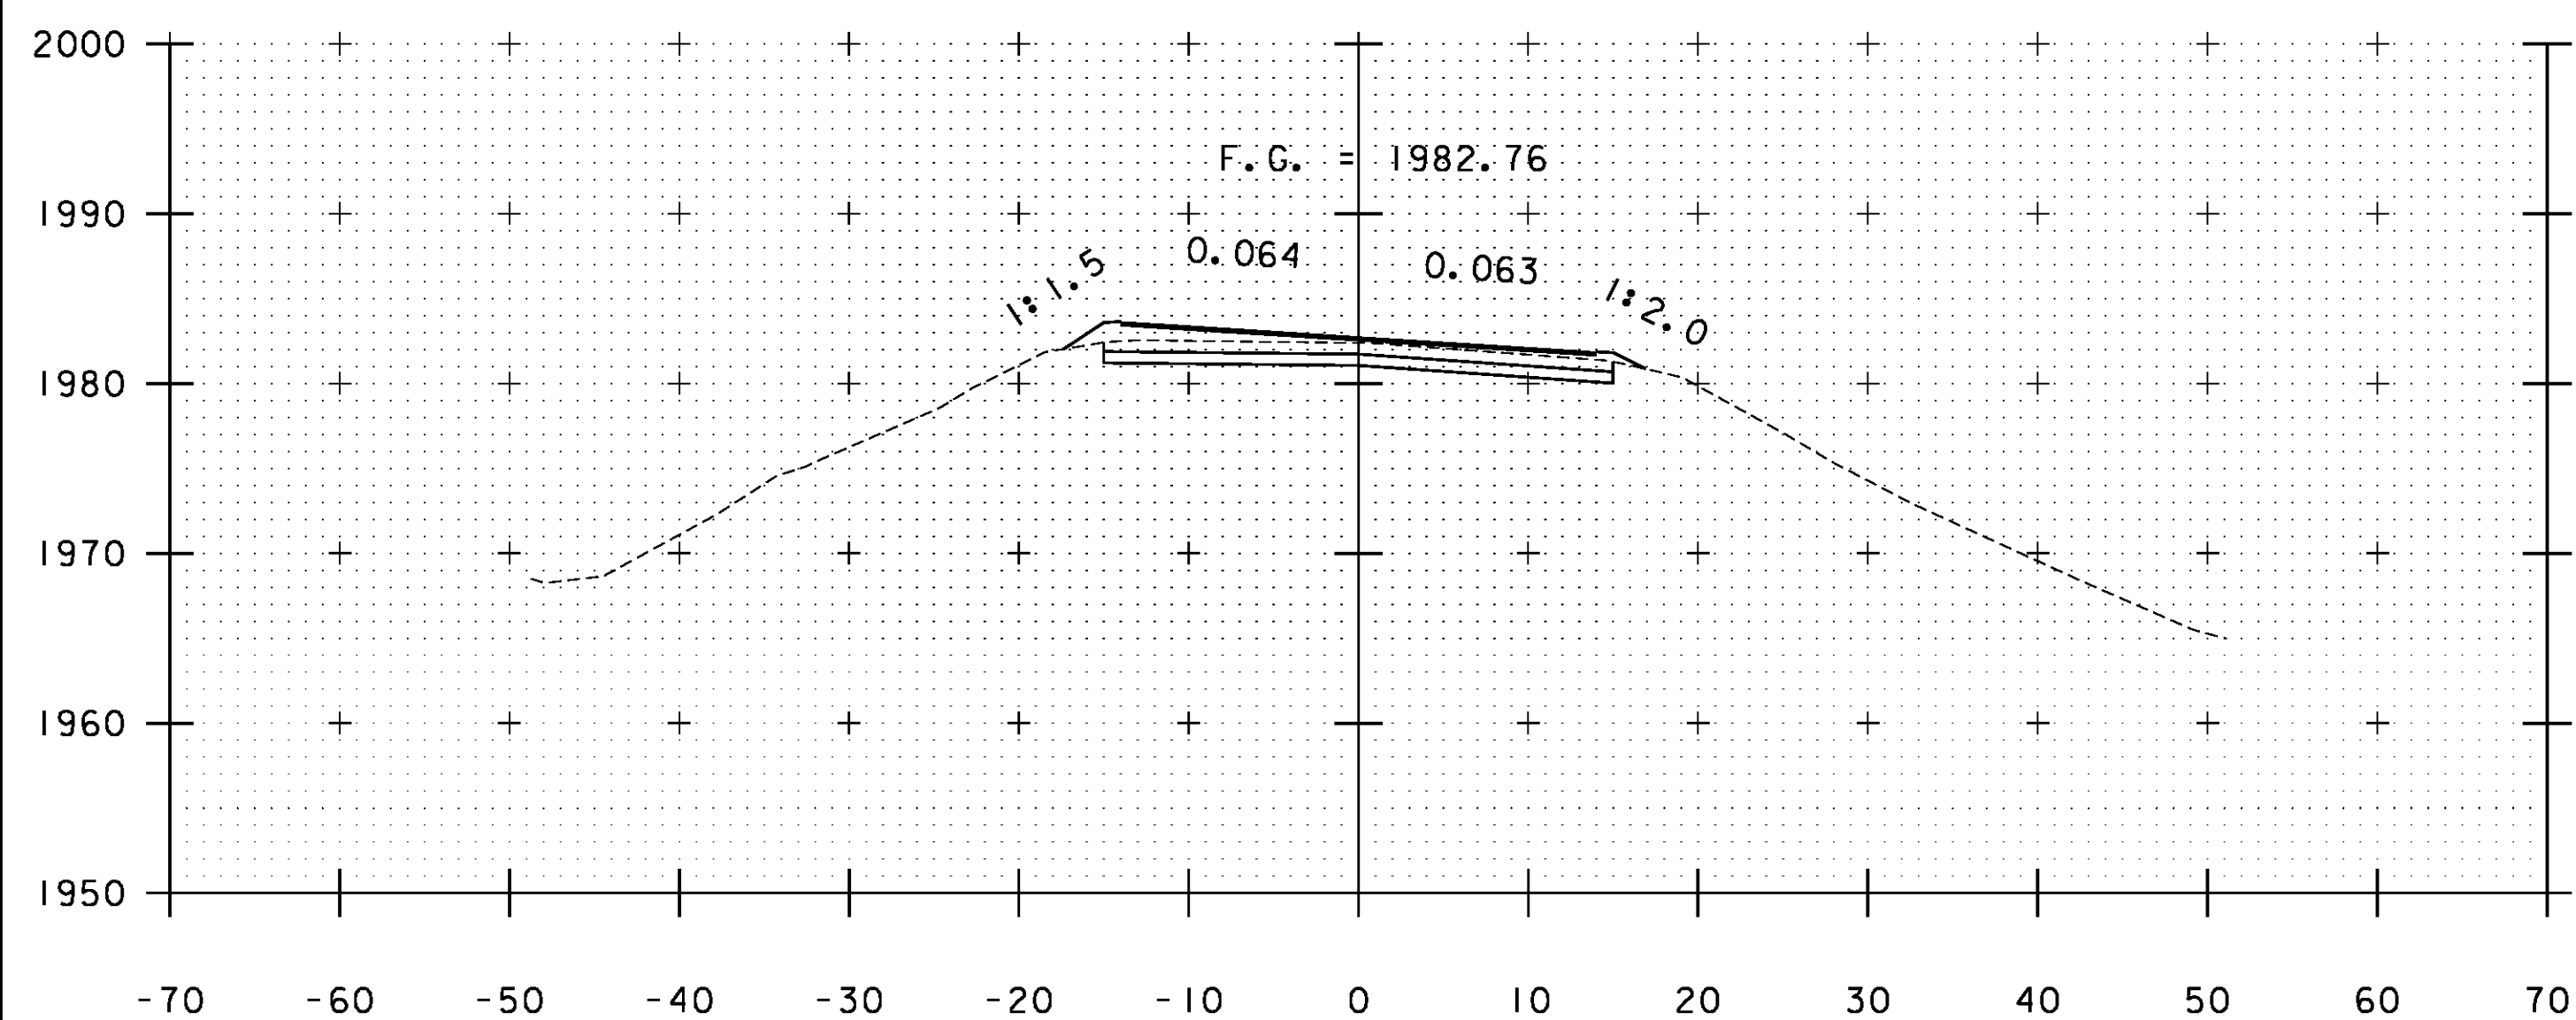

A 22+50

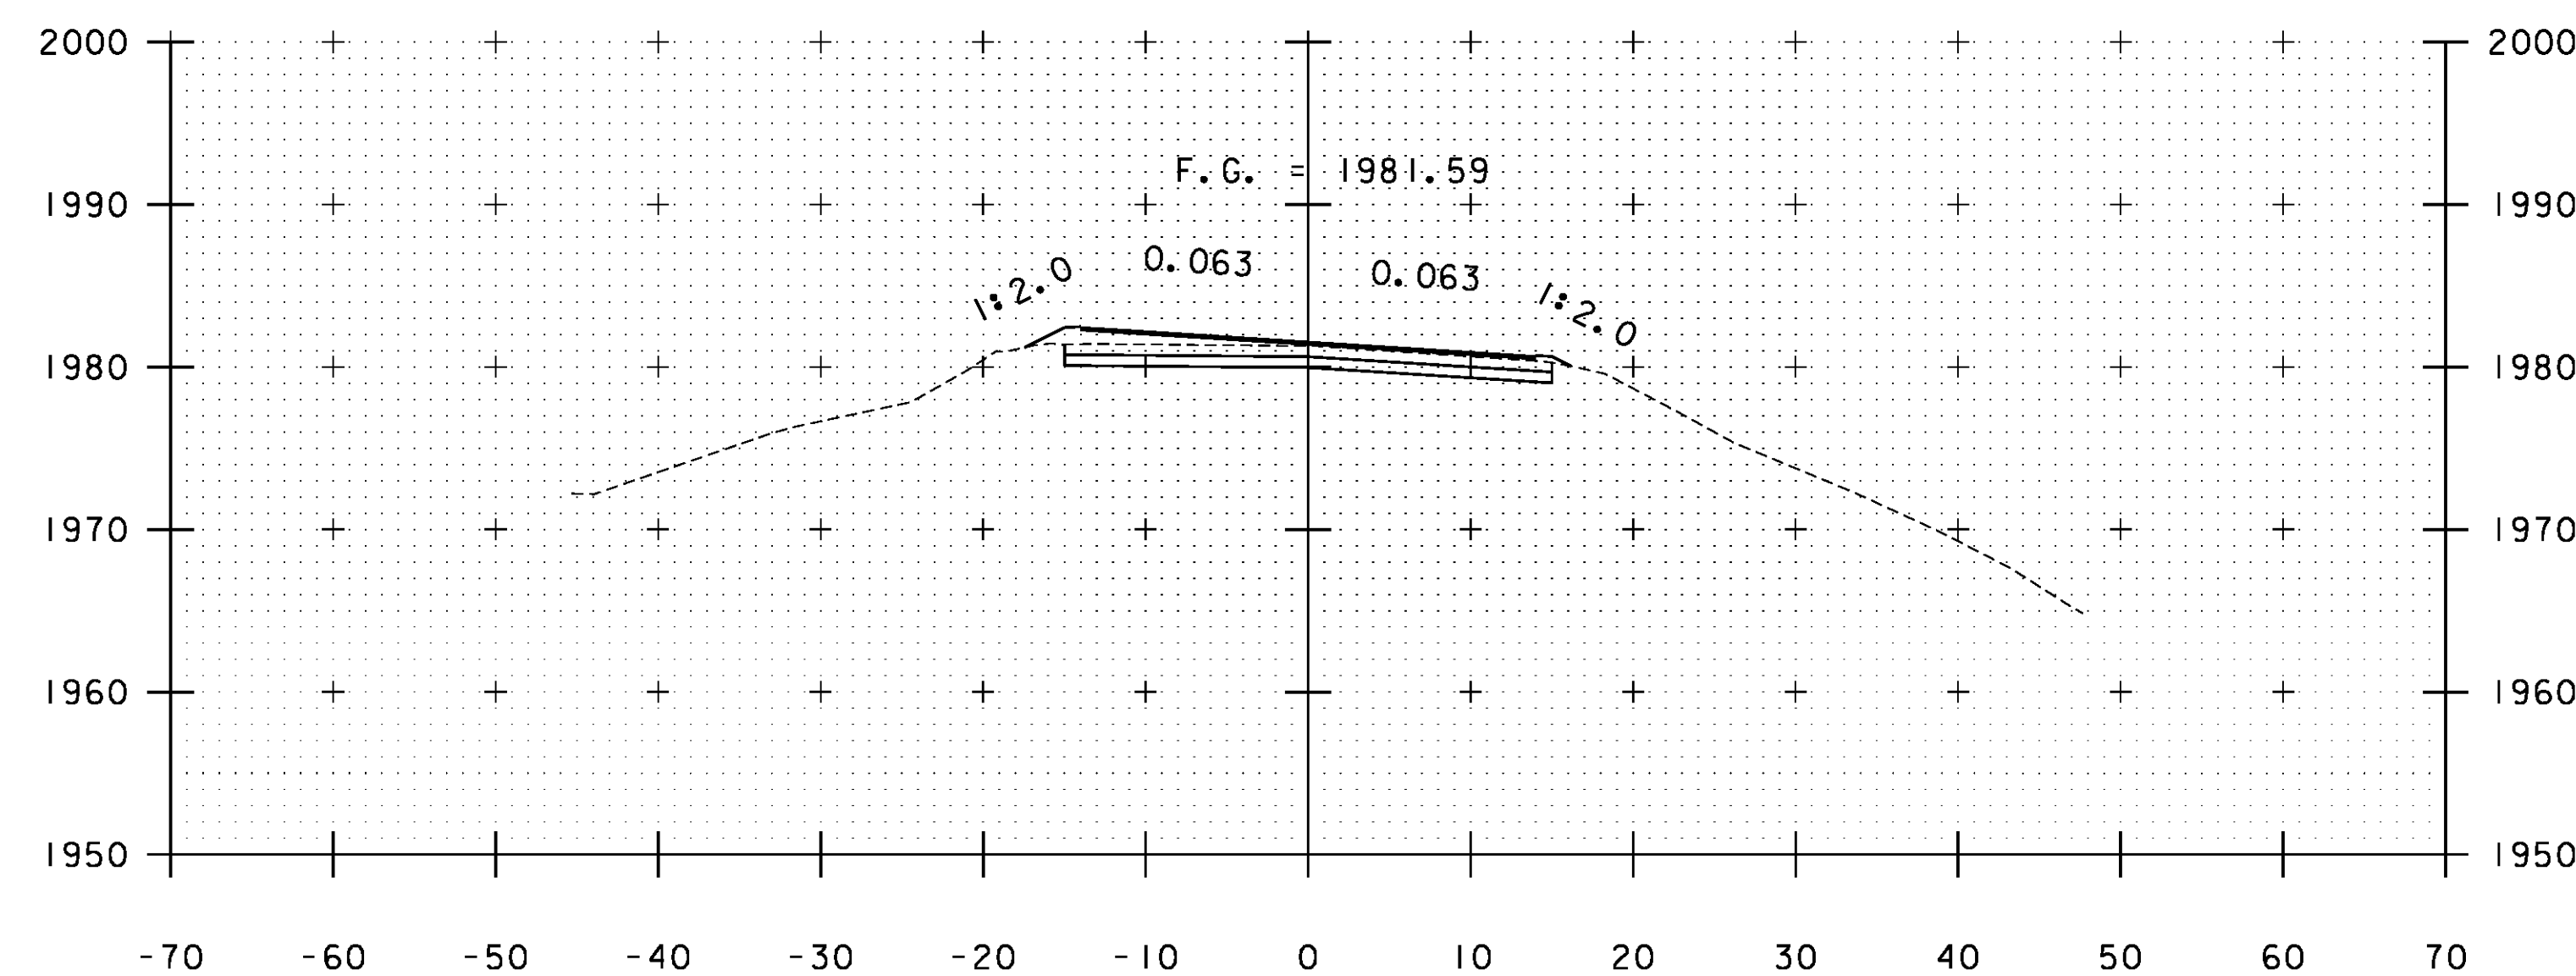

A 23+00

STA. A 22+50 TO STA. A 23+50

PROJECT NAME:	WARDSBORO-JAMAICA	PLOT DATE:	2/26/2014
PROJECT NUMBER:	ER STP 013-1(17)	DRAWN BY:	B. KIPP
FILE NAME:	xs.dgn	CHECKED BY:	HSD
PROJECT LEADER:	K. UPMAL	CROSS SECTIONS	SHEET 181 OF 444
DESIGNED BY:	B. KIPP		