




A 25+00

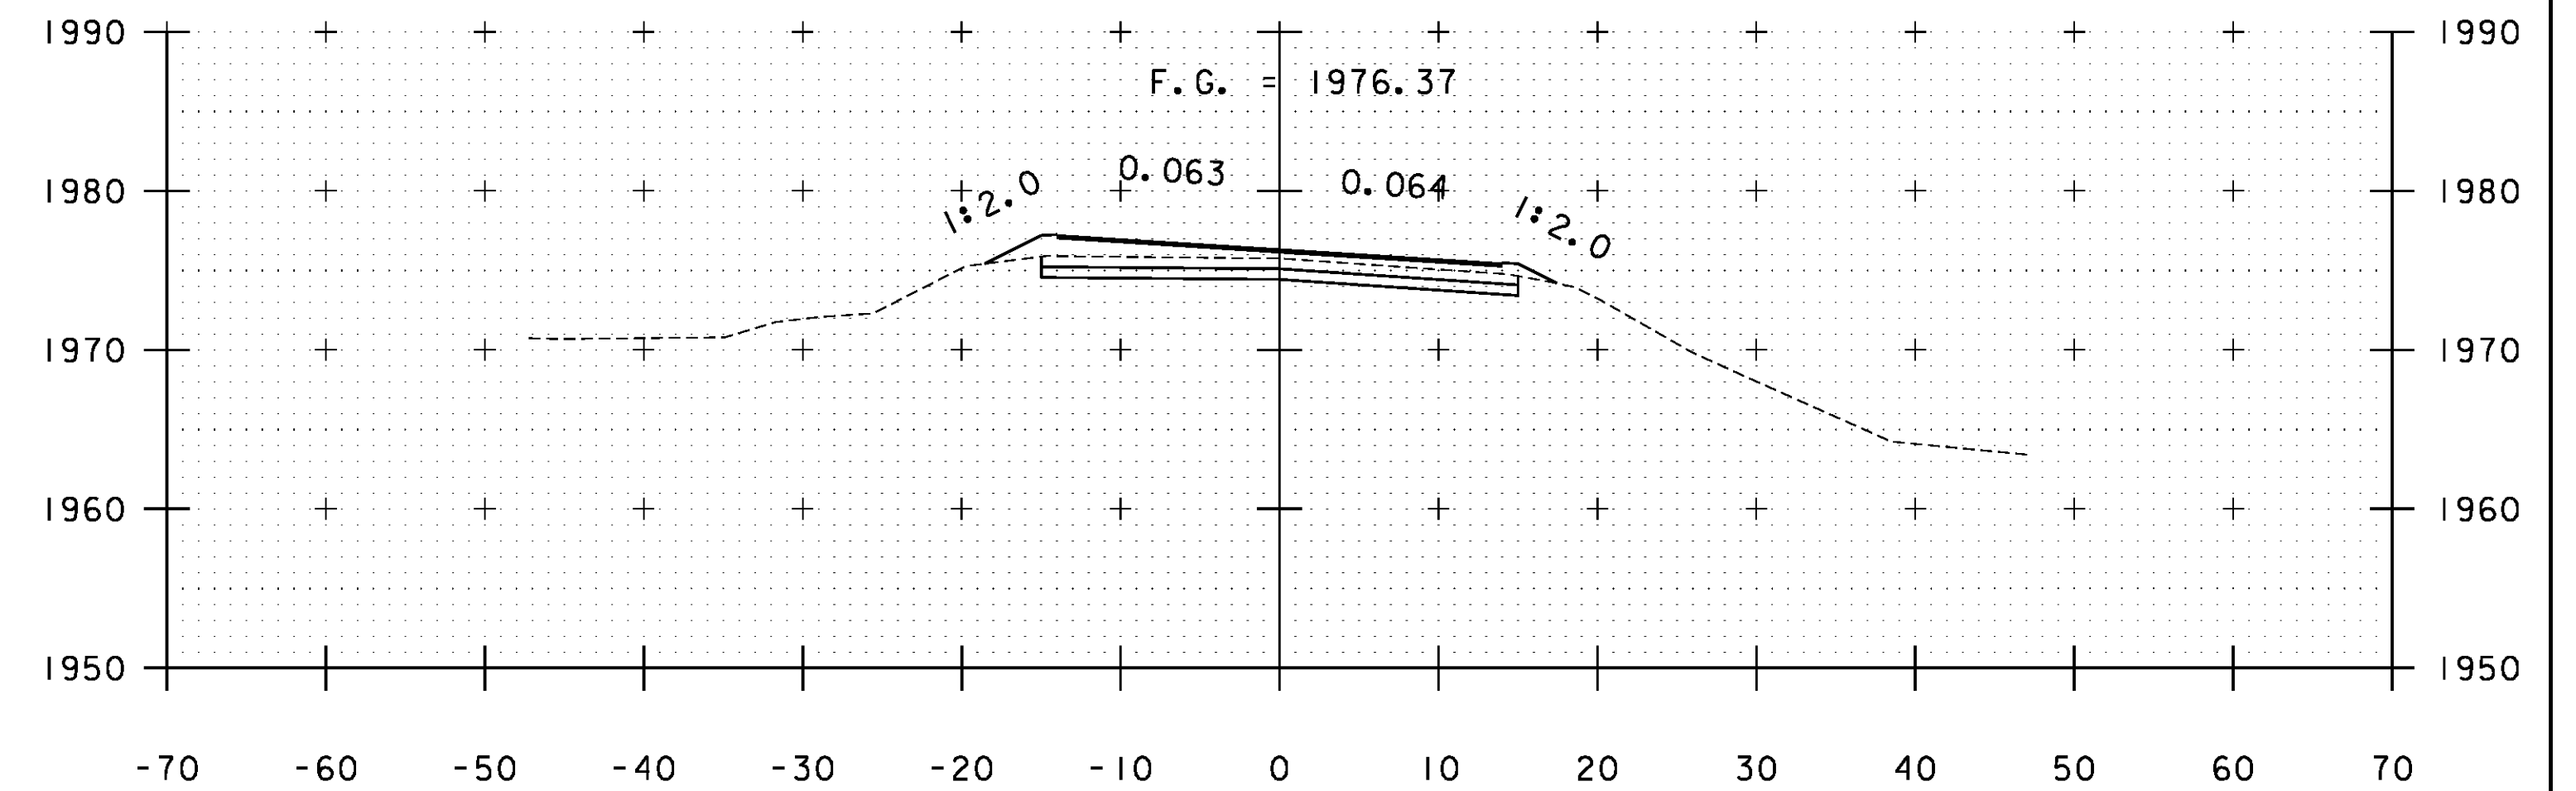


A 26+50

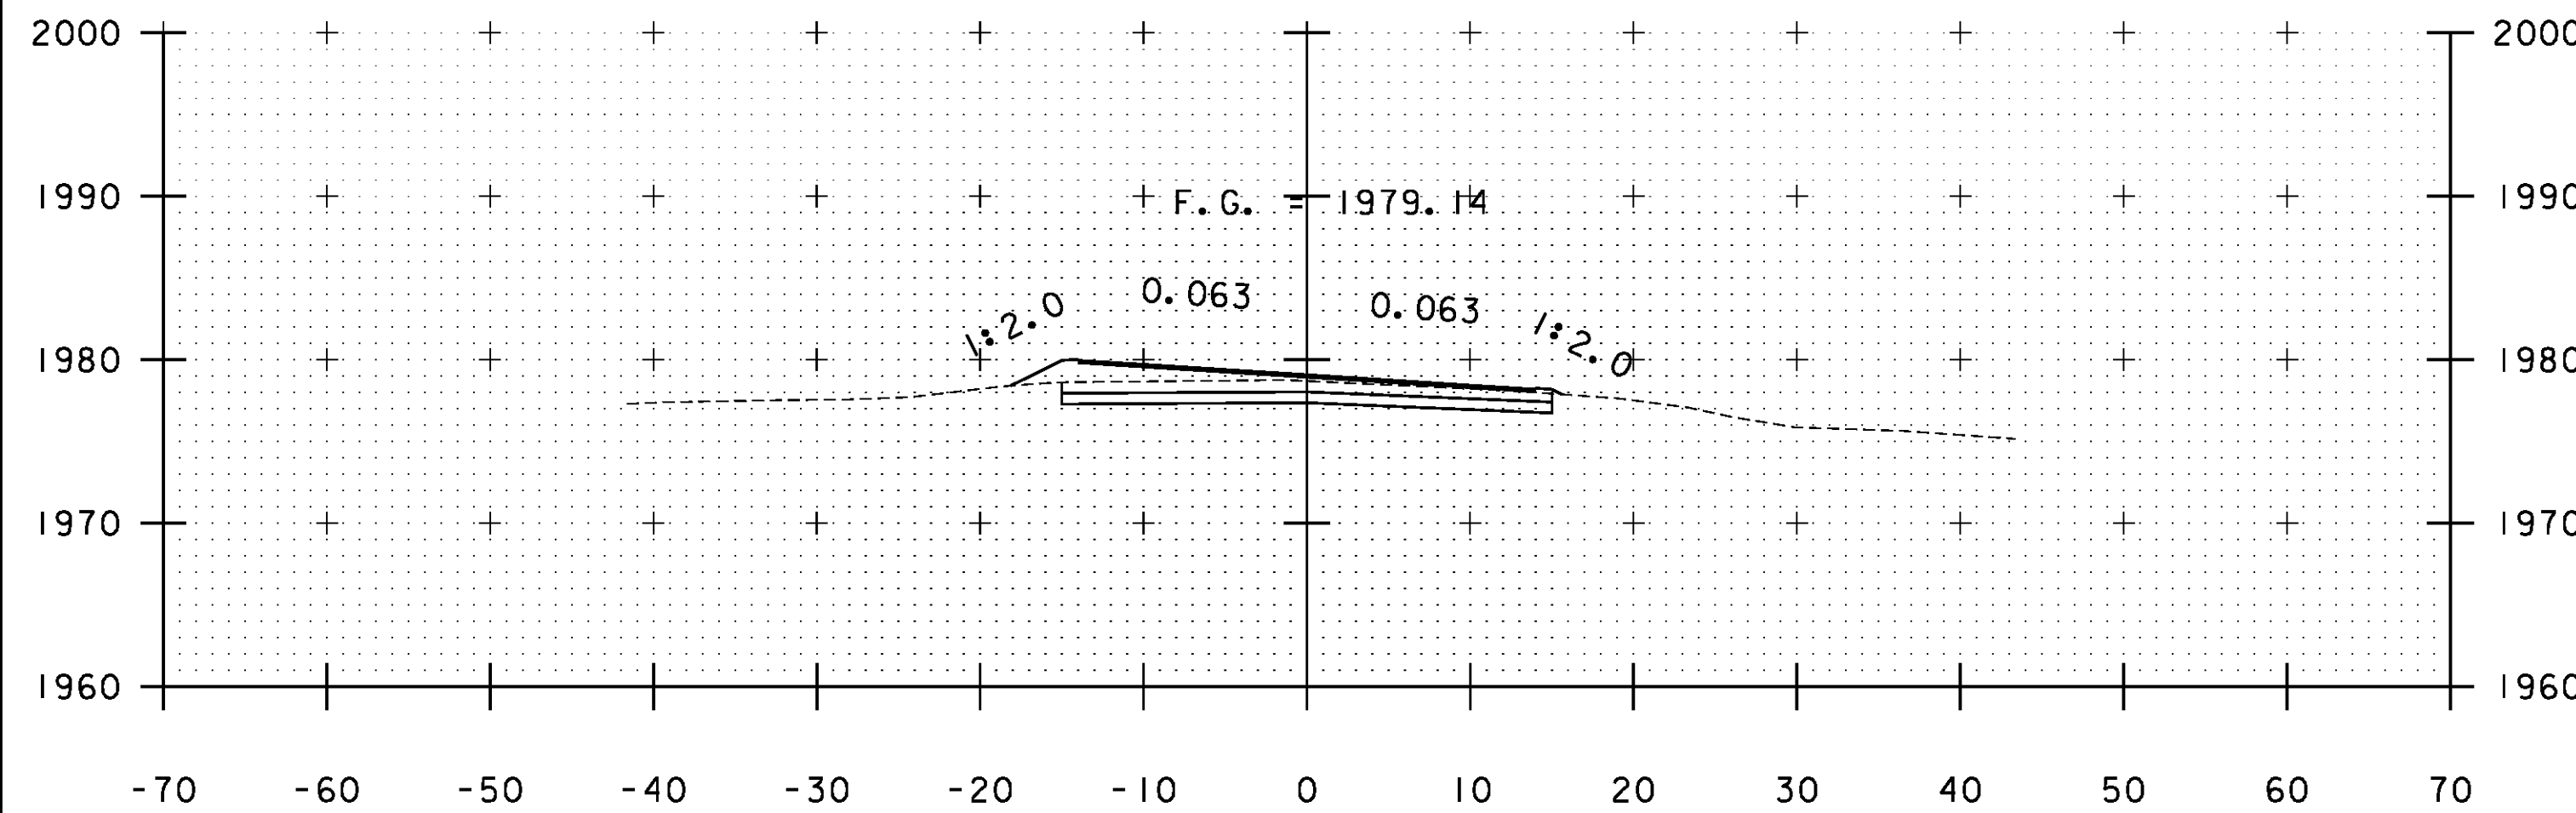


A 24+50

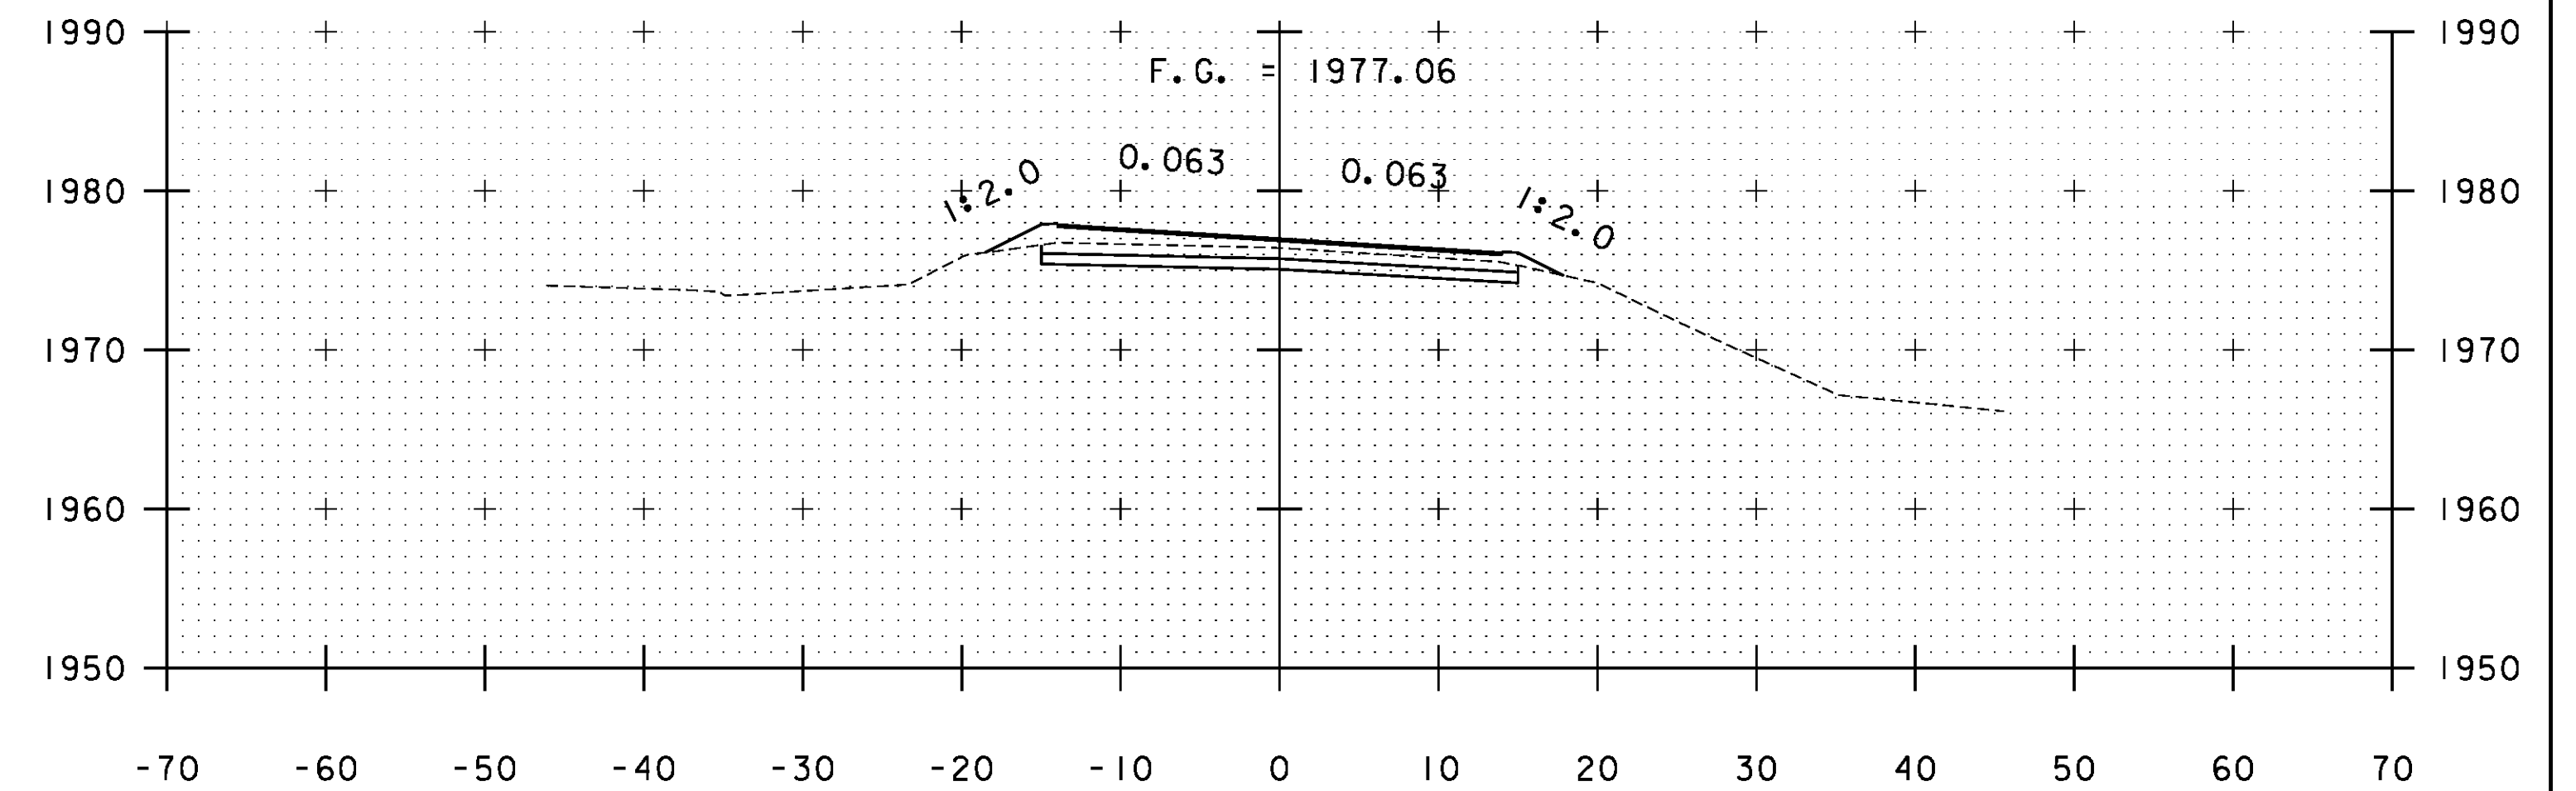

A 26+00

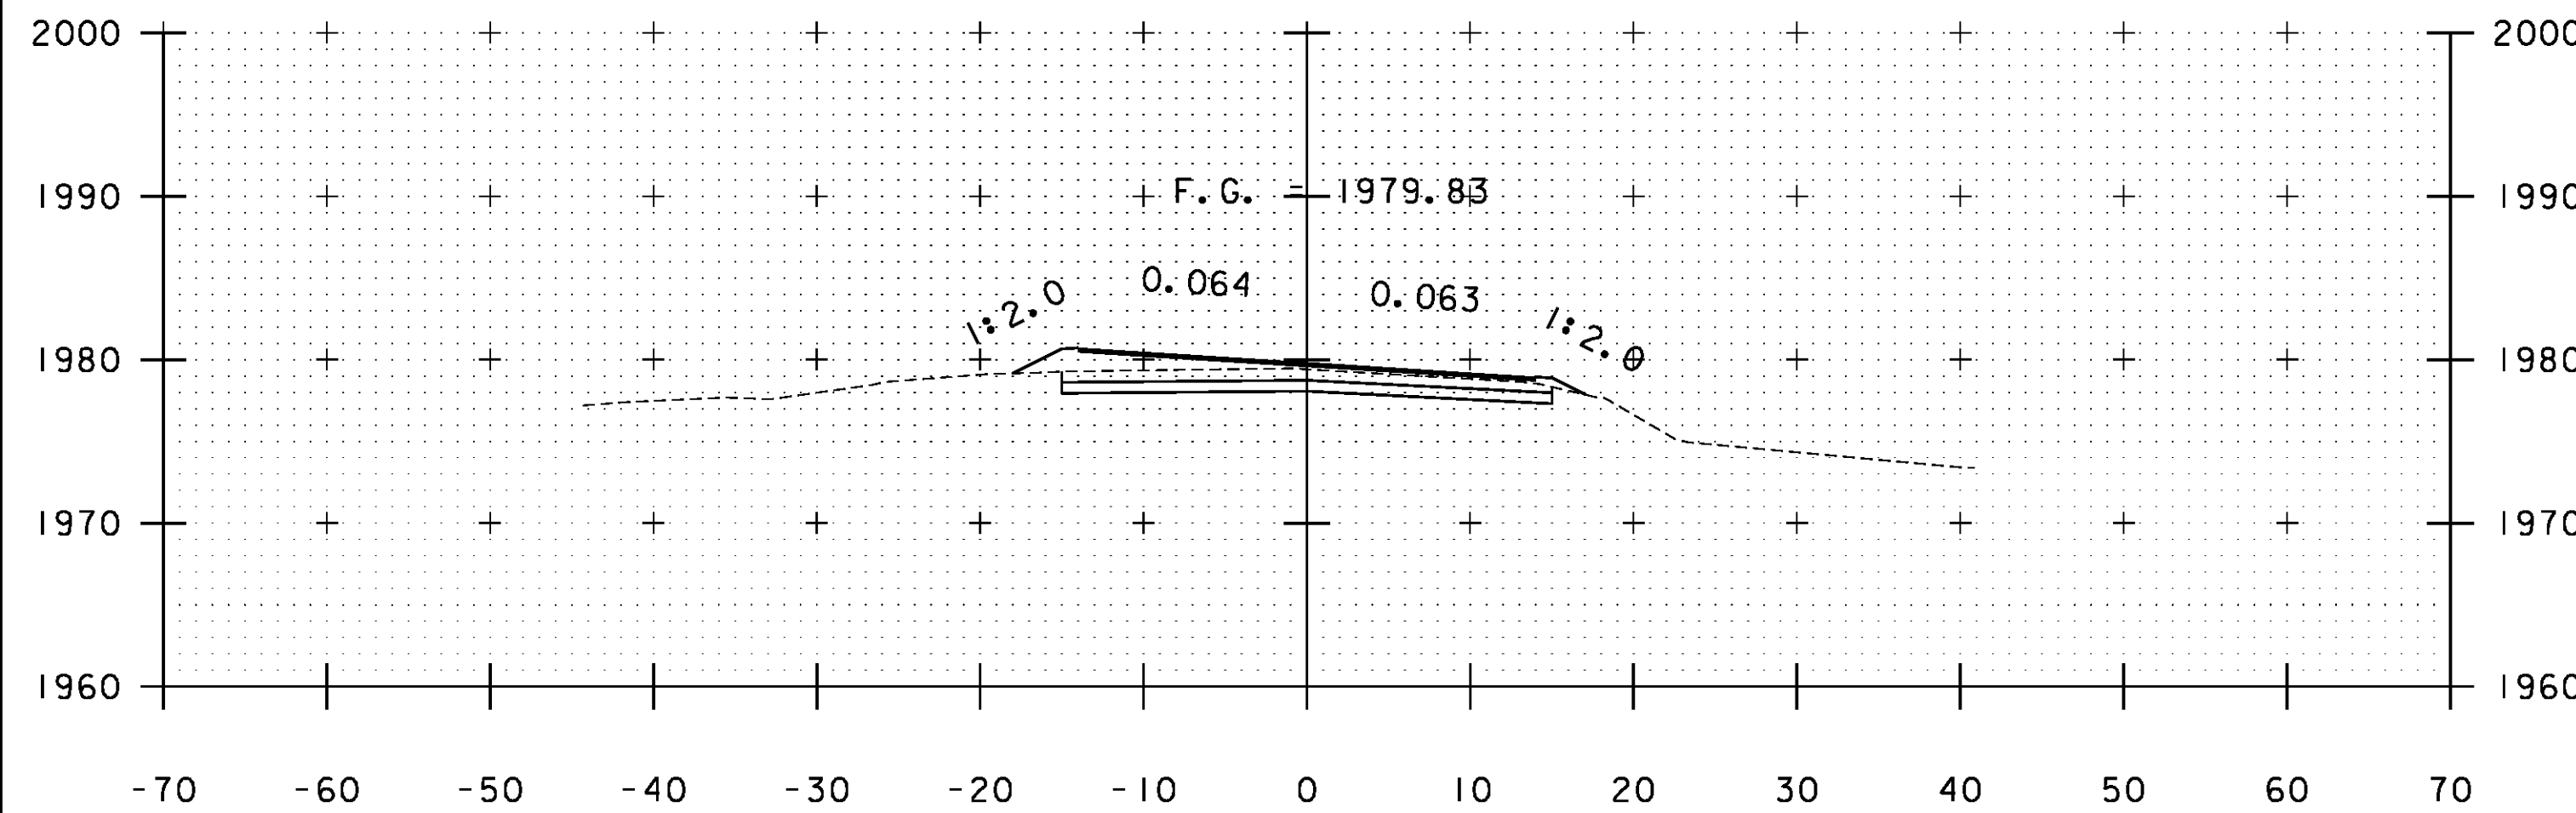

A 24+00

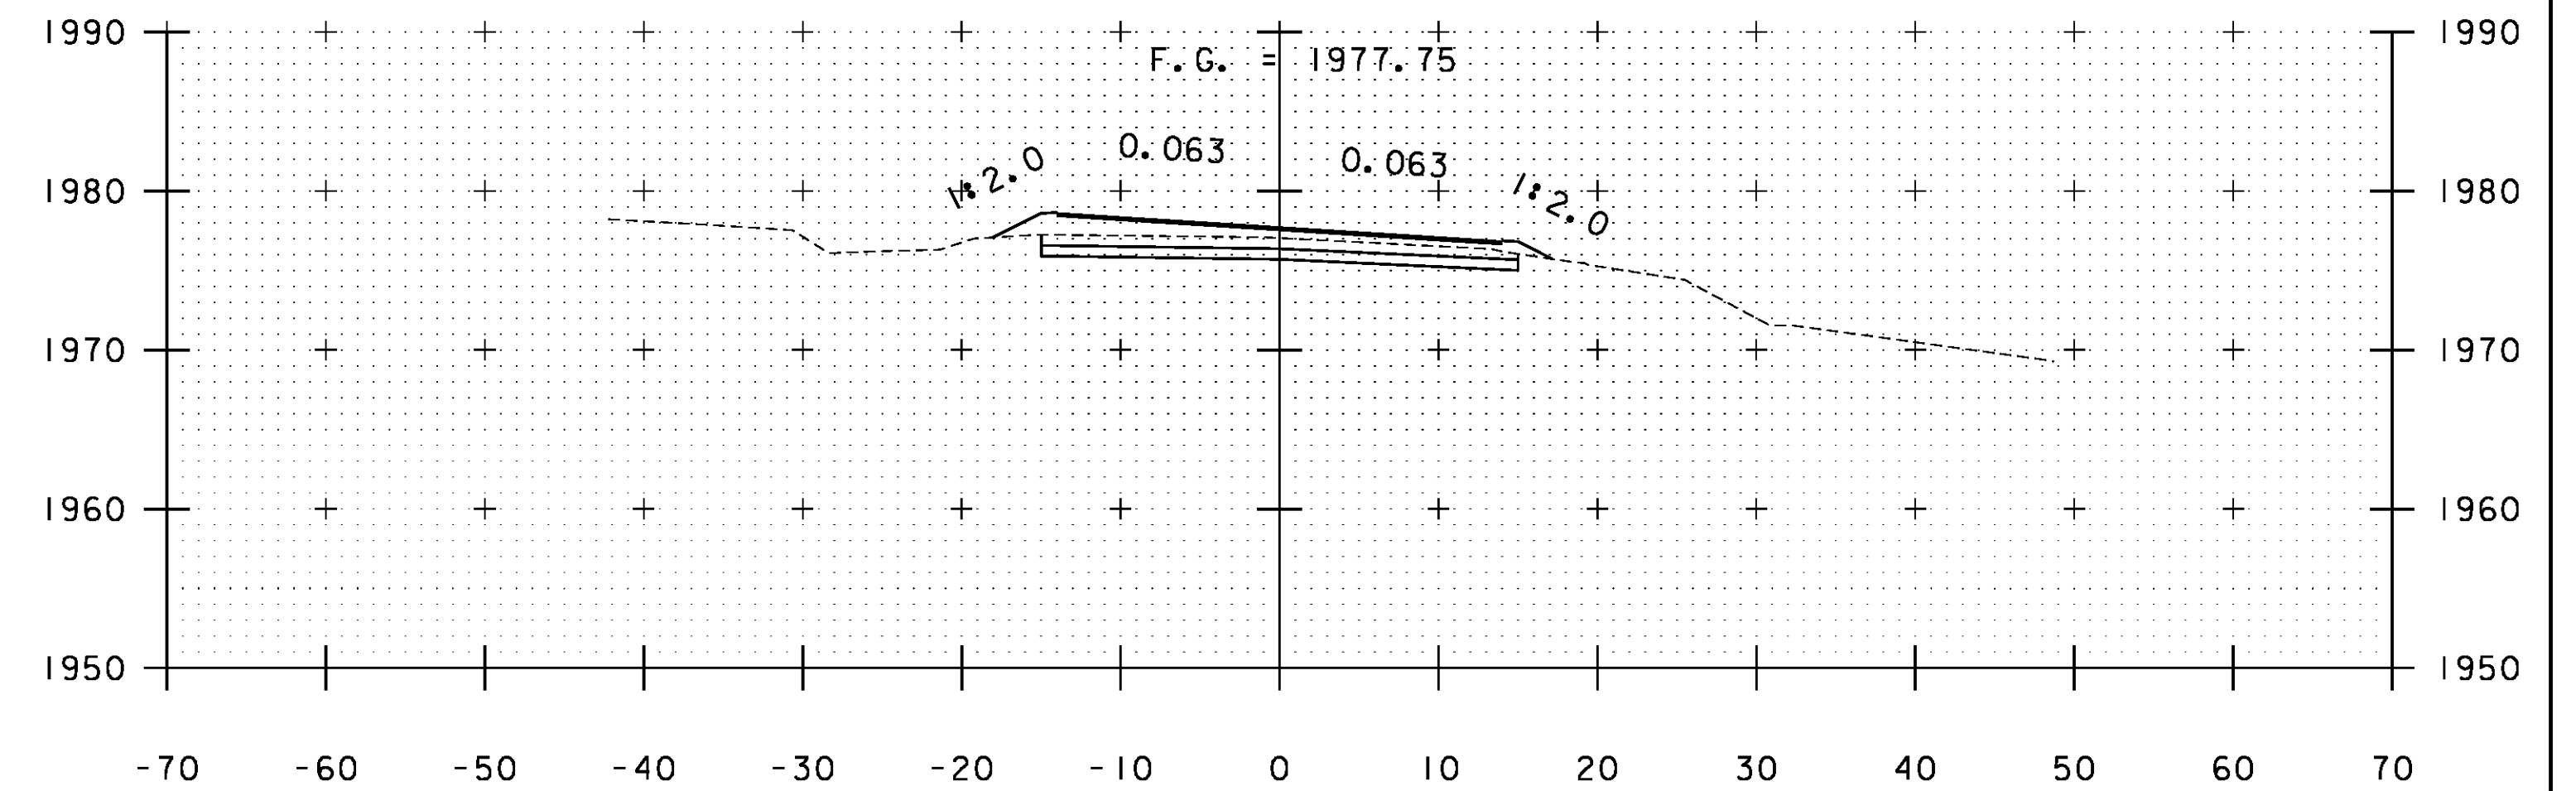

A 25+50

STA. A 24+00 TO STA. A 26+50

PROJECT NAME: WARDBORO-JAMAICA	
PROJECT NUMBER: ER STP 013-1(17)	
FILE NAME: xs.dgn	PLOT DATE: 2/26/2014
PROJECT LEADER: K. UPMAL	DRAWN BY: B. KIPP
DESIGNED BY: B. KIPP	CHECKED BY: HSD
CROSS SECTIONS	SHEET 182 OF 444