




A 27+50

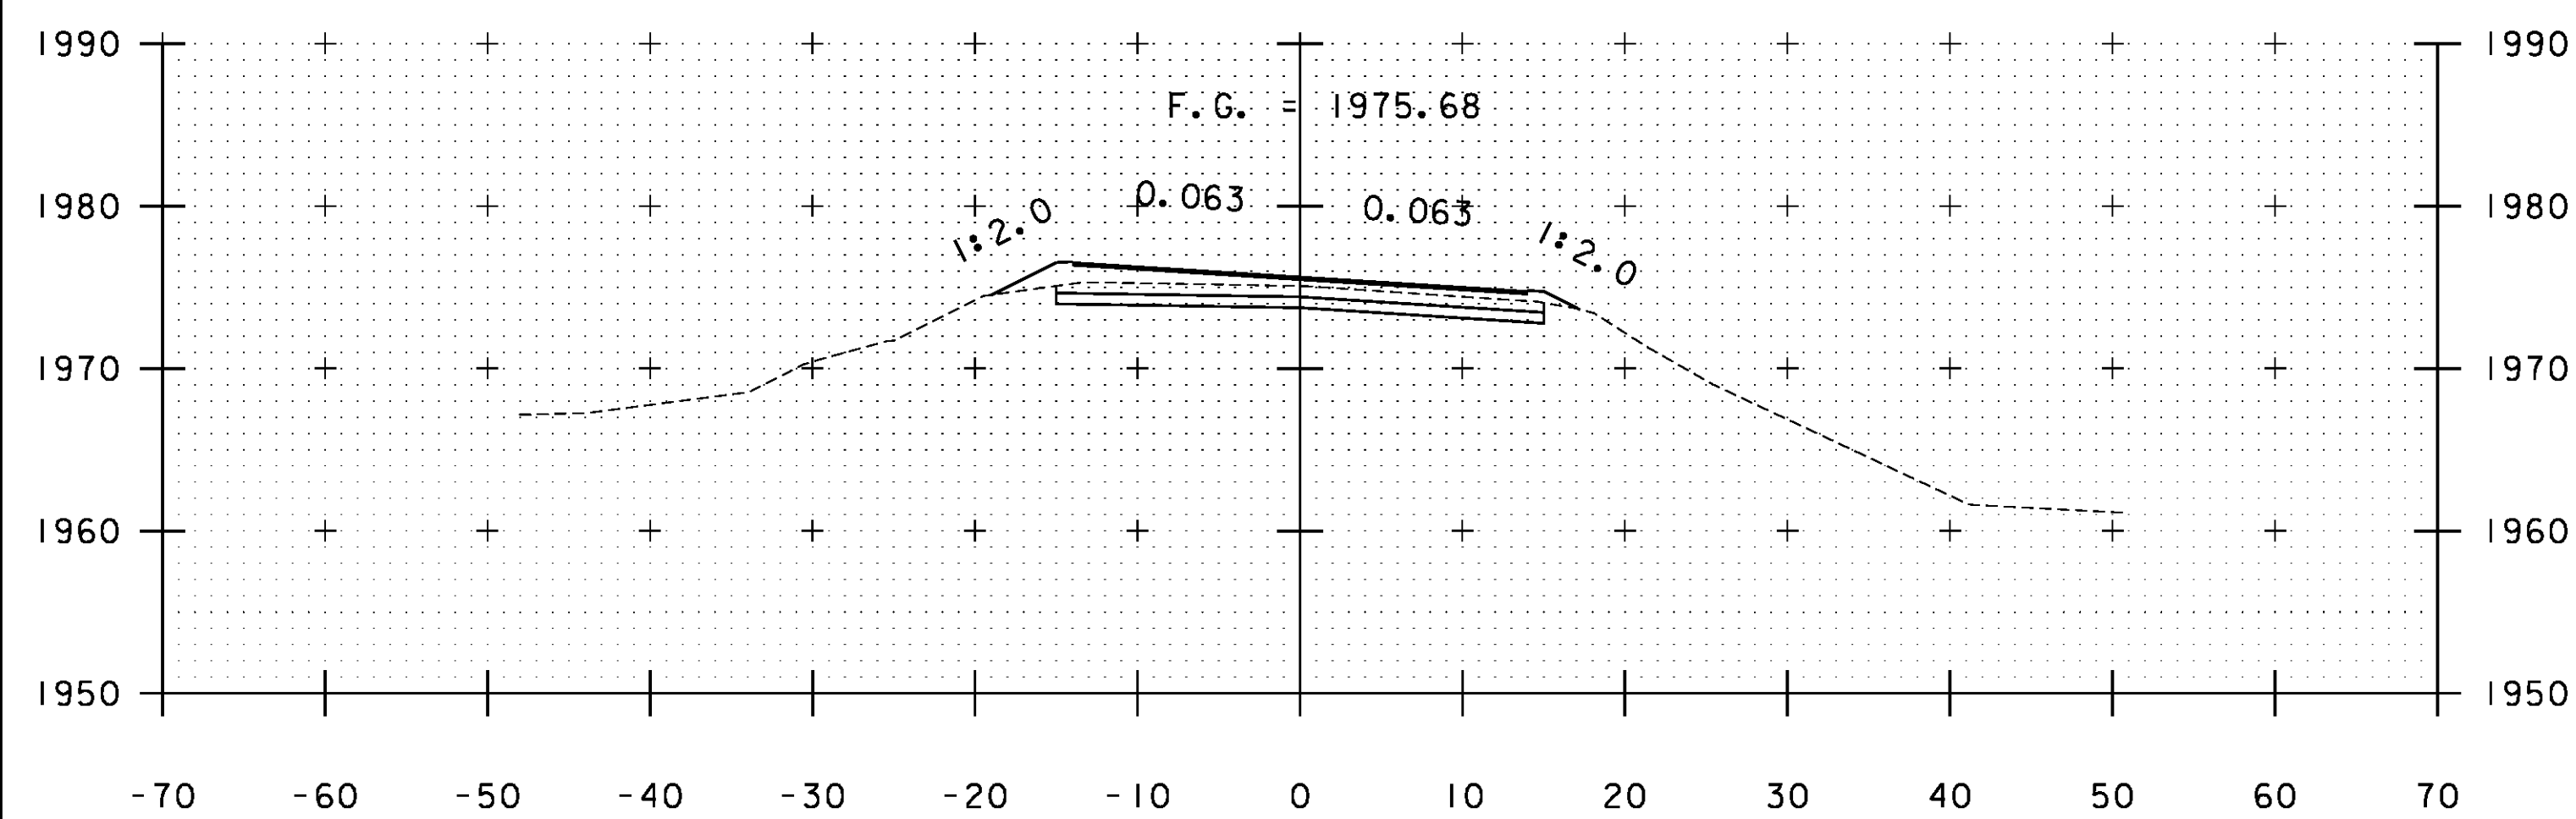

A 27+00

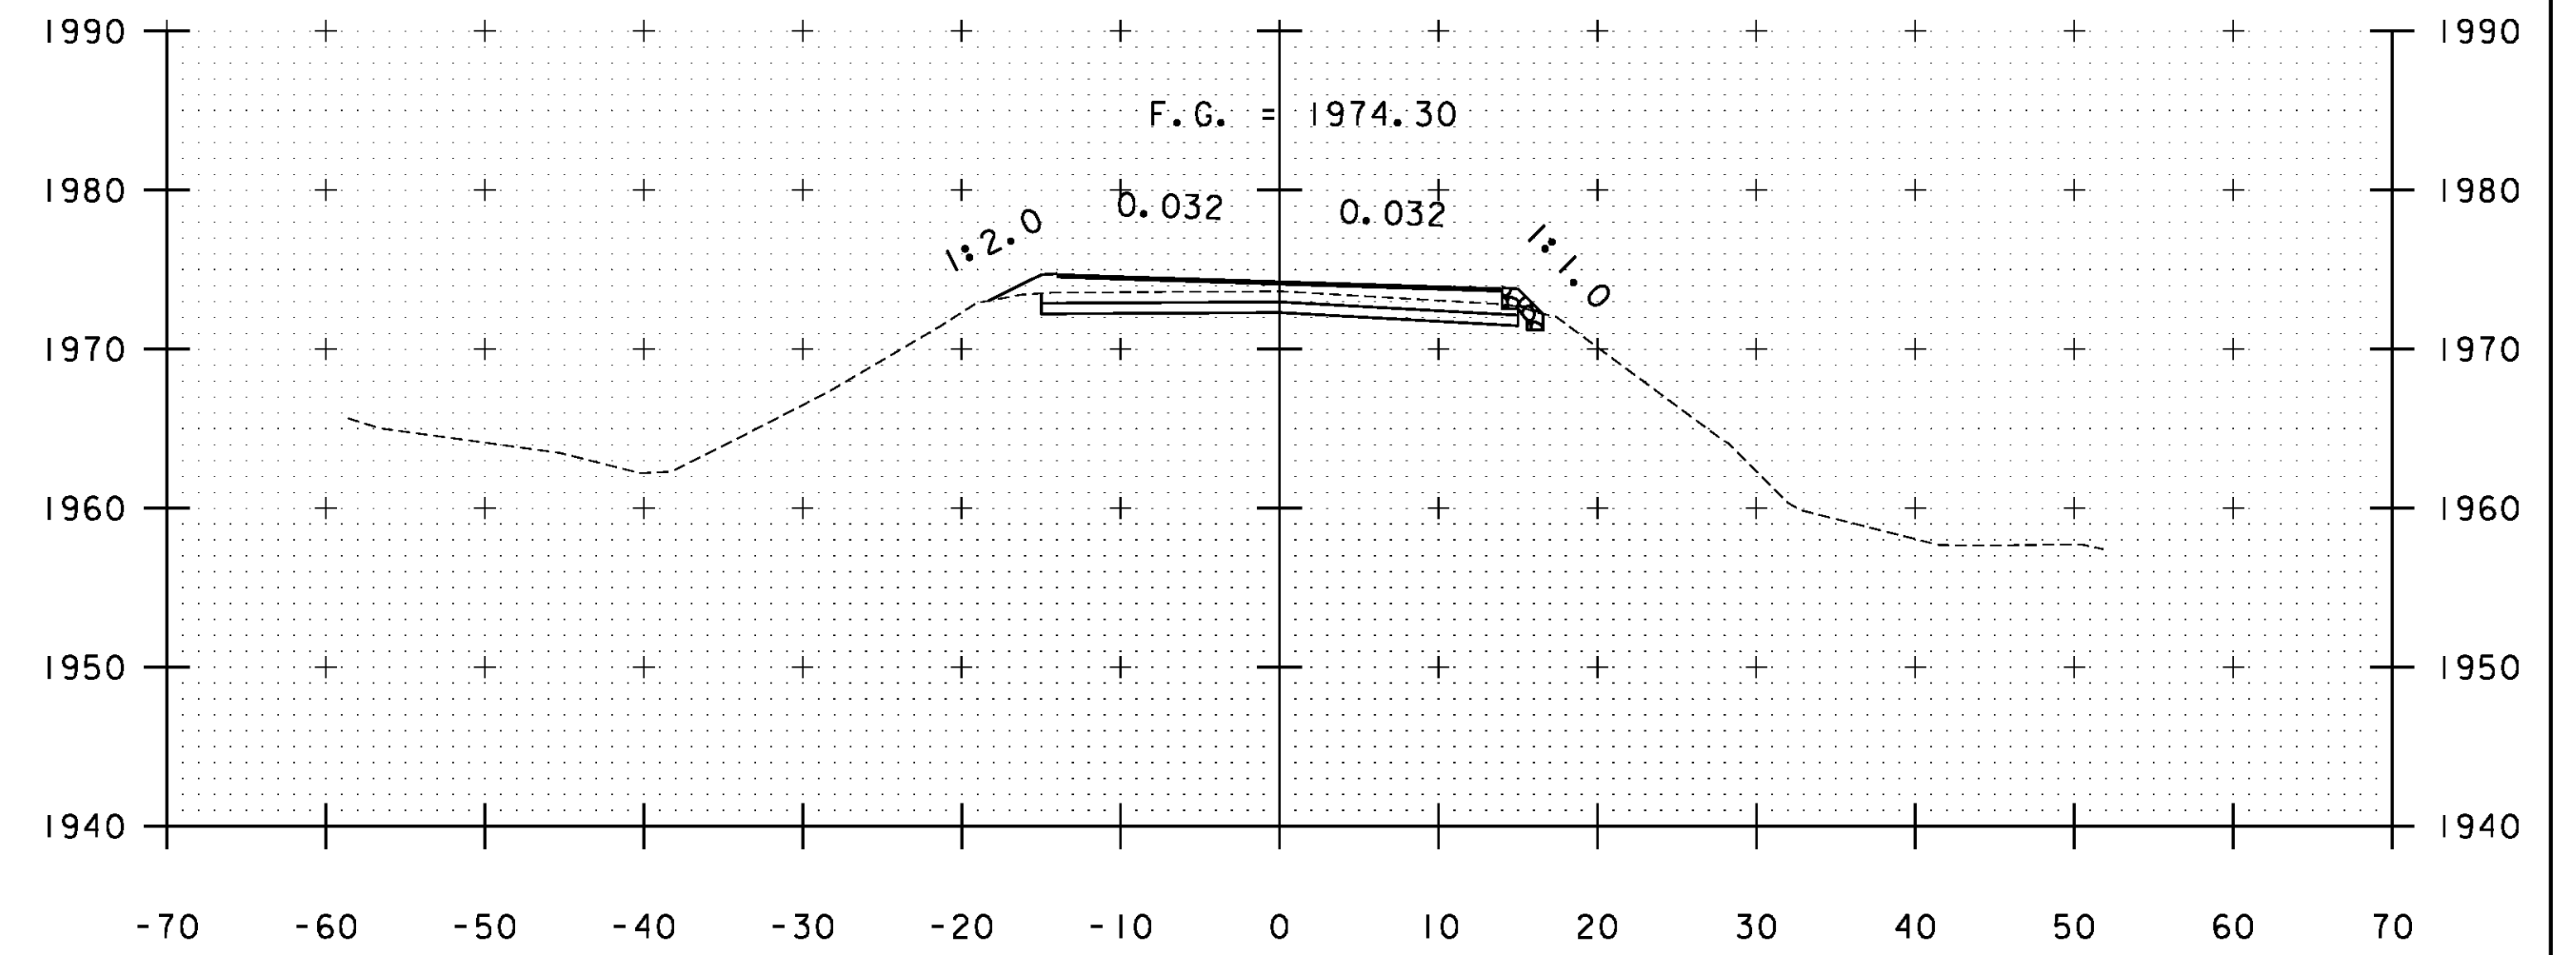

A 28+00

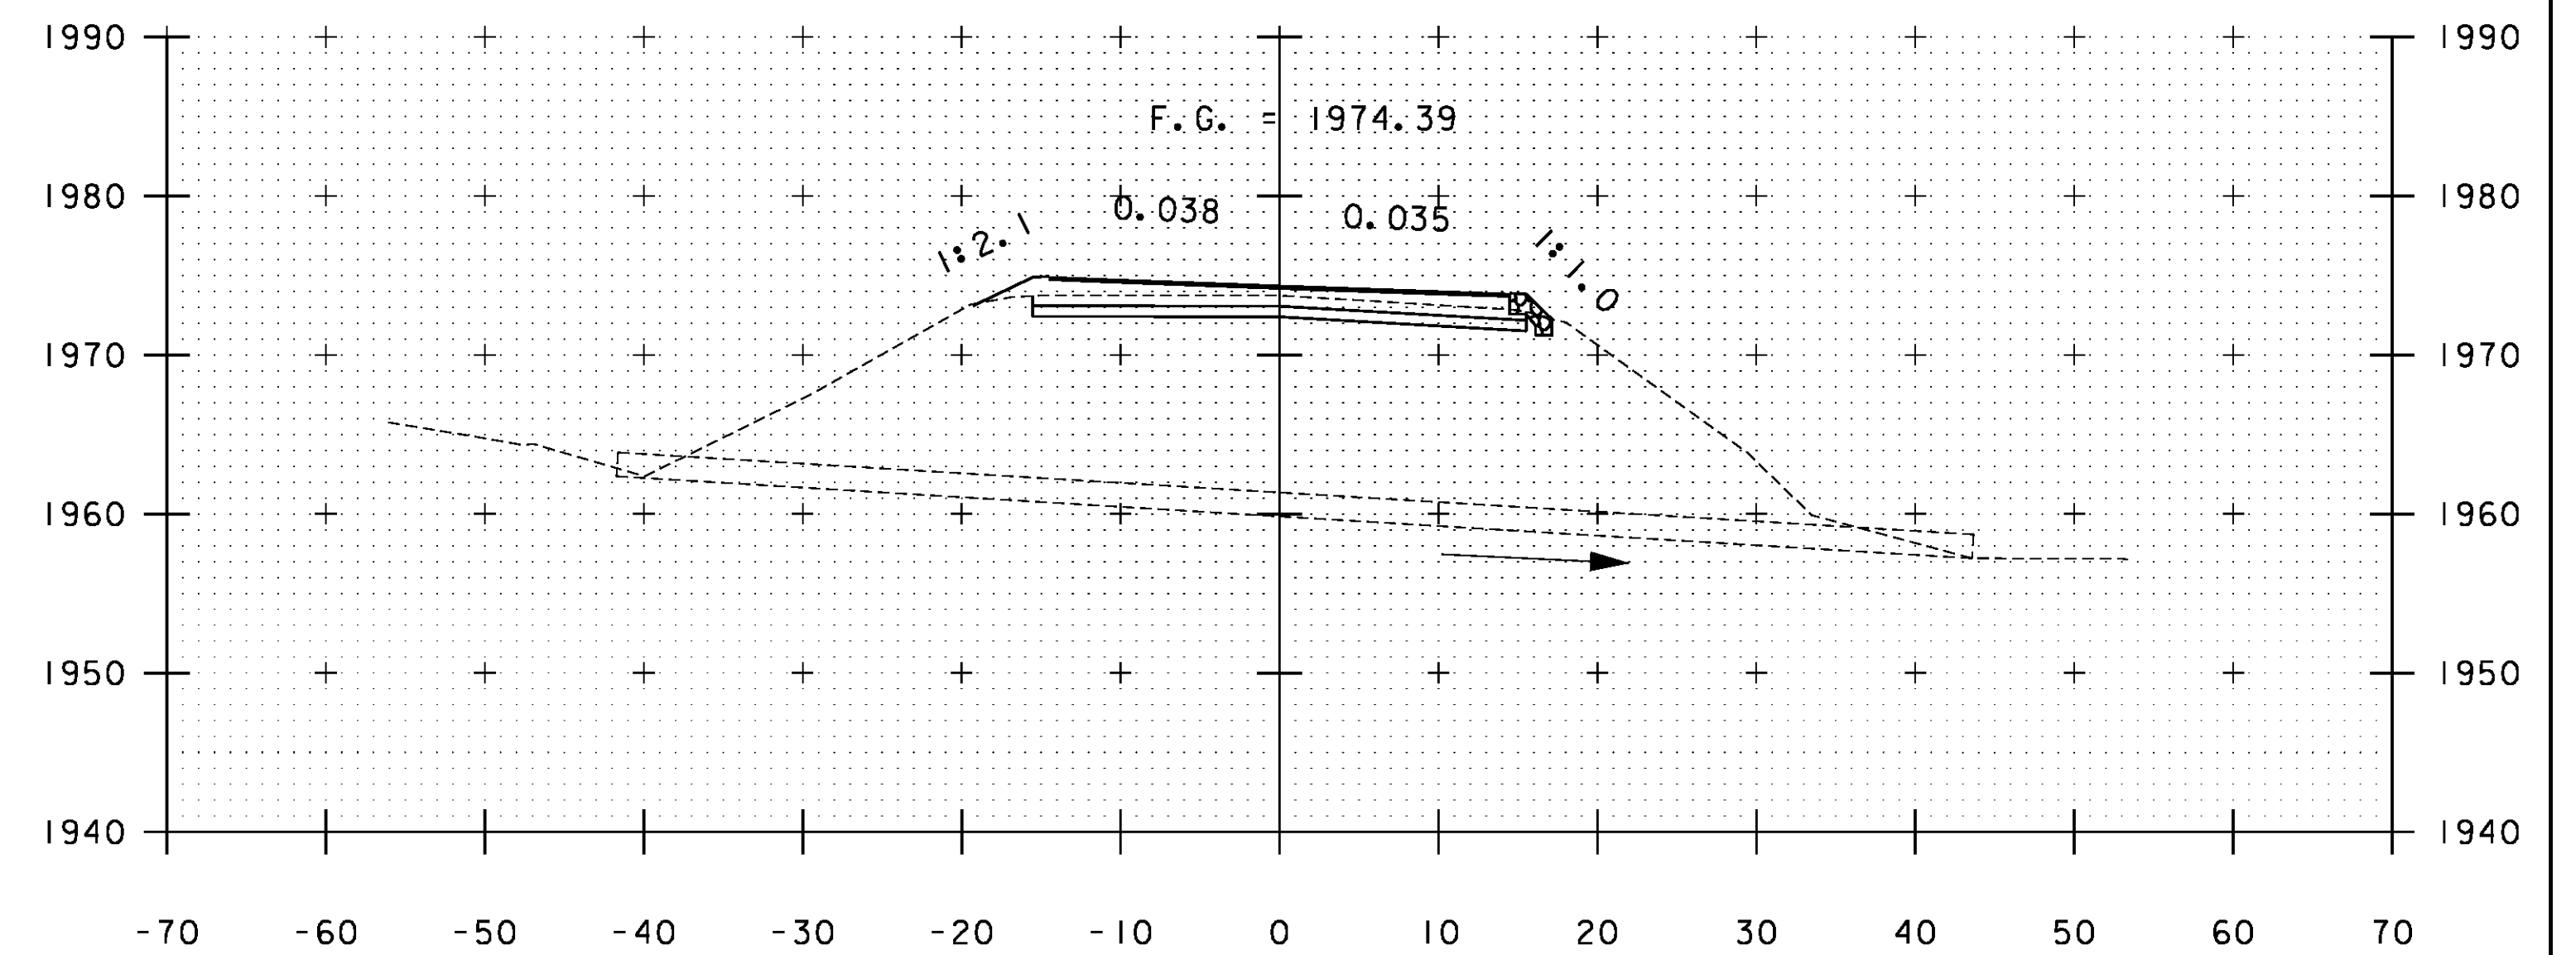

A 27+93

STA. A 27+00 TO STA. A 28+00

PROJECT NAME: WARDBORO-JAMAICA	
PROJECT NUMBER: ER STP 013-1(17)	
FILE NAME: xs.dgn	PLOT DATE: 2/26/2014
PROJECT LEADER: K. UPMAL	DRAWN BY: B. KIPP
DESIGNED BY: B. KIPP	CHECKED BY: HSD
CROSS SECTIONS	SHEET 183 OF 444