




A 35+00

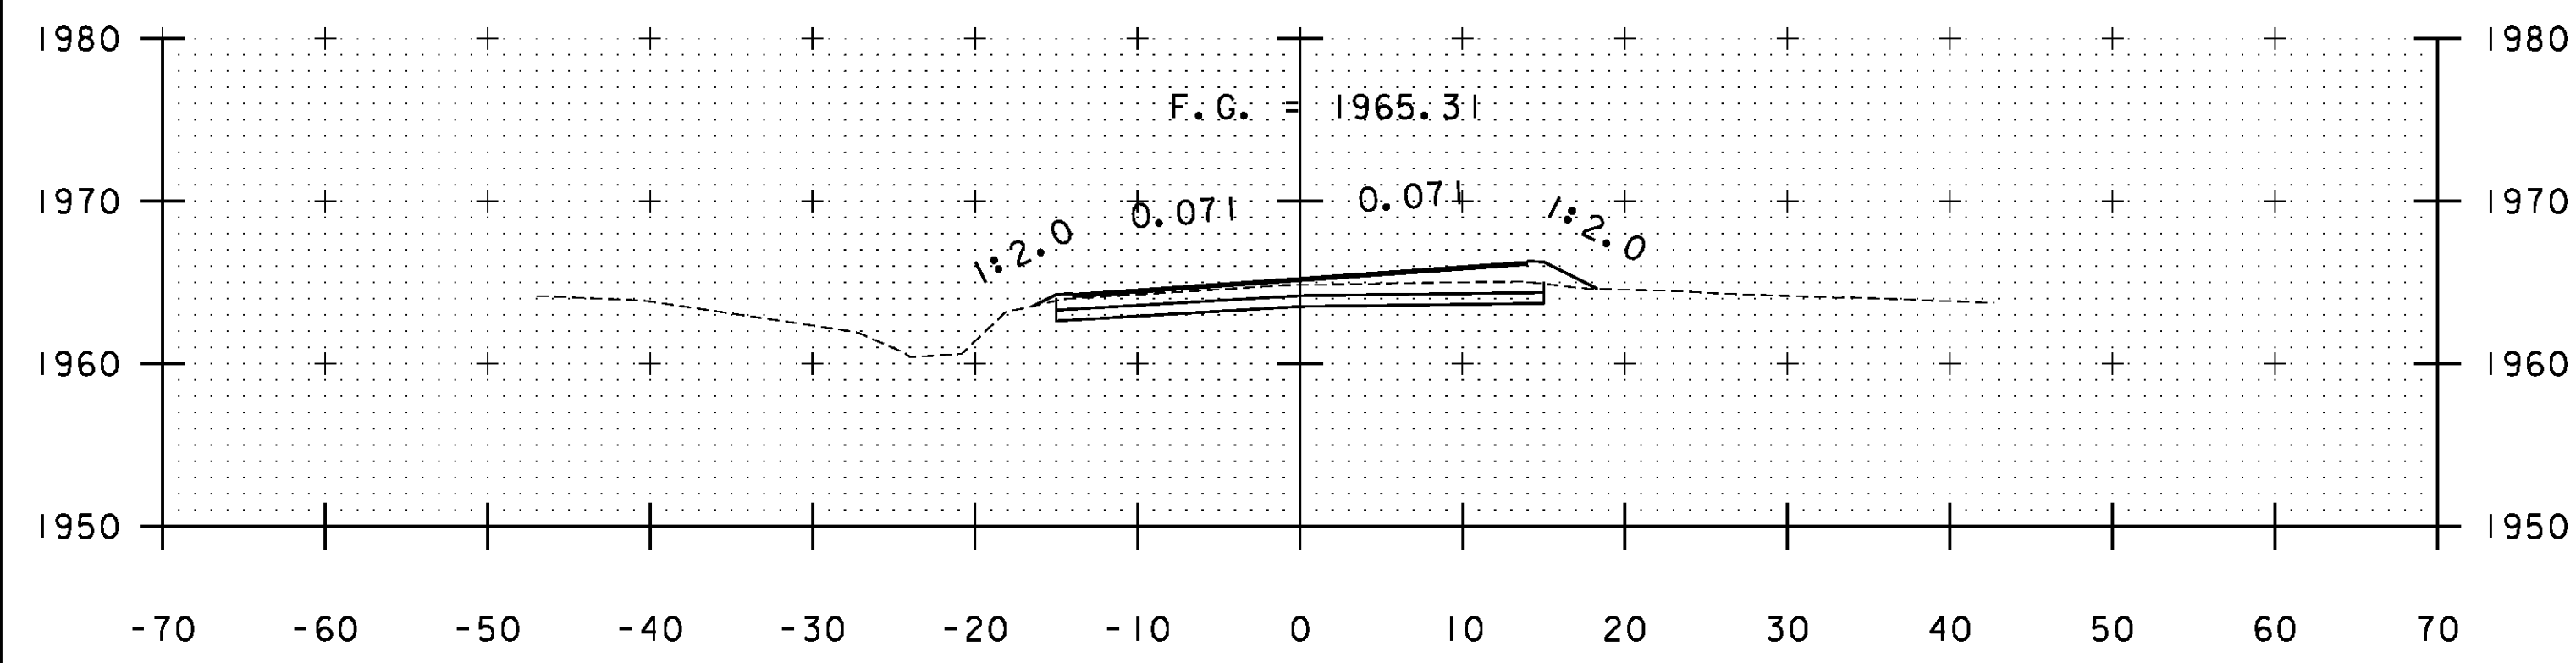


A 34+50

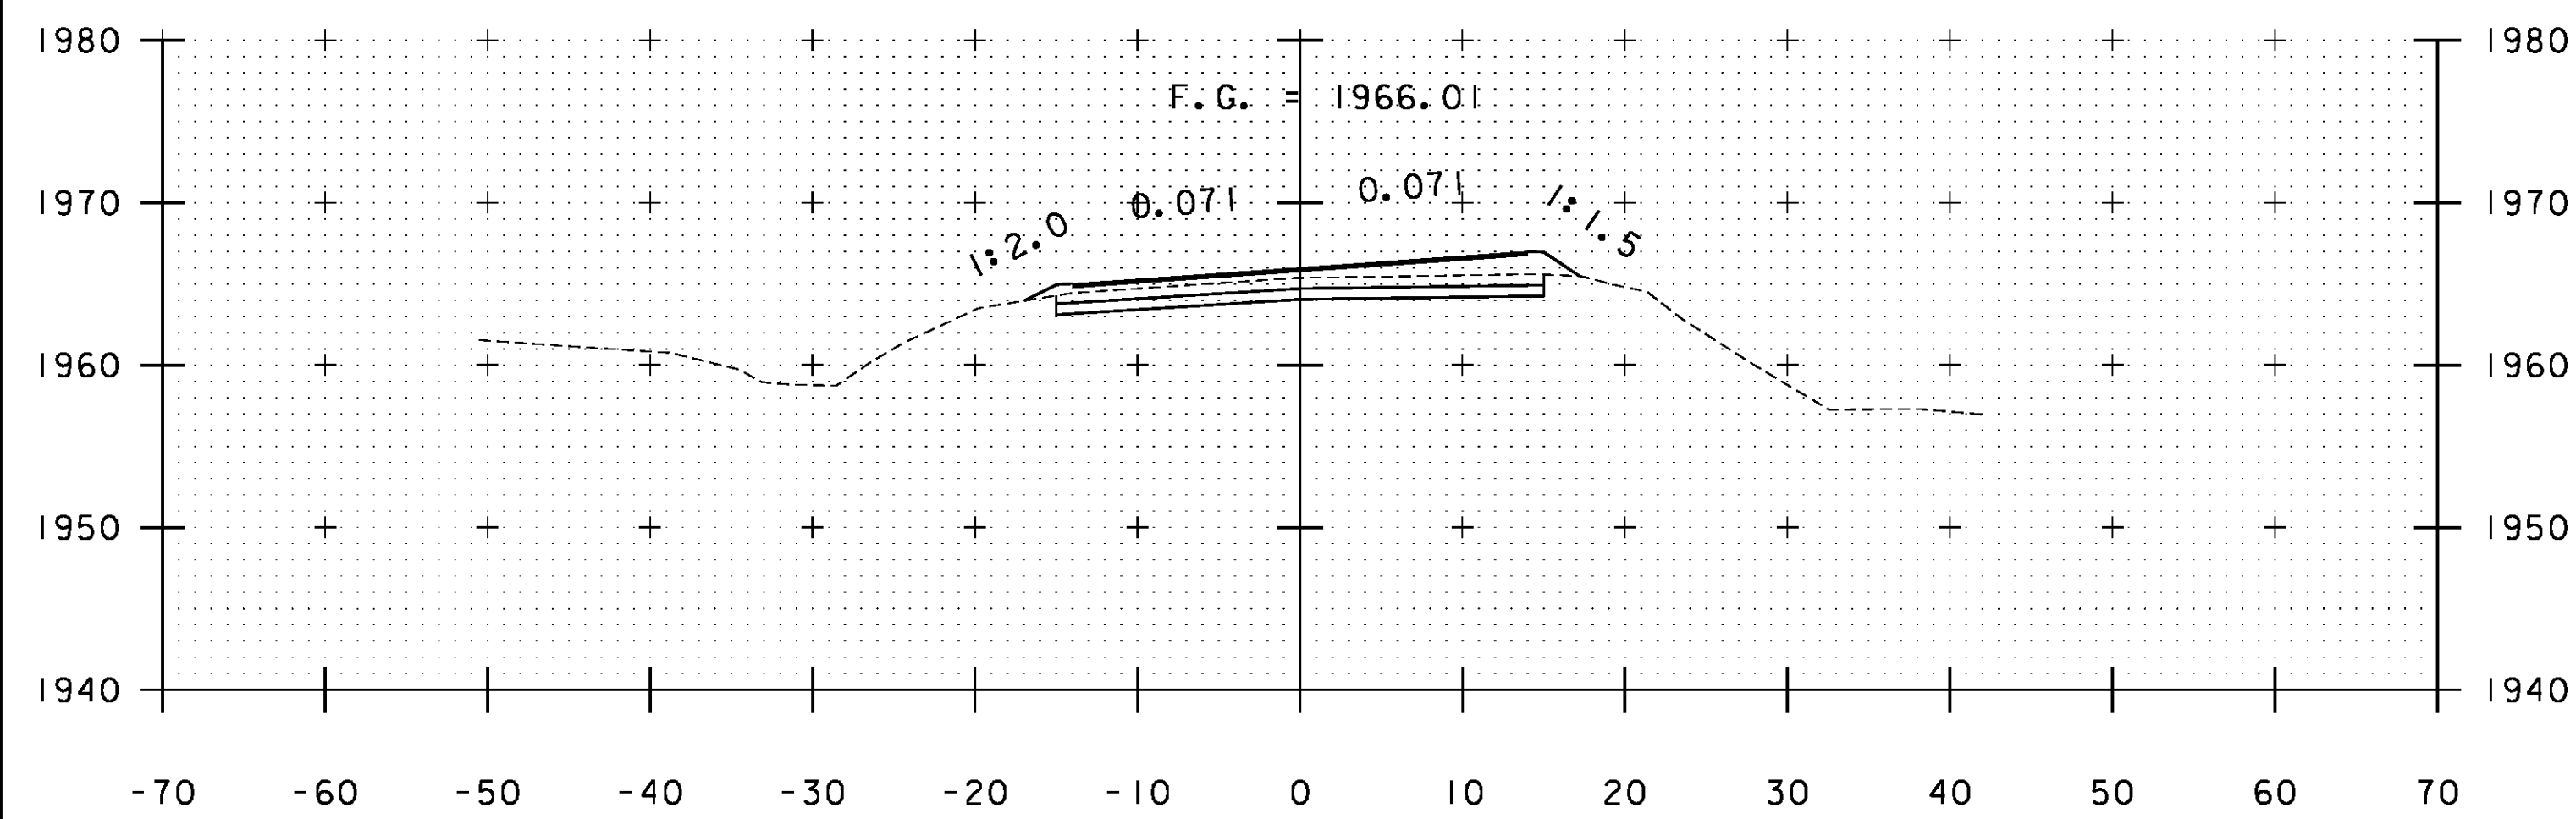


A 34+00

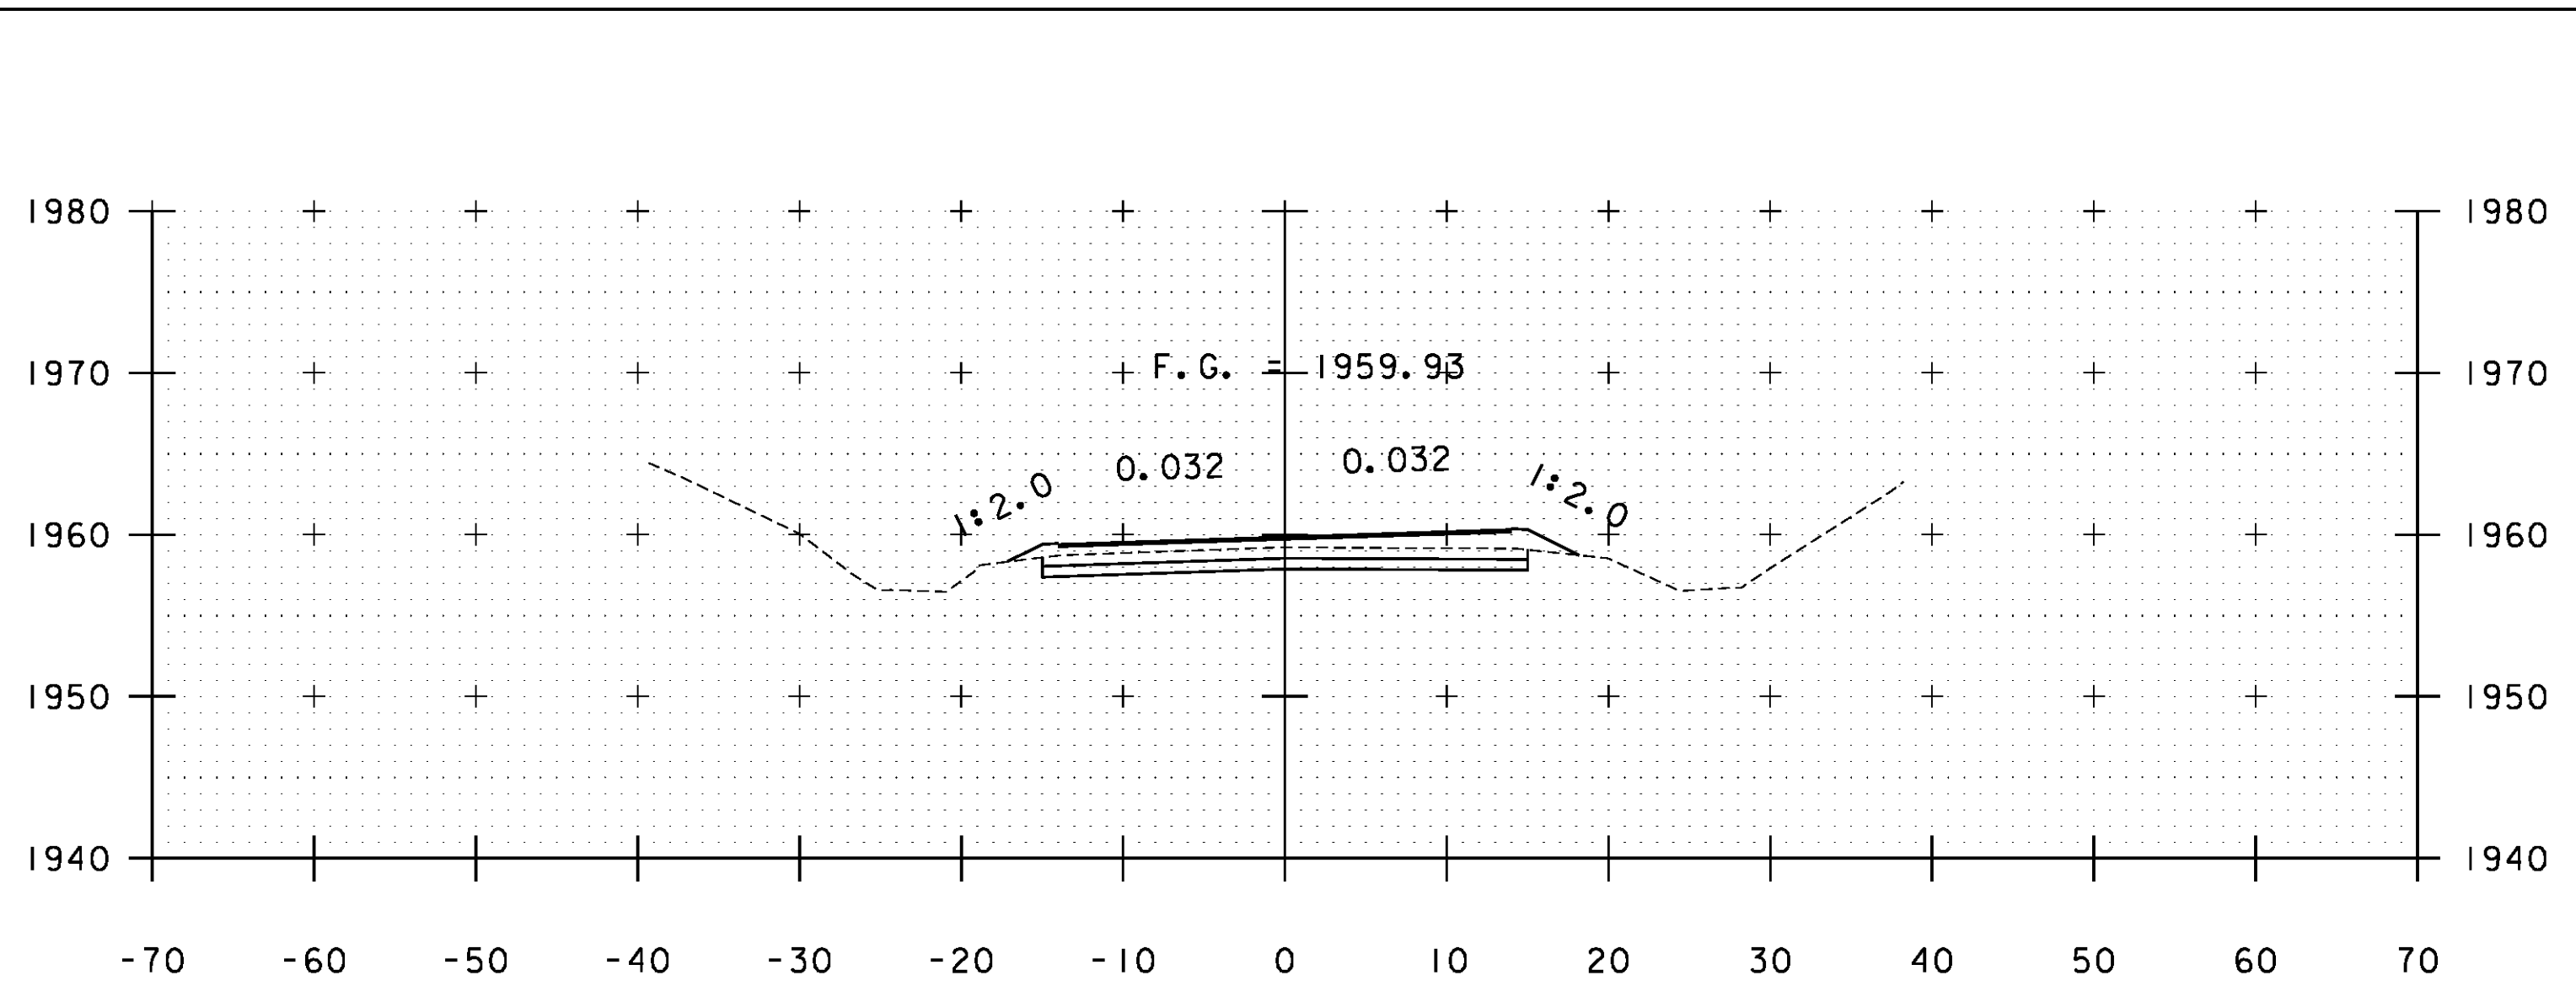

A 36+50

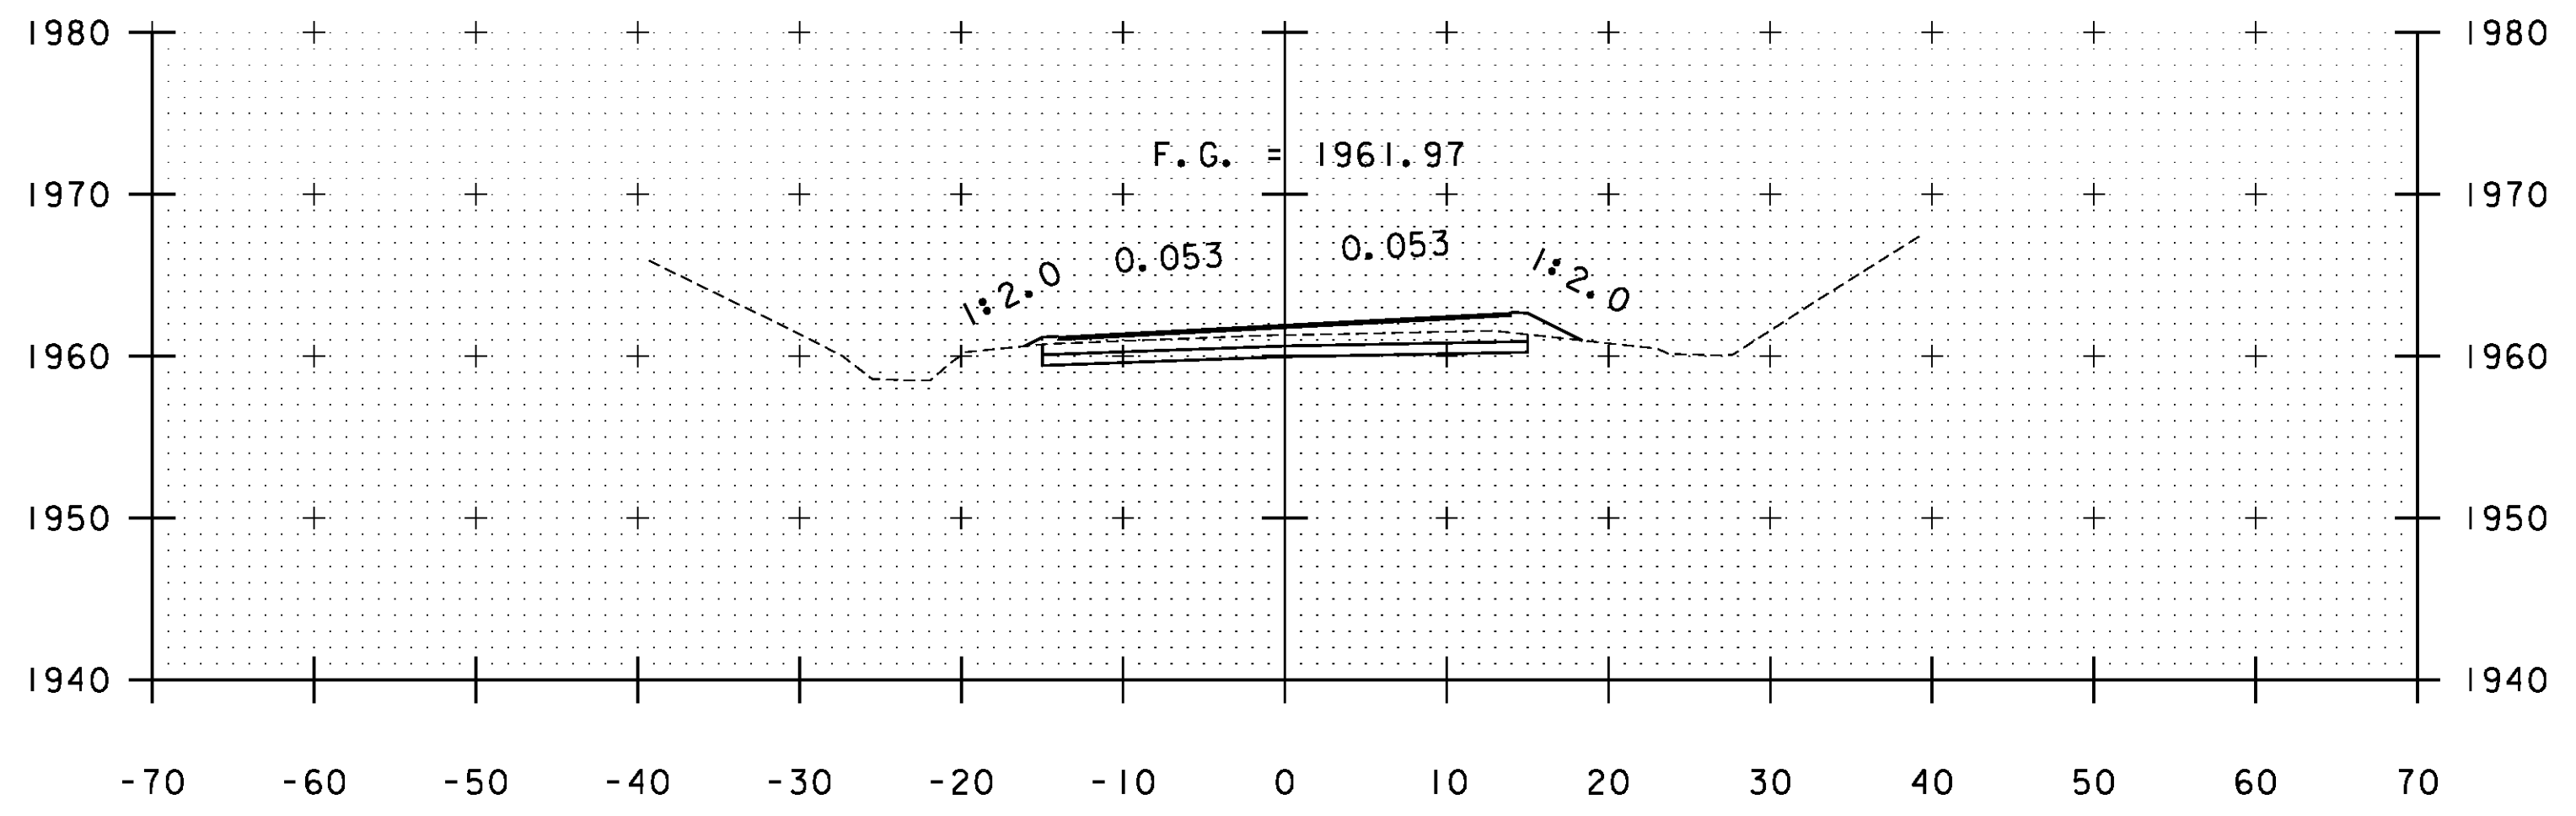

A 36+00

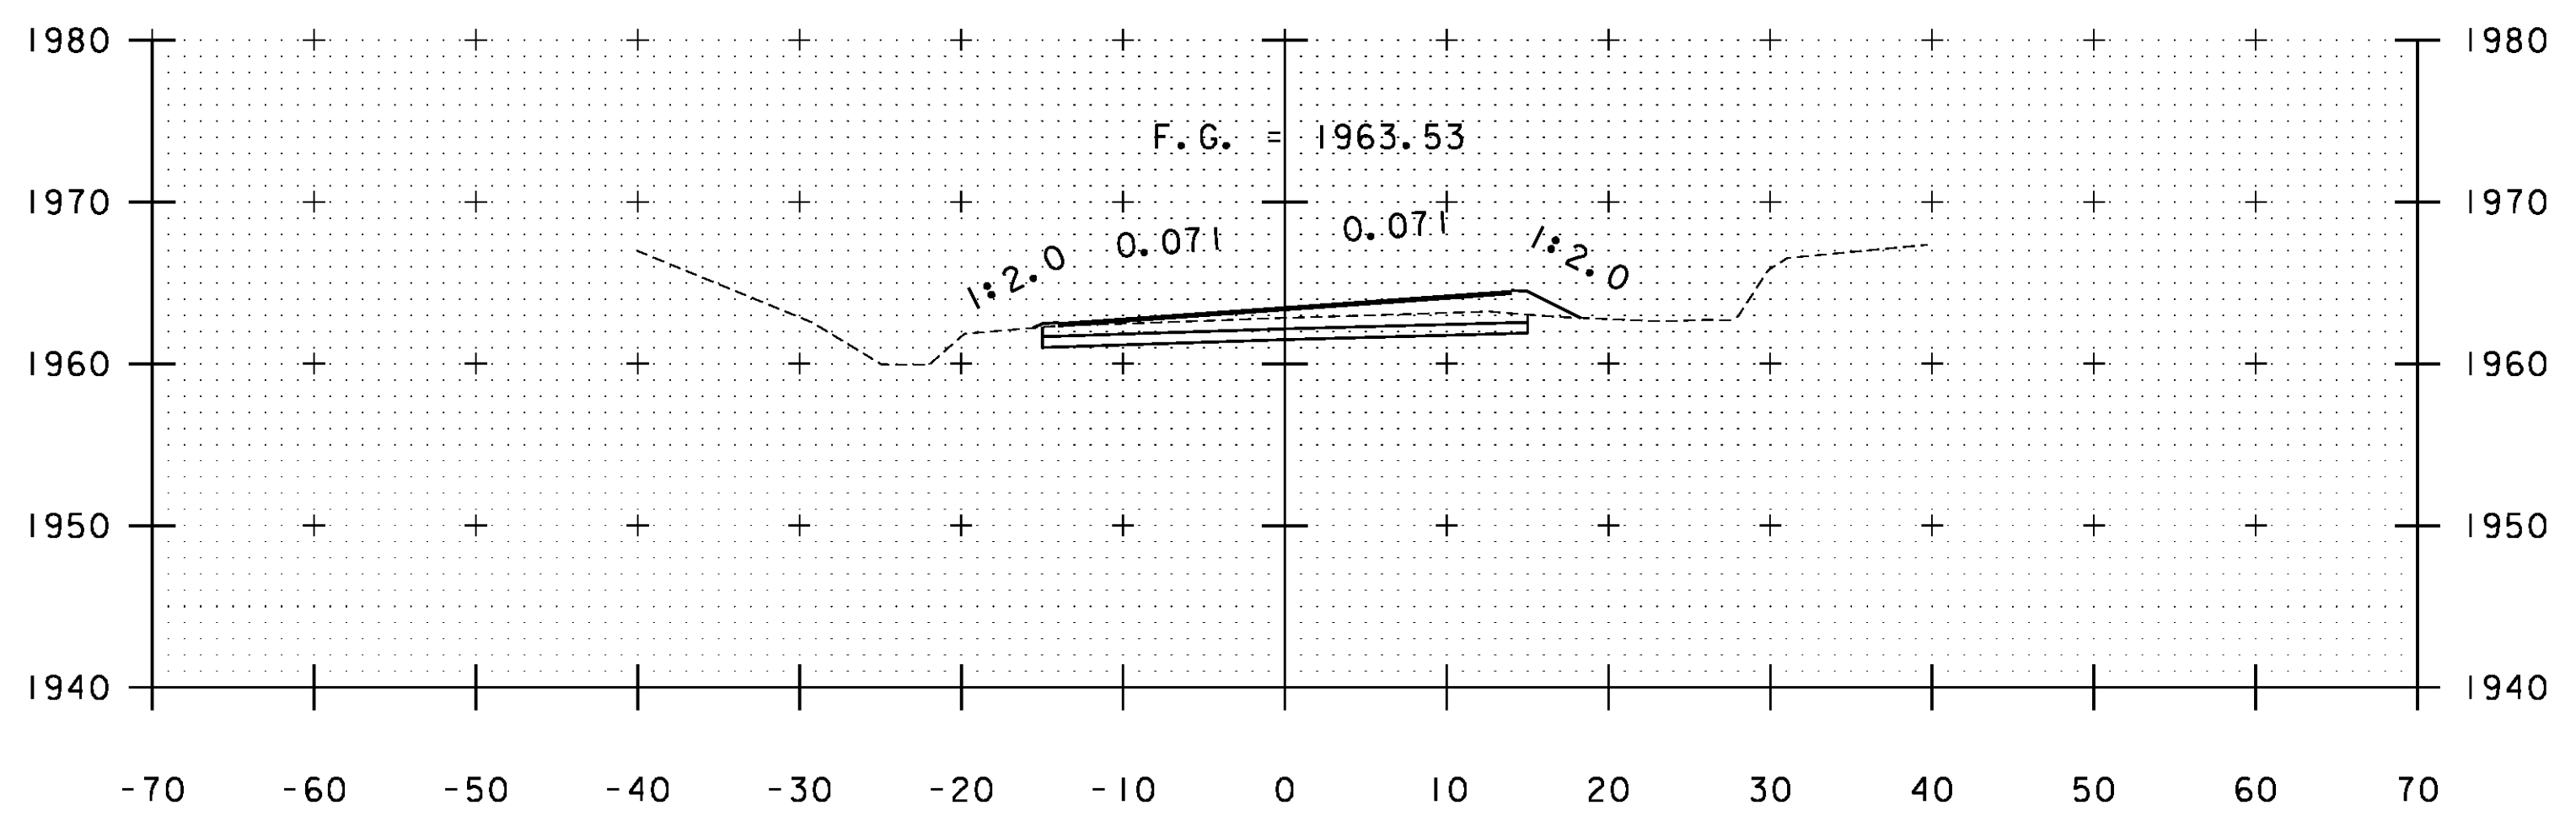

A 35+50

STA. A 34+00 TO STA. A 36+50

PROJECT NAME: WARDBORO-JAMAICA	PLOT DATE: 2/26/2014
PROJECT NUMBER: ER STP 013-1(17)	DRAWN BY: B. KIPP
FILE NAME: xs.dgn	CHECKED BY: HSD
PROJECT LEADER: K. UPMAL	SHEET 187 OF 444
DESIGNED BY: B. KIPP	
CROSS SECTIONS	