




A 48+00

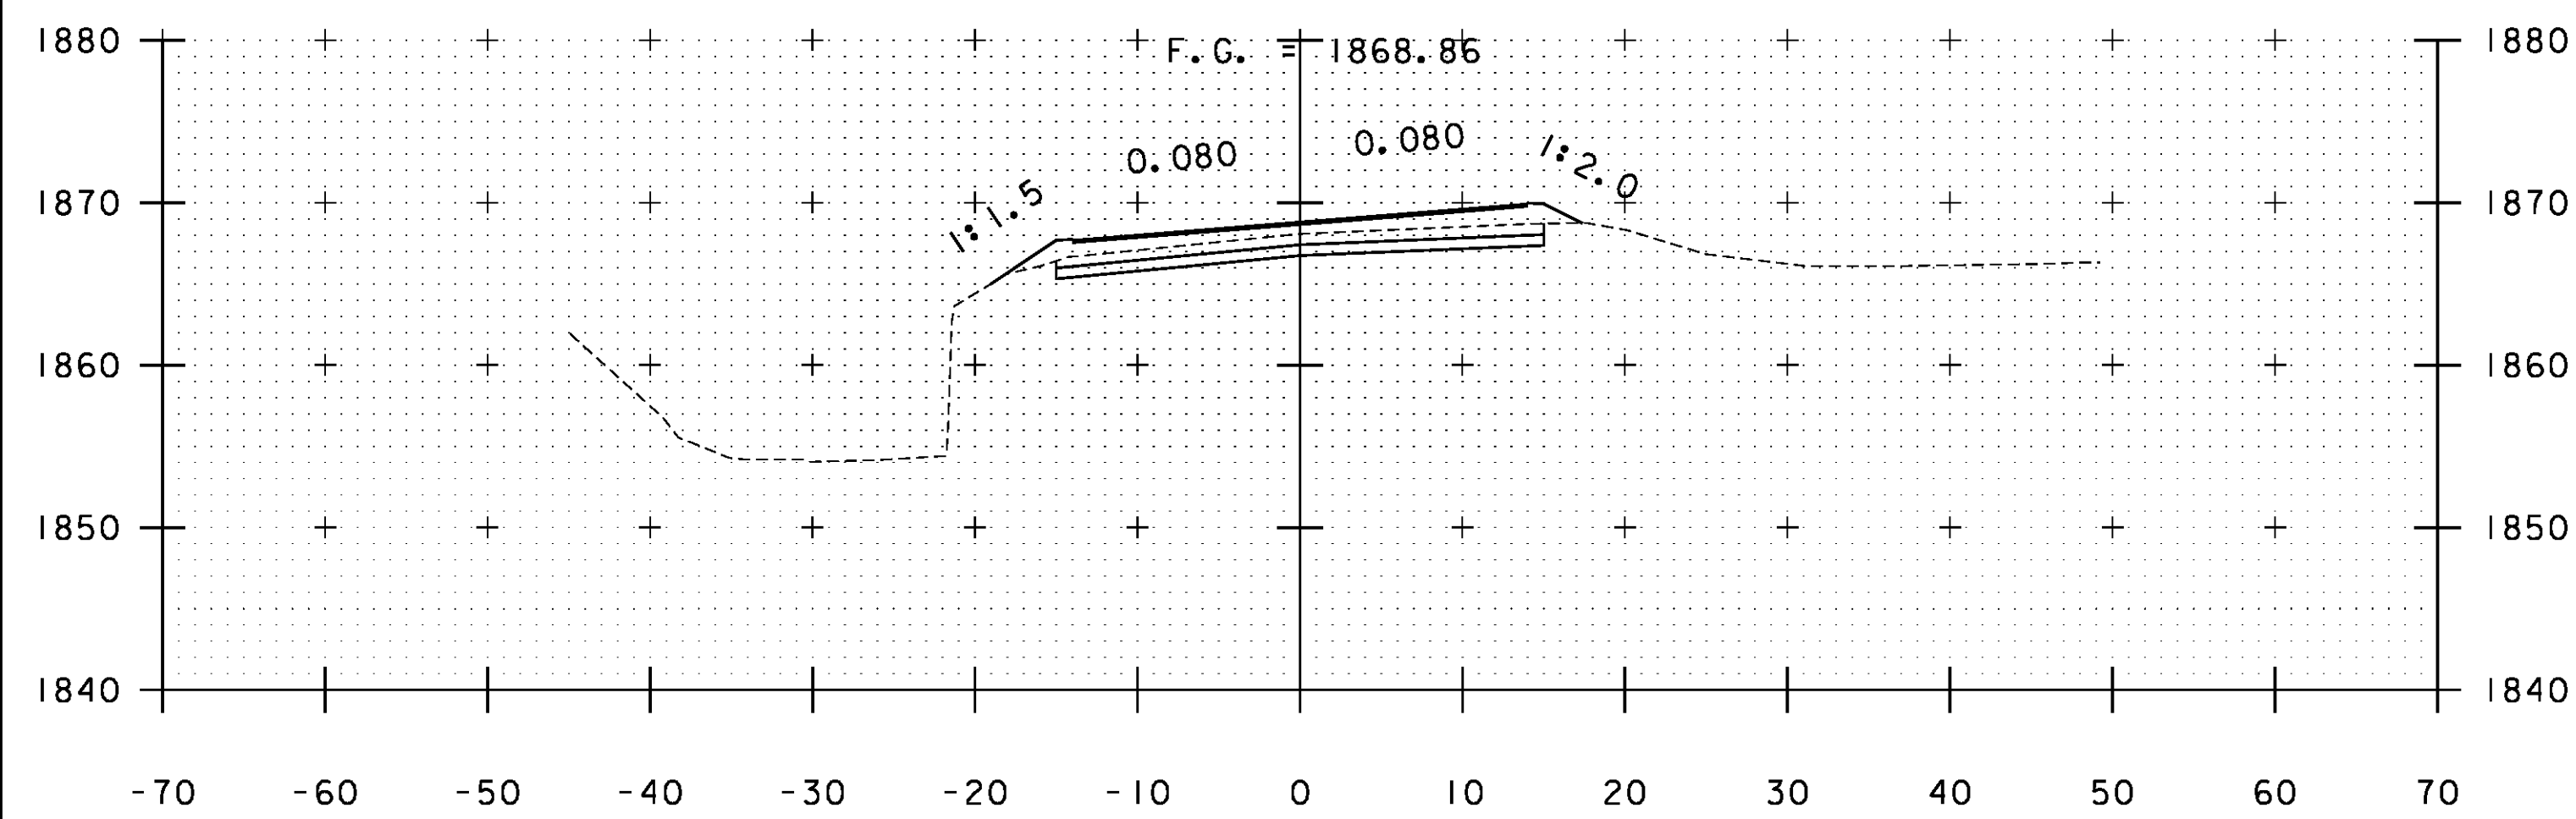

A 47+50

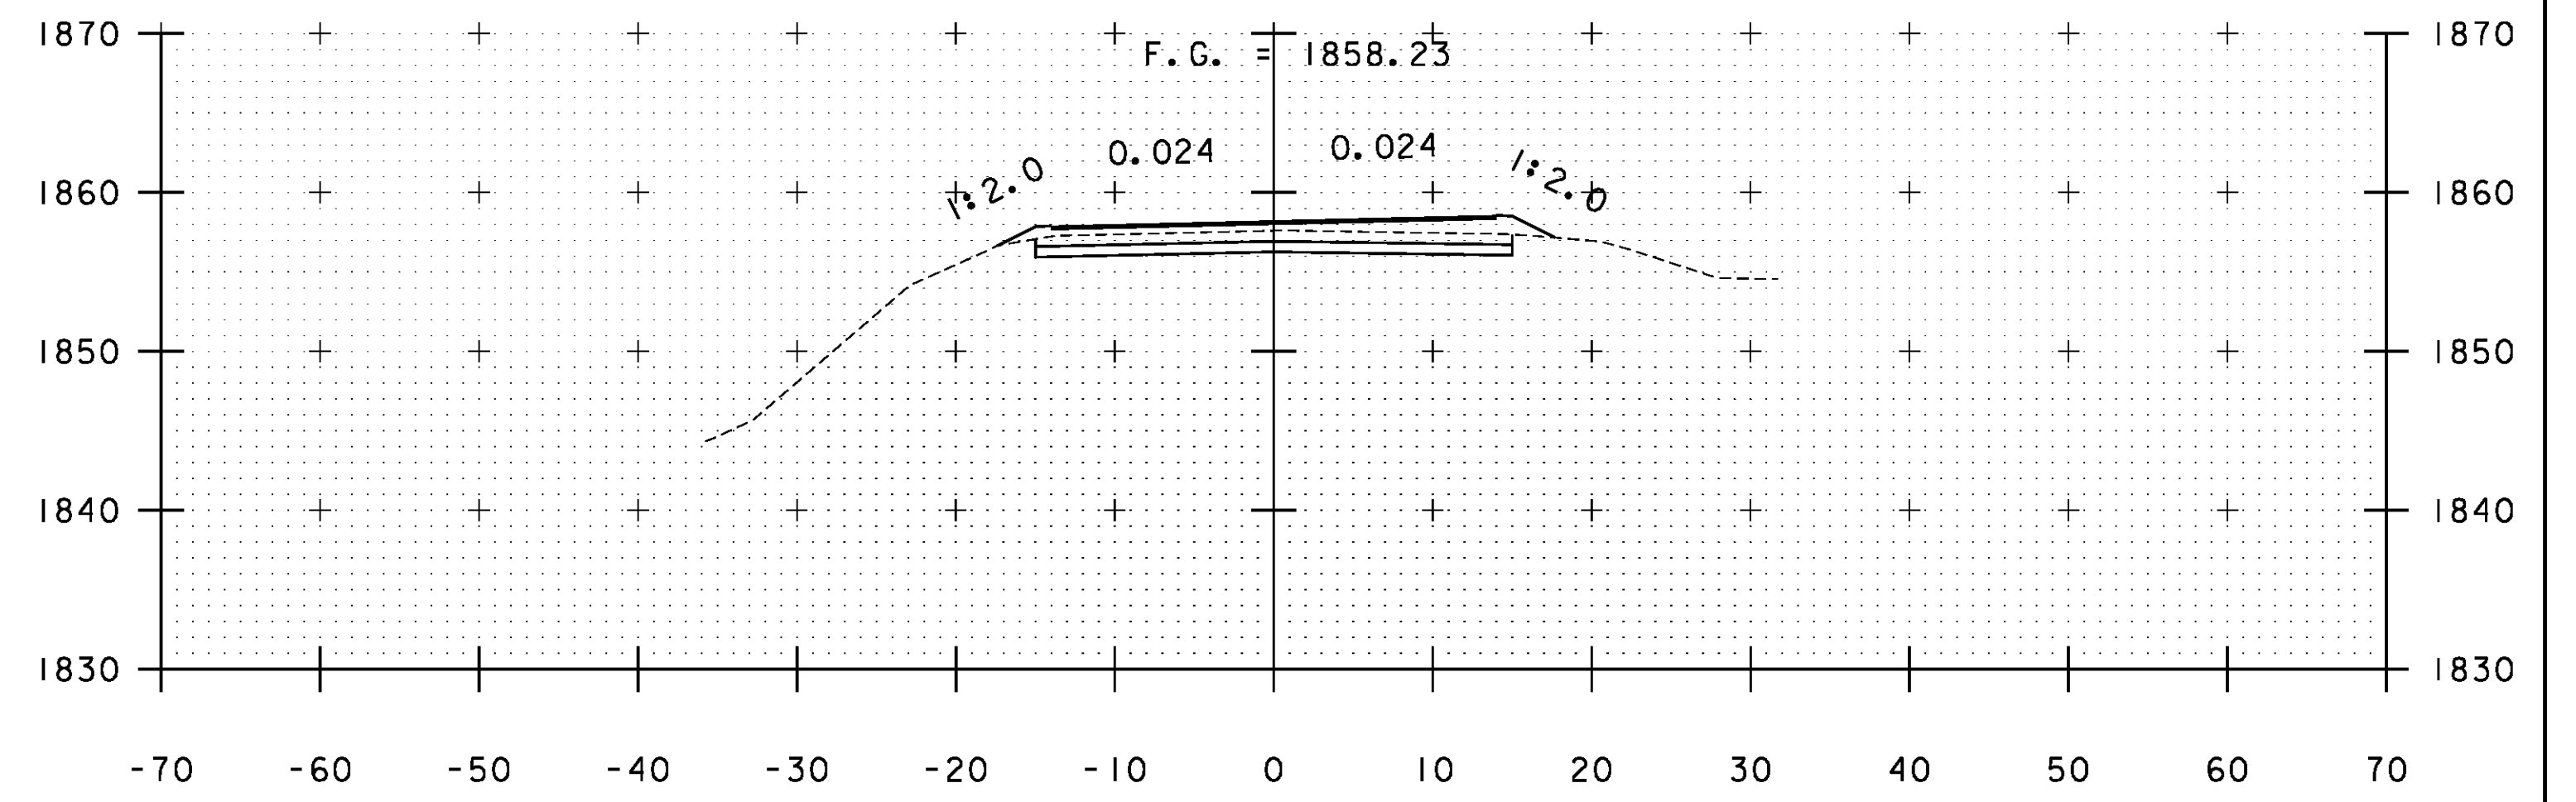

A 49+00

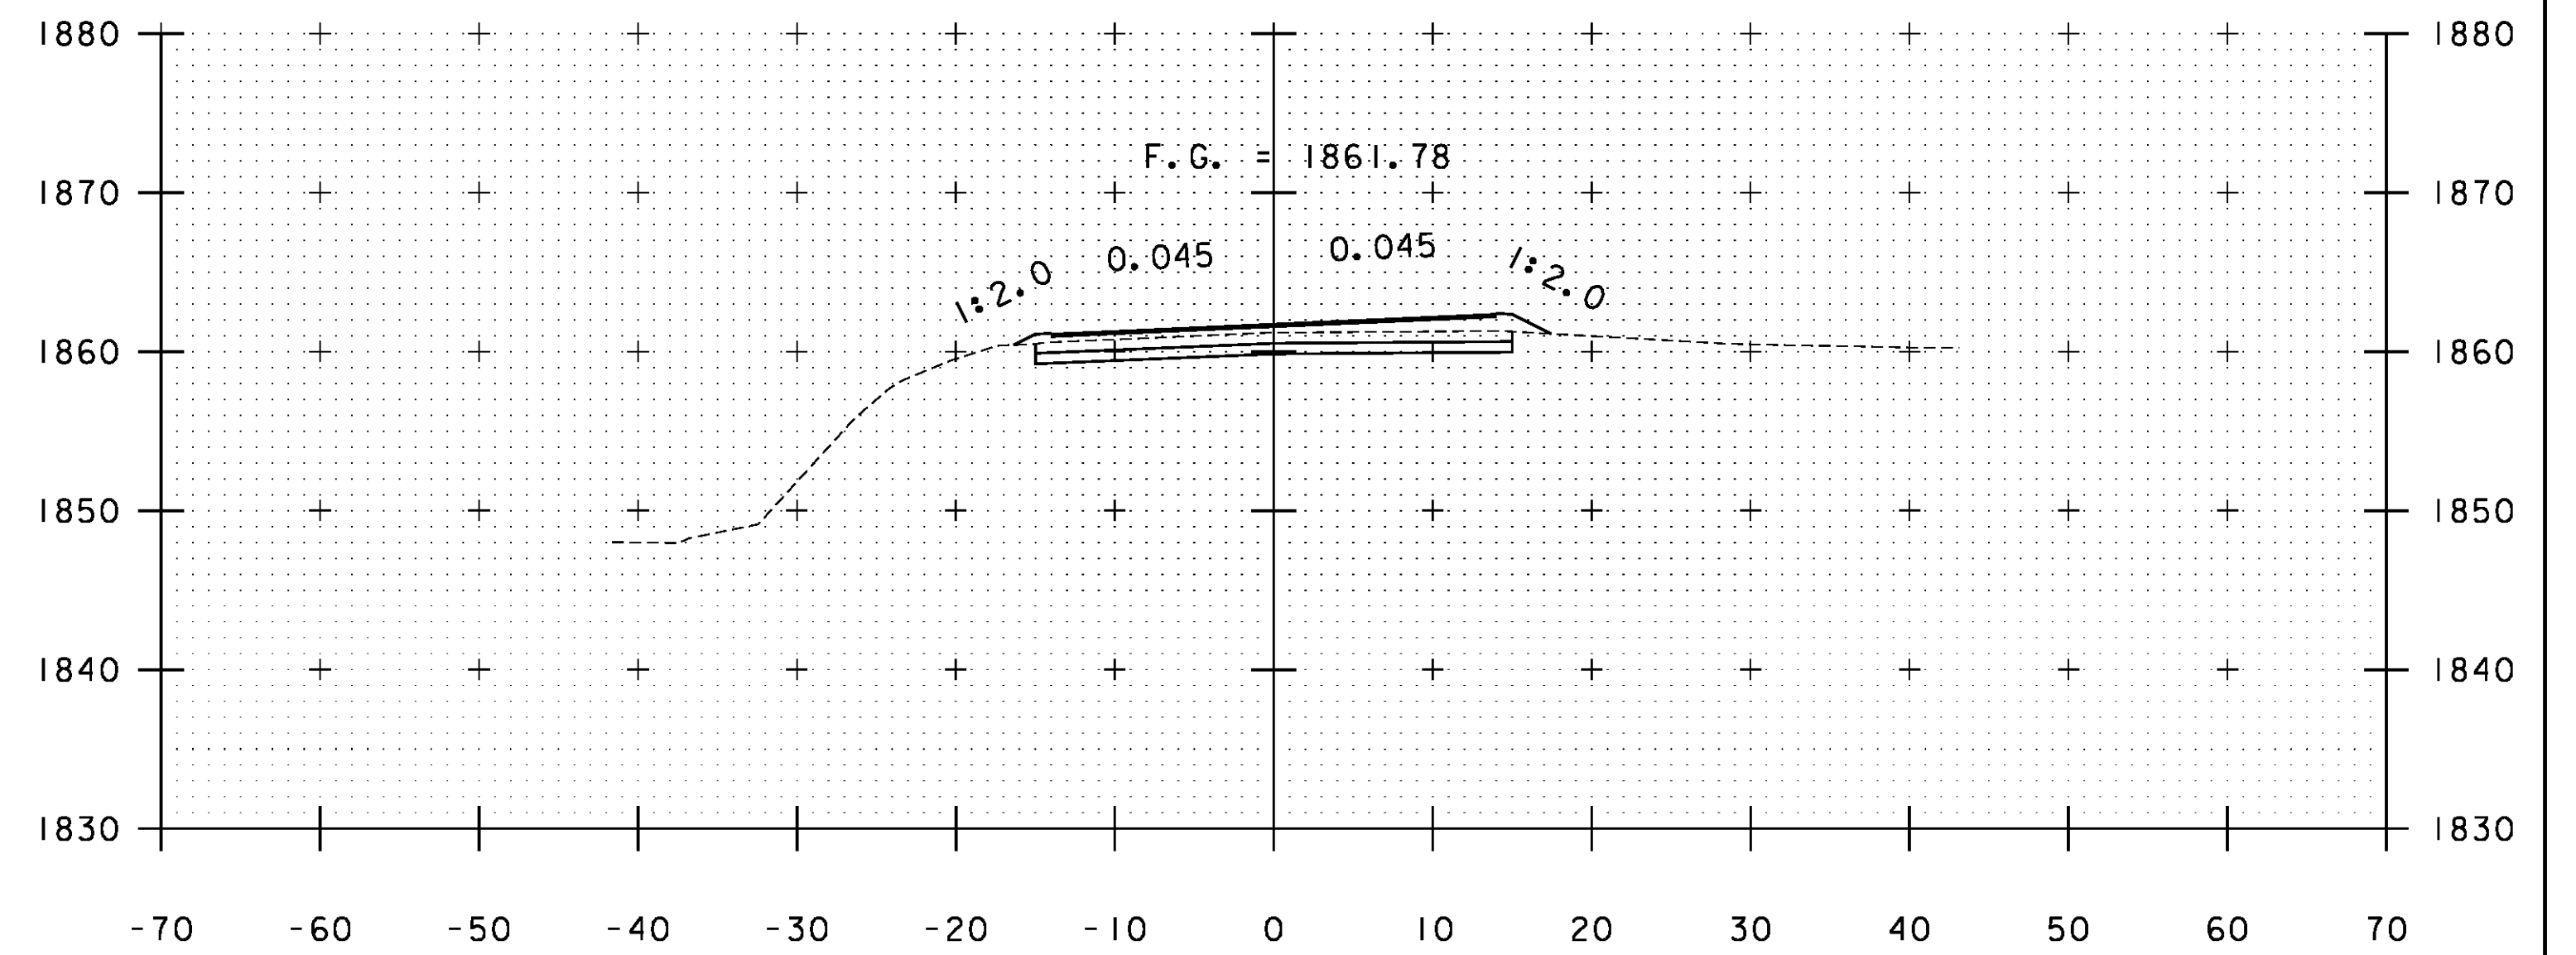

A 48+50

STA. A 47+50 TO STA. A 49+00

PROJECT NAME:	WARDSBORO-JAMAICA
PROJECT NUMBER:	ER BRPSP-013(17)
FILE NAME:	xs.dgn
PROJECT LEADER:	K. UPMAL
DESIGNED BY:	B. KIPP
CROSS SECTIONS	
PLOT DATE:	2/26/2014
DRAWN BY:	B. KIPP
CHECKED BY:	HSD
SHEET	193 OF 444