




A 72+44

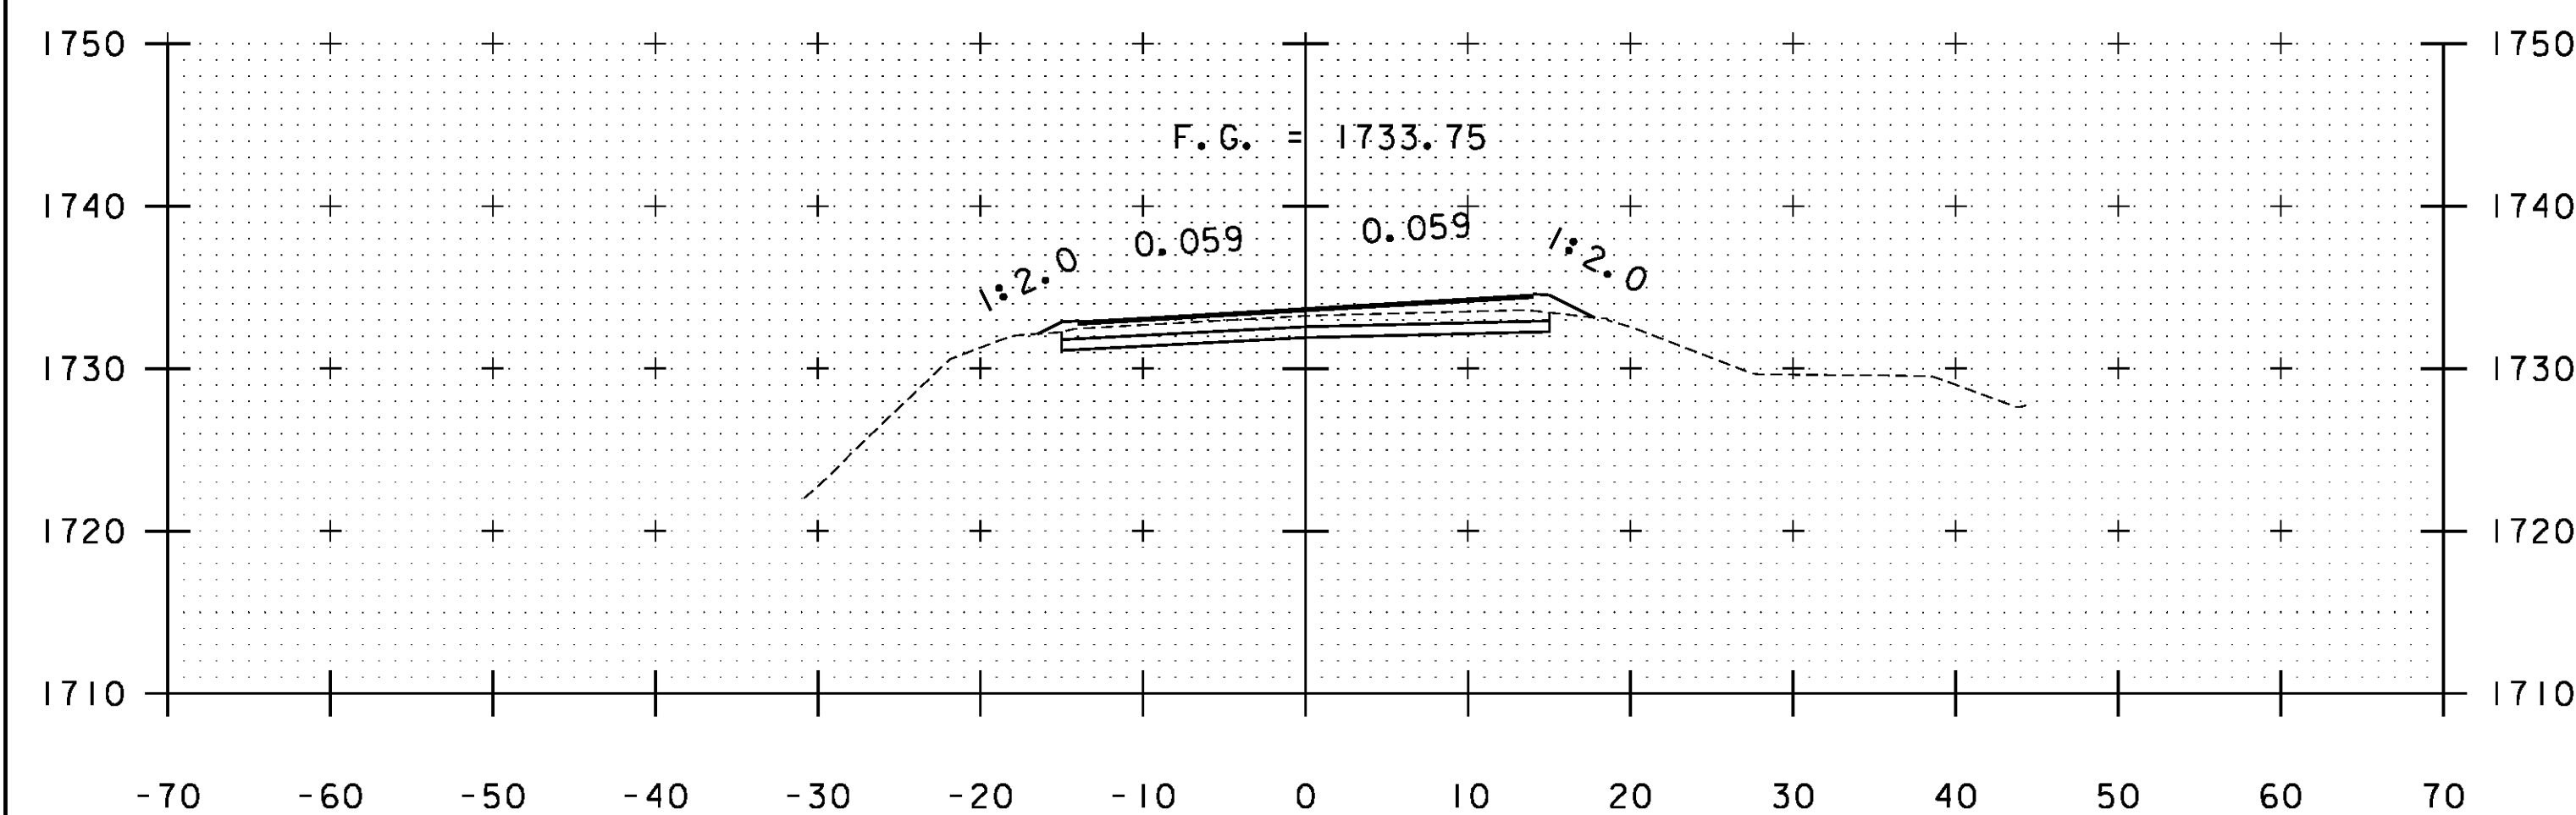

A 72+00

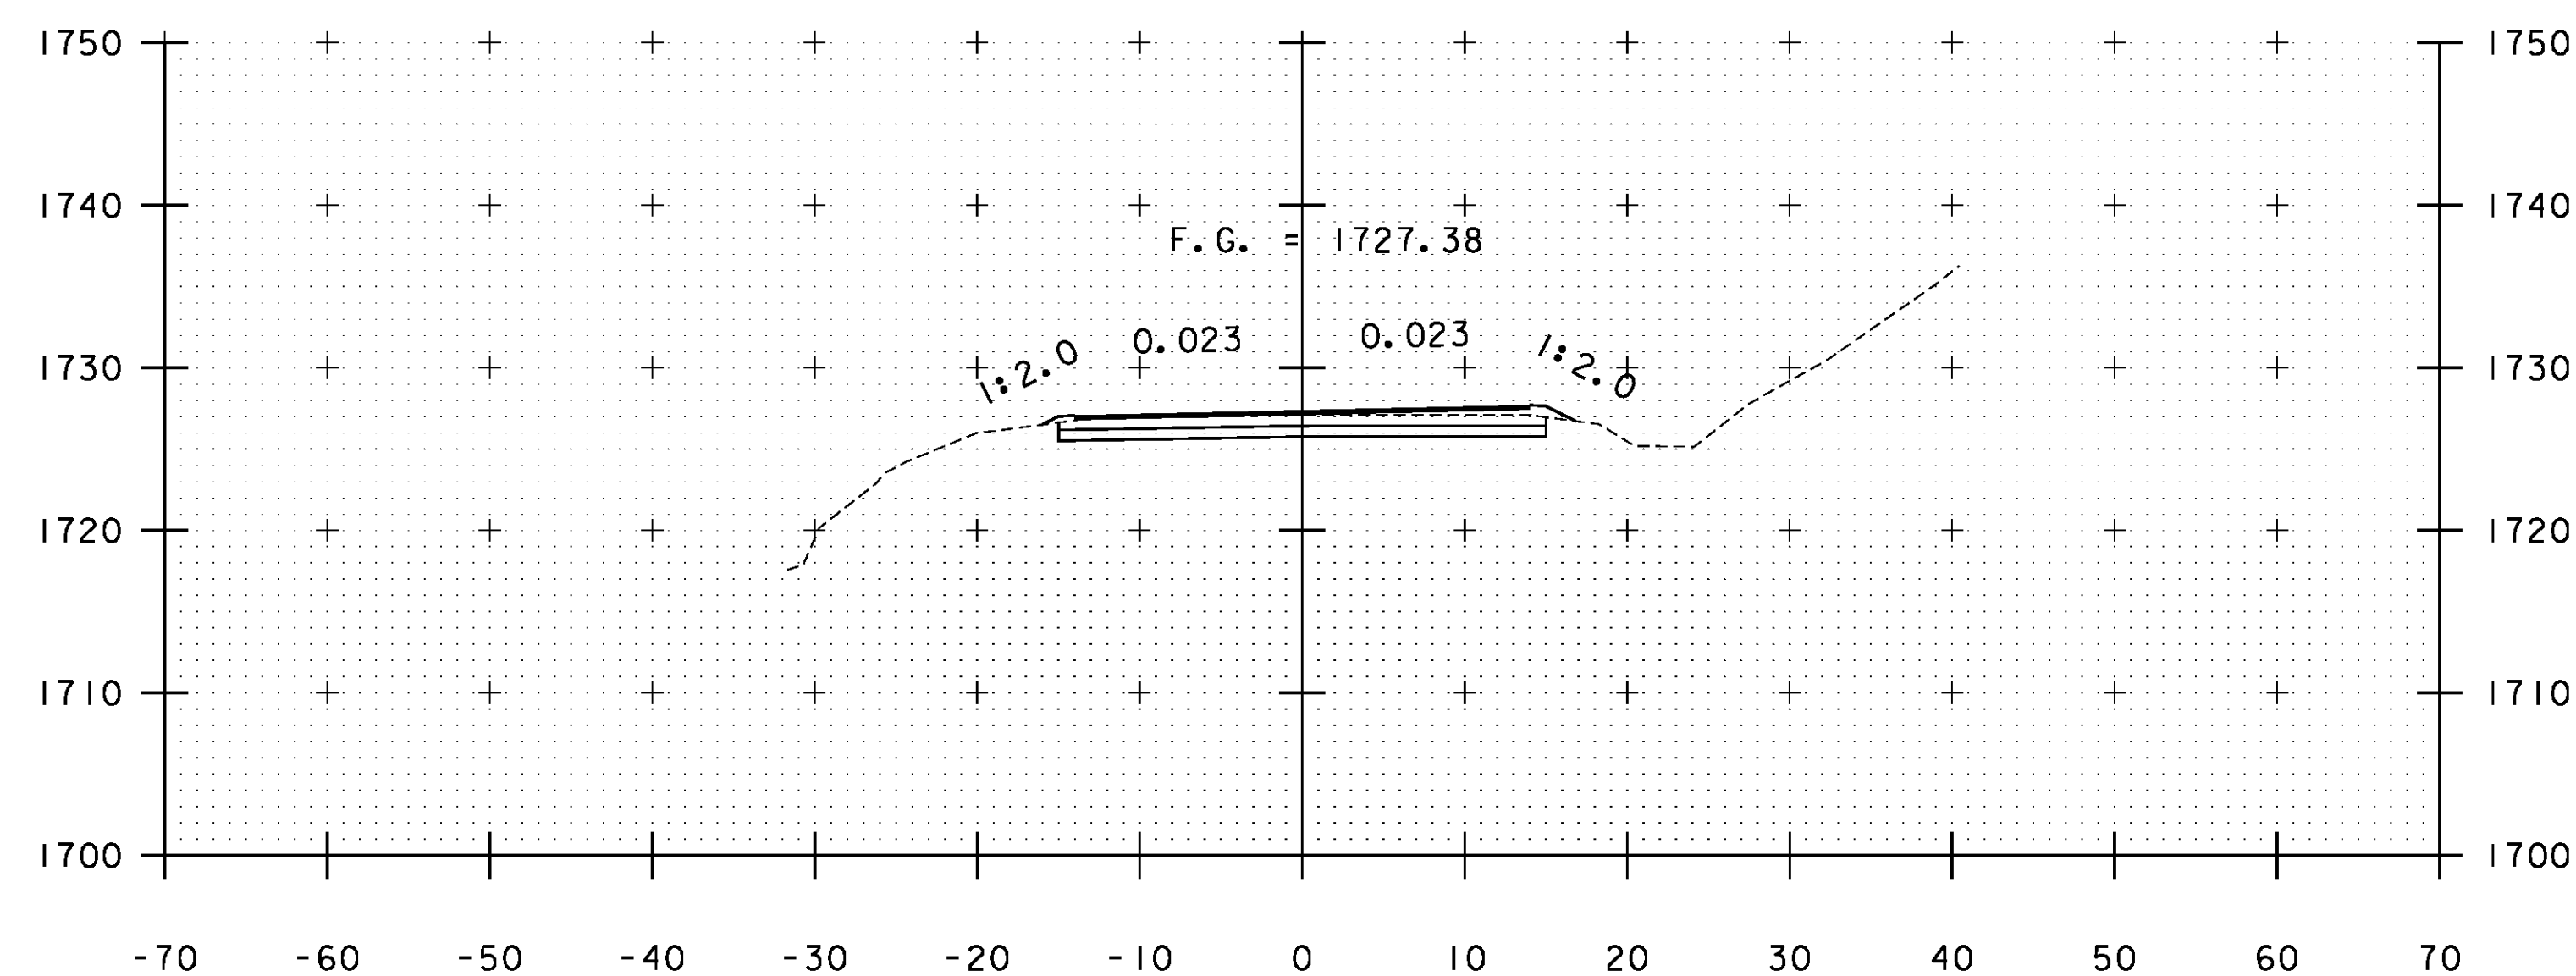

A 73+00

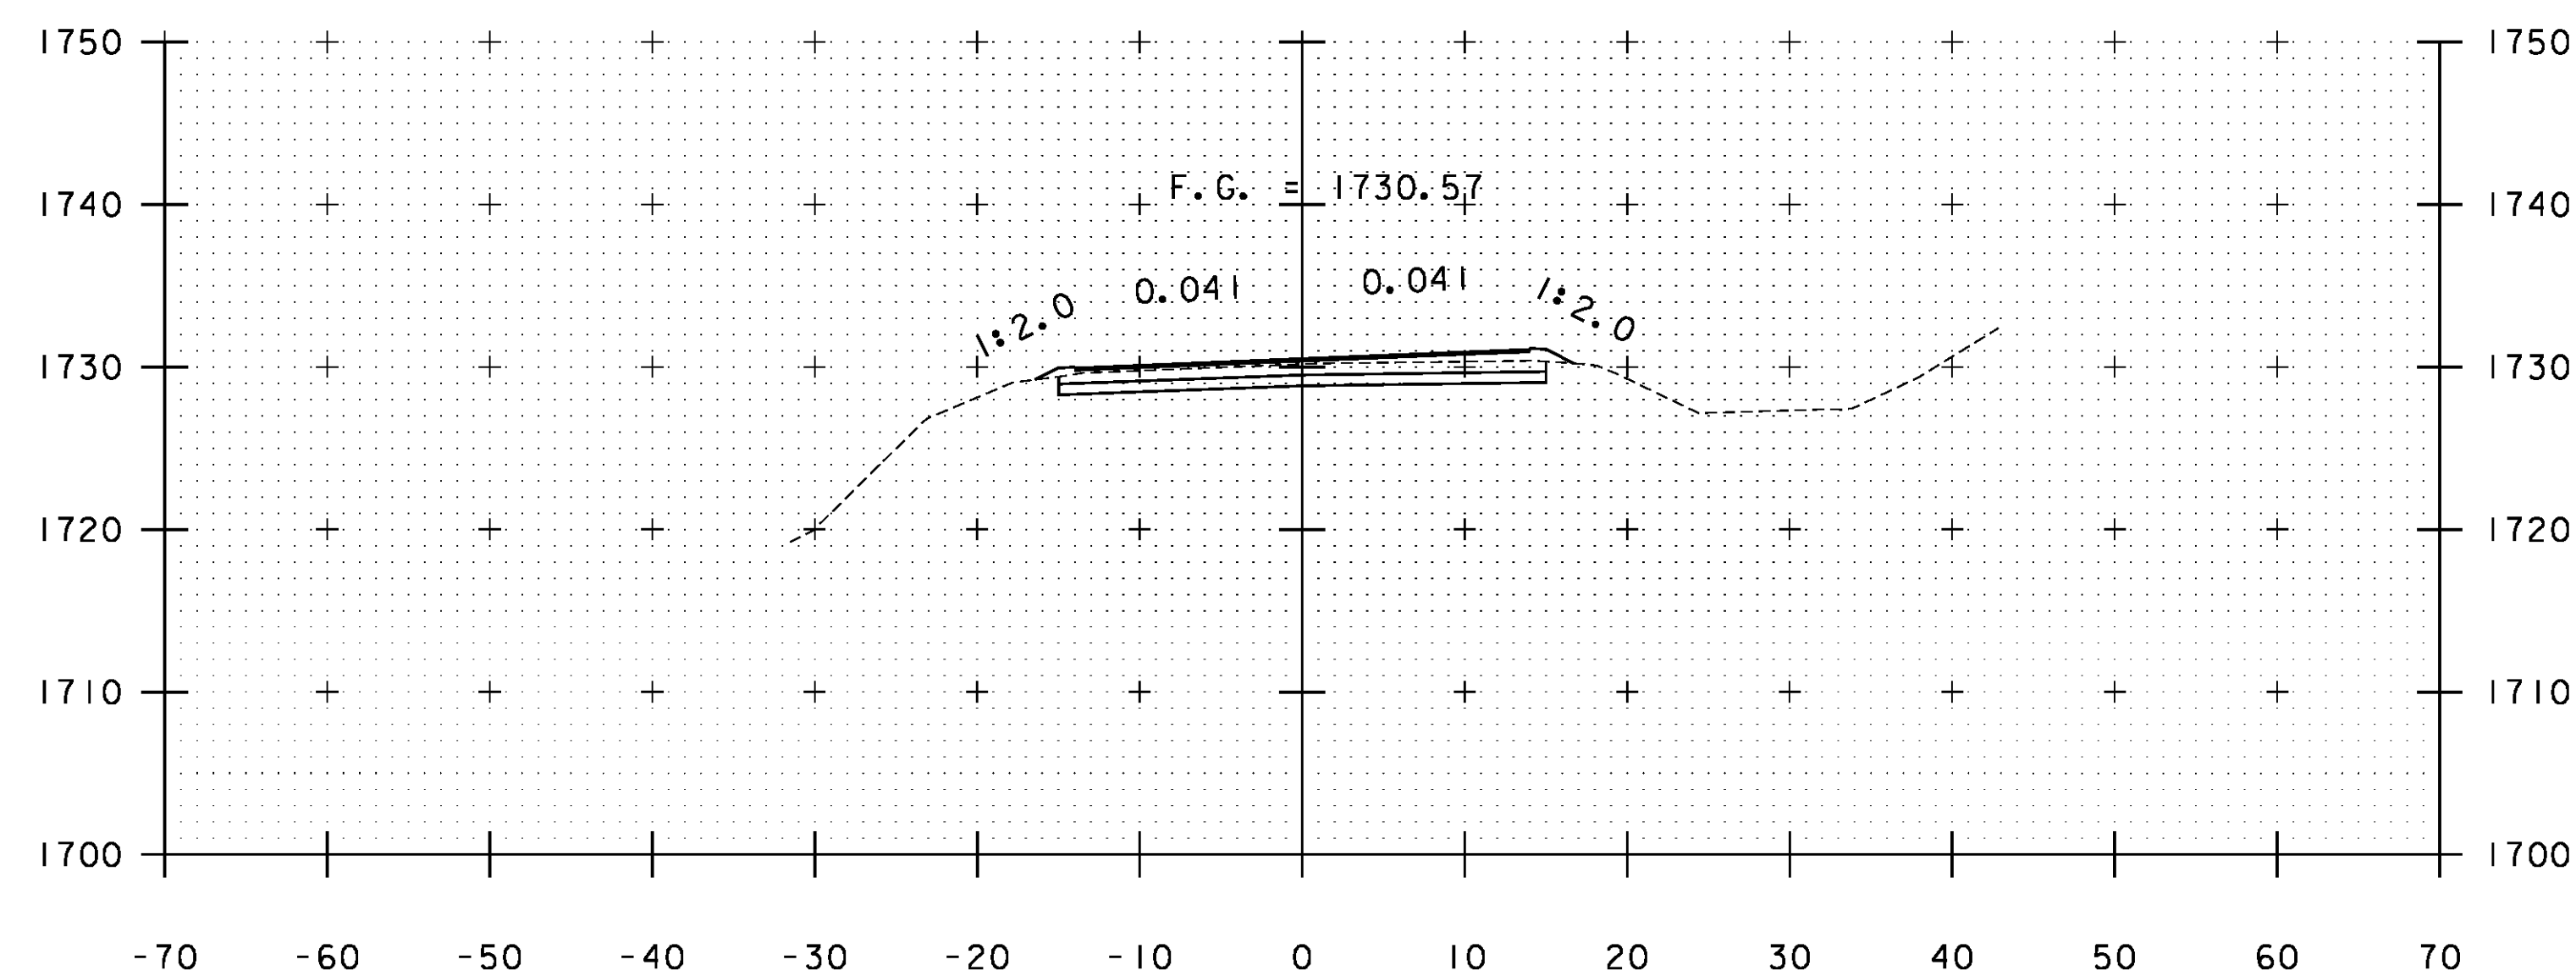

A 72+50

STA. A 72+00 TO STA. A 73+00

PROJECT NAME: WARDBORO-JAMAICA	PLOT DATE: 2/26/2014
PROJECT NUMBER: ER STP 013-1(17)	DRAWN BY: B. KIPP
FILE NAME: xs.dgn	CHECKED BY: HSD
PROJECT LEADER: K. UPMAL	SHEET 204 OF 444
DESIGNED BY: B. KIPP	
CROSS SECTIONS	