




A 79+50

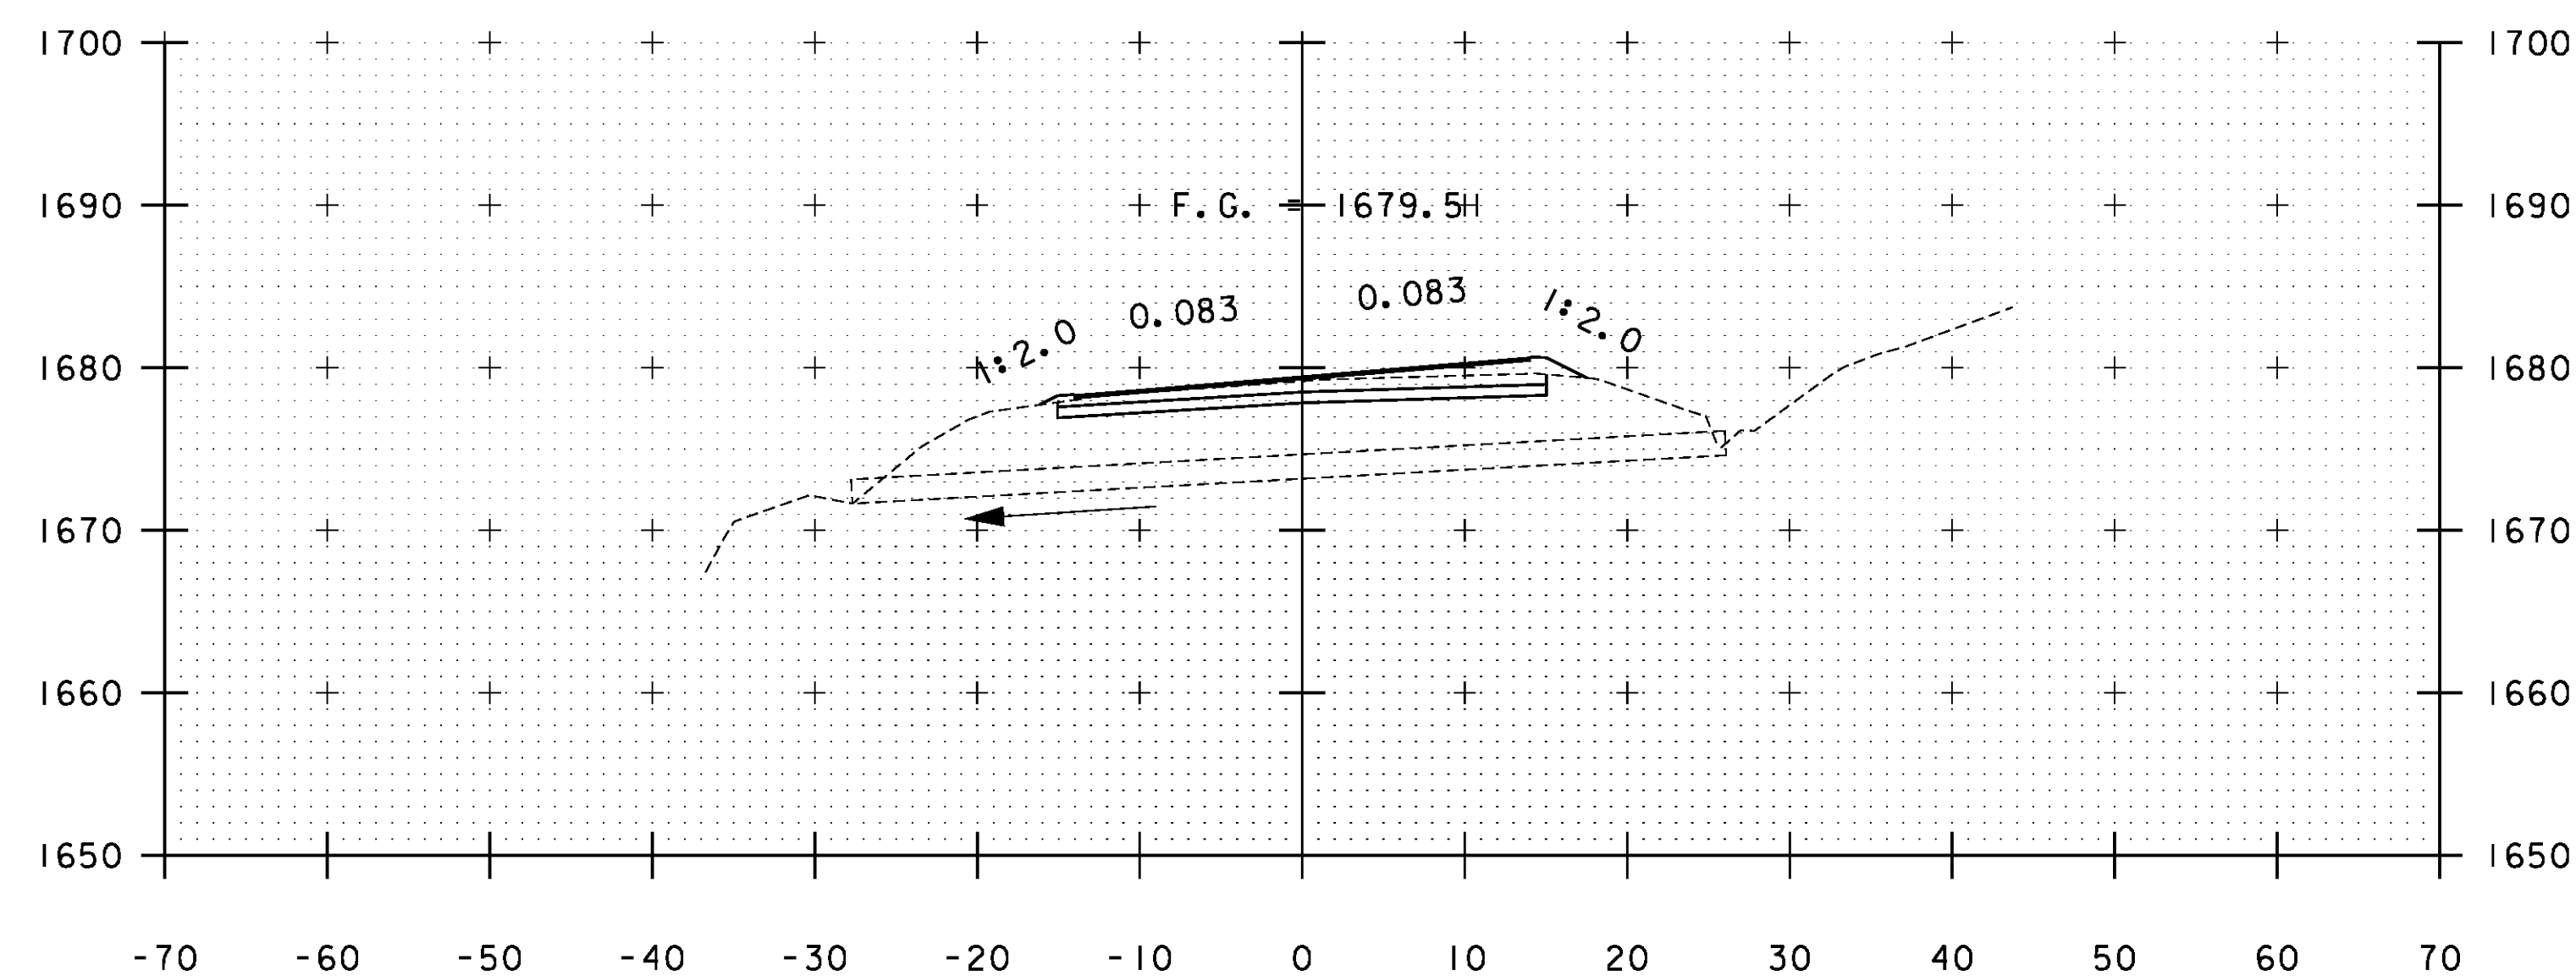

A 80+14

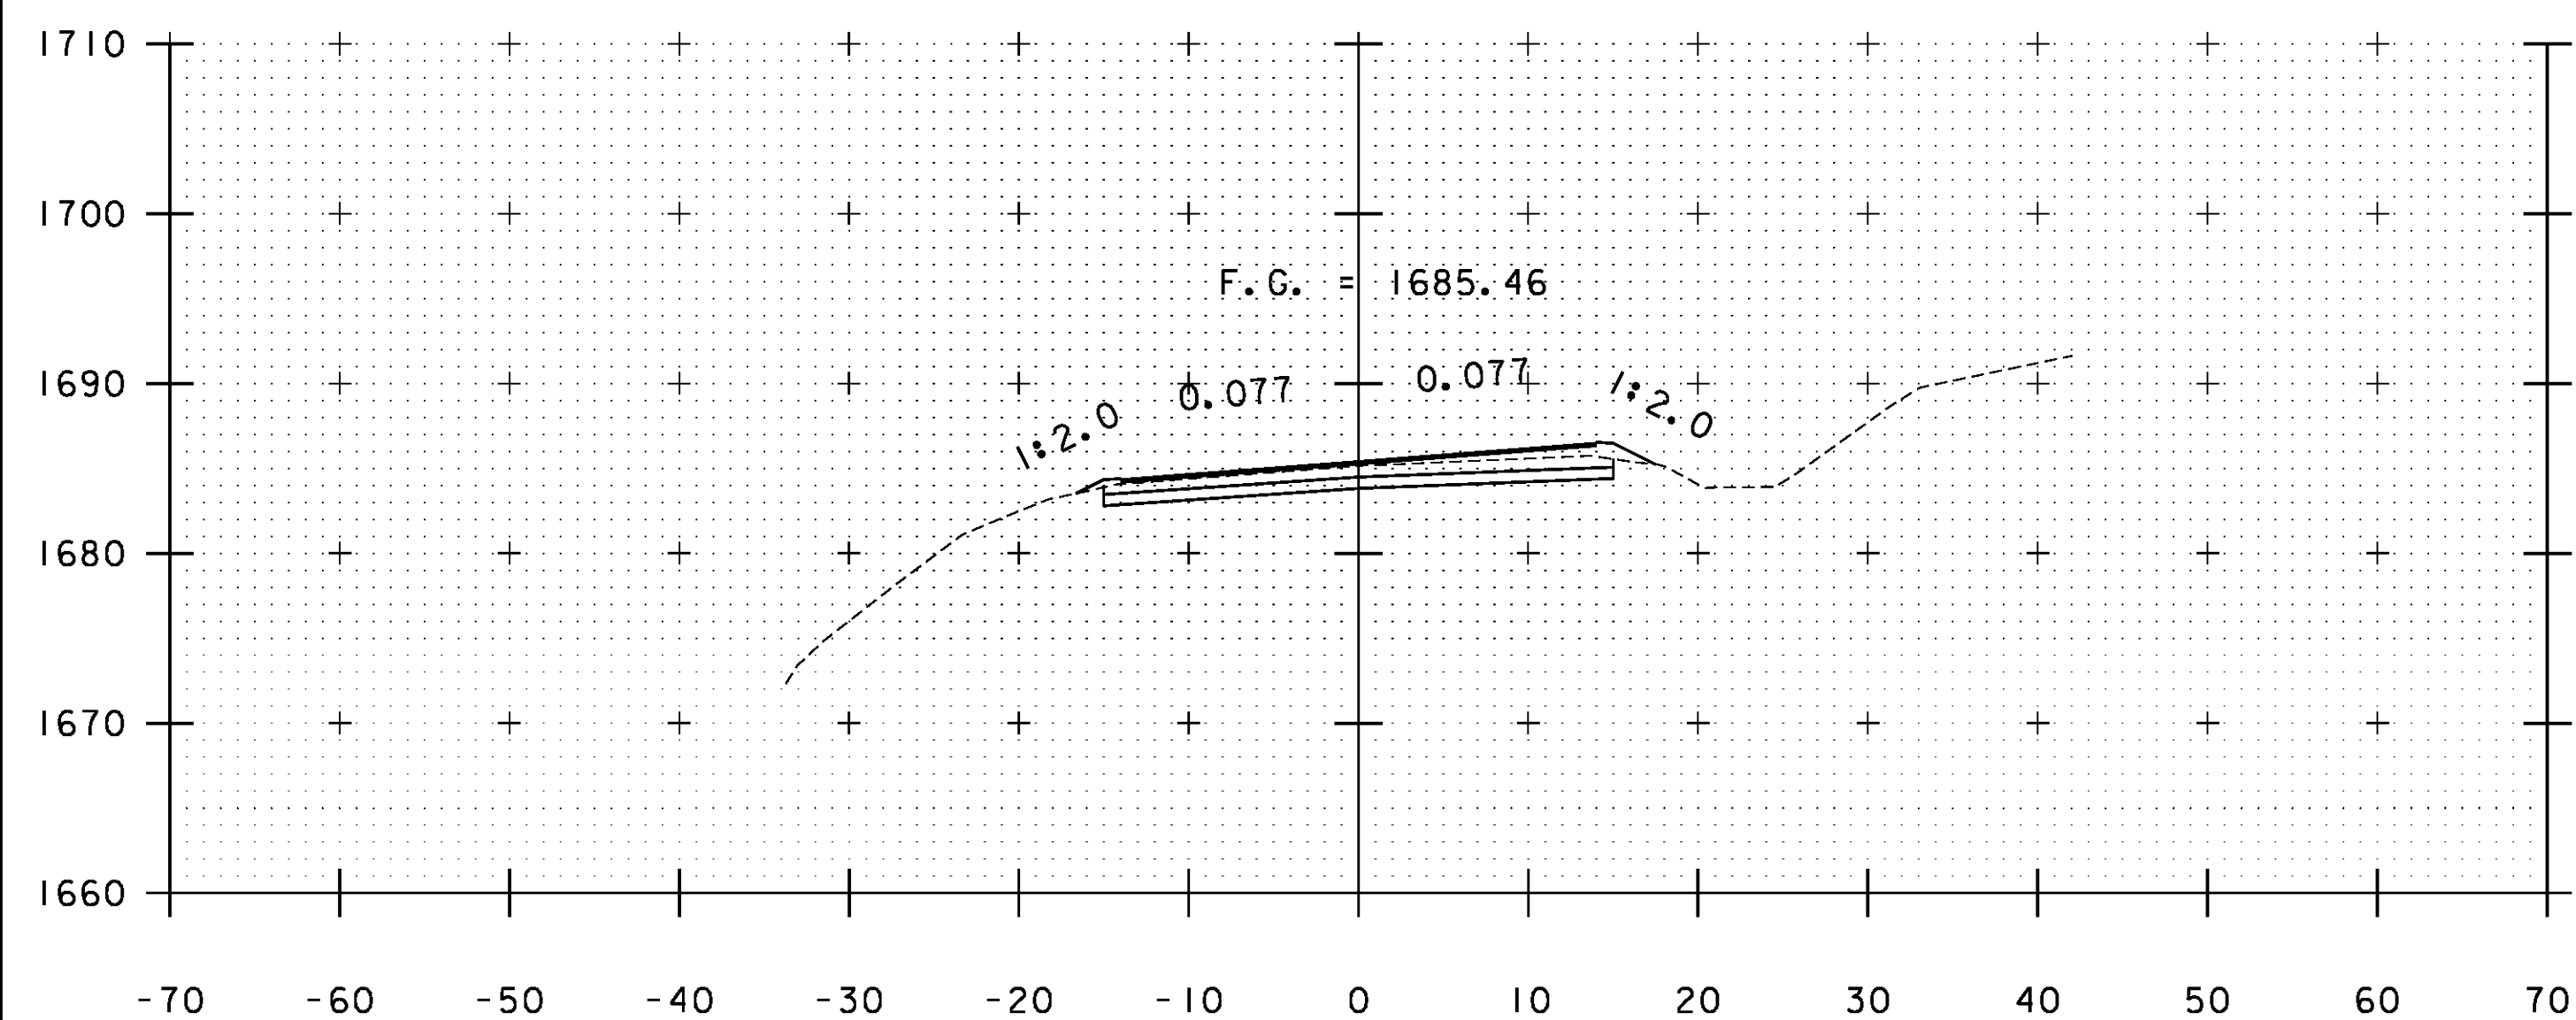

A 79+00

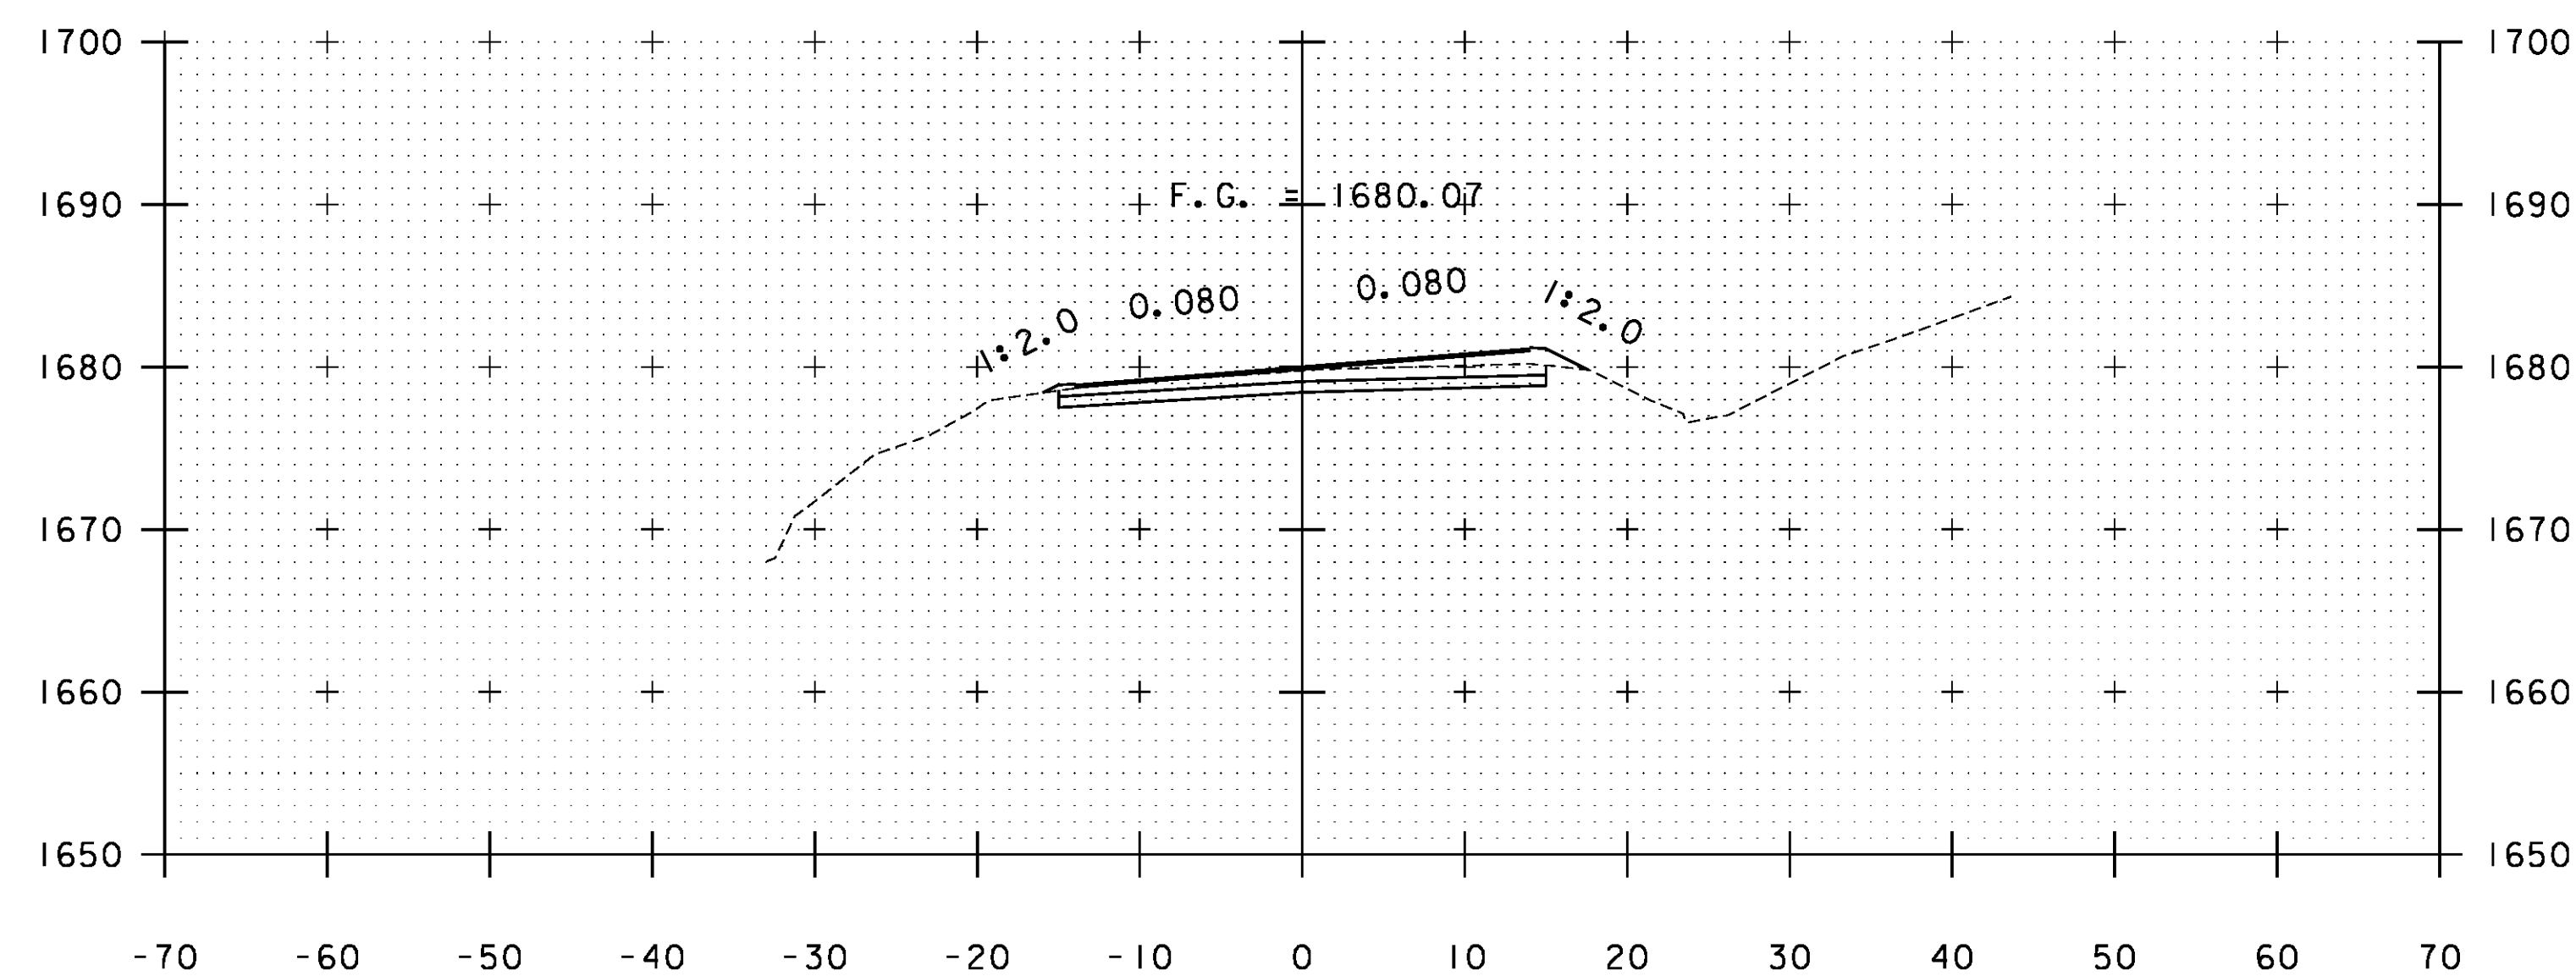

A 80+00

STA. A 79+00 TO STA. A 80+14

| | |
|----------------------------------|----------------------|
| PROJECT NAME: WARDBORO-JAMAICA | PLOT DATE: 2/26/2014 |
| PROJECT NUMBER: ER STP 013-1(17) | DRAWN BY: B. KIPP |
| FILE NAME: xs.dgn | CHECKED BY: HSD |
| PROJECT LEADER: K. UPMAL | SHEET 208 OF 444 |
| DESIGNED BY: B. KIPP | |
| CROSS SECTIONS | |