




A 85+00

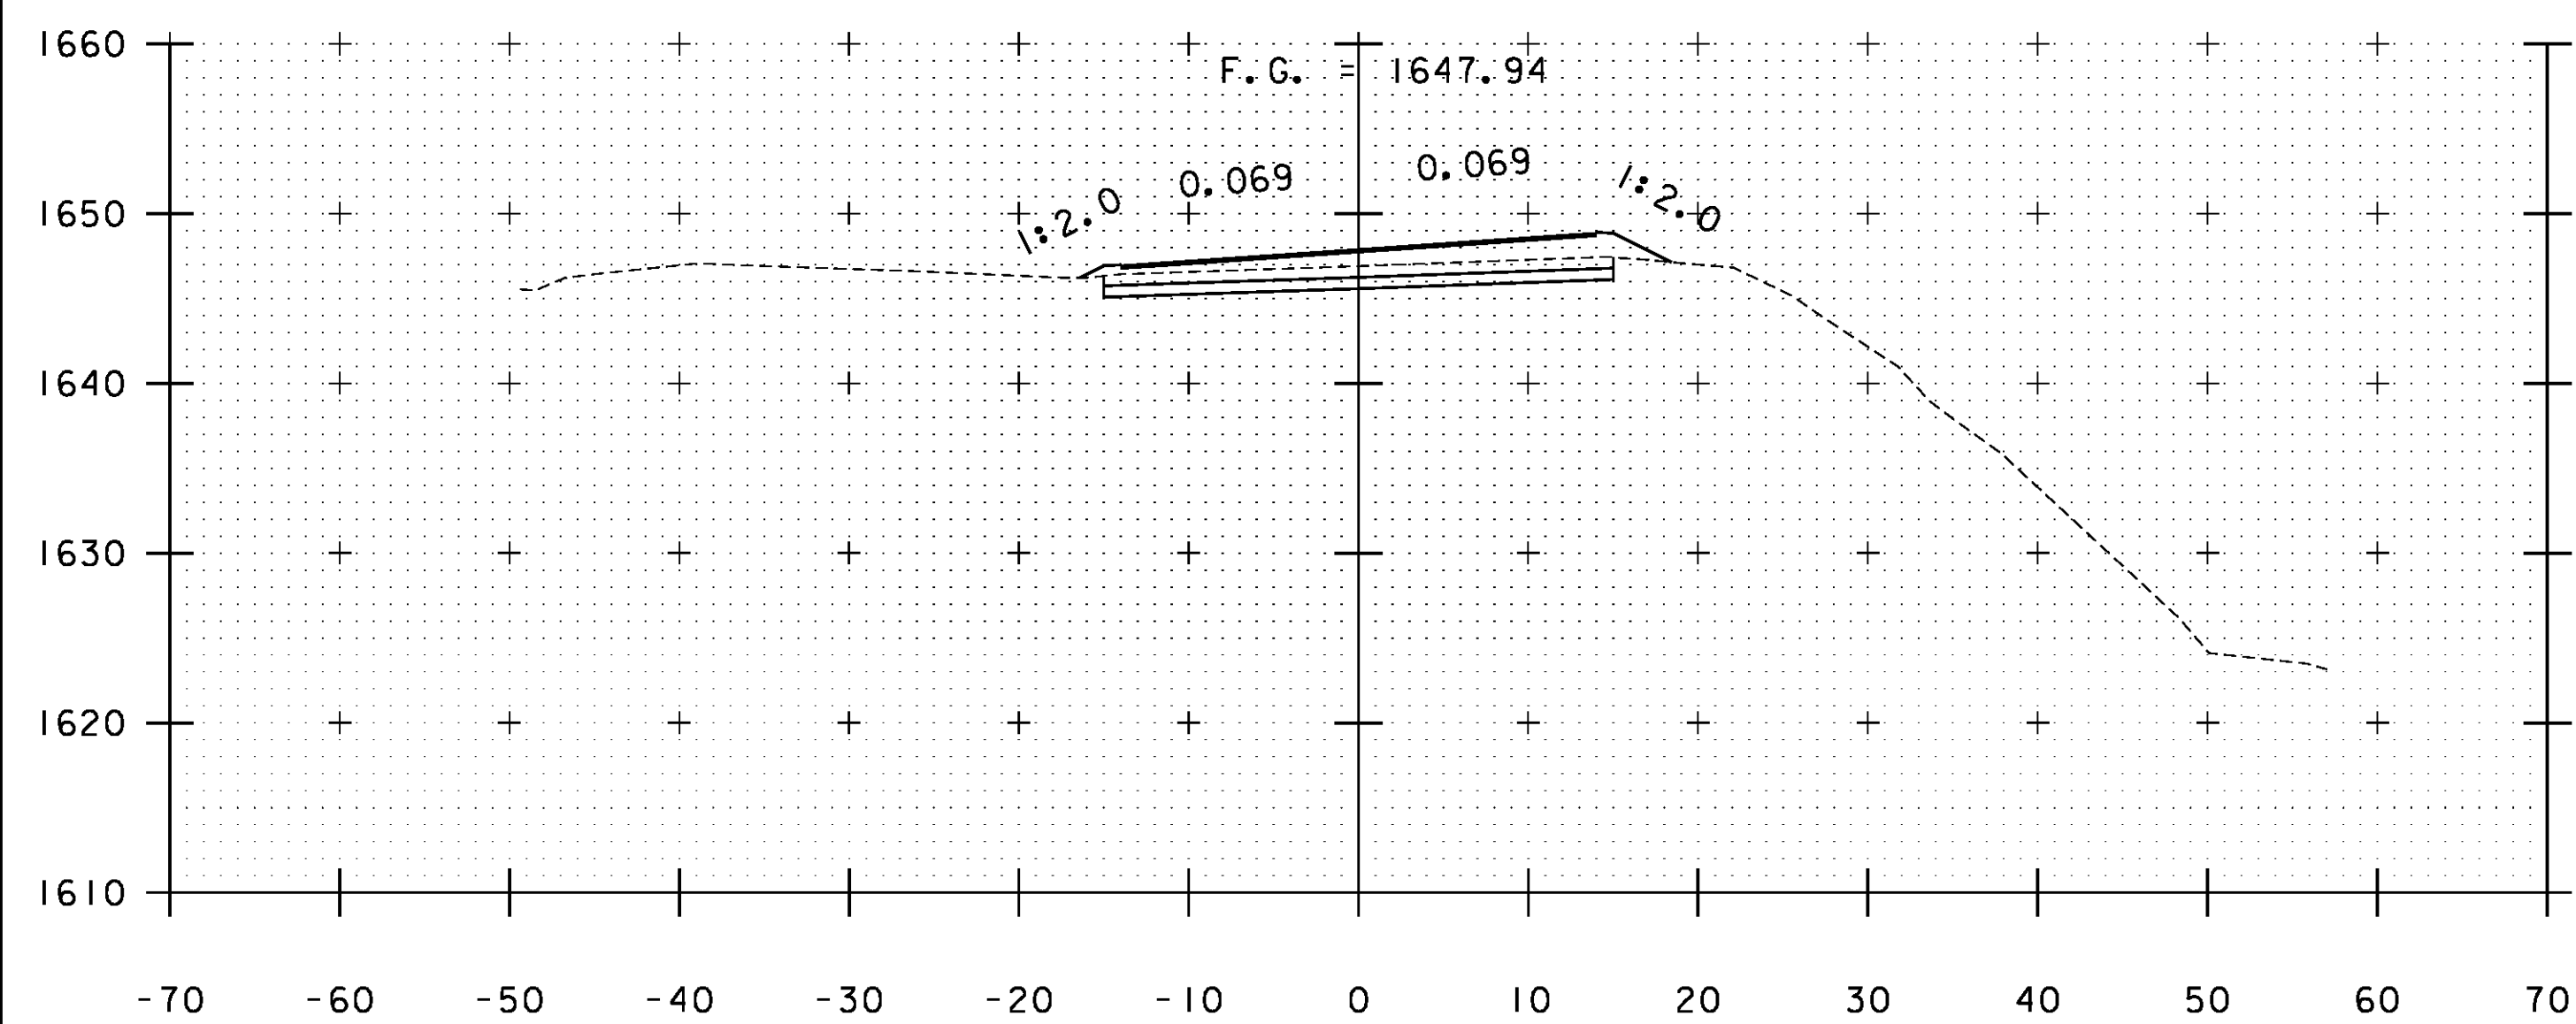

A 84+50

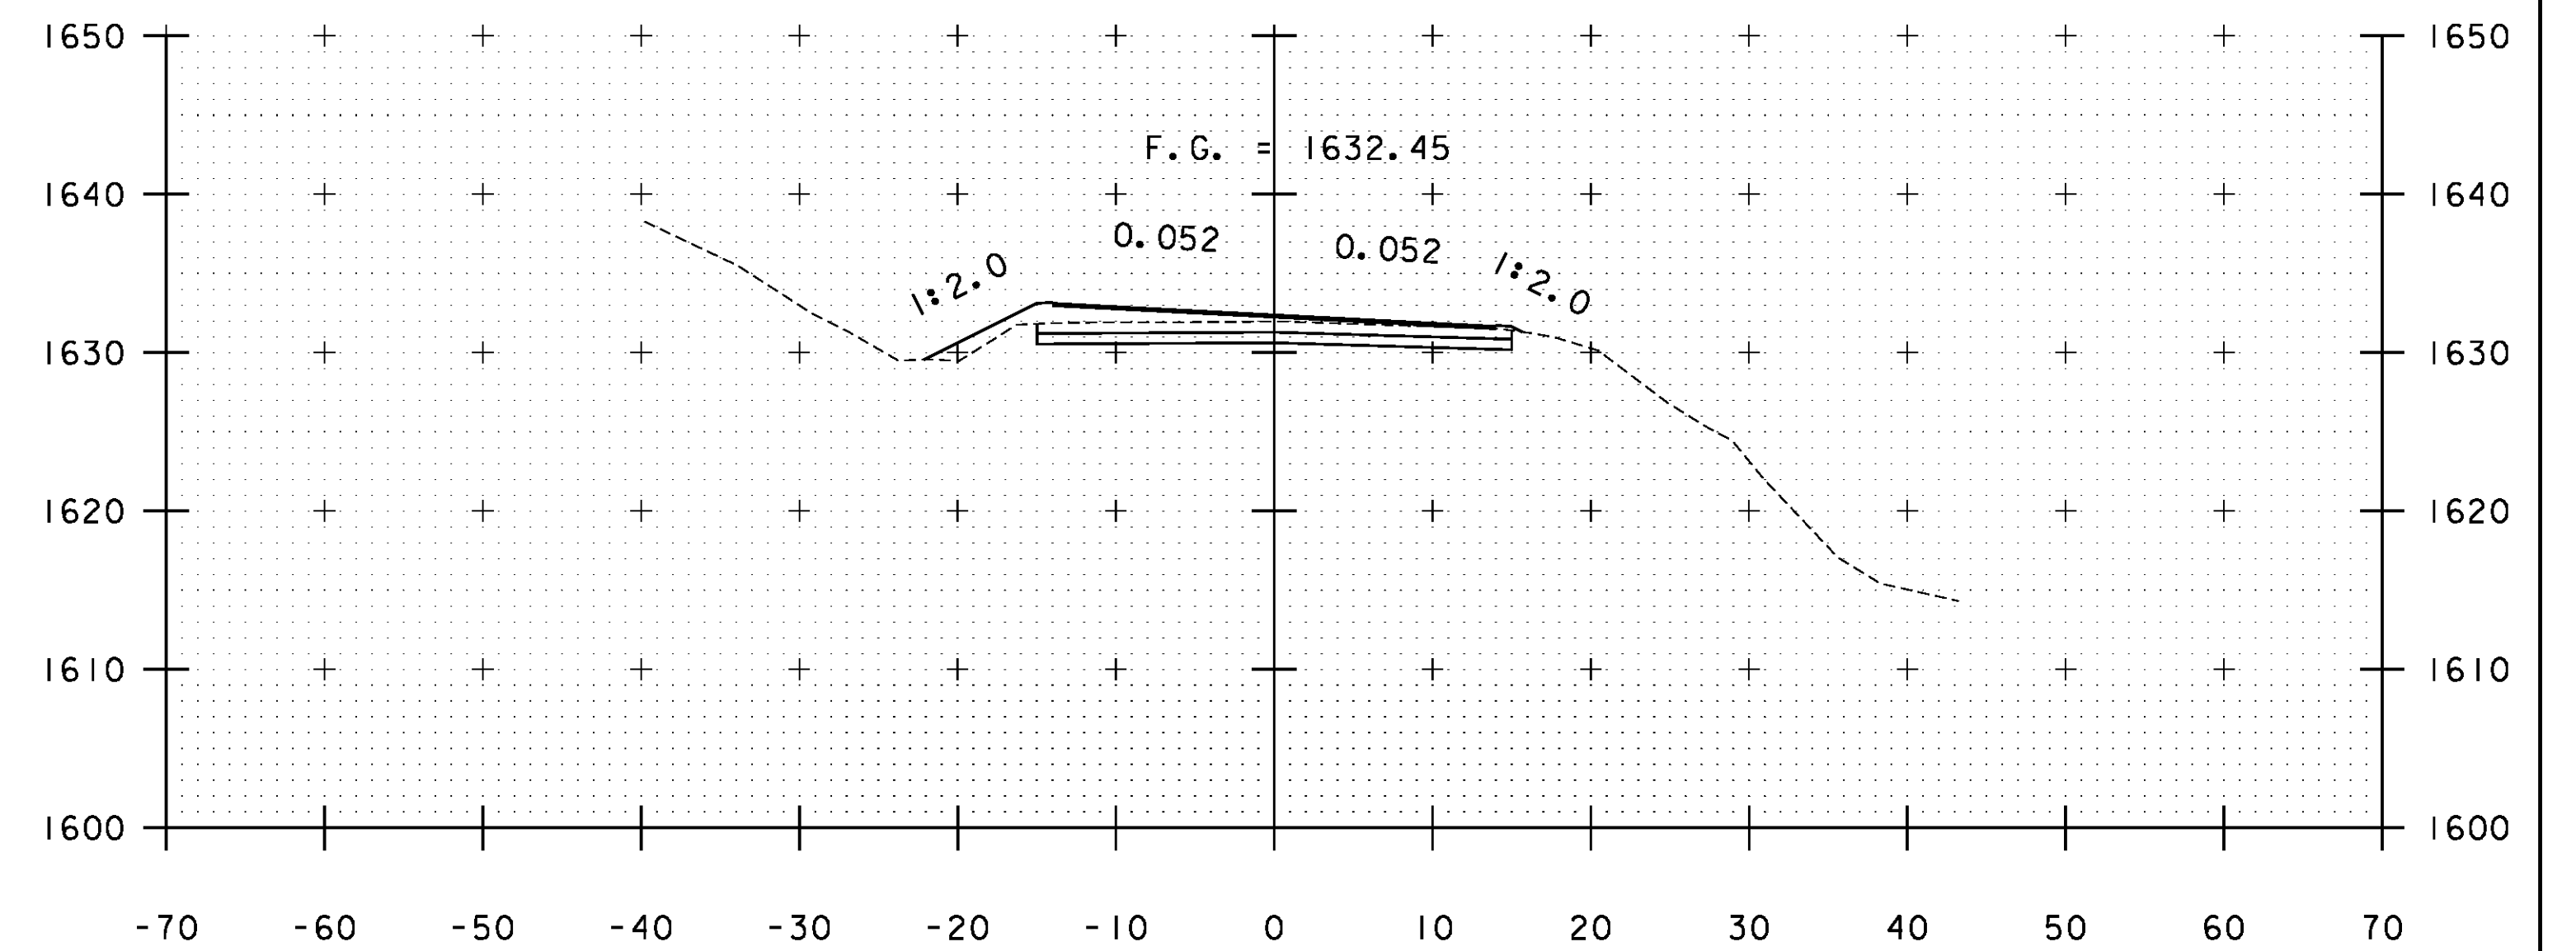

A 86+00

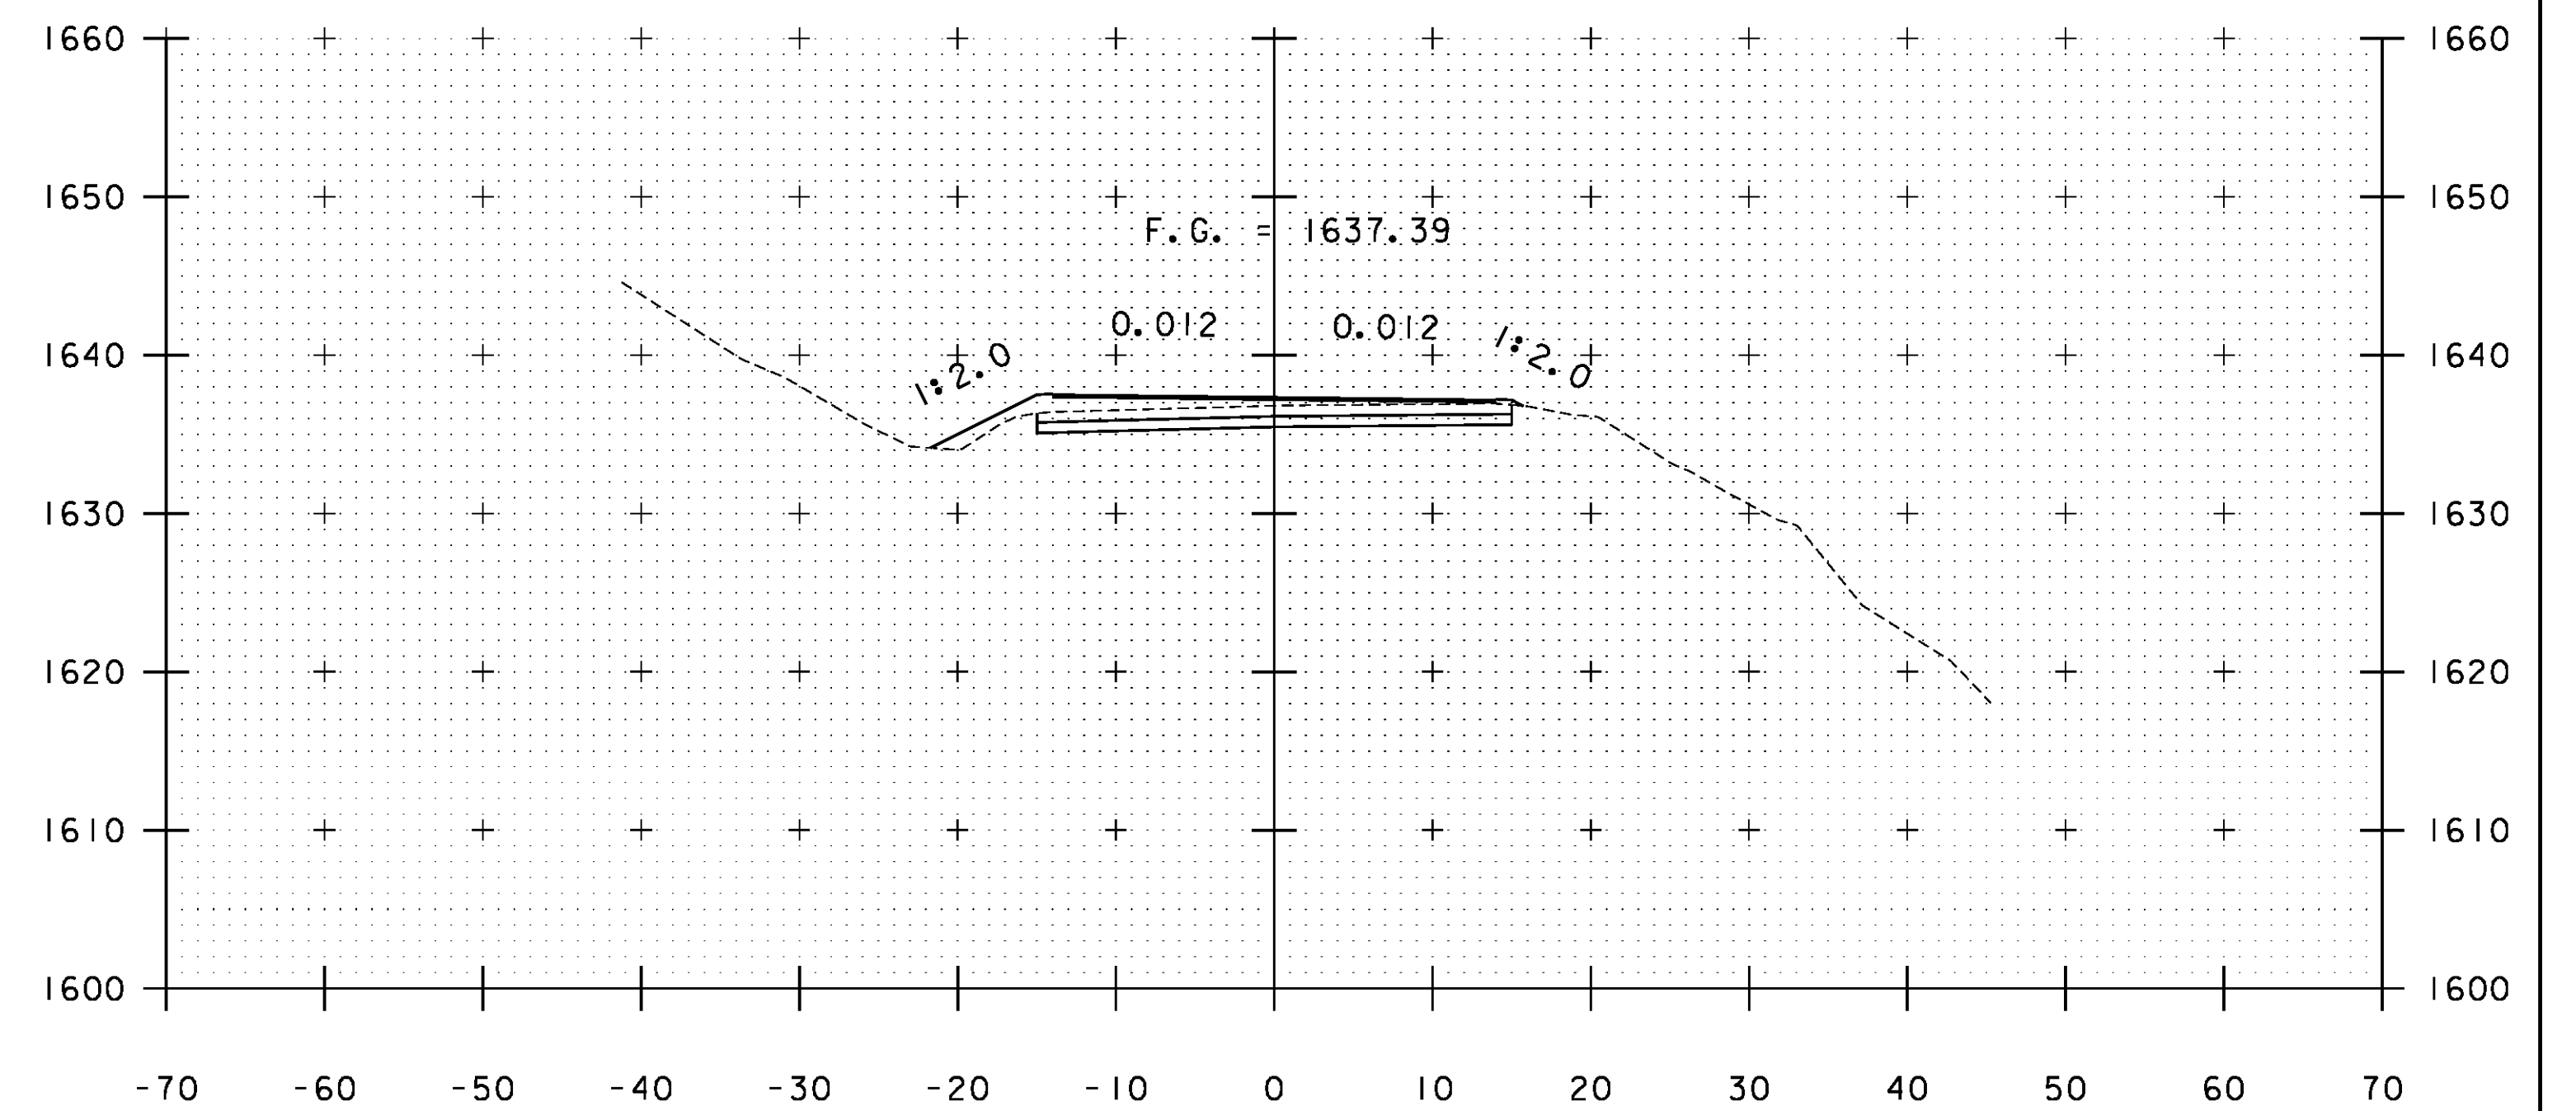

A 85+50

STA. A 84+50 TO STA. A 86+00

| | |
|----------------------------------|----------------------|
| PROJECT NAME: WARDBORO-JAMAICA | |
| PROJECT NUMBER: ER STP 013-1(17) | |
| FILE NAME: xs.dgn | PLOT DATE: 2/26/2014 |
| PROJECT LEADER: K. UPMAL | DRAWN BY: B. KIPP |
| DESIGNED BY: B. KIPP | CHECKED BY: HSD |
| CROSS SECTIONS | SHEET 211 OF 444 |