




A 139+00

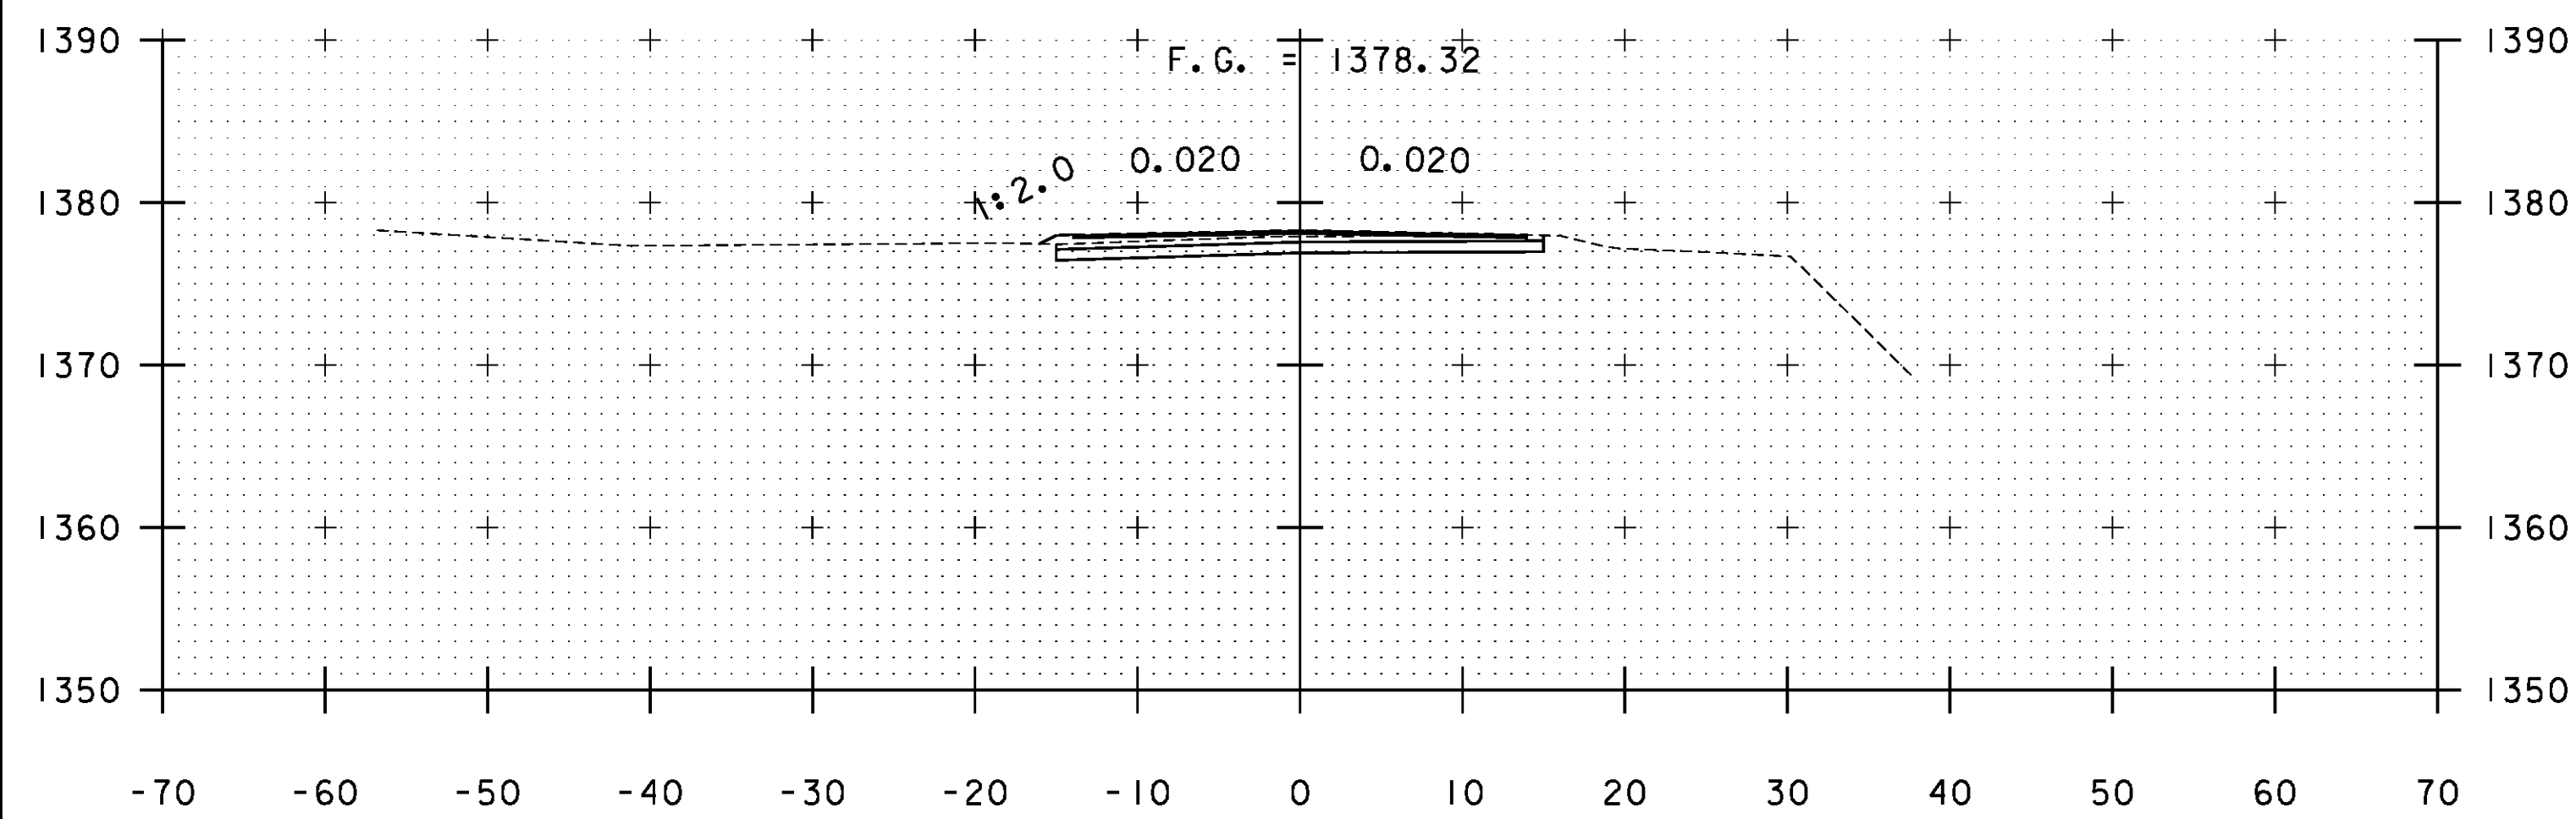


A 138+50

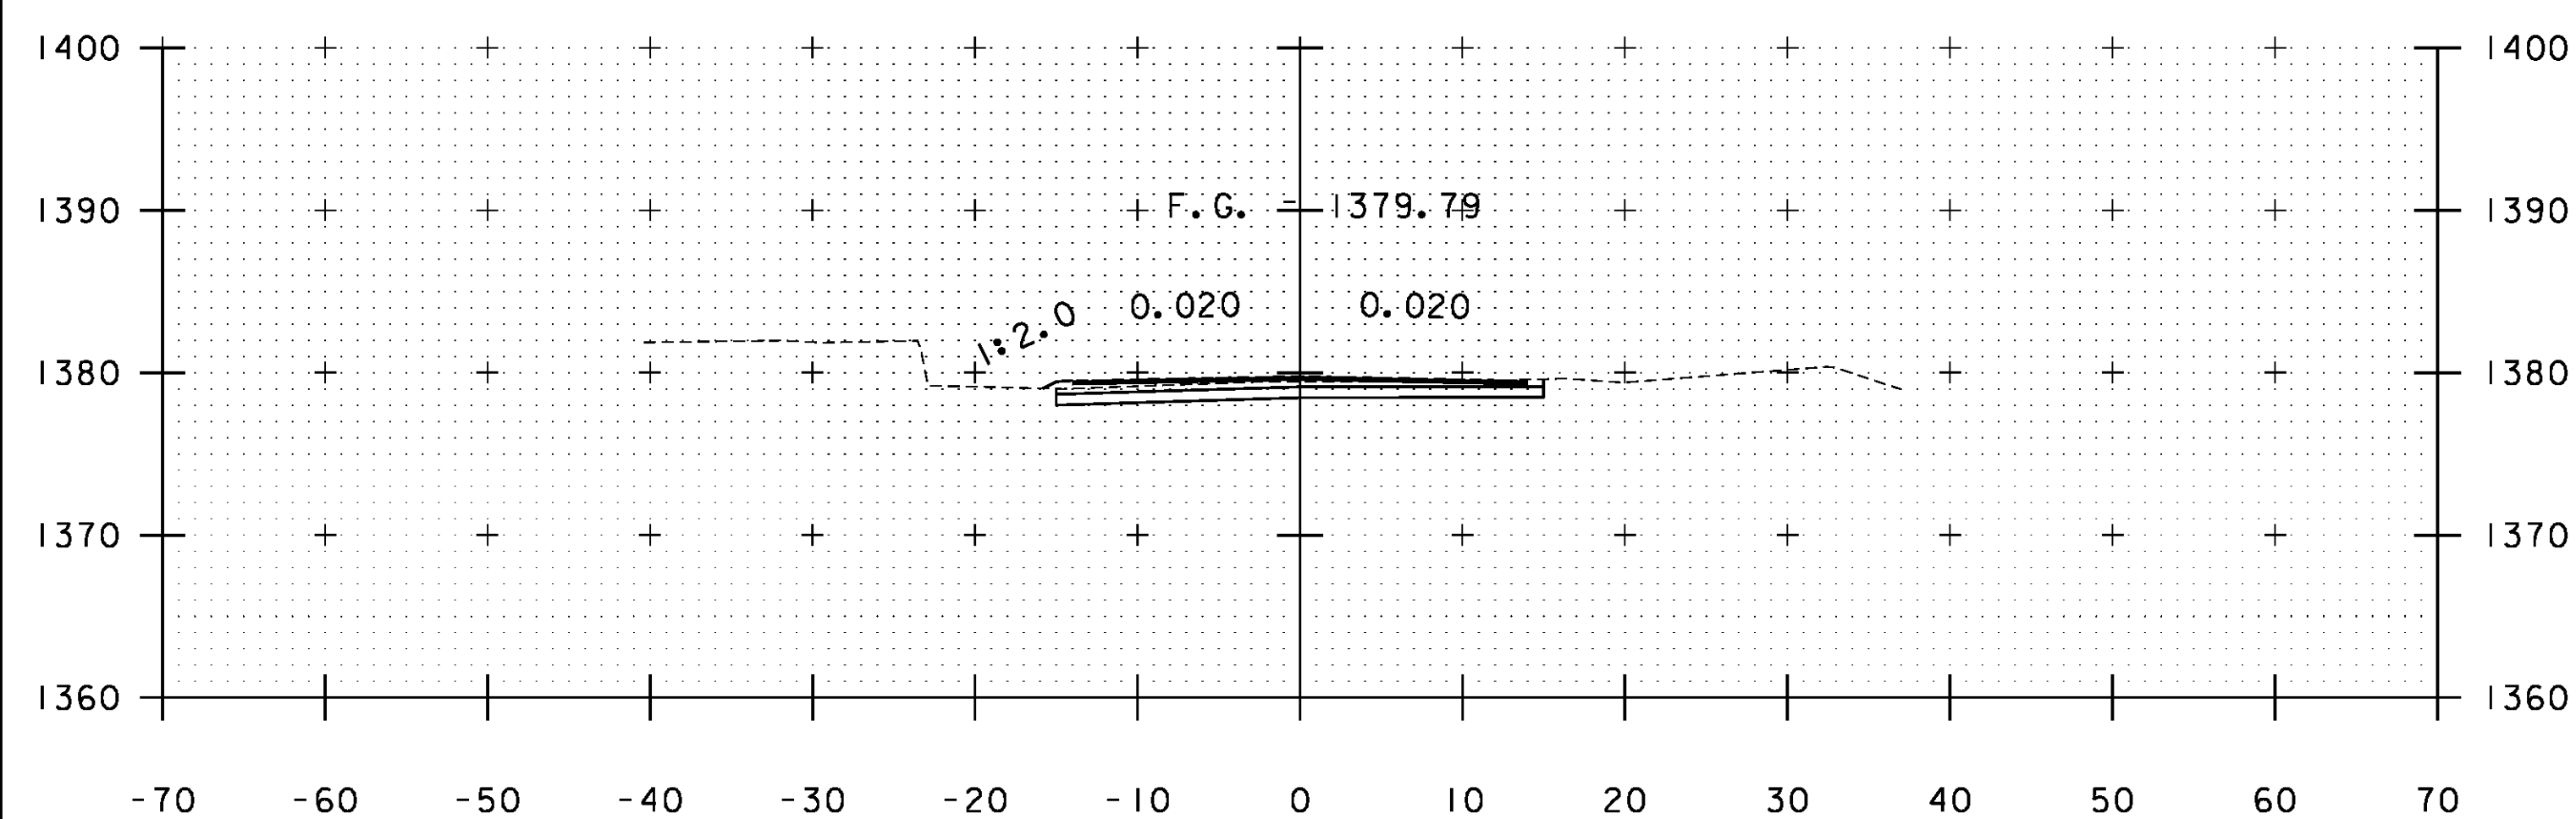

A 138+00

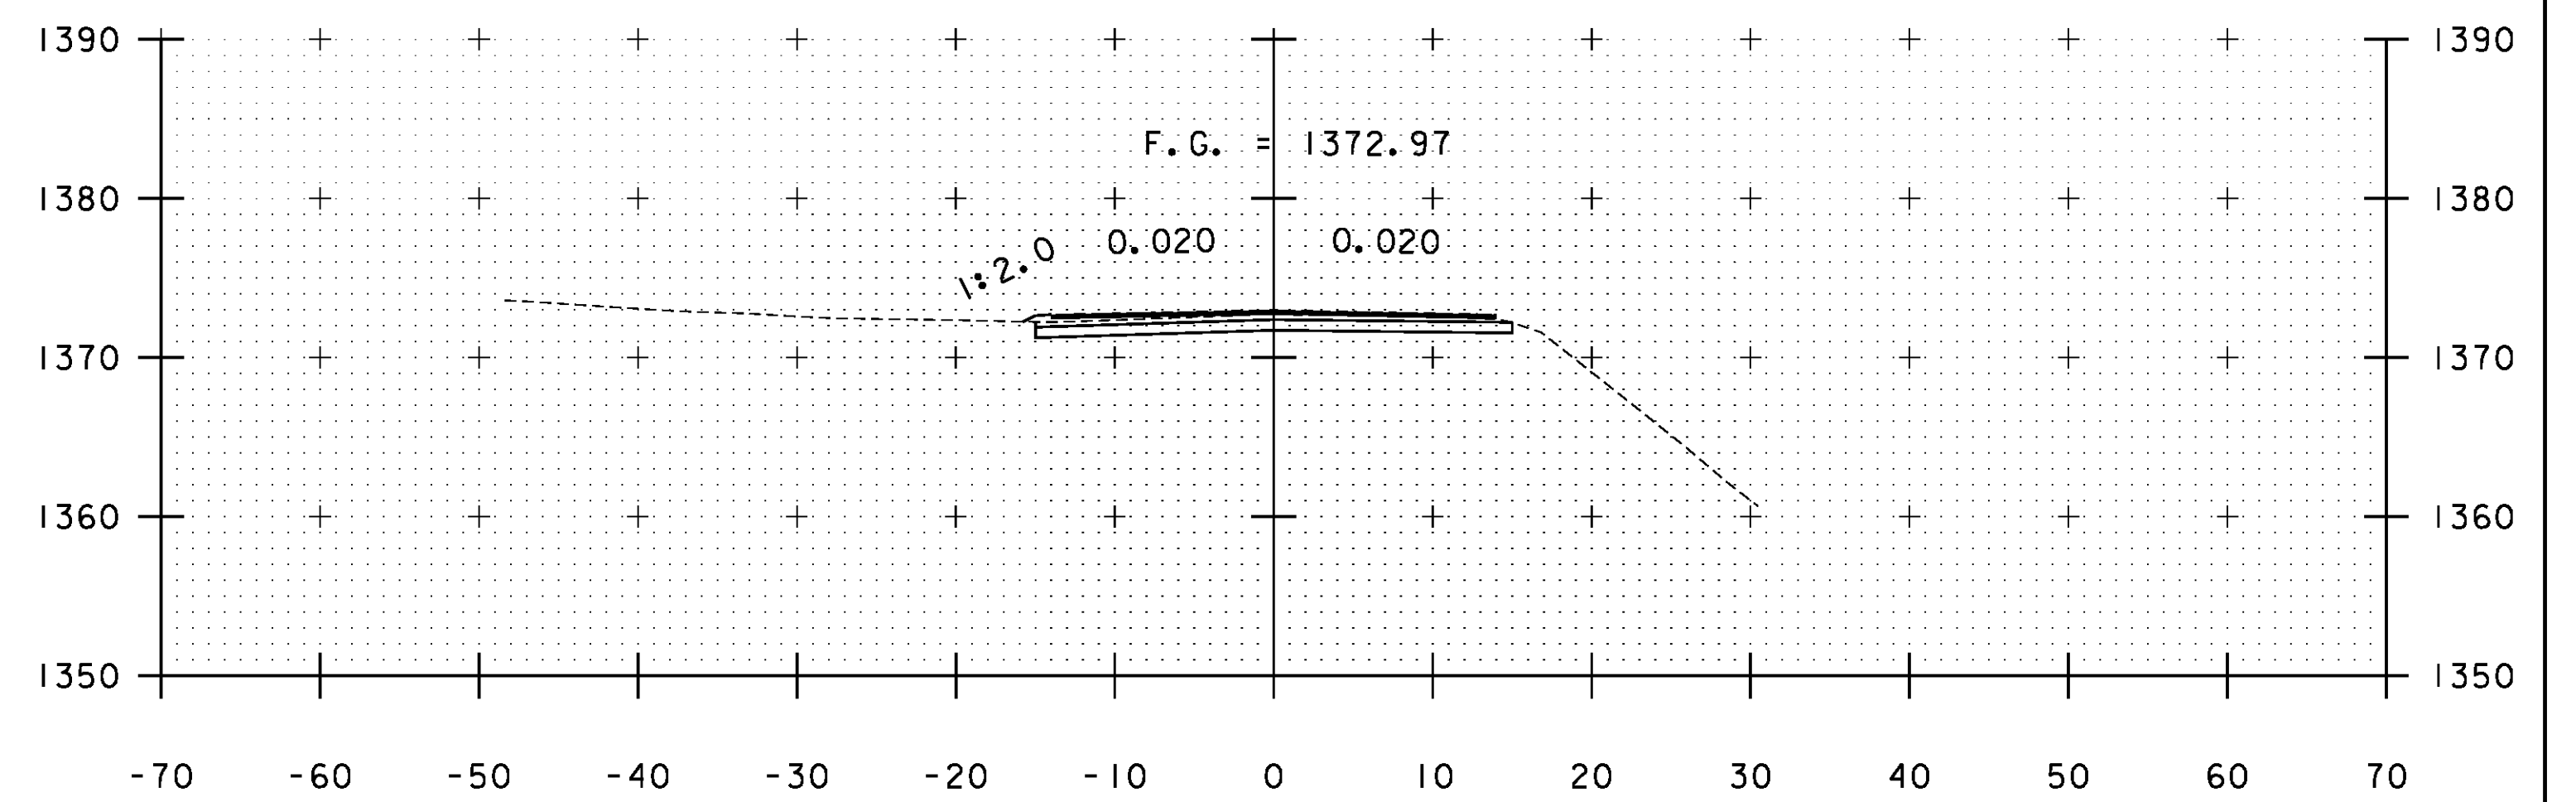

A 140+00

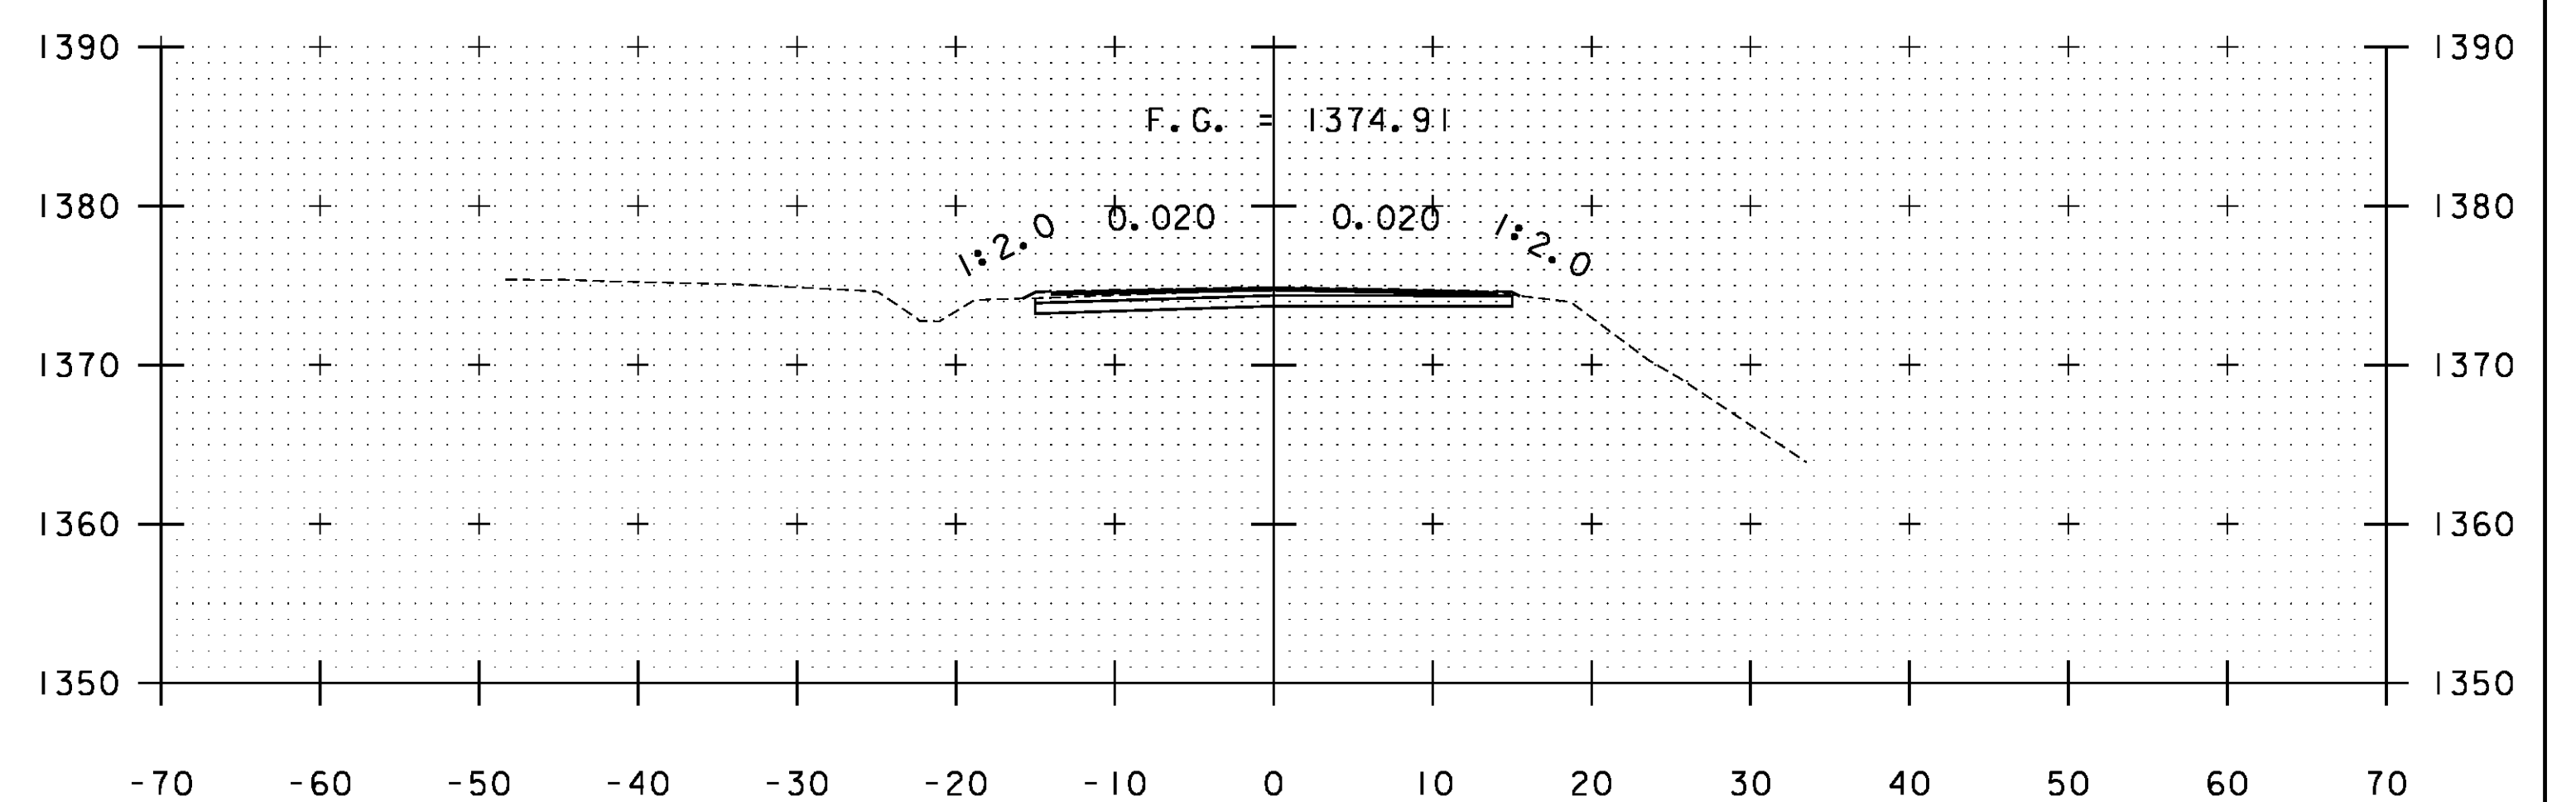

A 139+50

STA. A 138+00 TO STA. A 140+00

PROJECT NAME: WARDBORO-JAMAICA	PLOT DATE: 2/26/2014
PROJECT NUMBER: ER STP 013-1(17)	DRAWN BY: B. KIPP
FILE NAME: xs.dgn	CHECKED BY: HSD
PROJECT LEADER: K. UPMAL	SHEET 227 OF 444
DESIGNED BY: B. KIPP	
CROSS SECTIONS	