




A 155+50

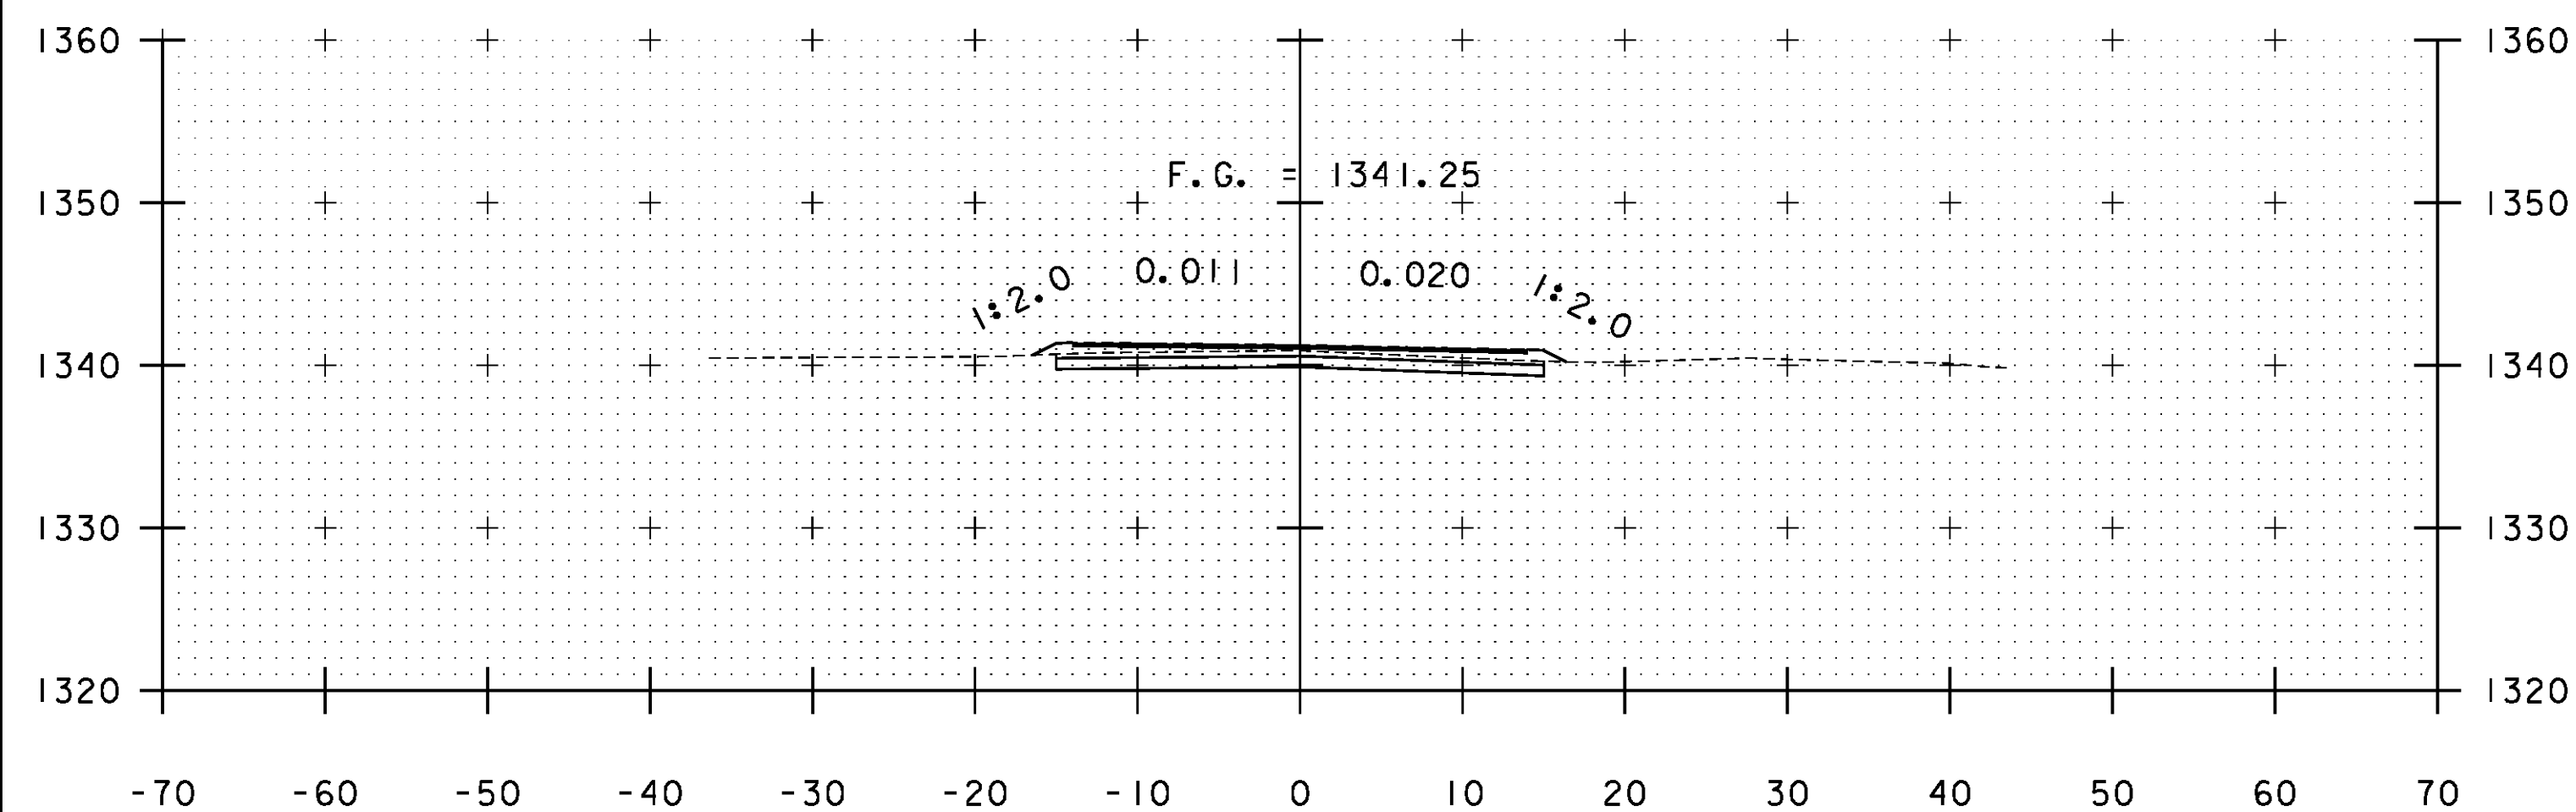


A 155+00

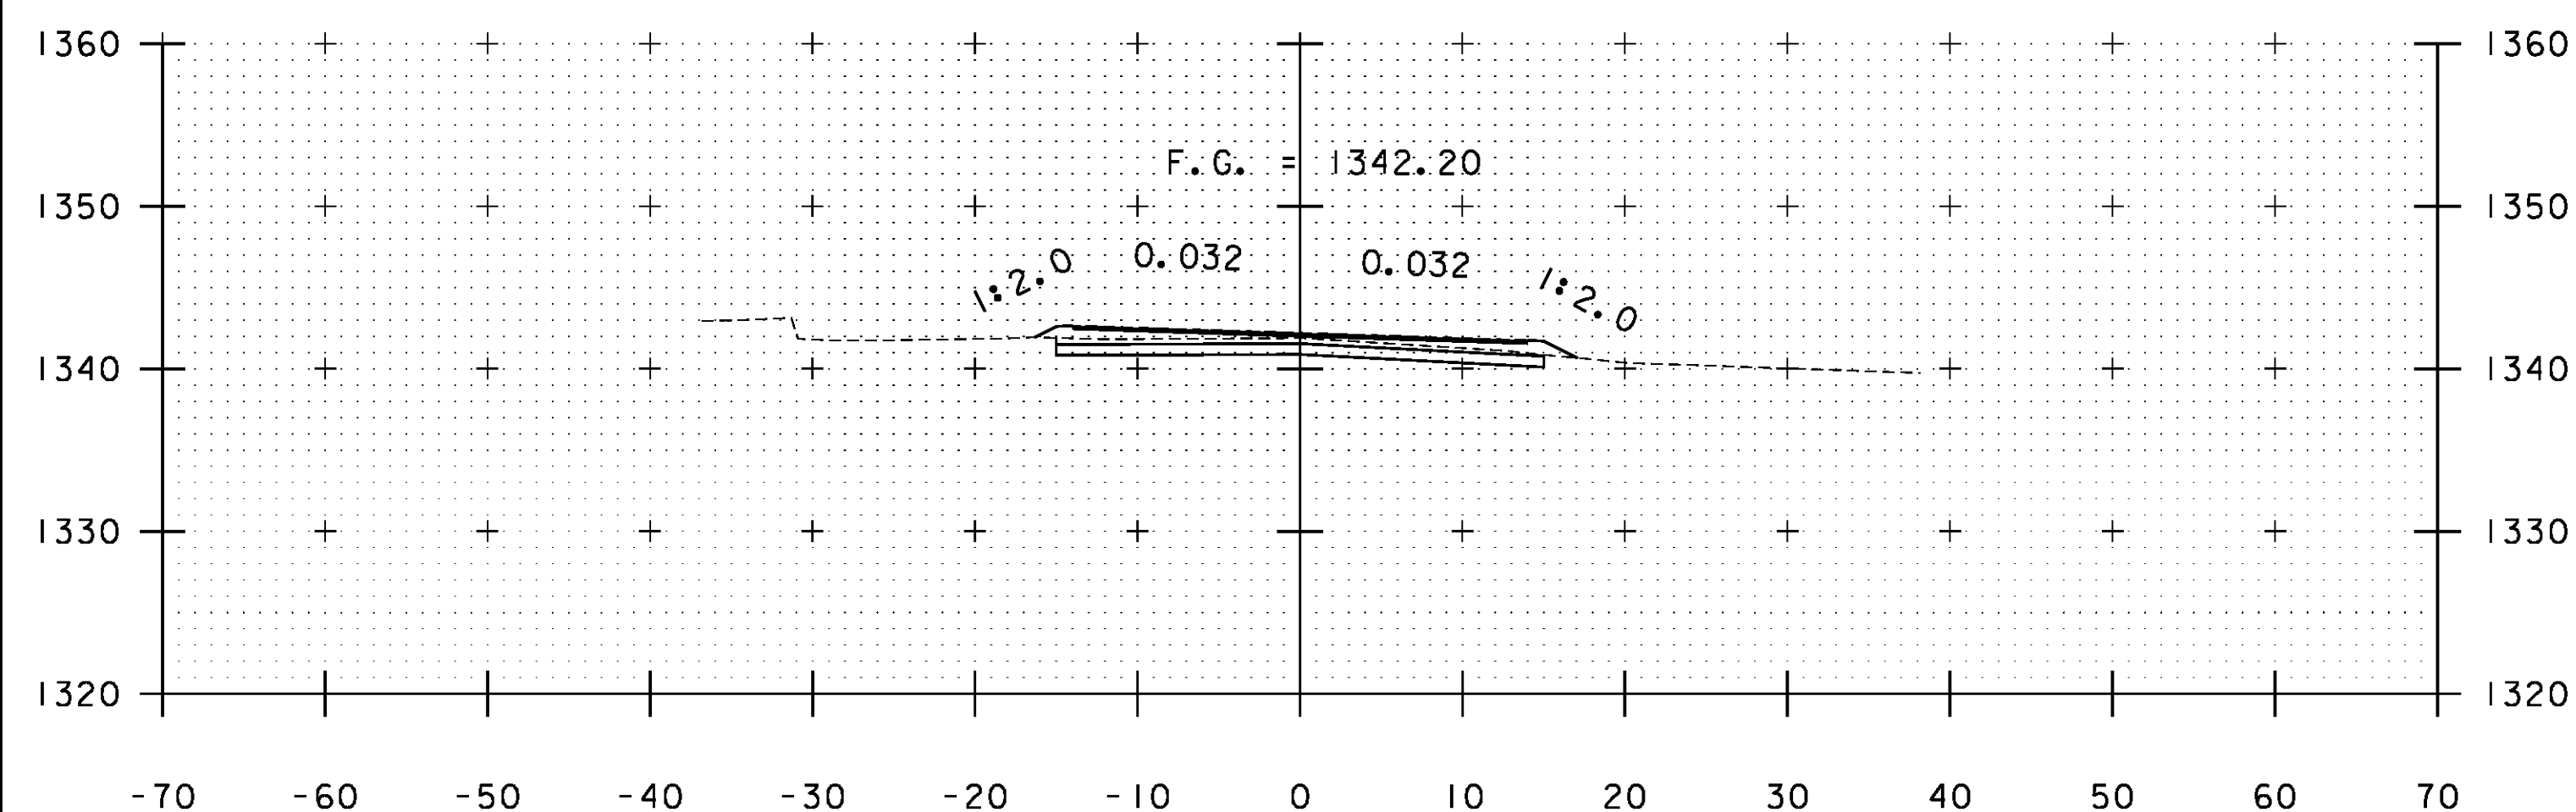


A 154+50

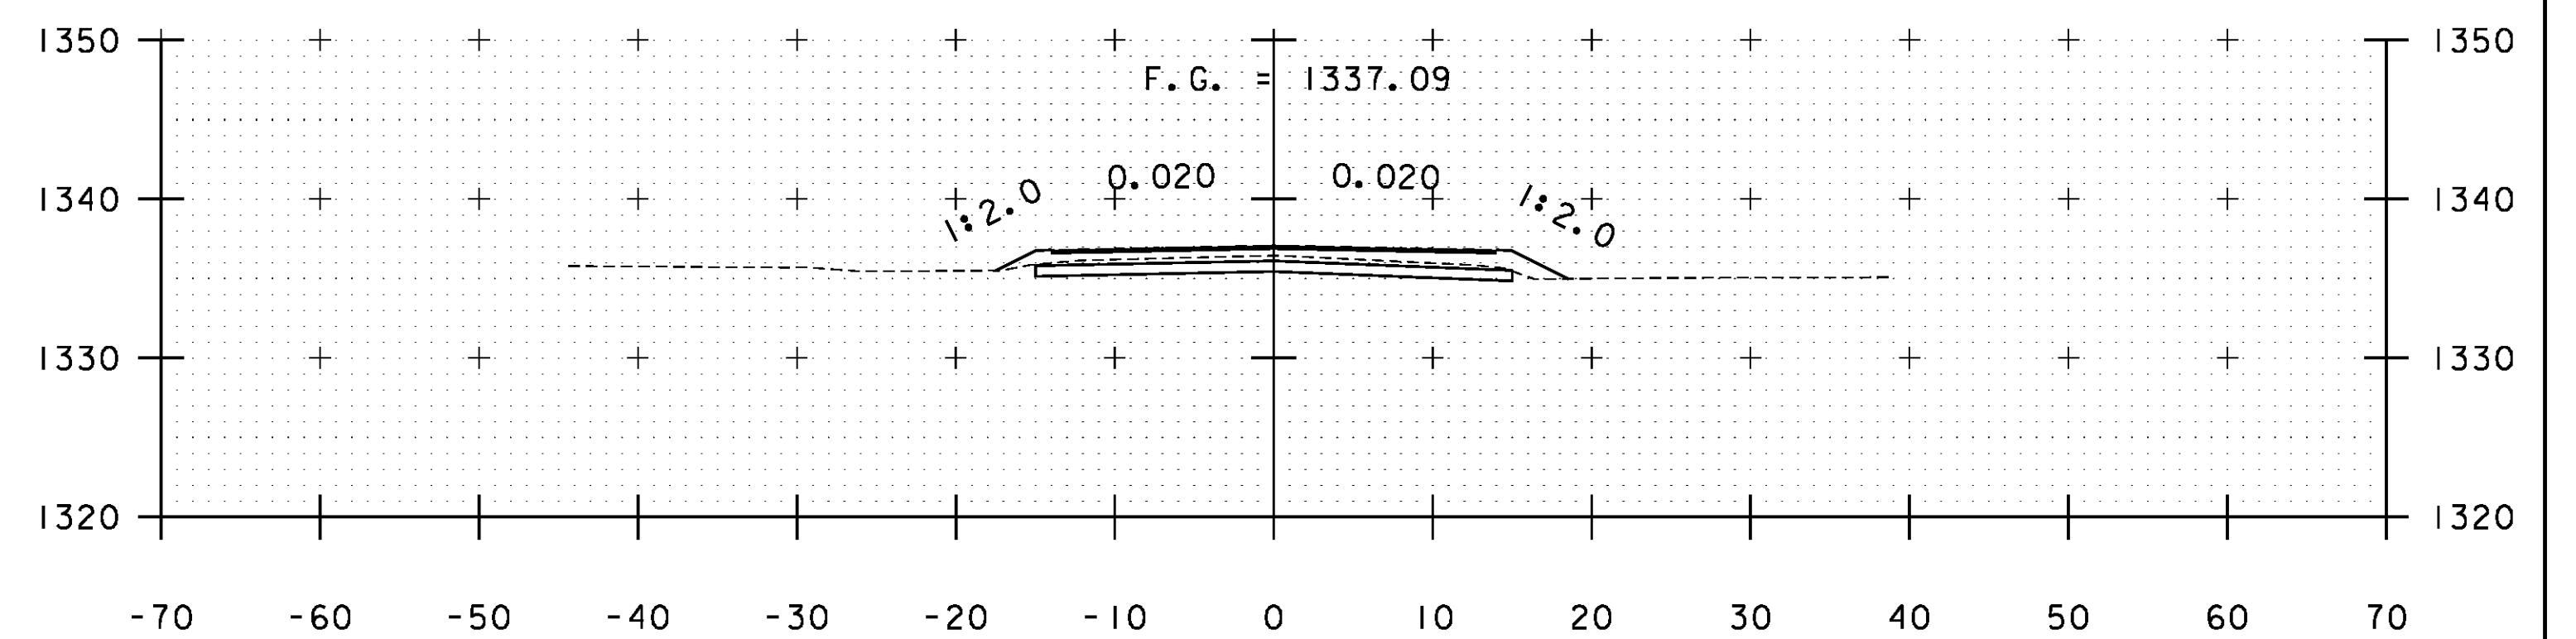

A 157+00

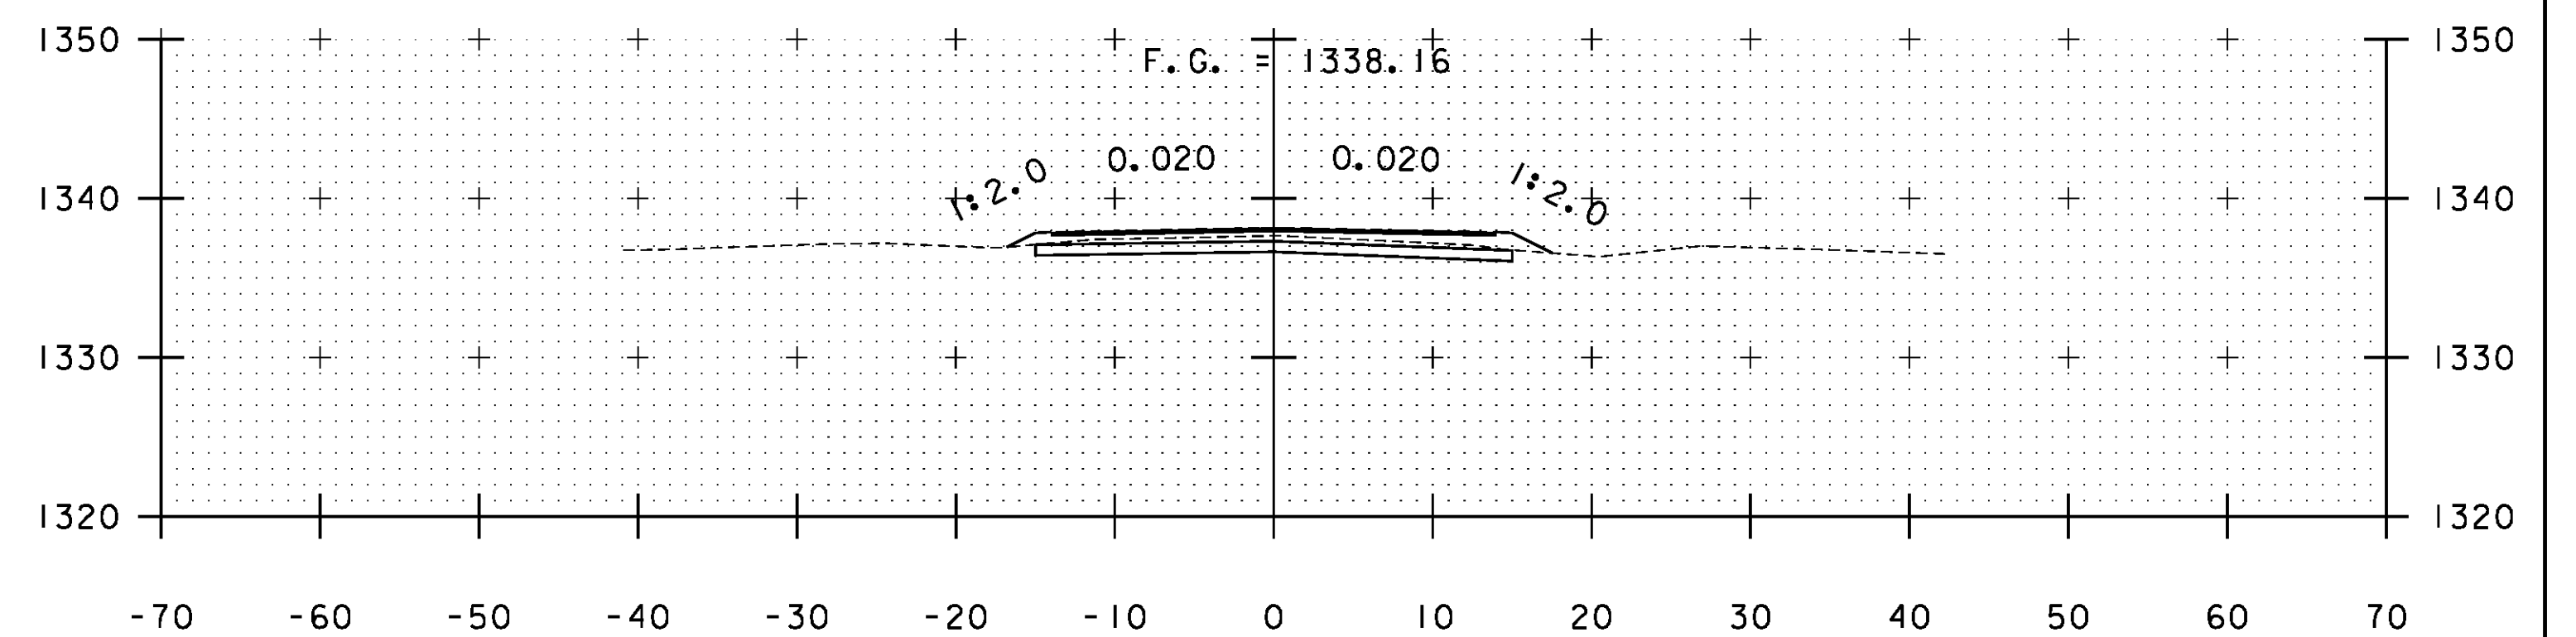

A 156+50

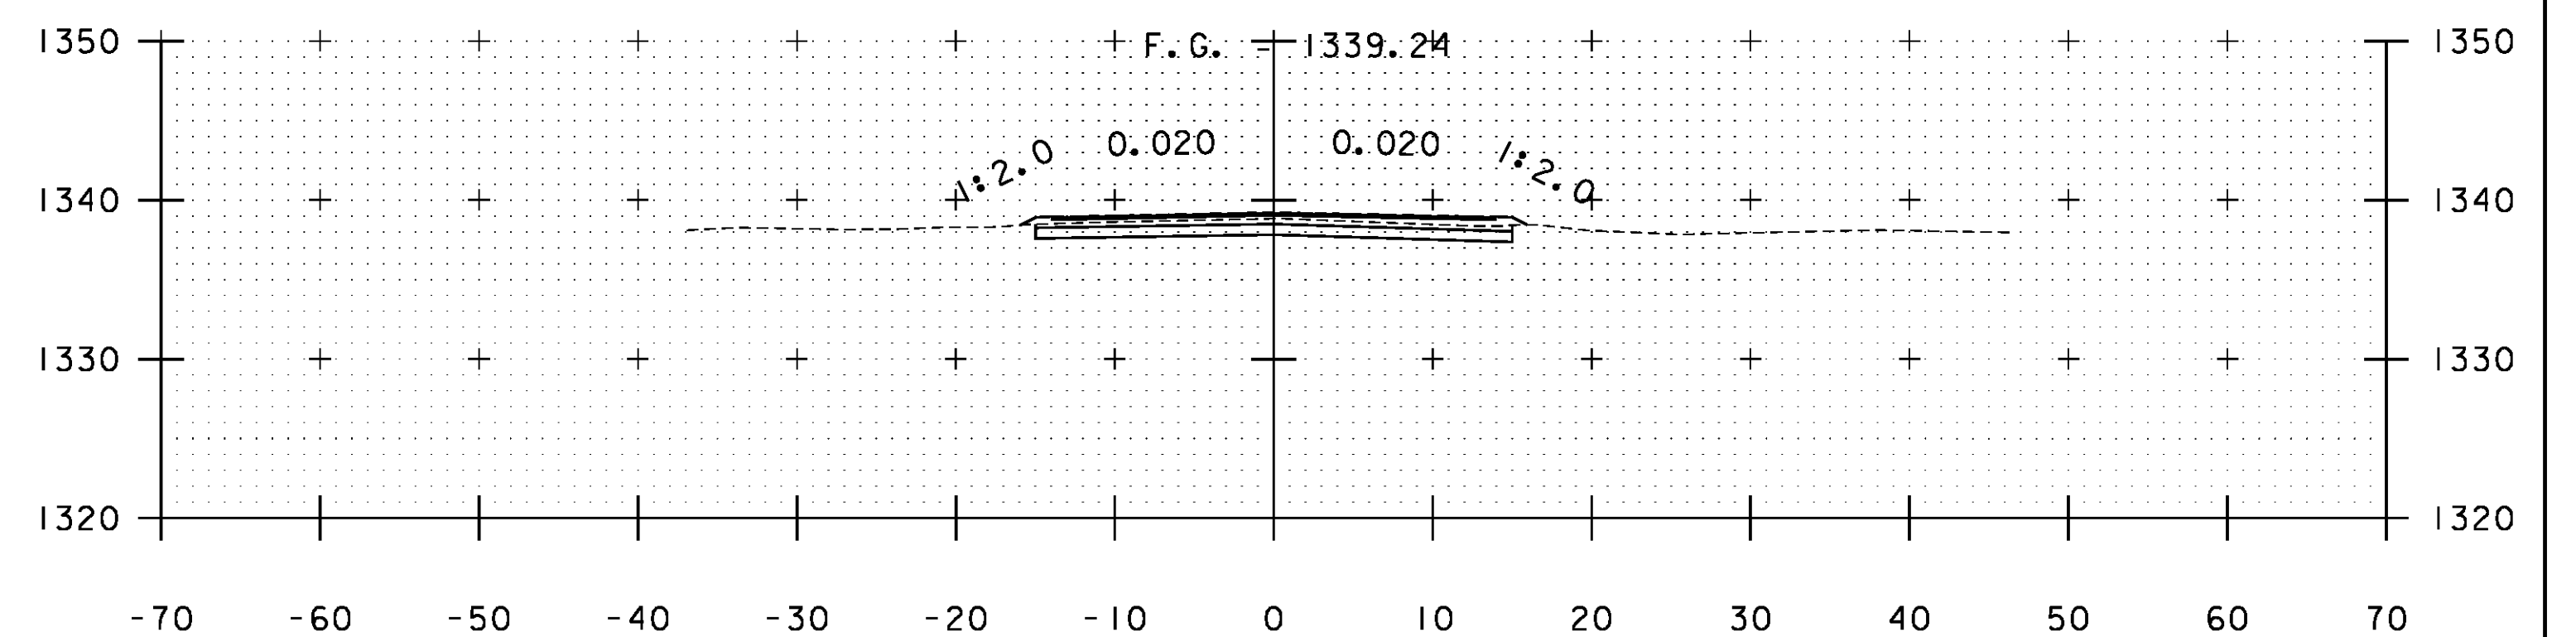

A 156+00

STA. A 154+50 TO STA. A 157+00

PROJECT NAME: WARDBORO-JAMAICA	PLOT DATE: 2/26/2014
PROJECT NUMBER: ER STP 013-1(17)	DRAWN BY: B. KIPP
FILE NAME: xs.dgn	CHECKED BY: HSD
PROJECT LEADER: K. UPMAL	SHEET 234 OF 444
DESIGNED BY: B. KIPP	
CROSS SECTIONS	