




A 158+50

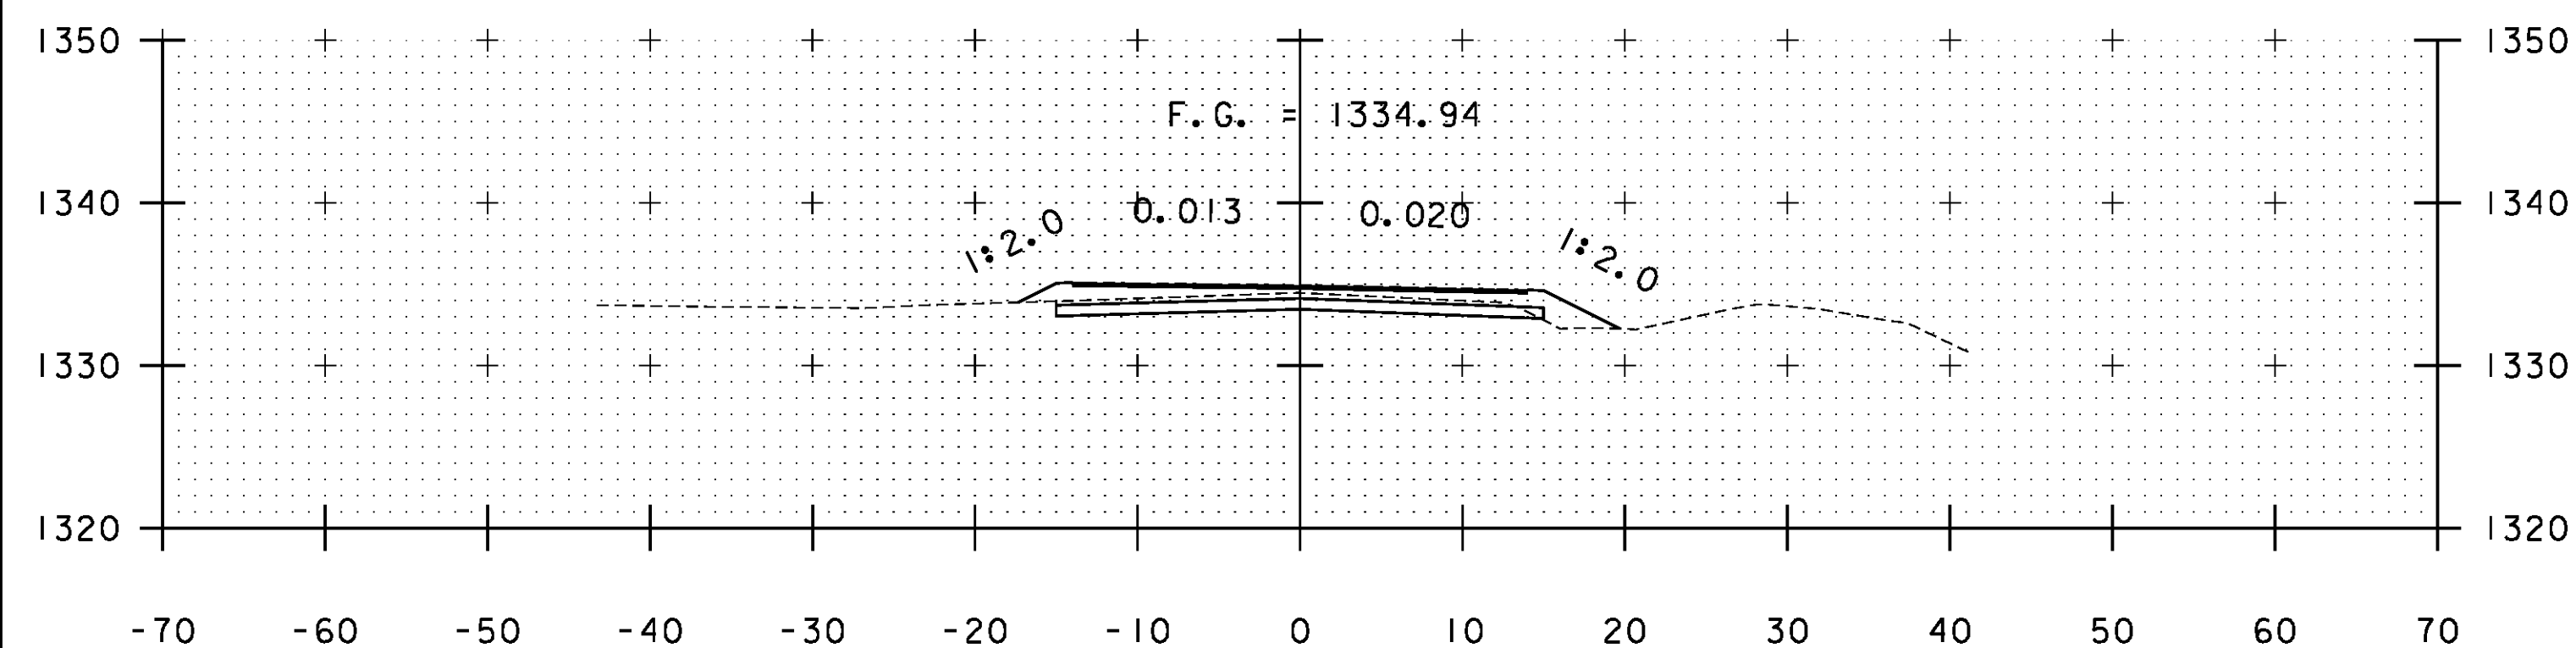


A 158+00

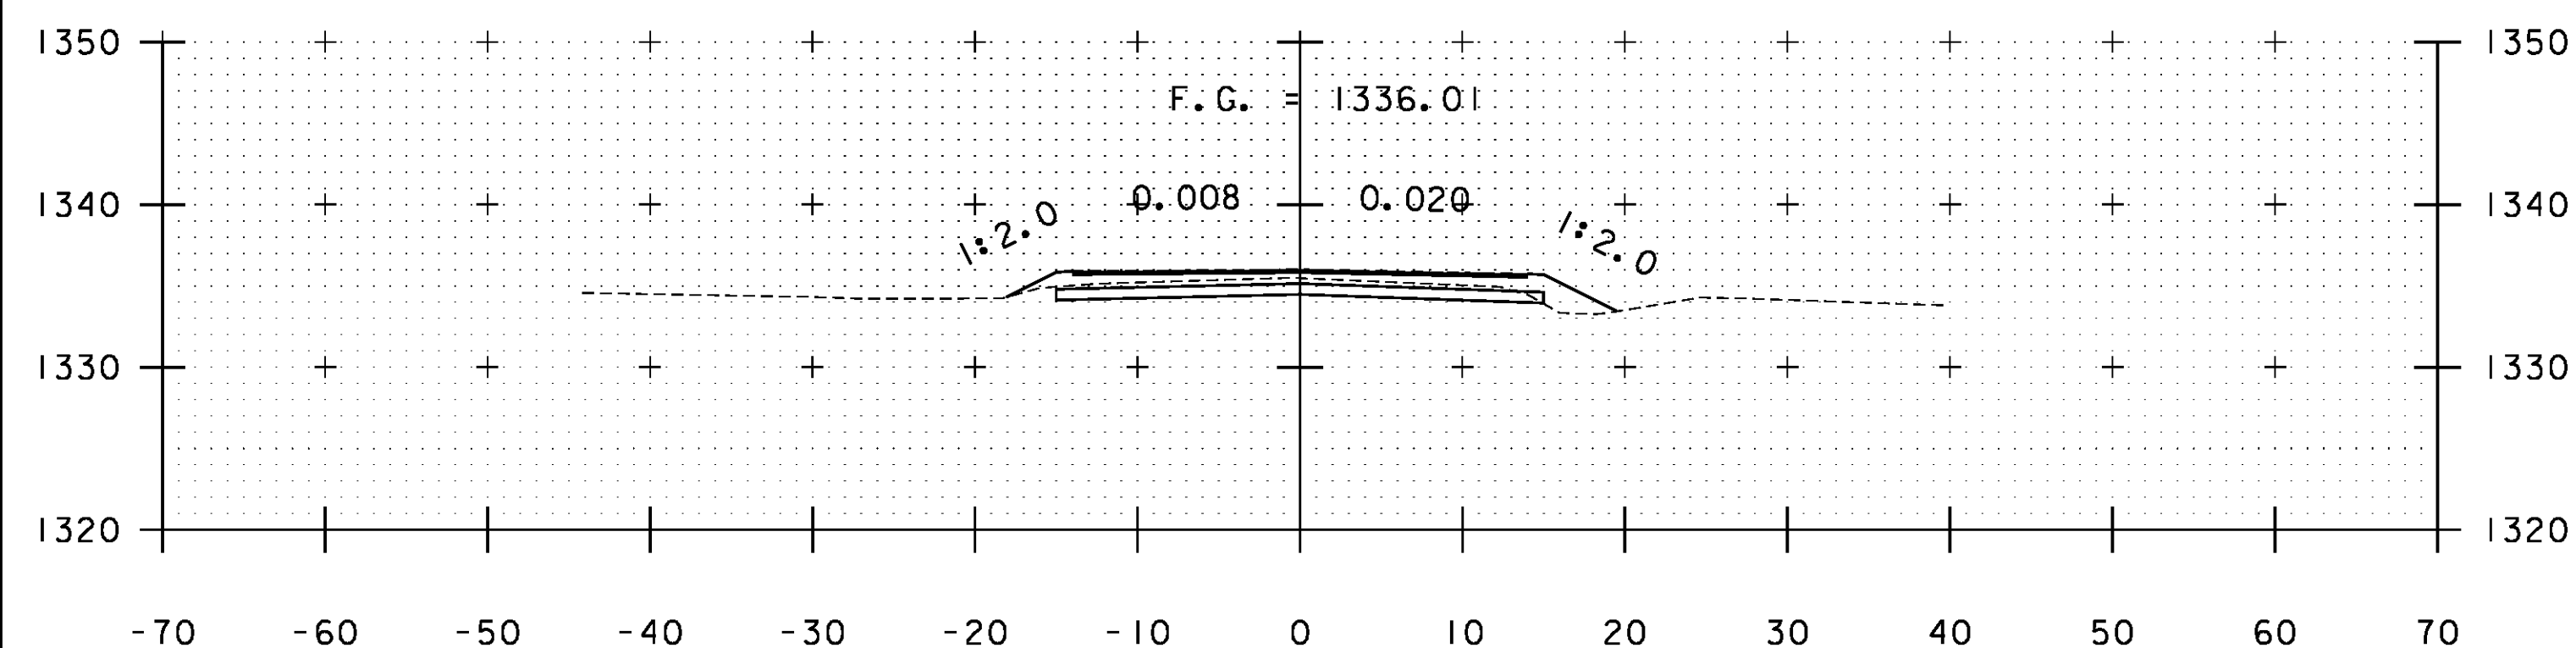


A 157+50

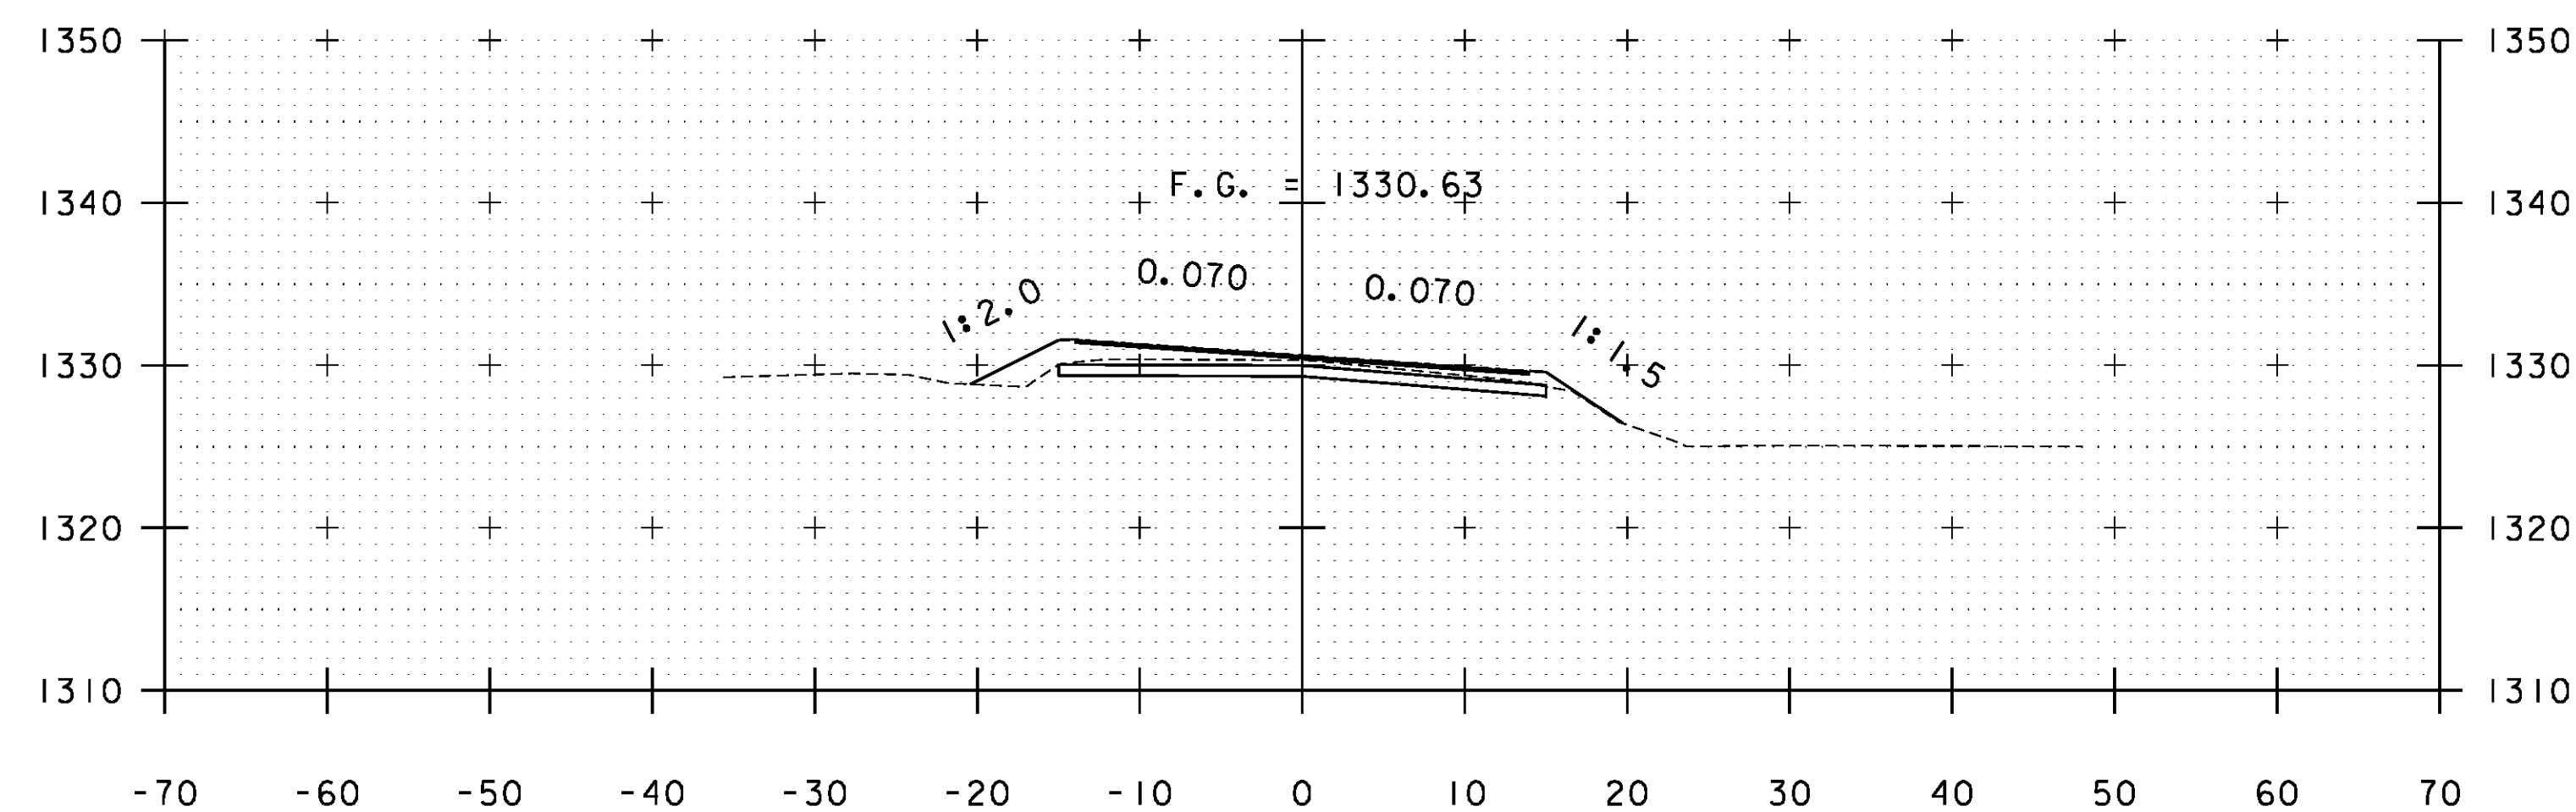

A 160+00

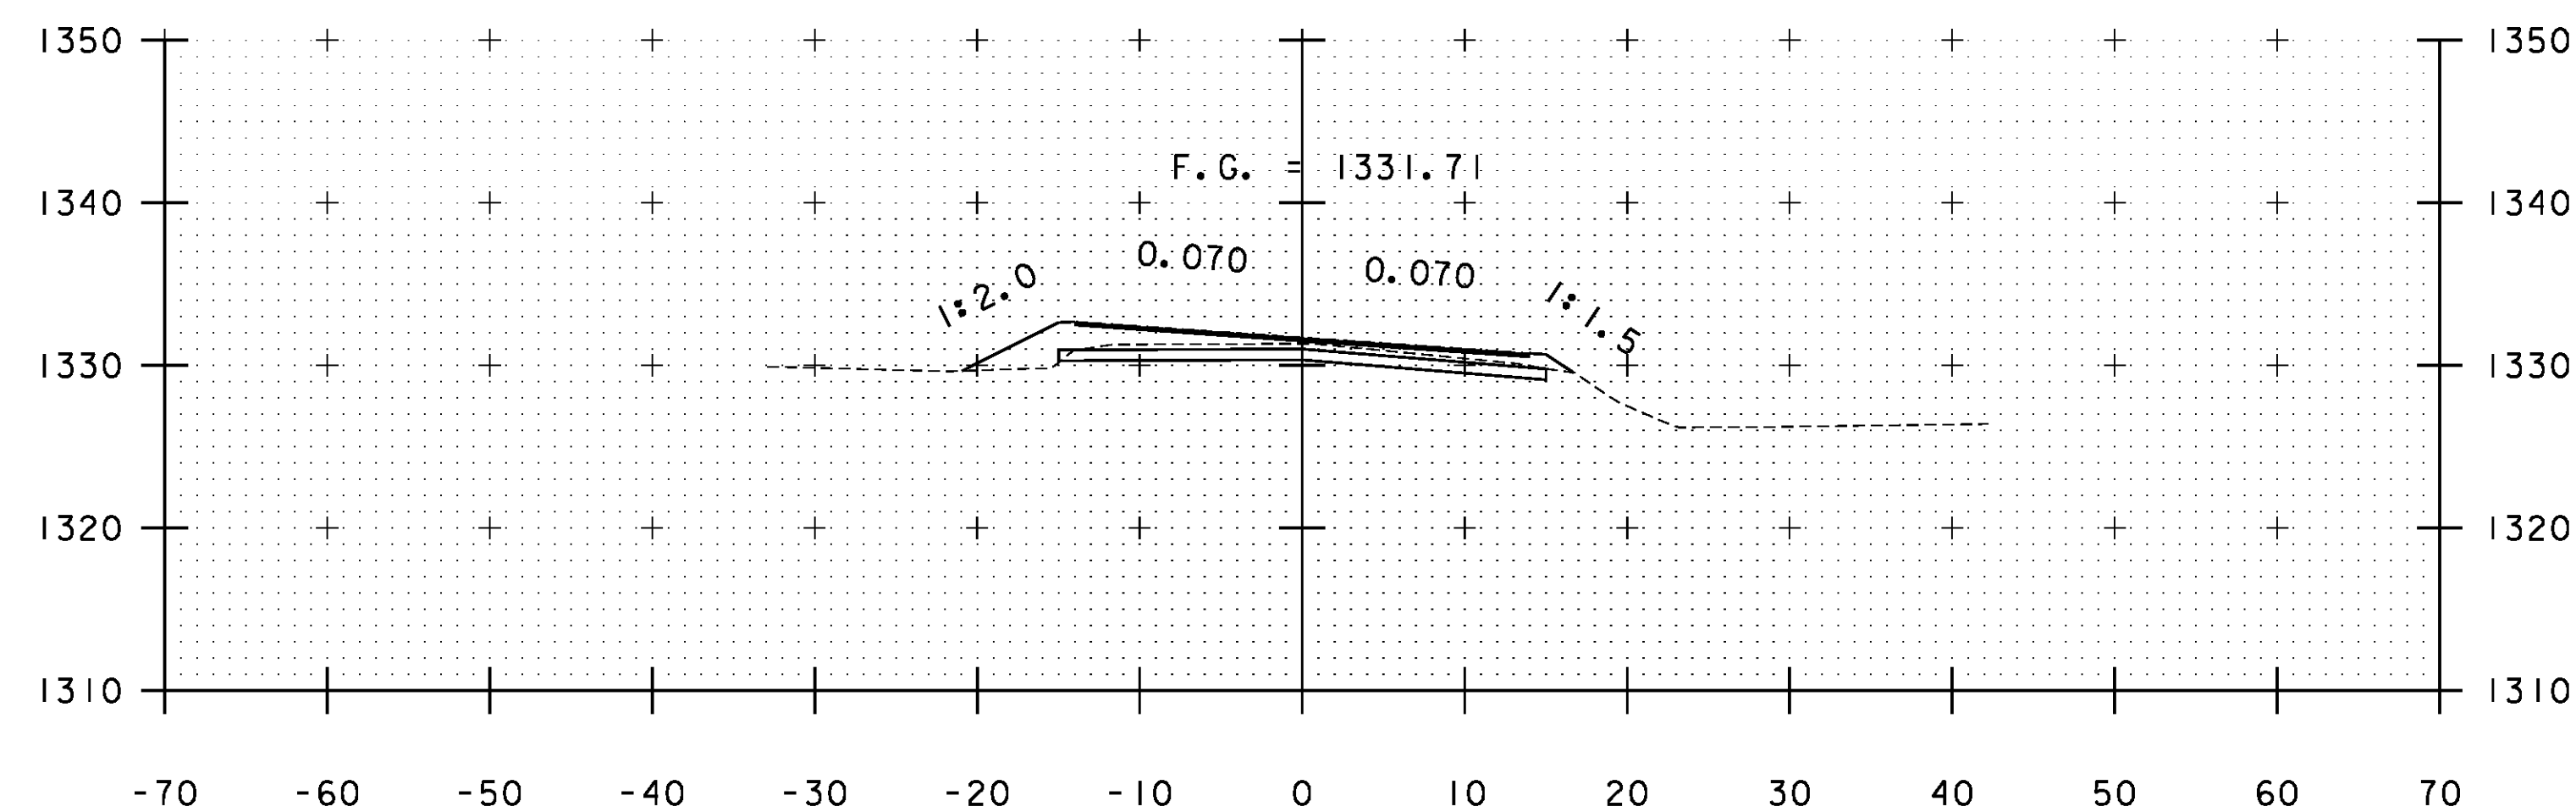

A 159+50

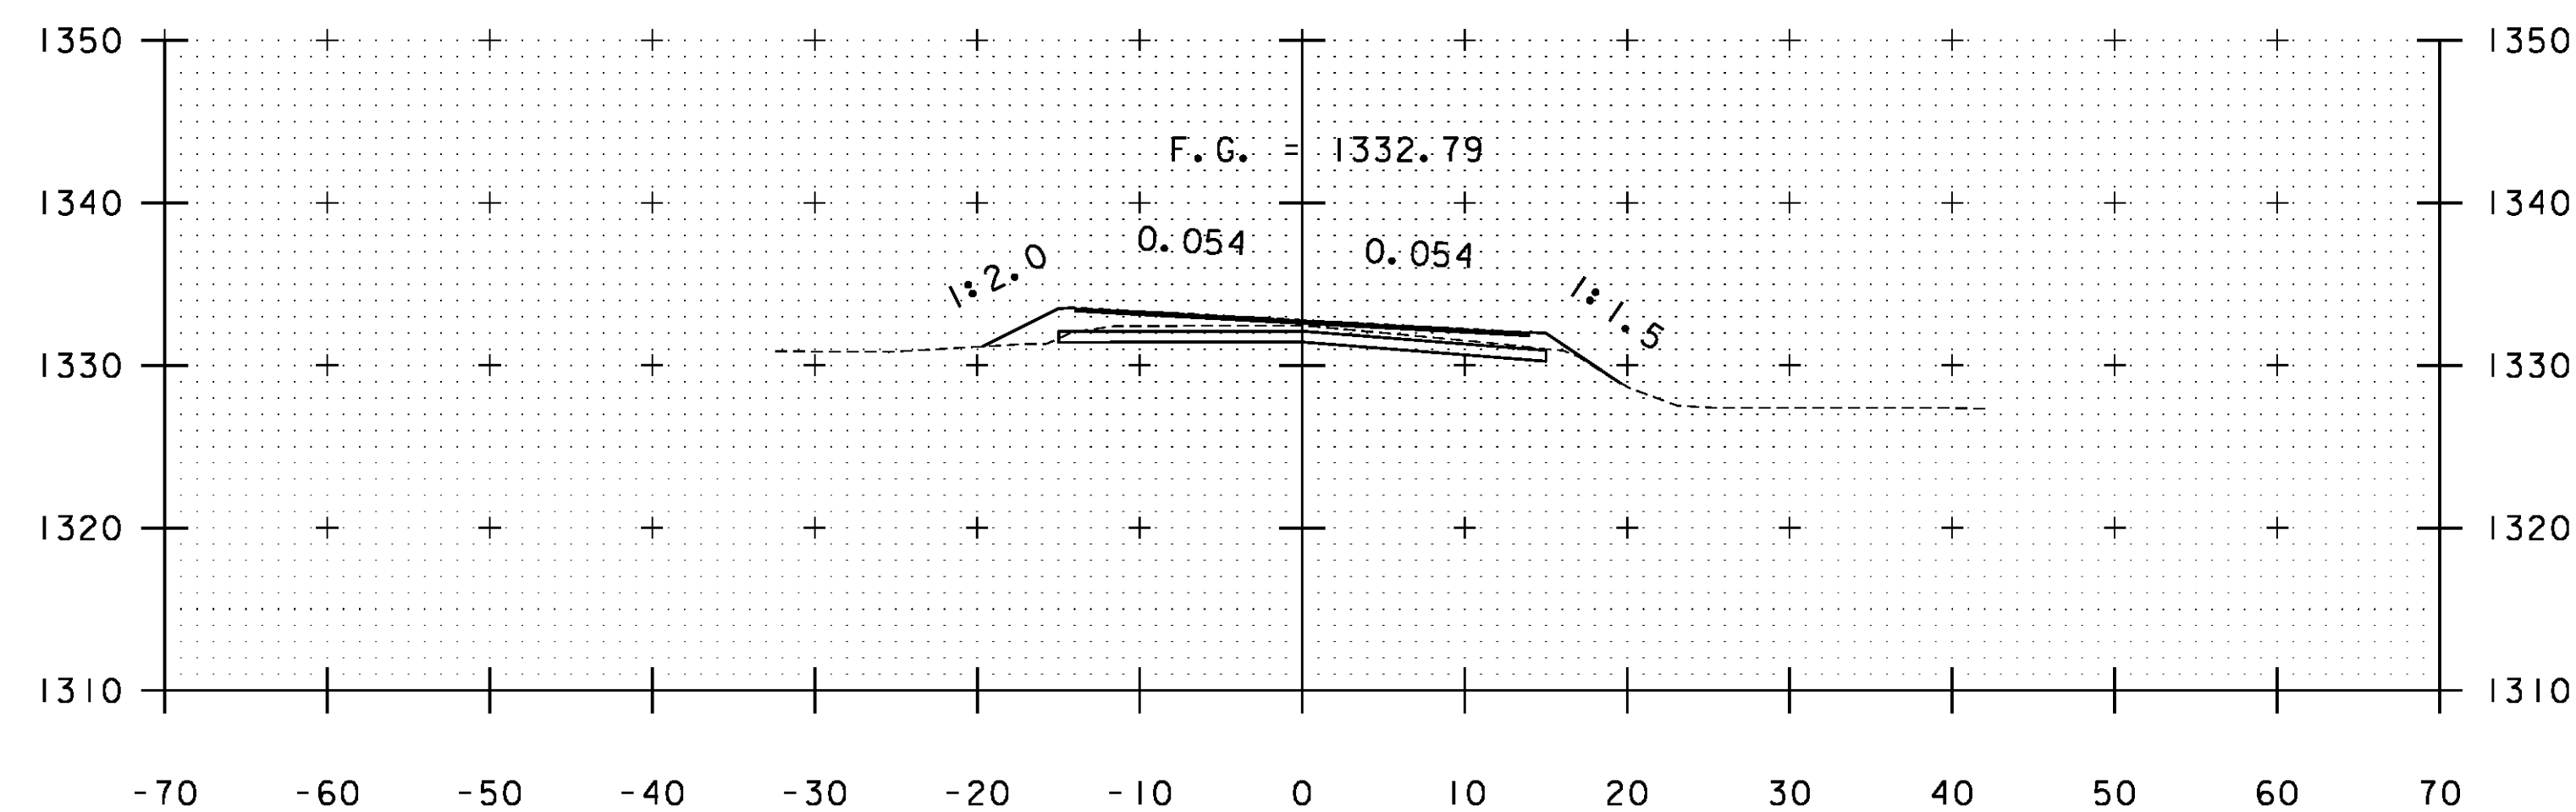

A 159+00

STA. A 157+50 TO STA. A 160+00

PROJECT NAME: WARDBORO-JAMAICA	PLOT DATE: 2/26/2014
PROJECT NUMBER: ER STP 013-1(17)	DRAWN BY: B. KIPP
FILE NAME: xs.dgn	CHECKED BY: HSD
PROJECT LEADER: K. UPMAL	SHEET 235 OF 444
DESIGNED BY: B. KIPP	
CROSS SECTIONS	