




A 170+50

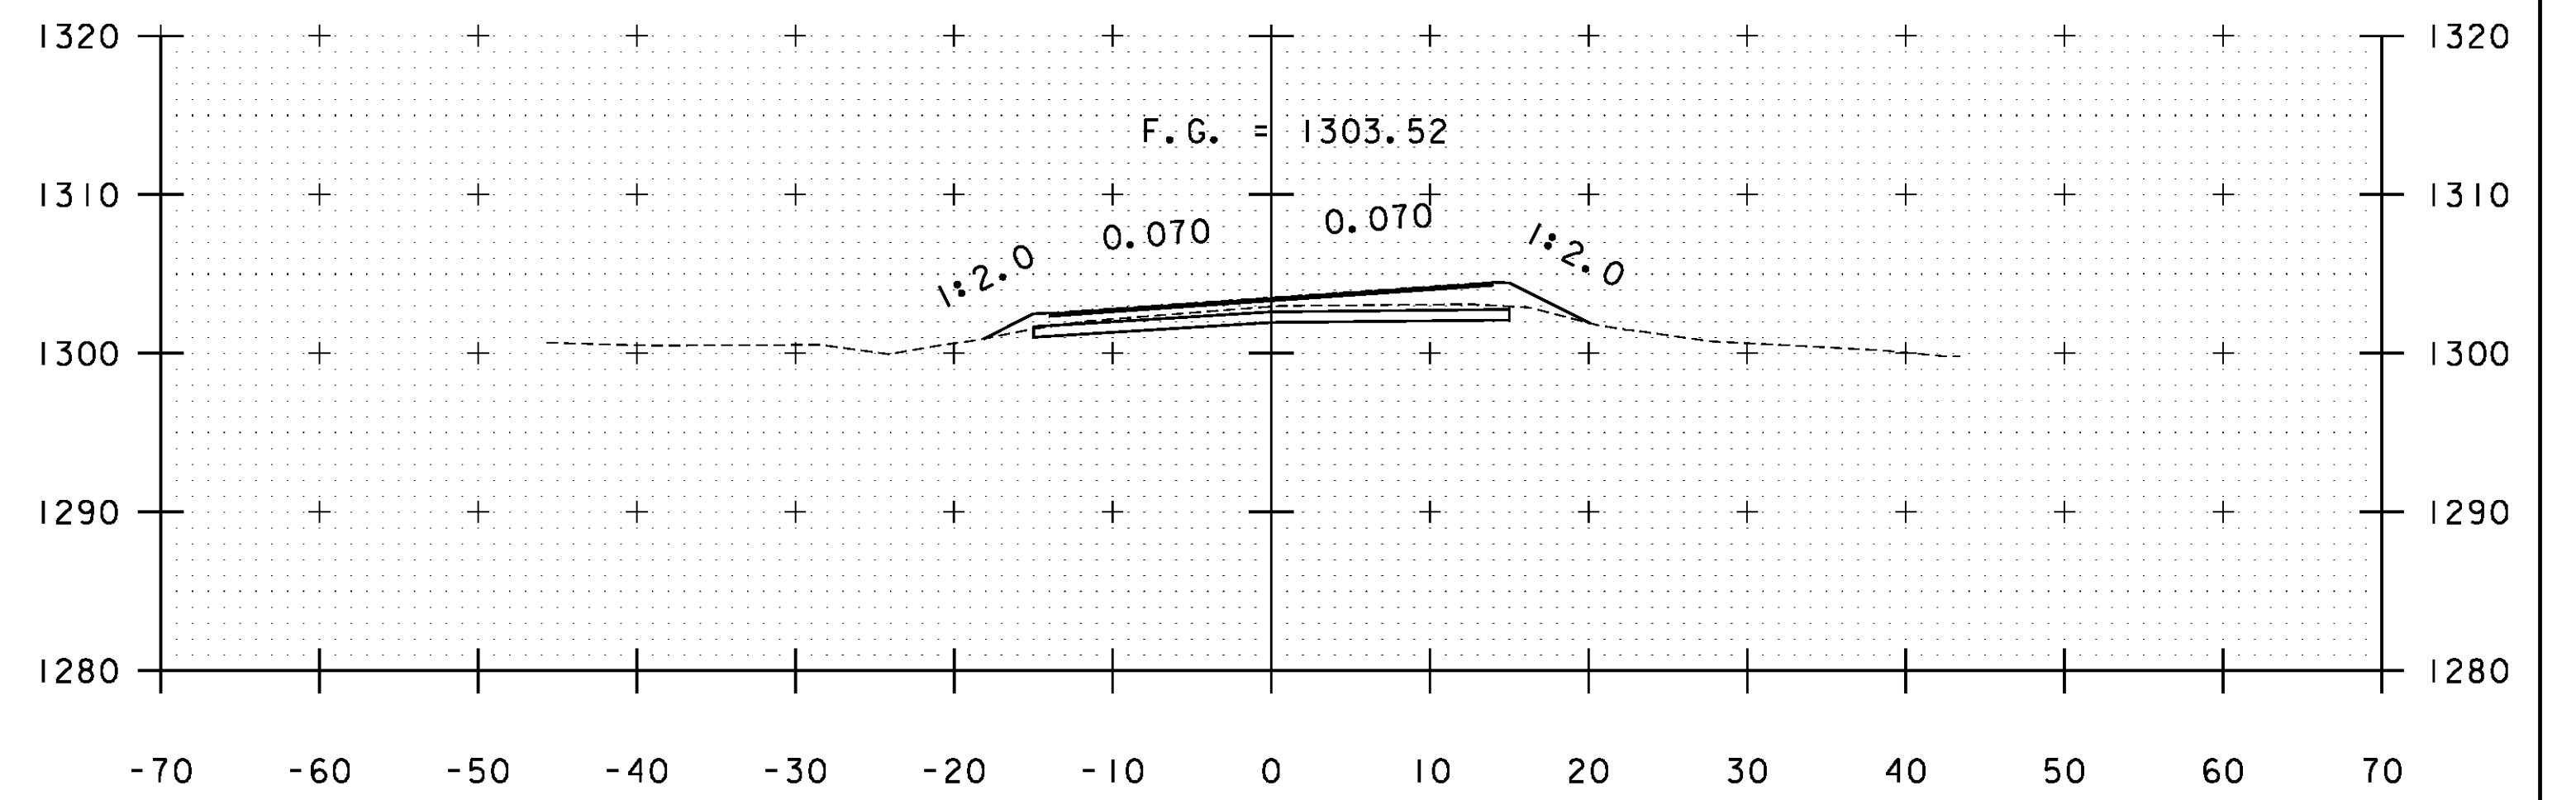


A 171+50

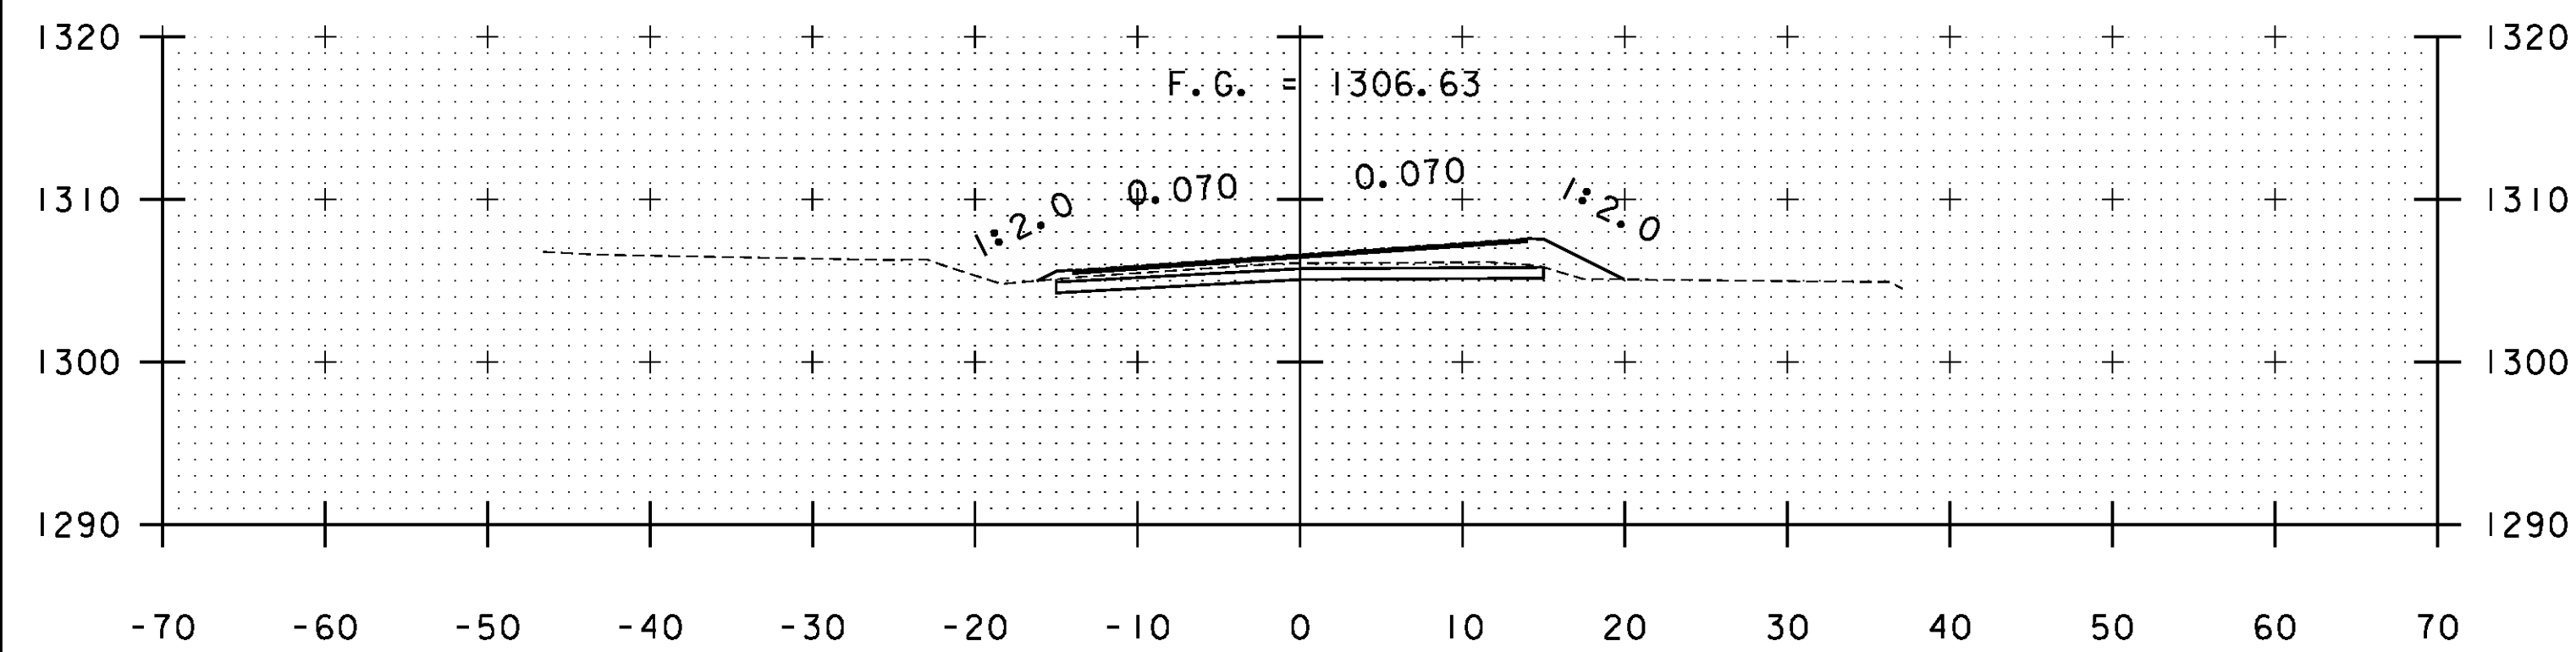

A 170+00

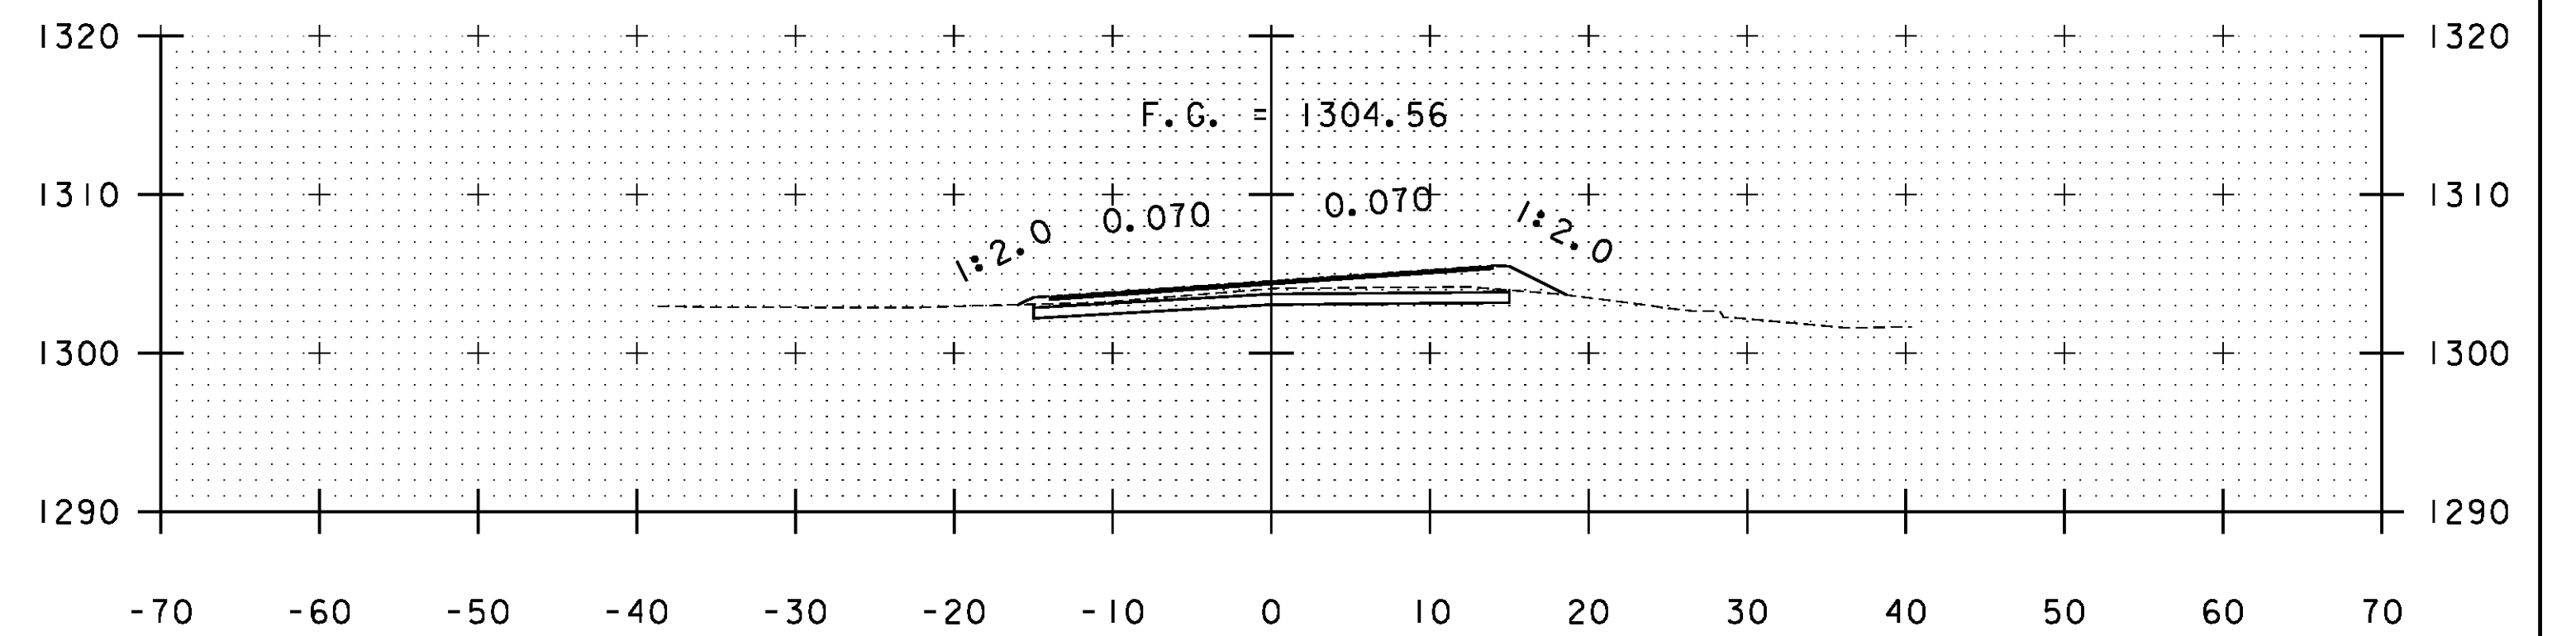

A 171+00

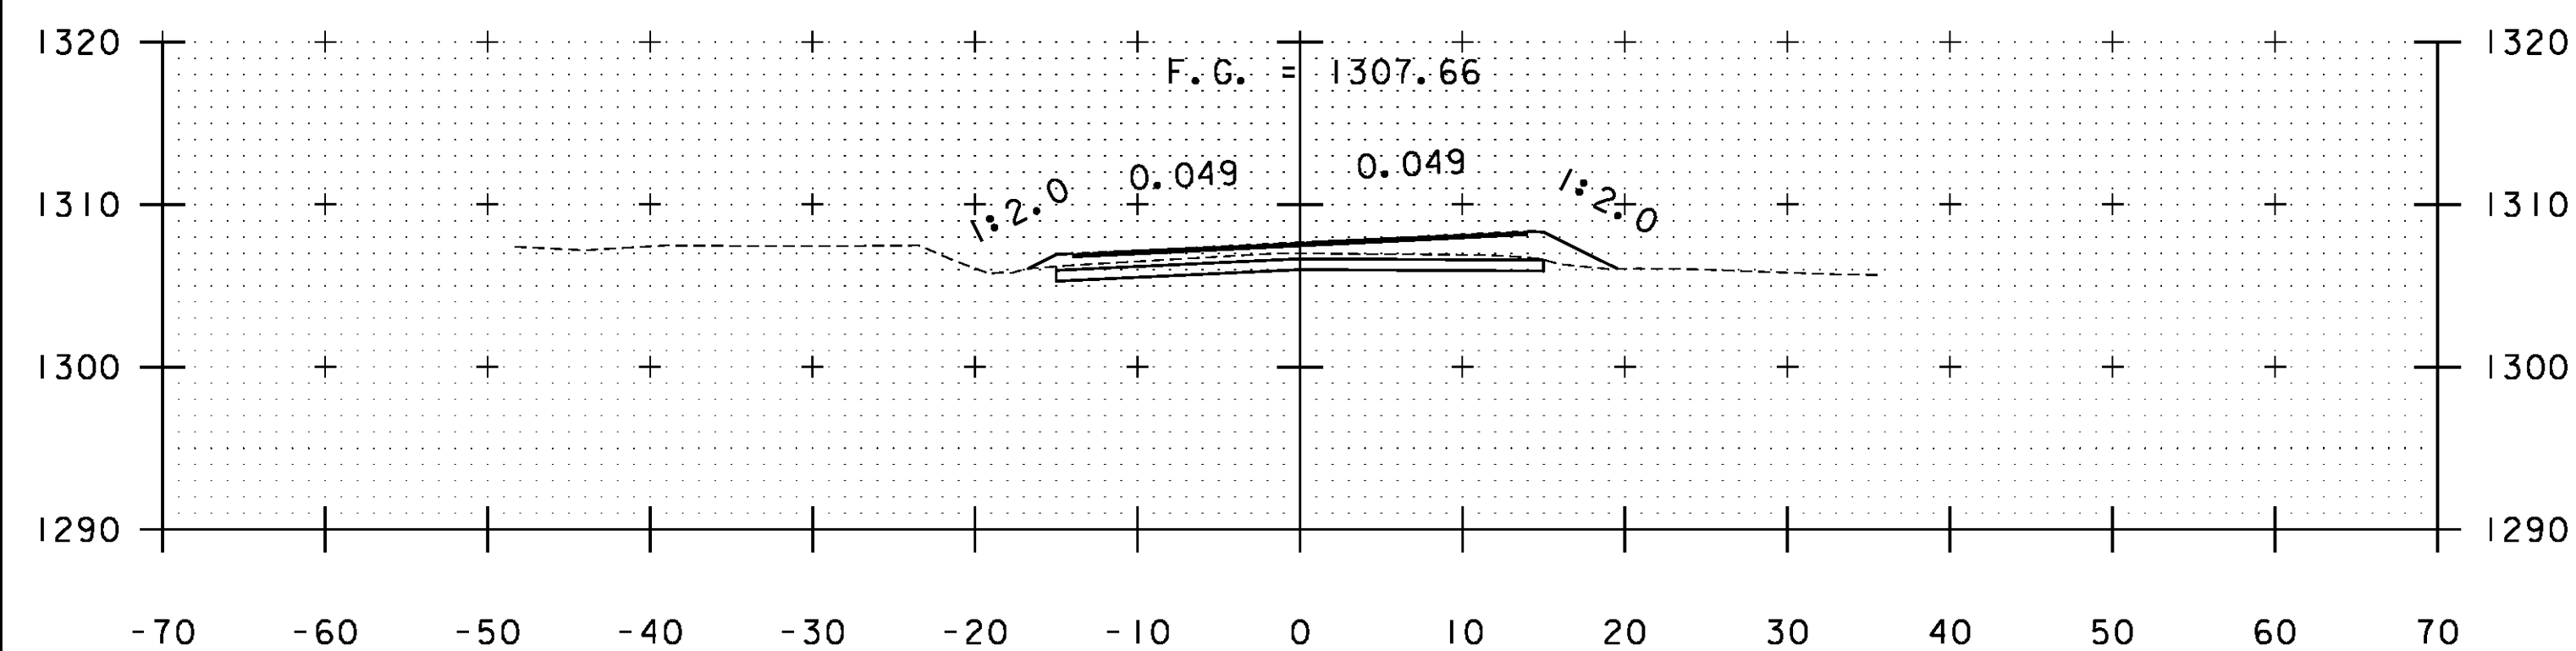

A 169+50

STA. A 169+50 TO STA. A 171+50

PROJECT NAME: WARDBORO-JAMAICA	PLOT DATE: 2/26/2014
PROJECT NUMBER: ER STP 013-1(17)	DRAWN BY: B. KIPP
FILE NAME: xs.dgn	CHECKED BY: HSD
PROJECT LEADER: K. UPMAL	SHEET 239 OF 444
DESIGNED BY: B. KIPP	
CROSS SECTIONS	