




A 173+00

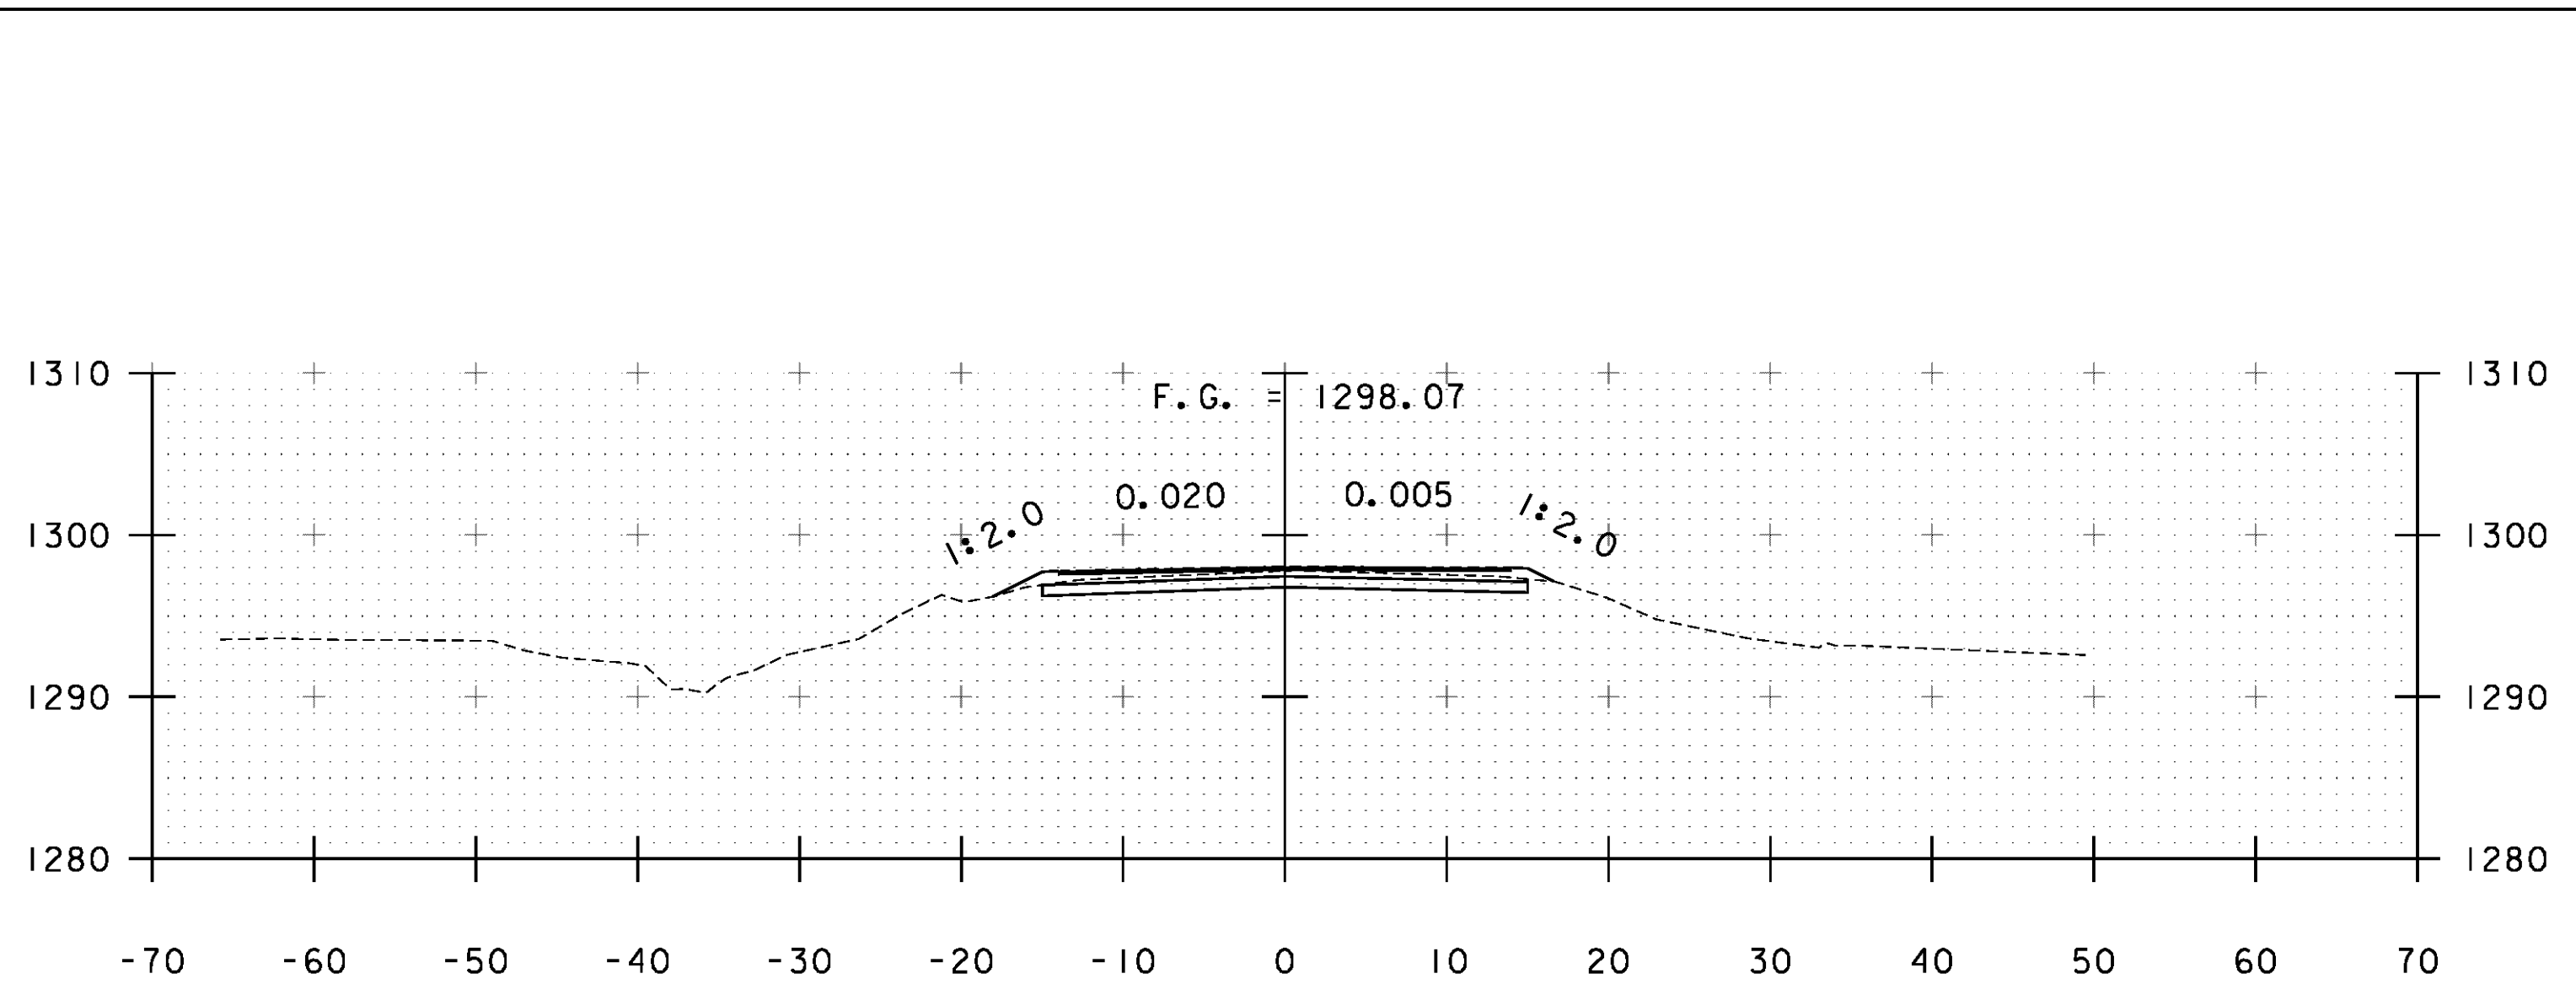


A 174+50
BEGIN BF 013-1 (21)

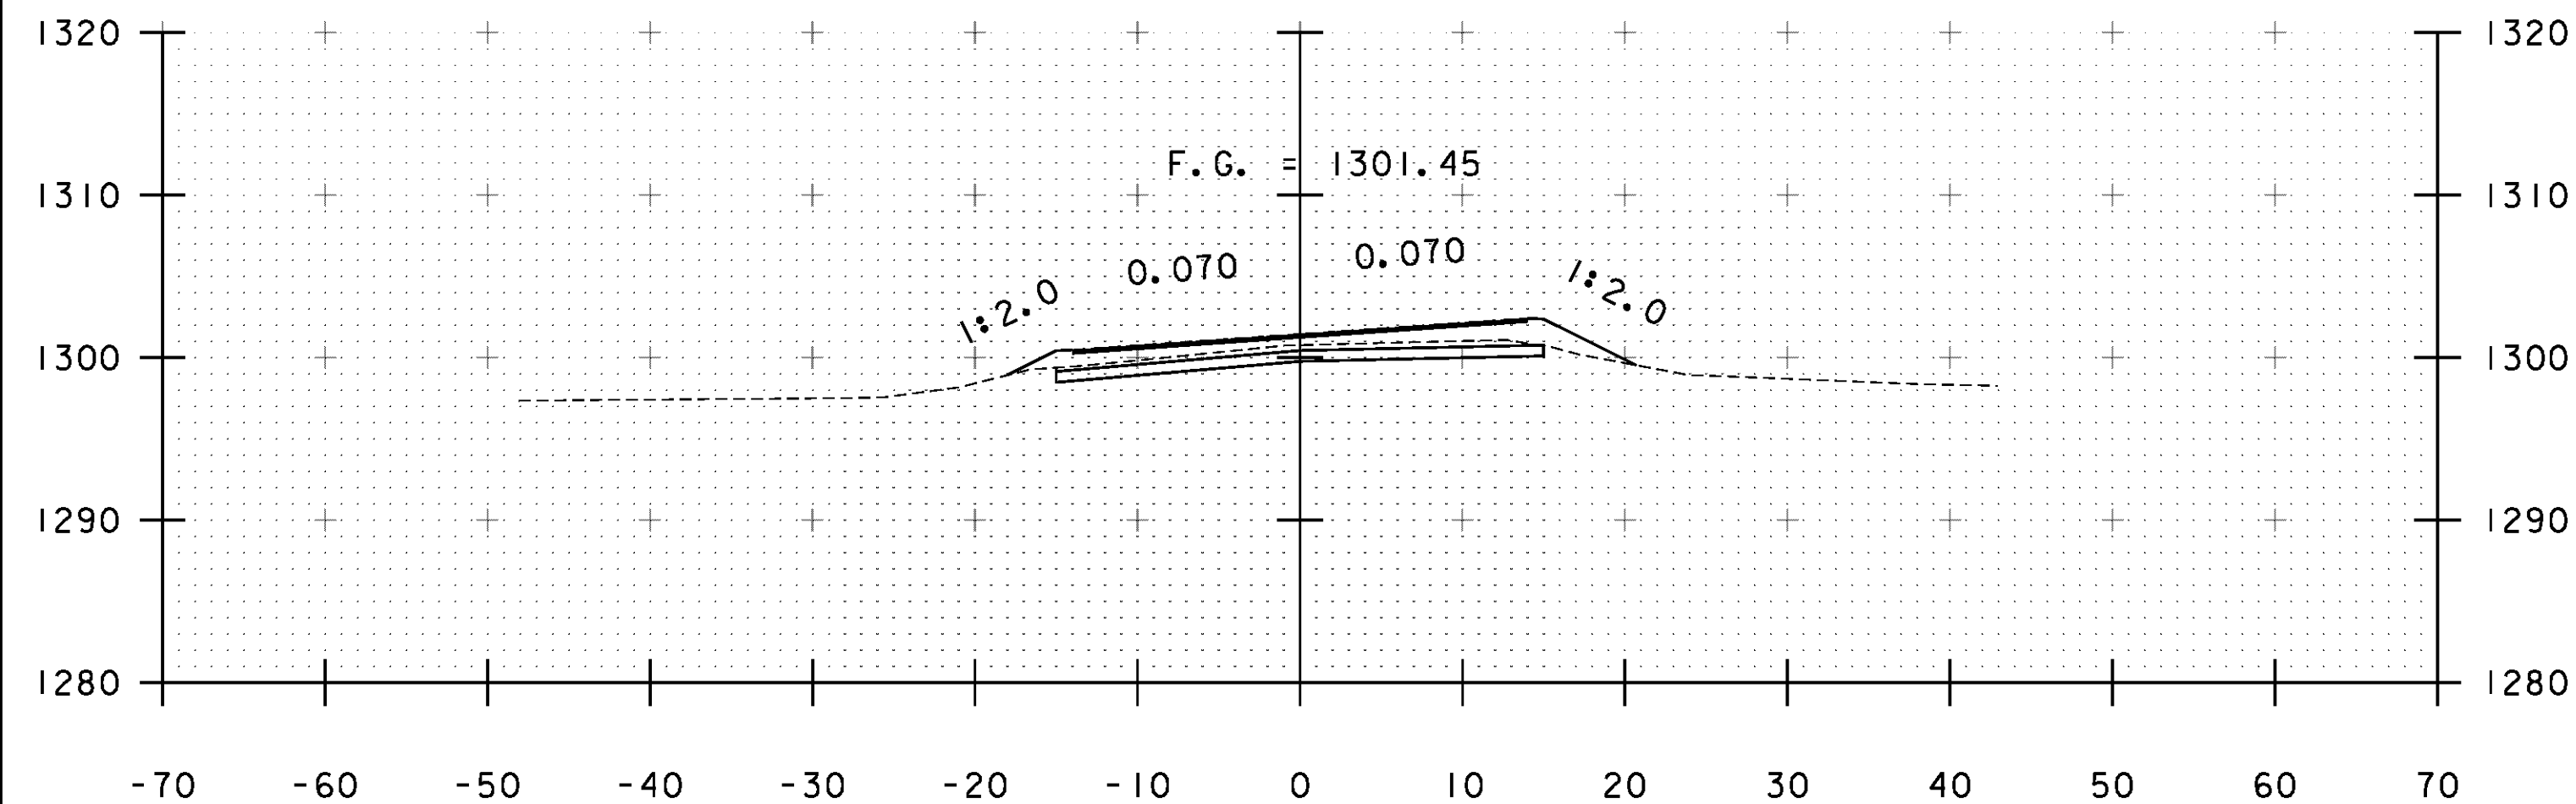


A 172+50

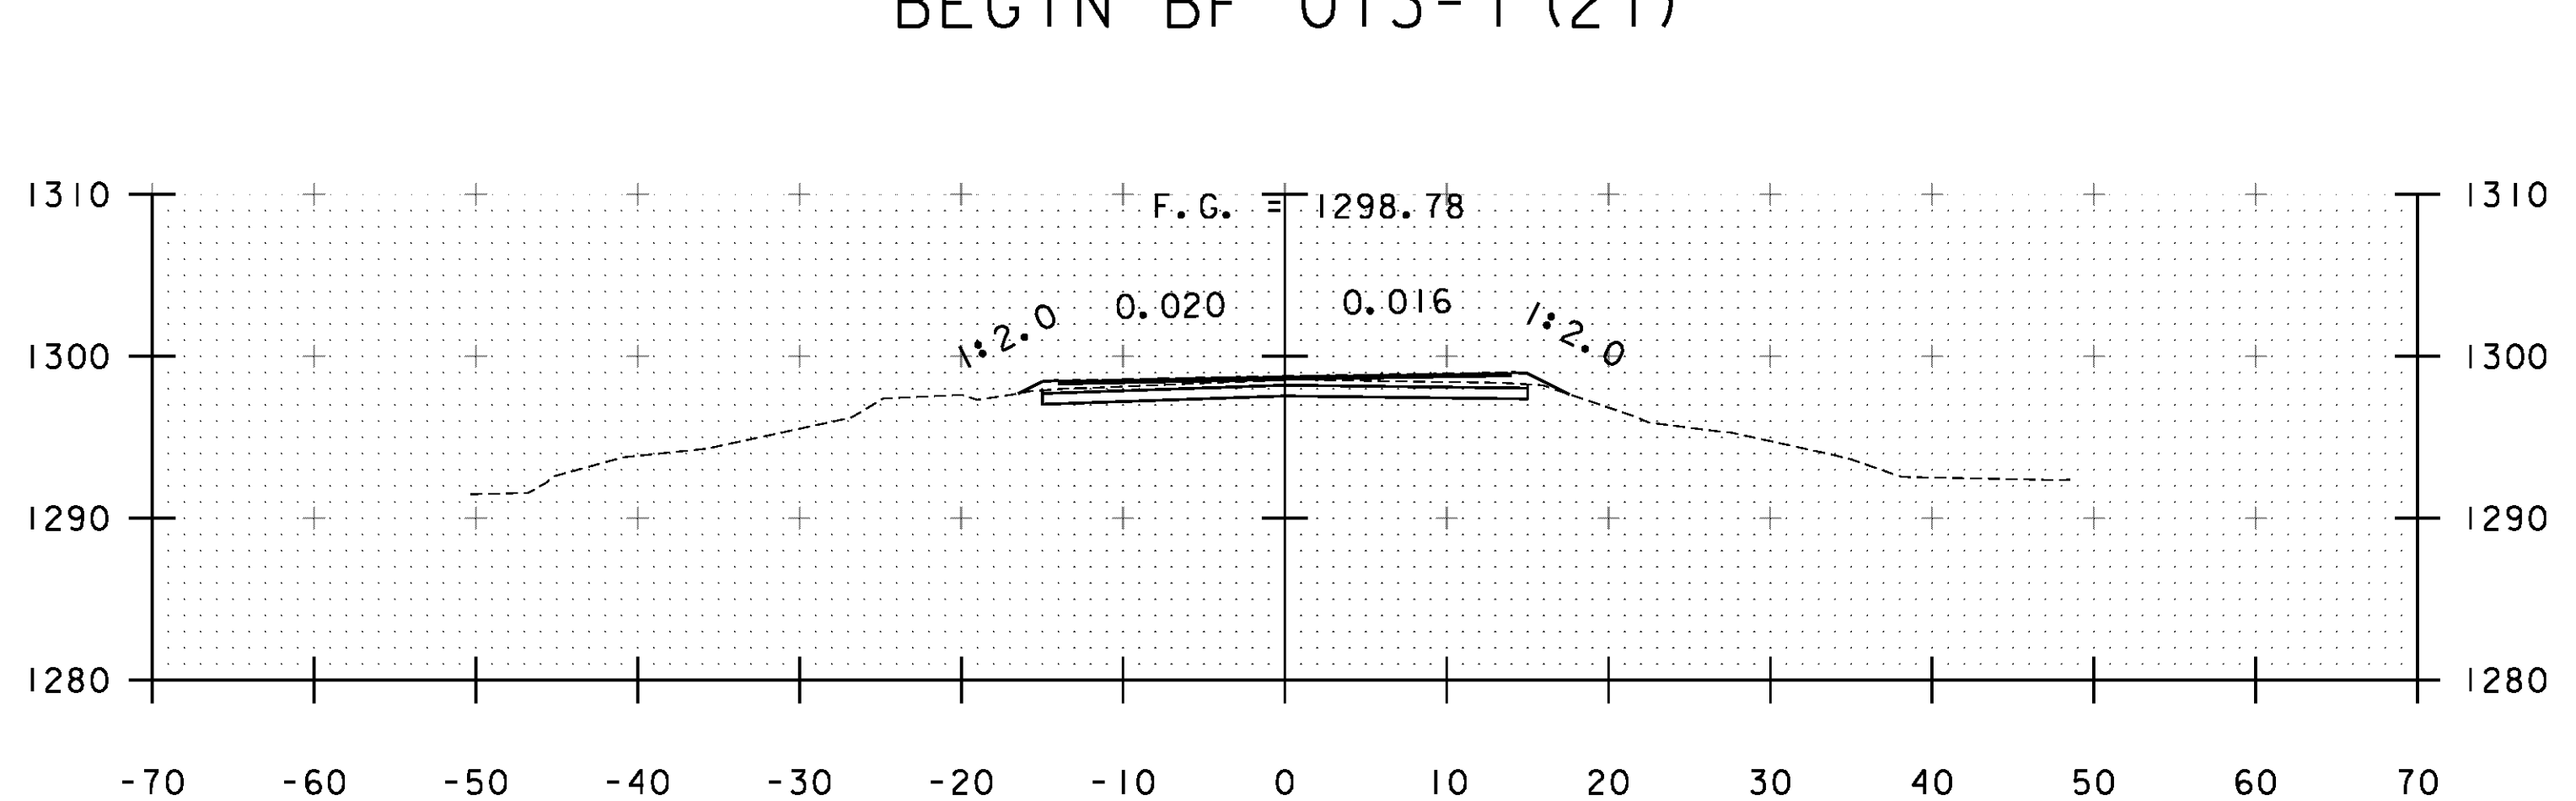

A 174+00

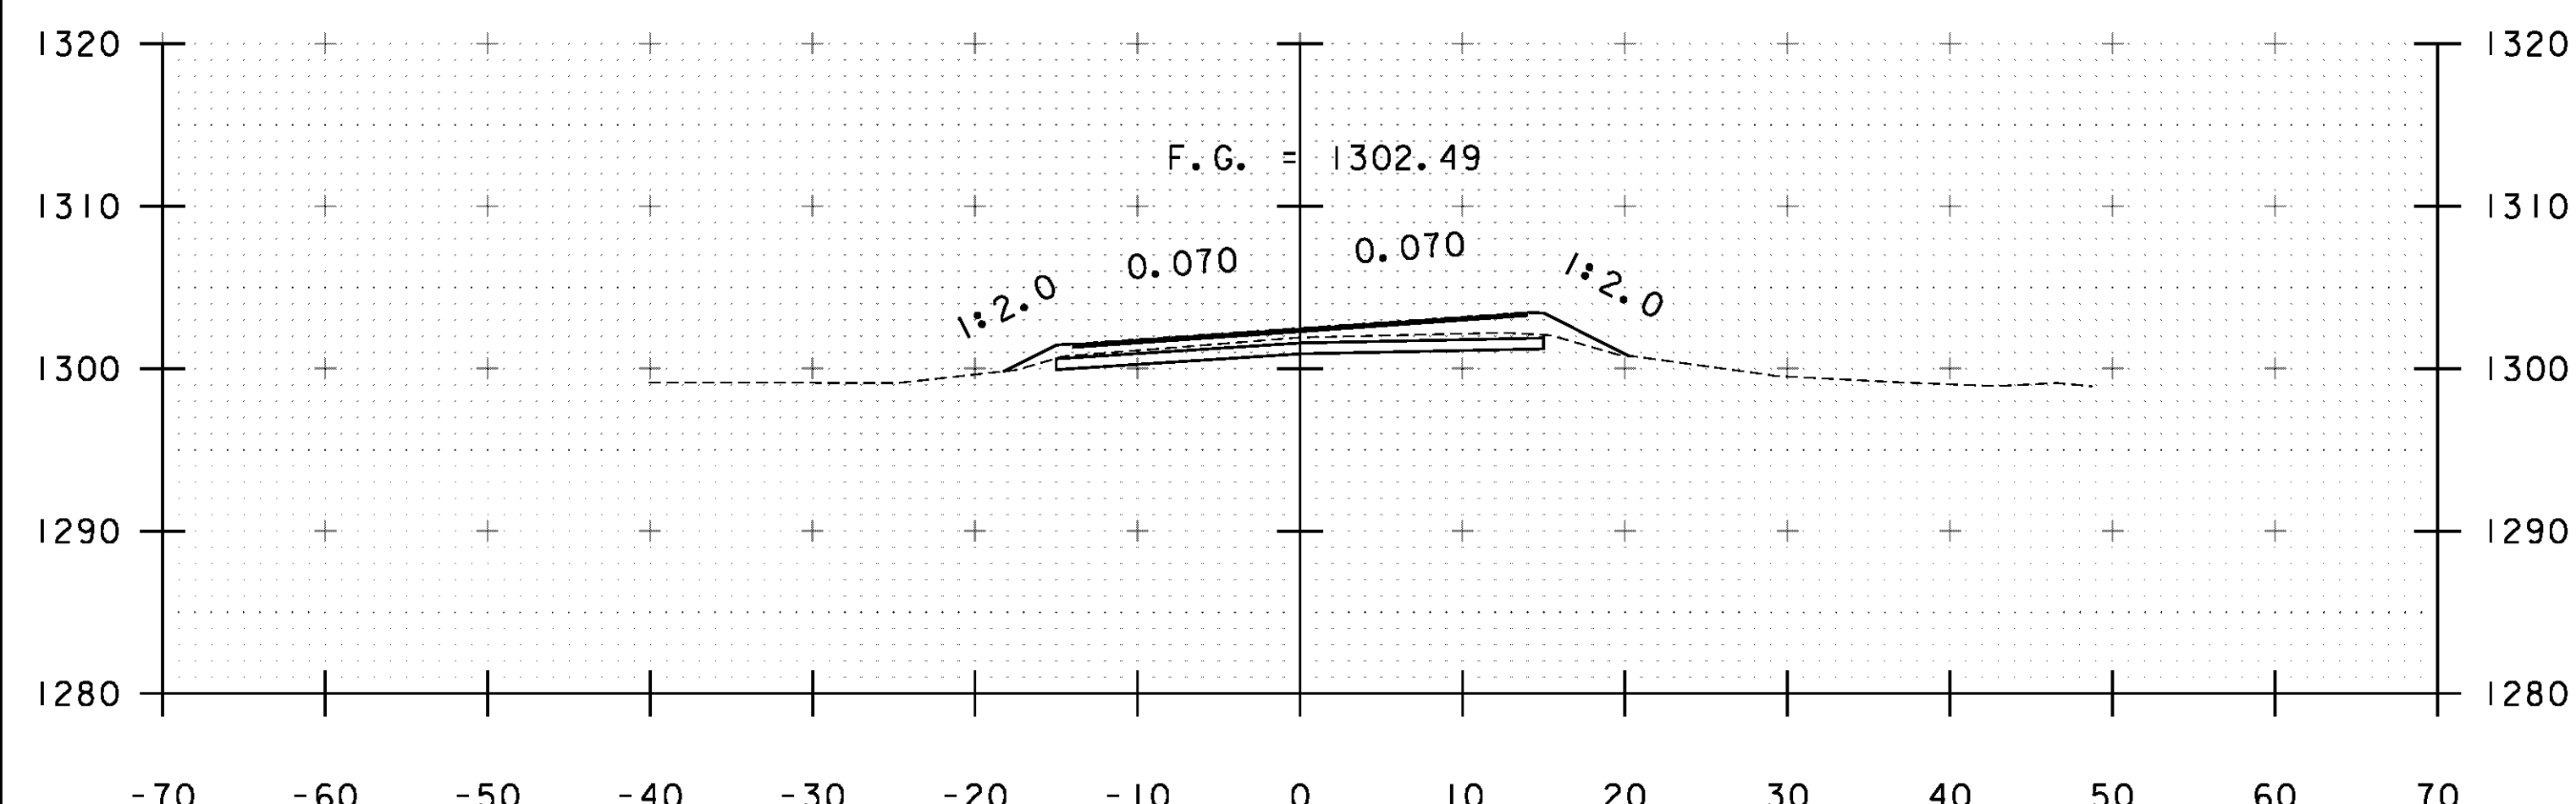

A 172+00

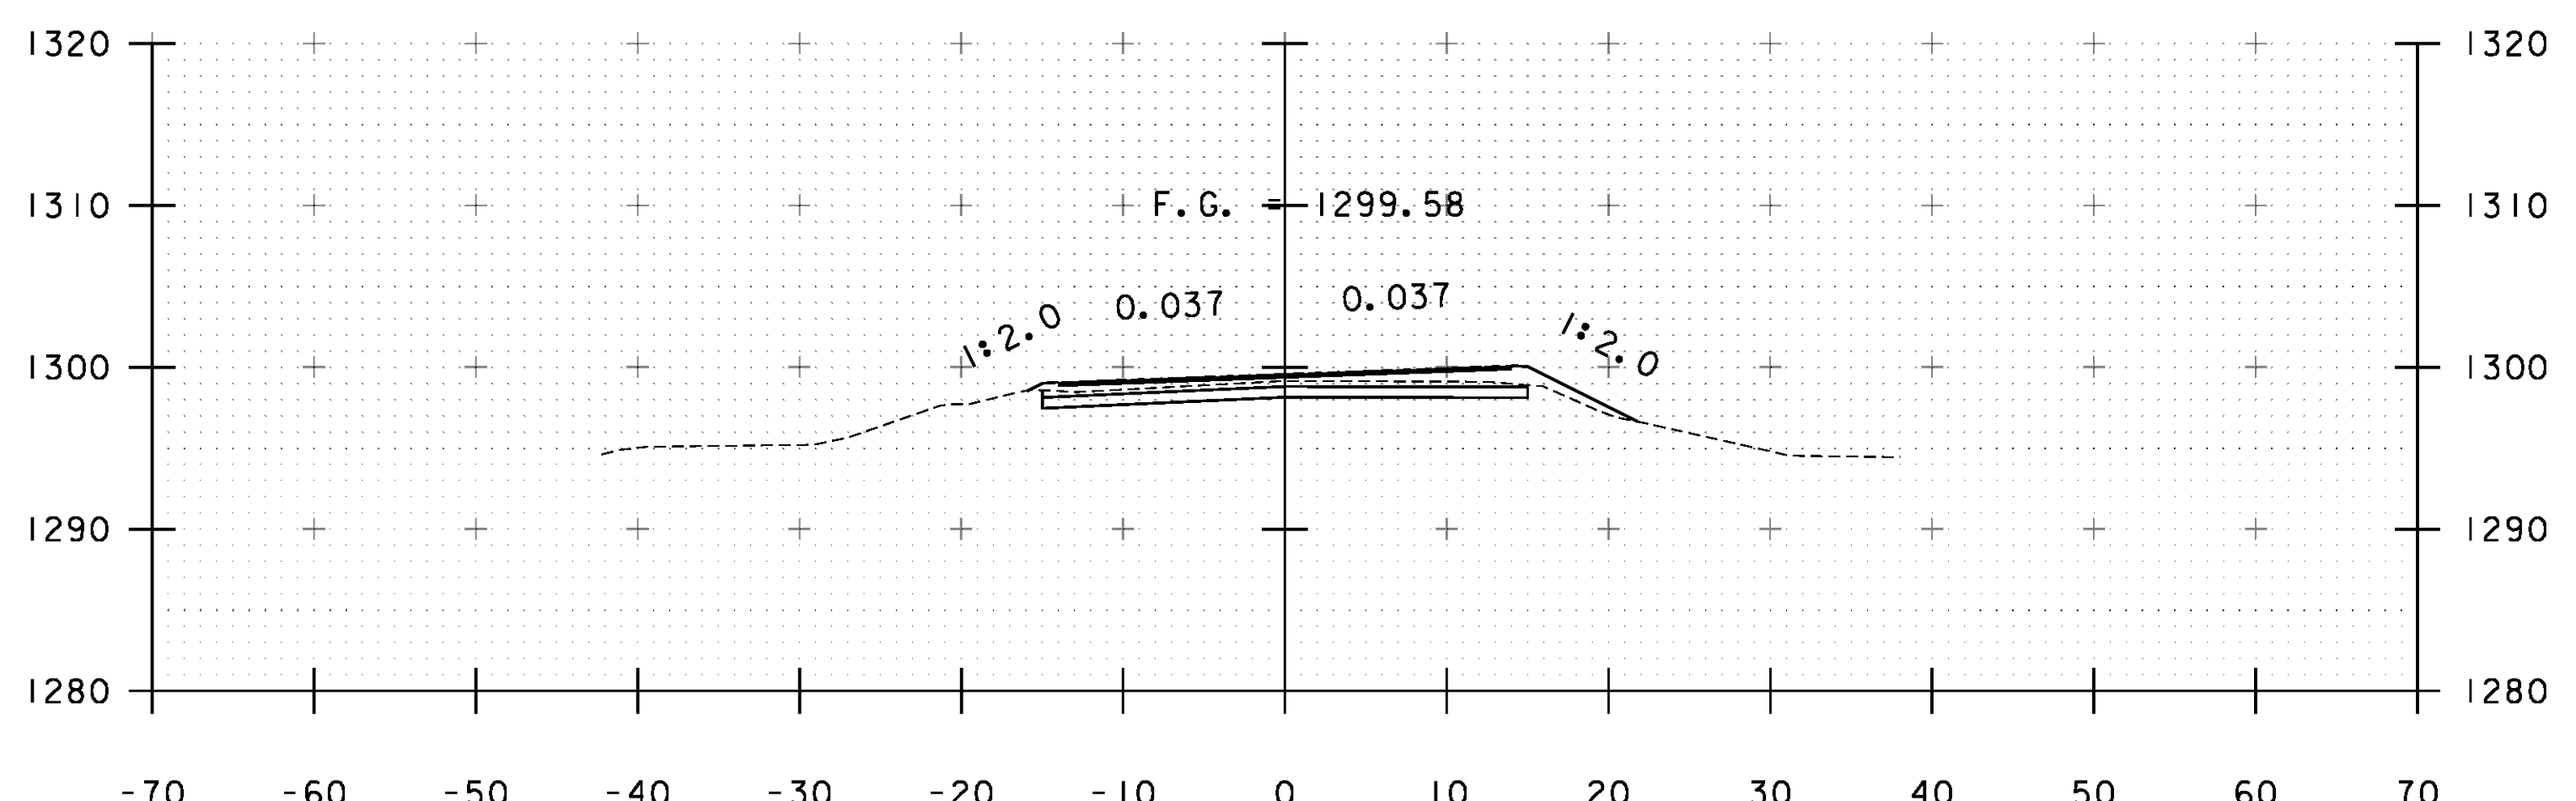

A 173+50

STA. A 172+00 TO STA. A 174+50

| | |
|----------------------------------|----------------------|
| PROJECT NAME: WARDBORO-JAMAICA | |
| PROJECT NUMBER: ER STP 013-1(17) | |
| FILE NAME: xs_C70.dgn | PLOT DATE: 2/26/2014 |
| PROJECT LEADER: K. UPMAL | DRAWN BY: B. KIPP |
| DESIGNED BY: B. KIPP | CHECKED BY: HSD |
| CROSS SECTIONS | SHEET 240 OF 444 |