




A 176+00

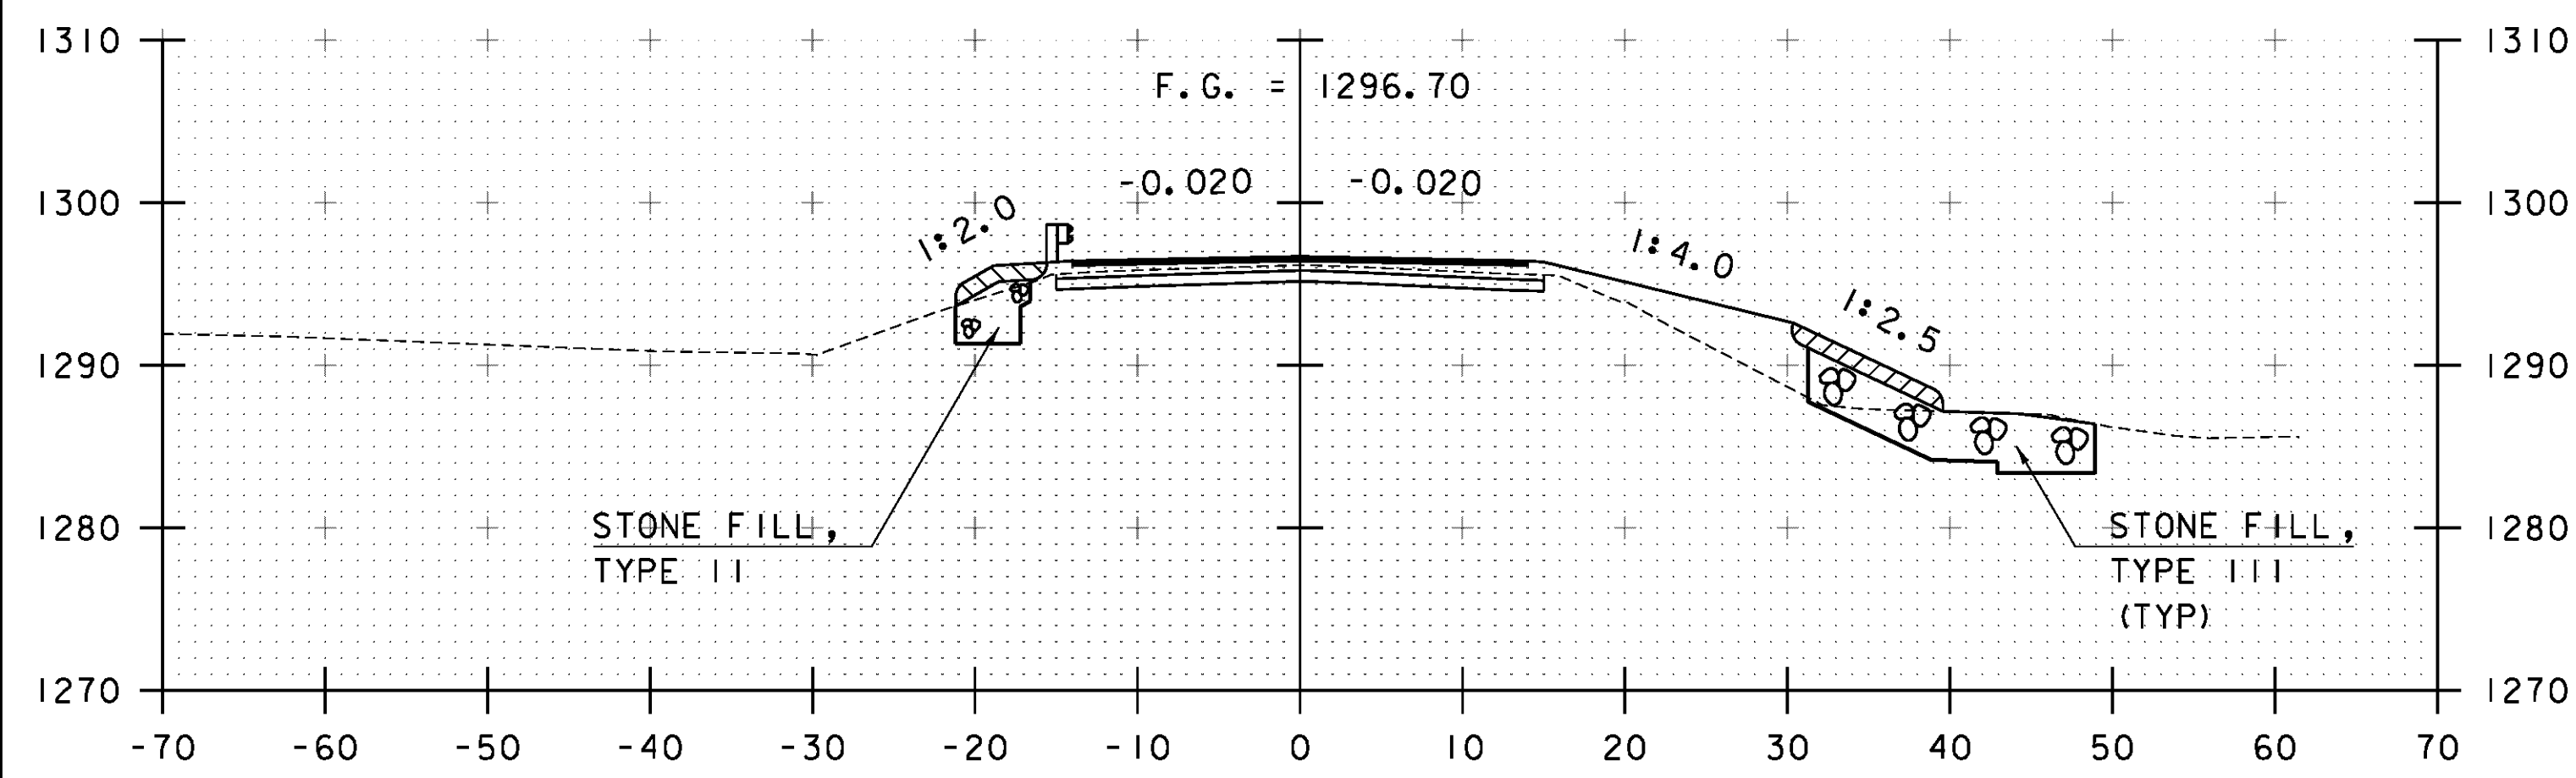


A 175+75

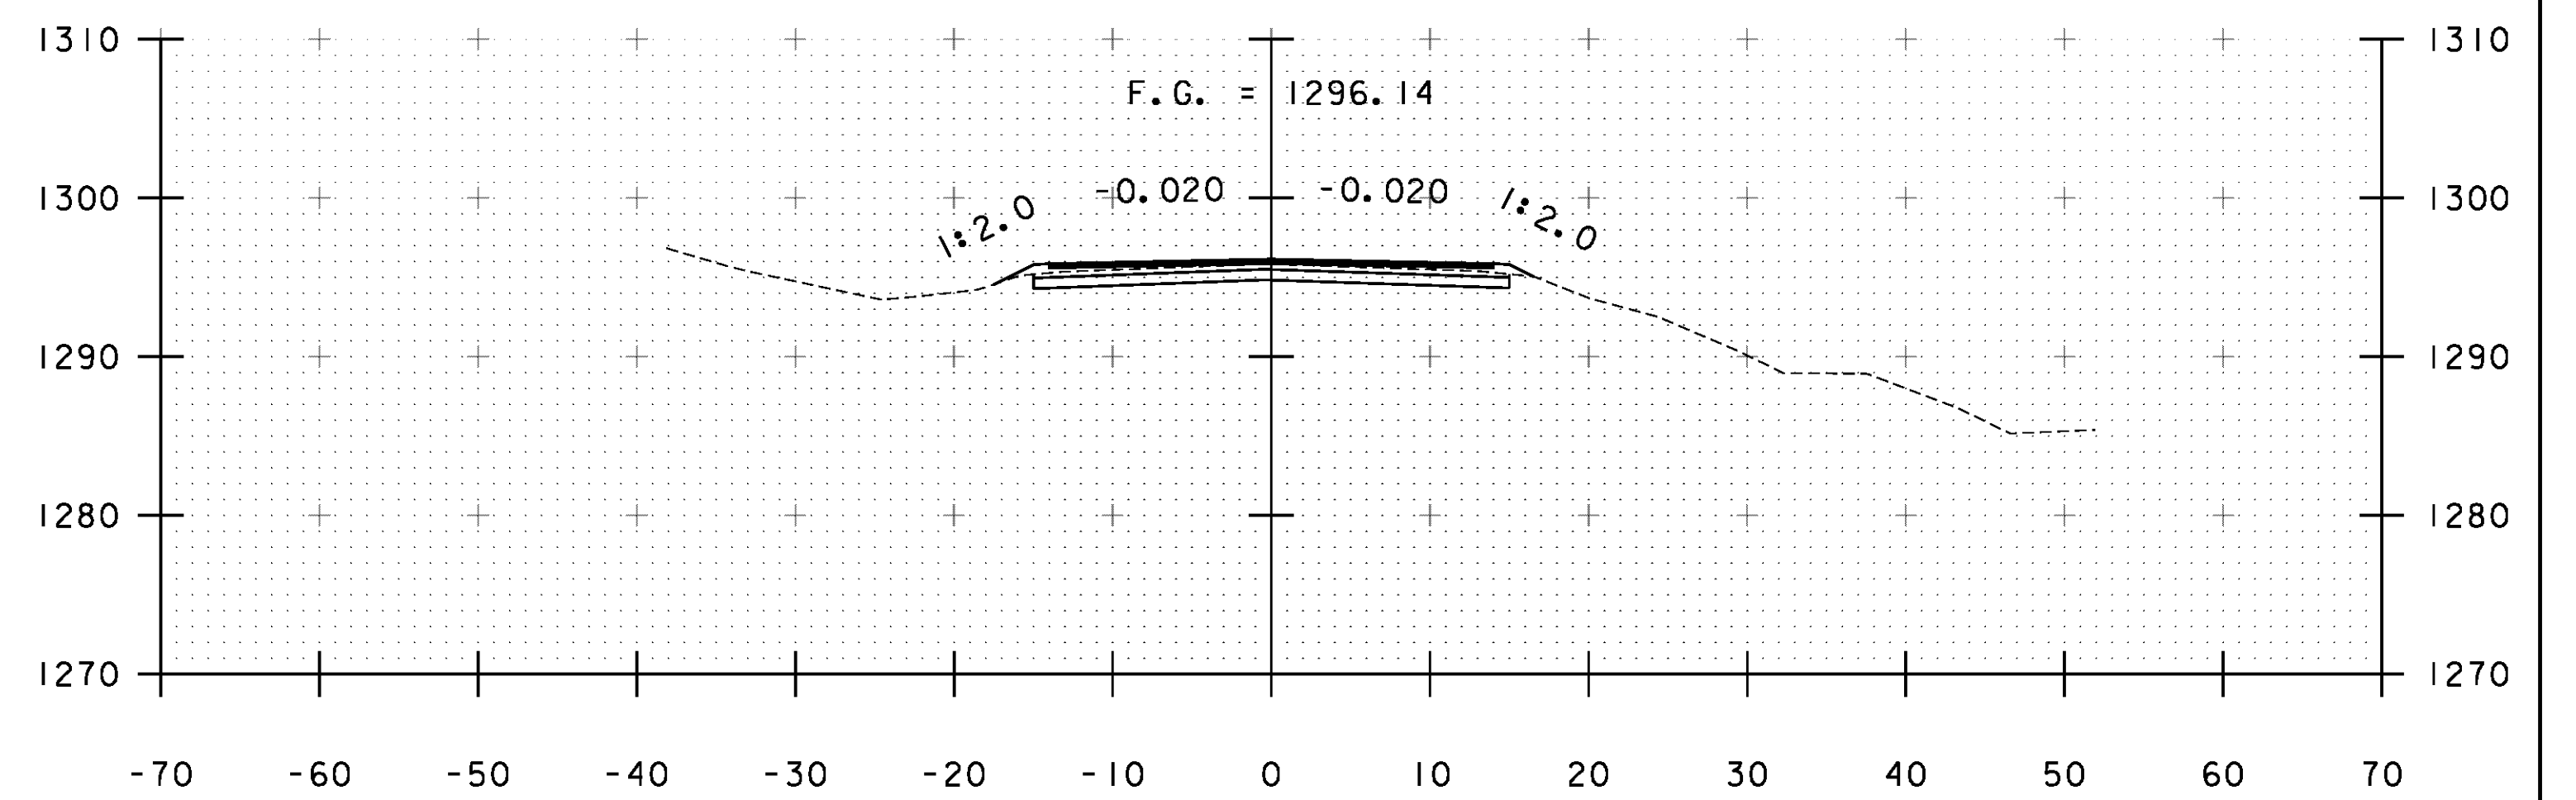

A 176+50

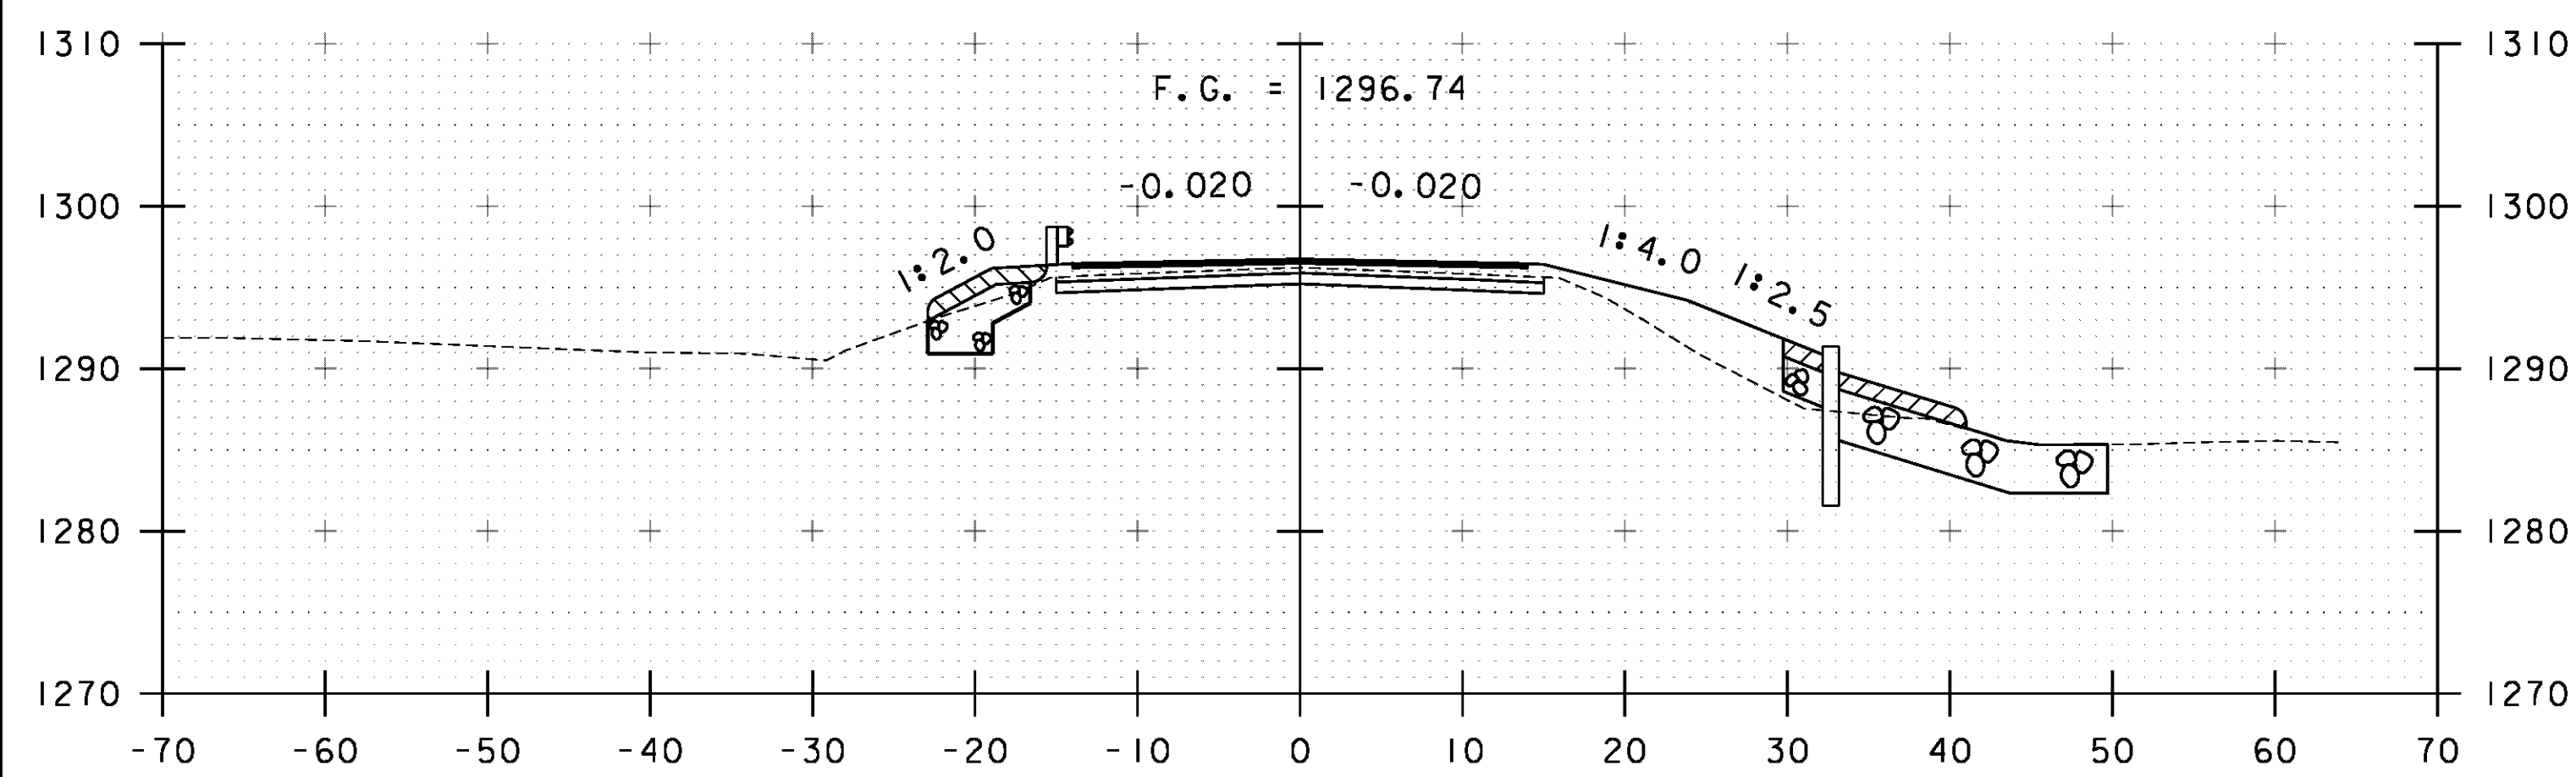

A 175+70

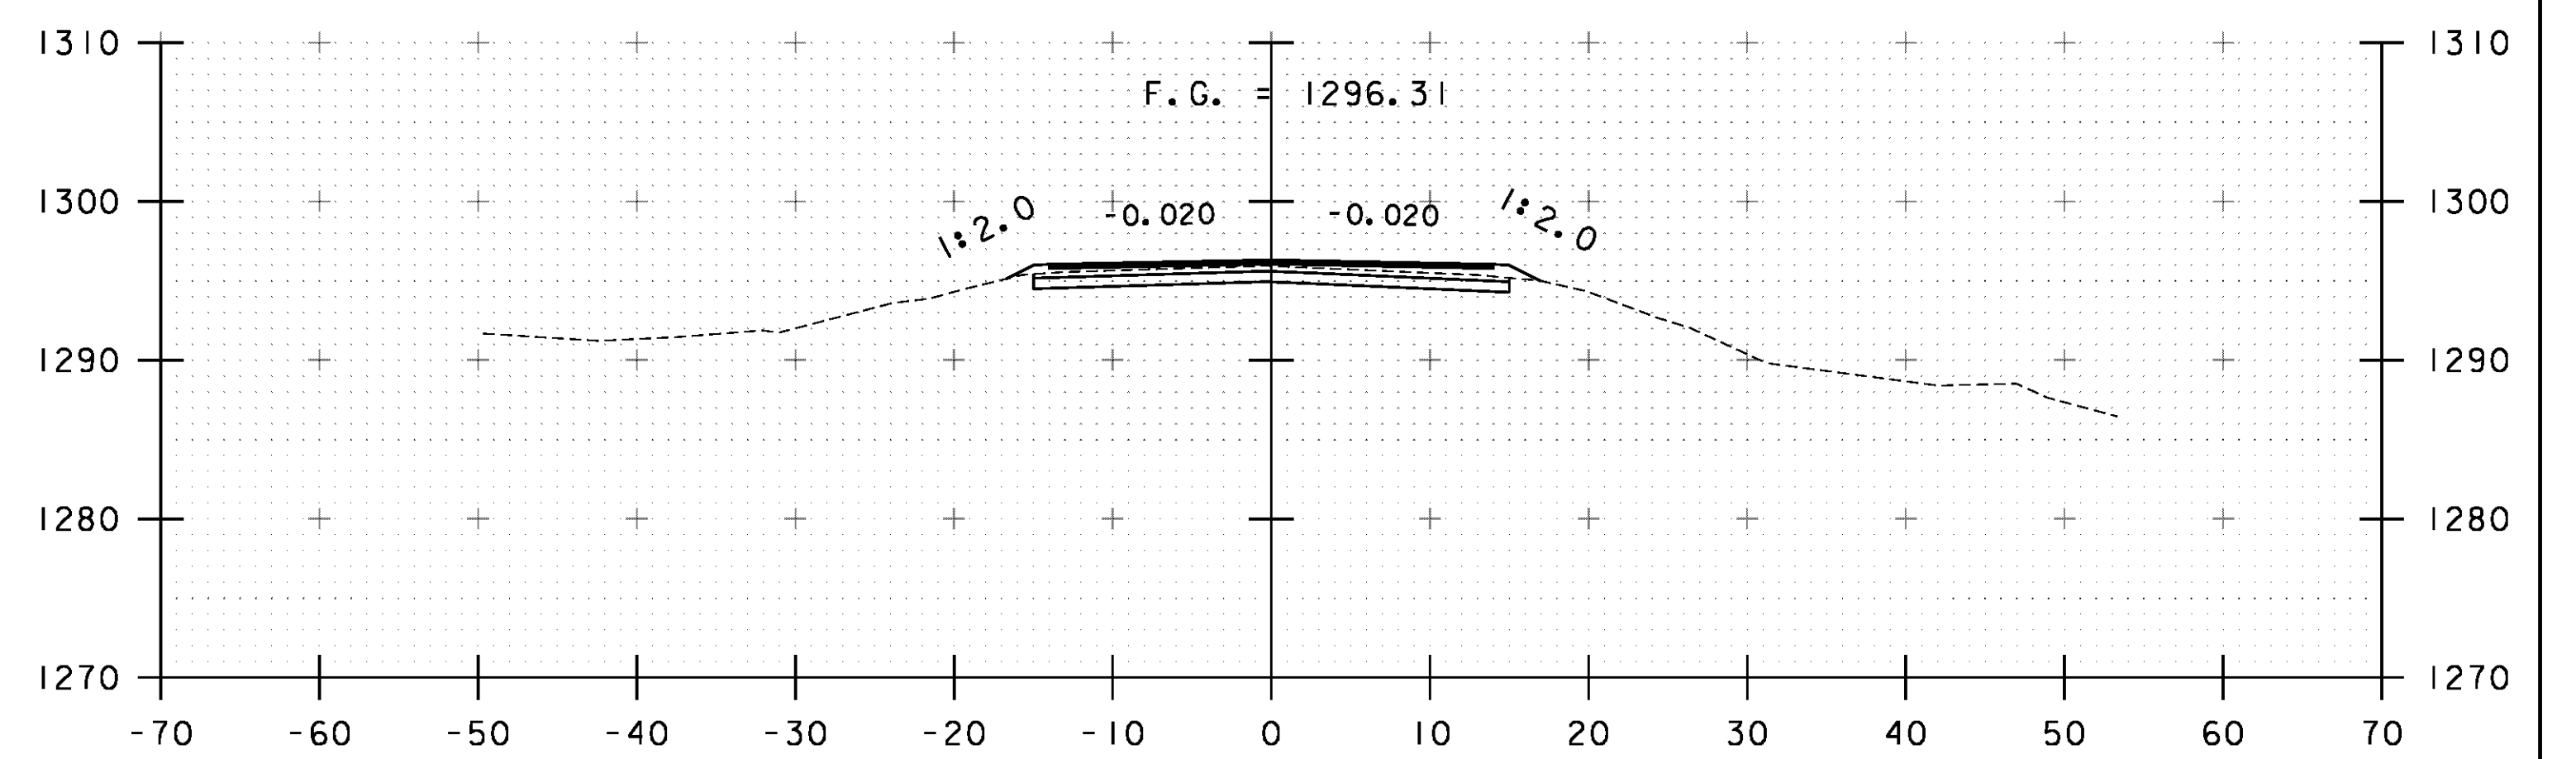

A 176+25
END BF 013-1 (21)

STA. A 175+70 TO STA. A 176+50

PROJECT NAME: WARDBORO-JAMAICA	
PROJECT NUMBER: ER STP 013-1(17)	
FILE NAME: xs_C70.dgn	PLOT DATE: 2/26/2014
PROJECT LEADER: K. UPMAL	DRAWN BY: B. KIPP
DESIGNED BY: B. KIPP	CHECKED BY: HSD
CROSS SECTIONS	SHEET 242 OF 444