




A 183+50

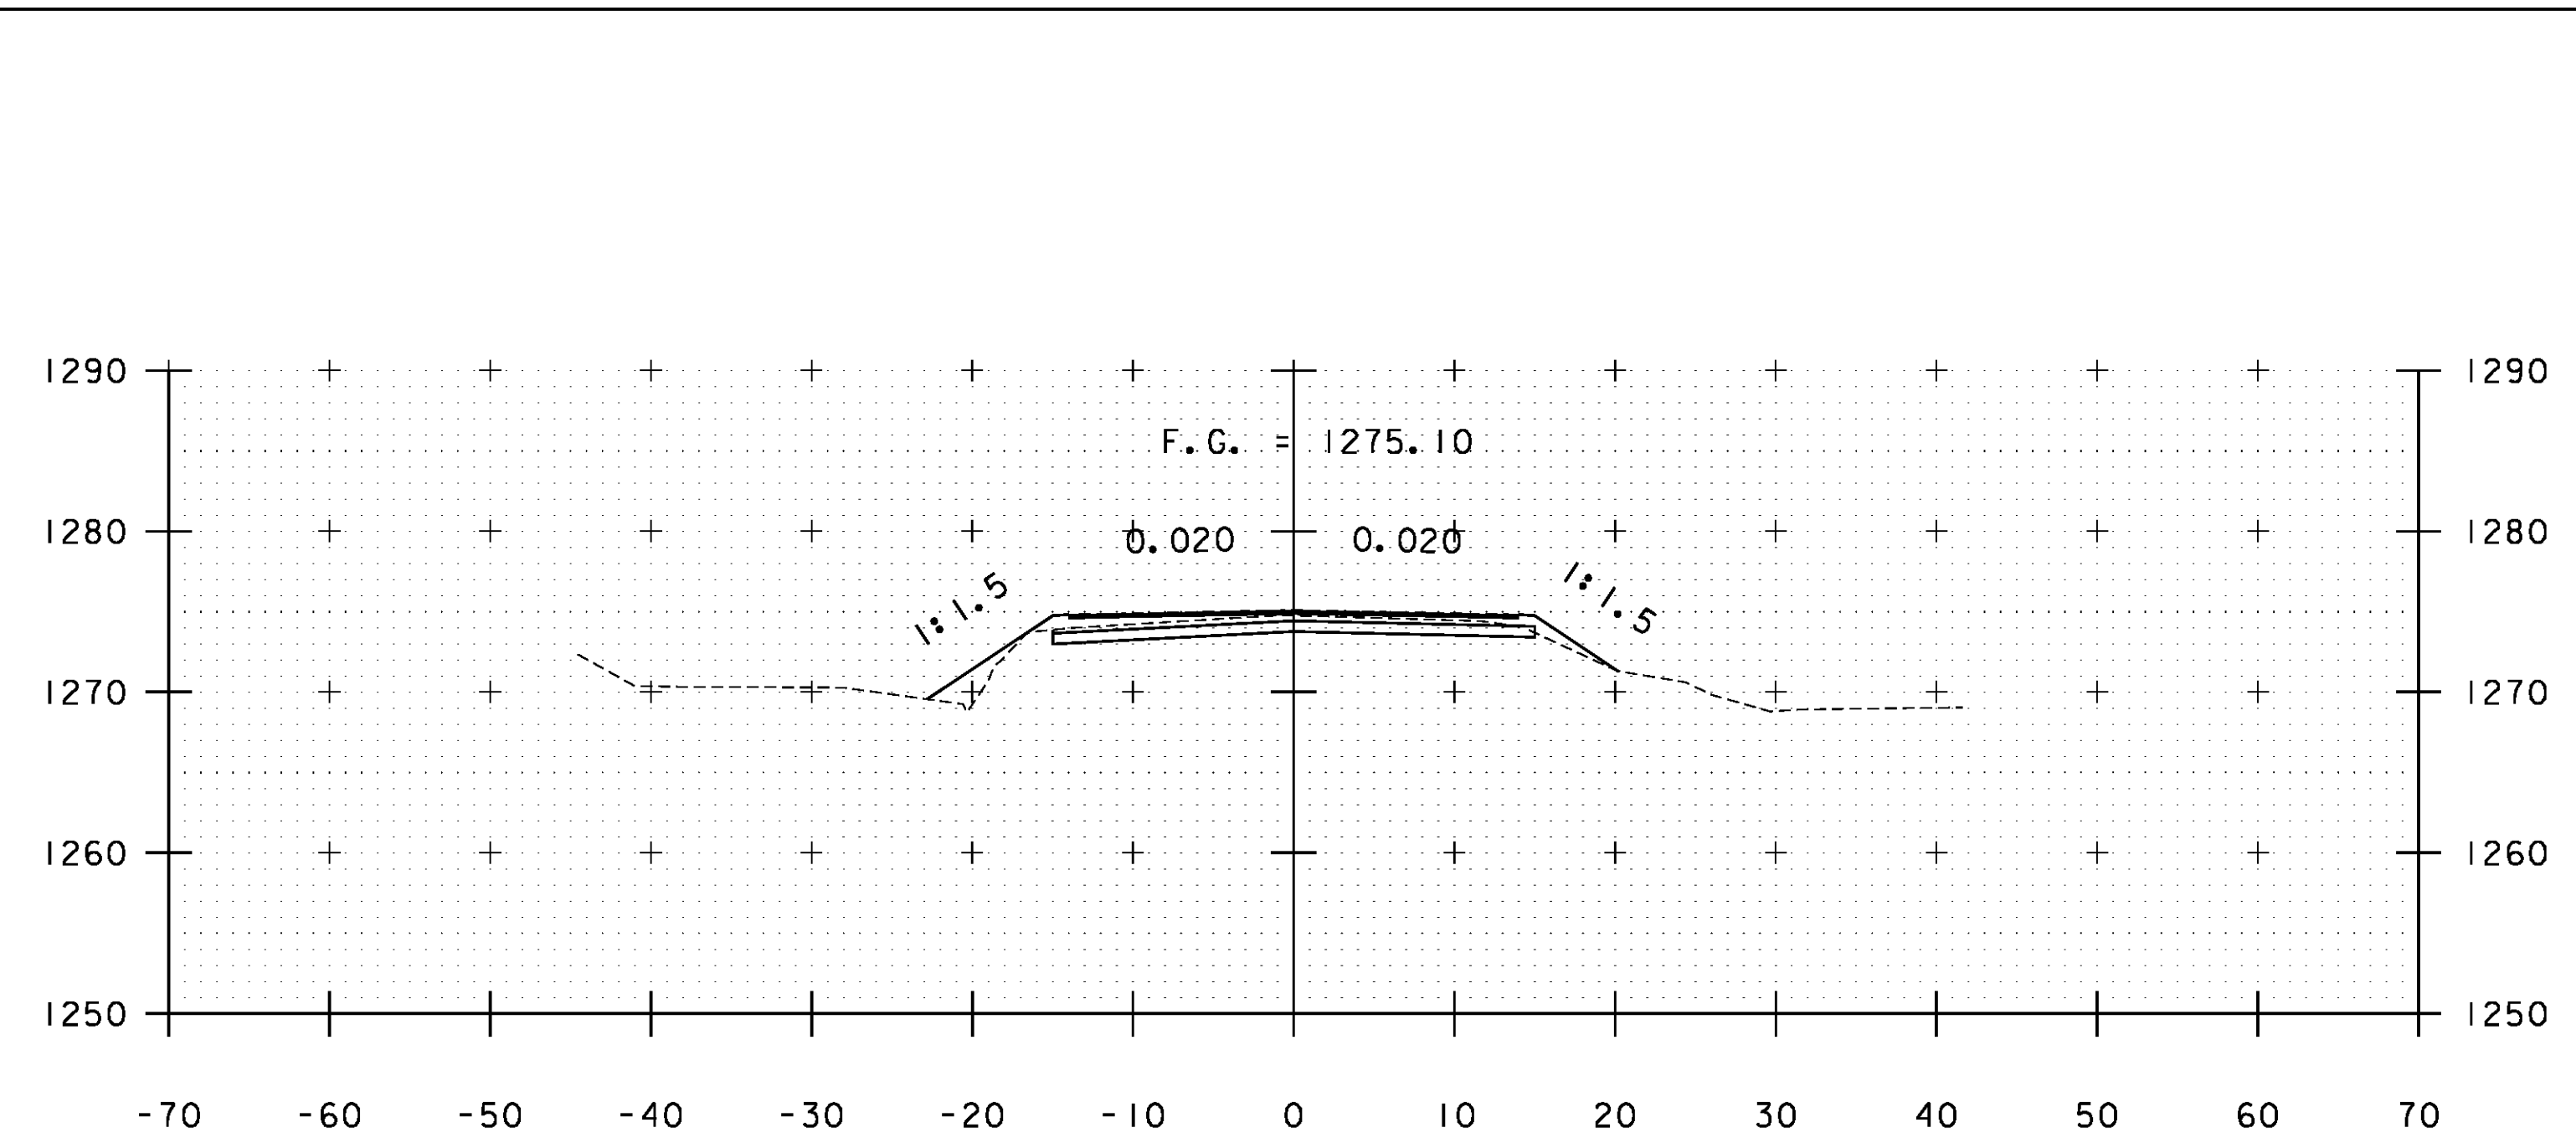


A 185+00

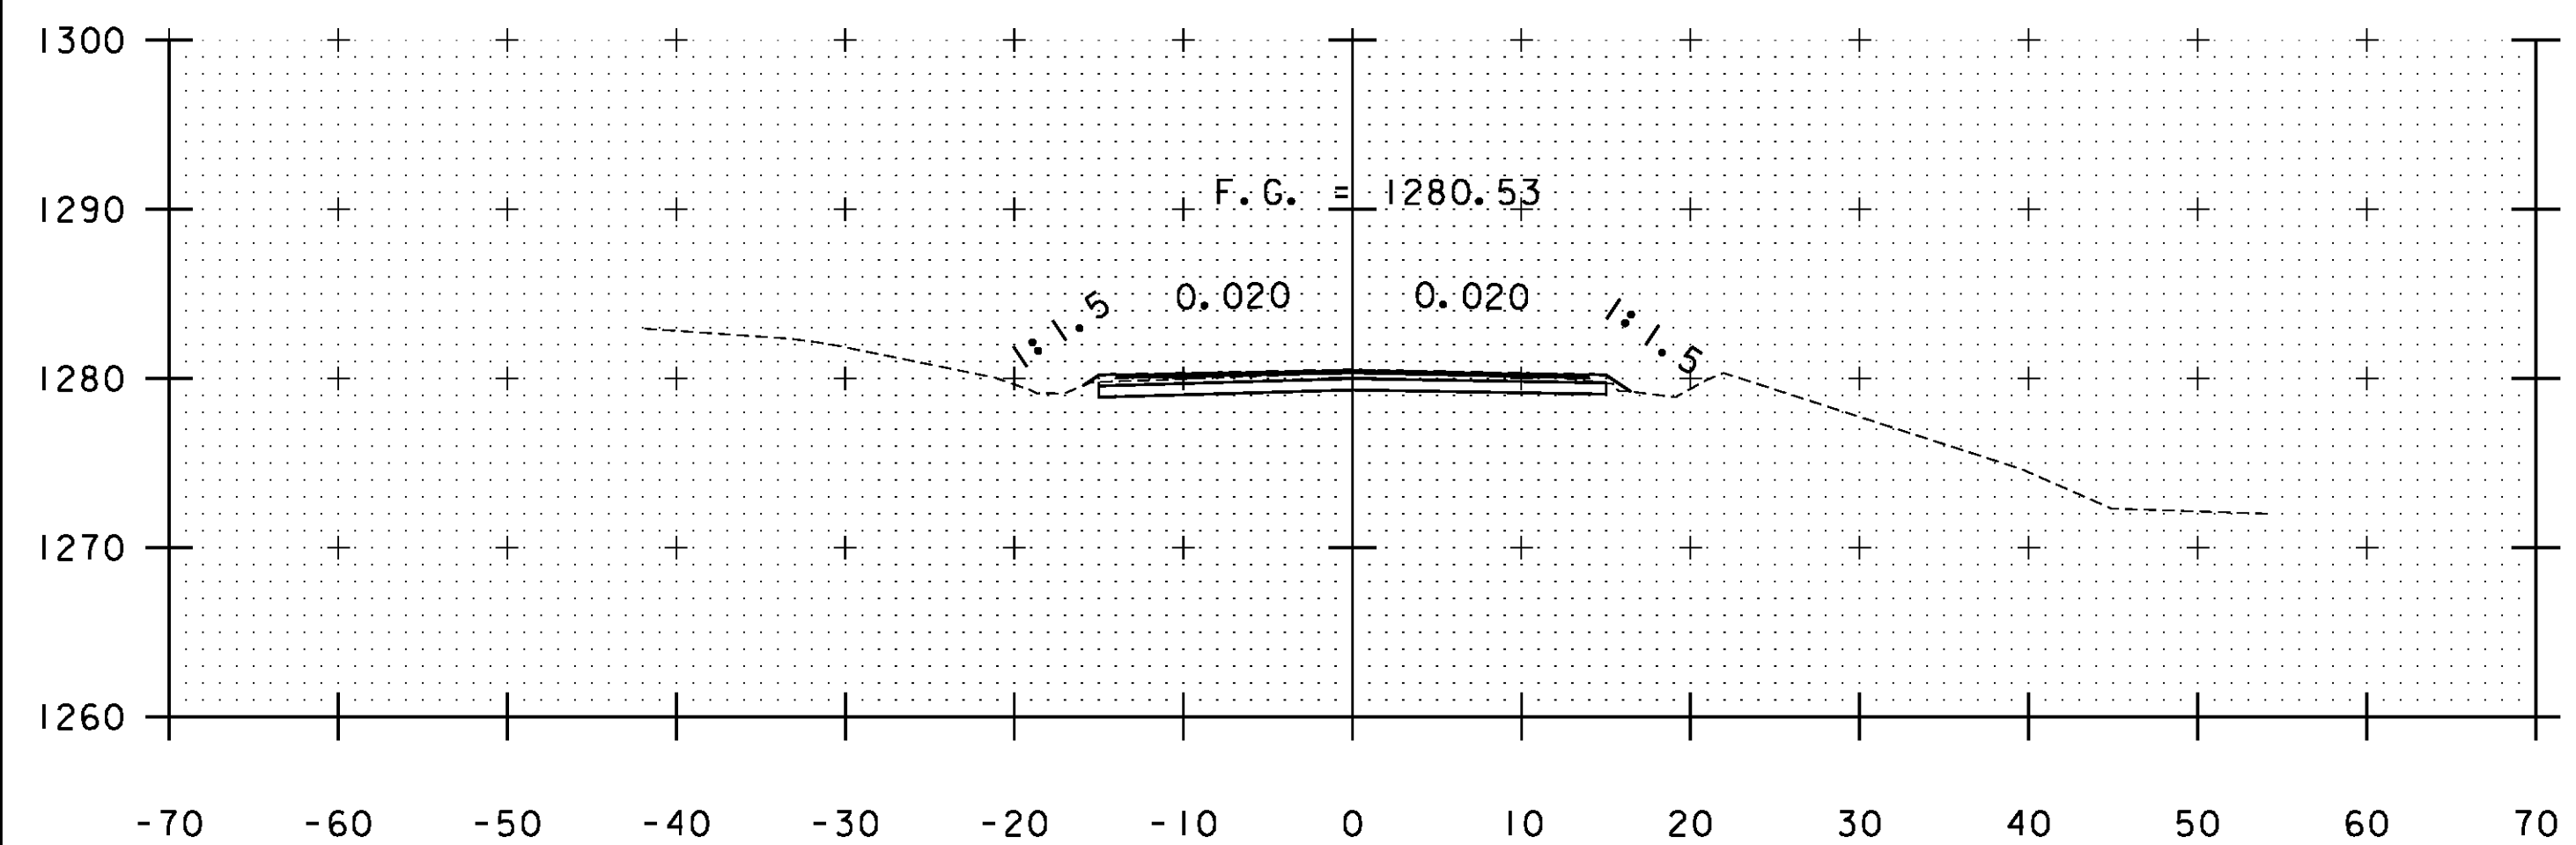


A 183+00

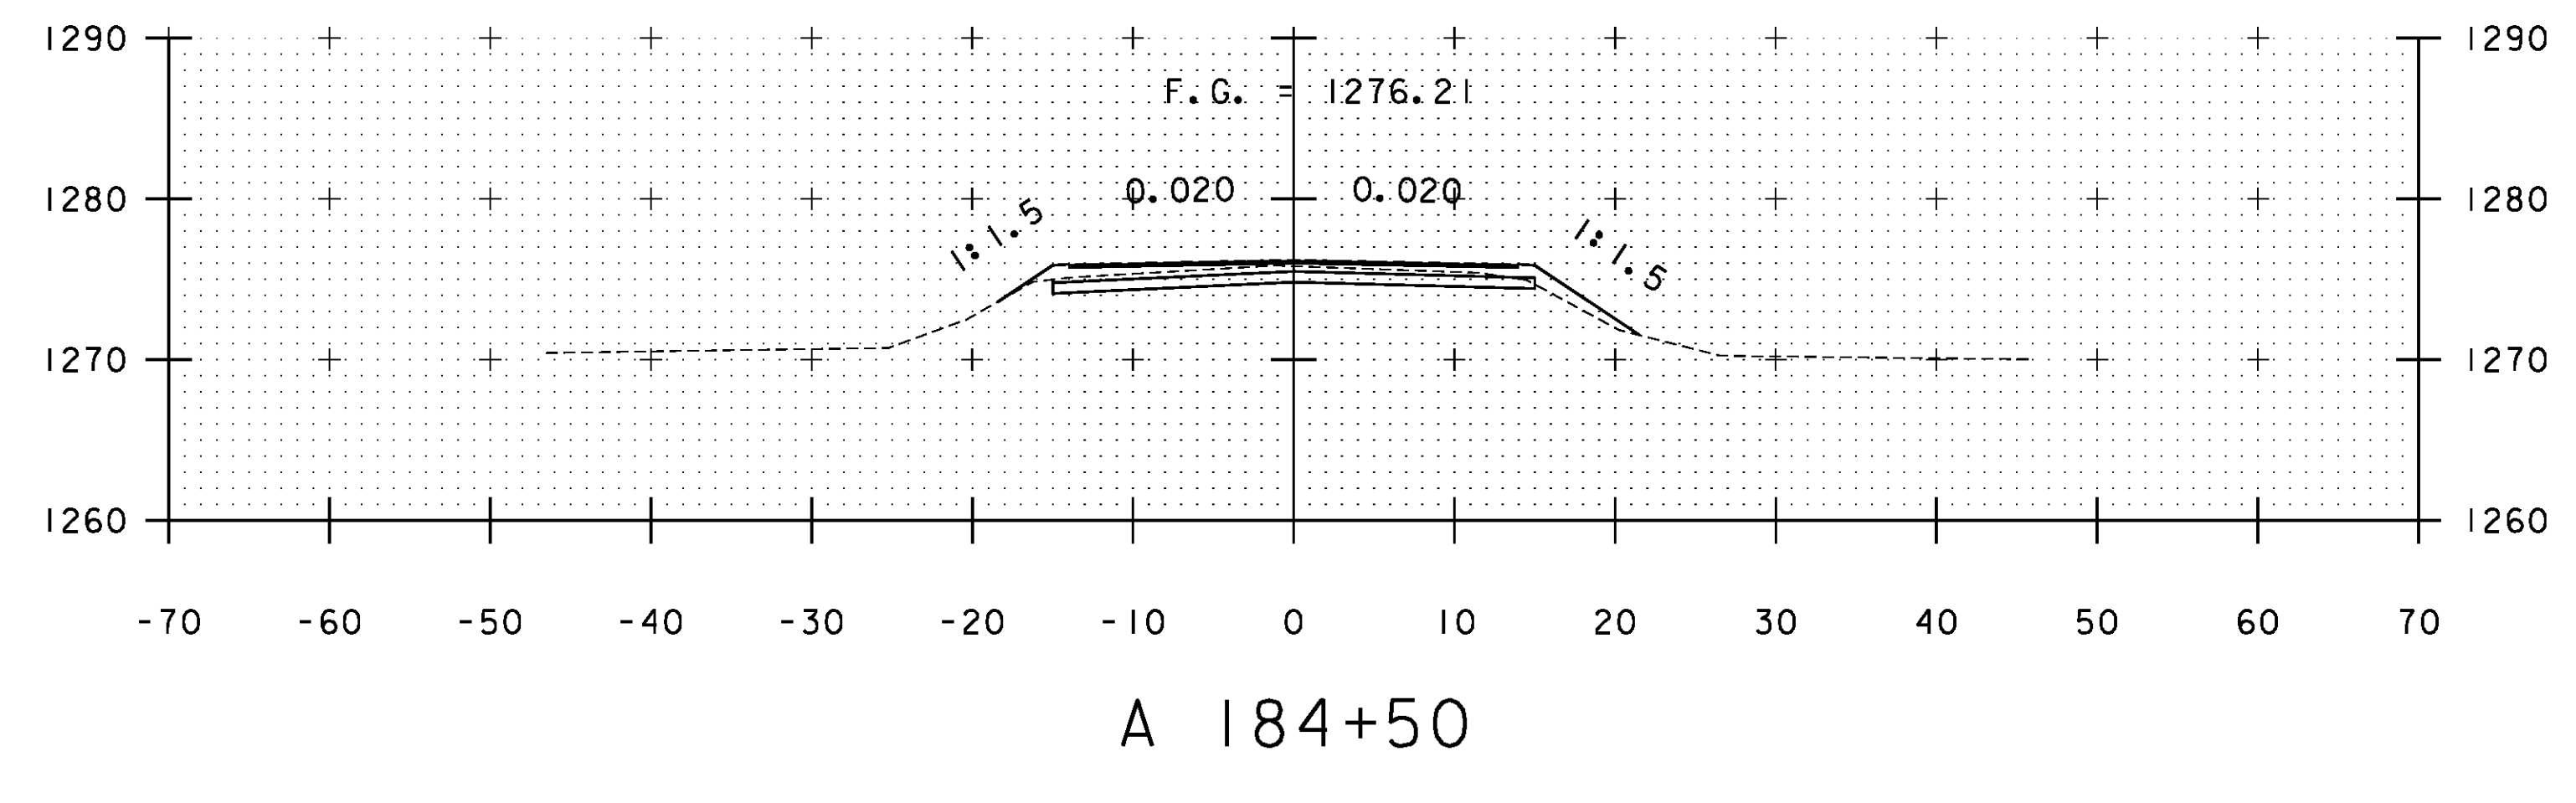

A 184+50

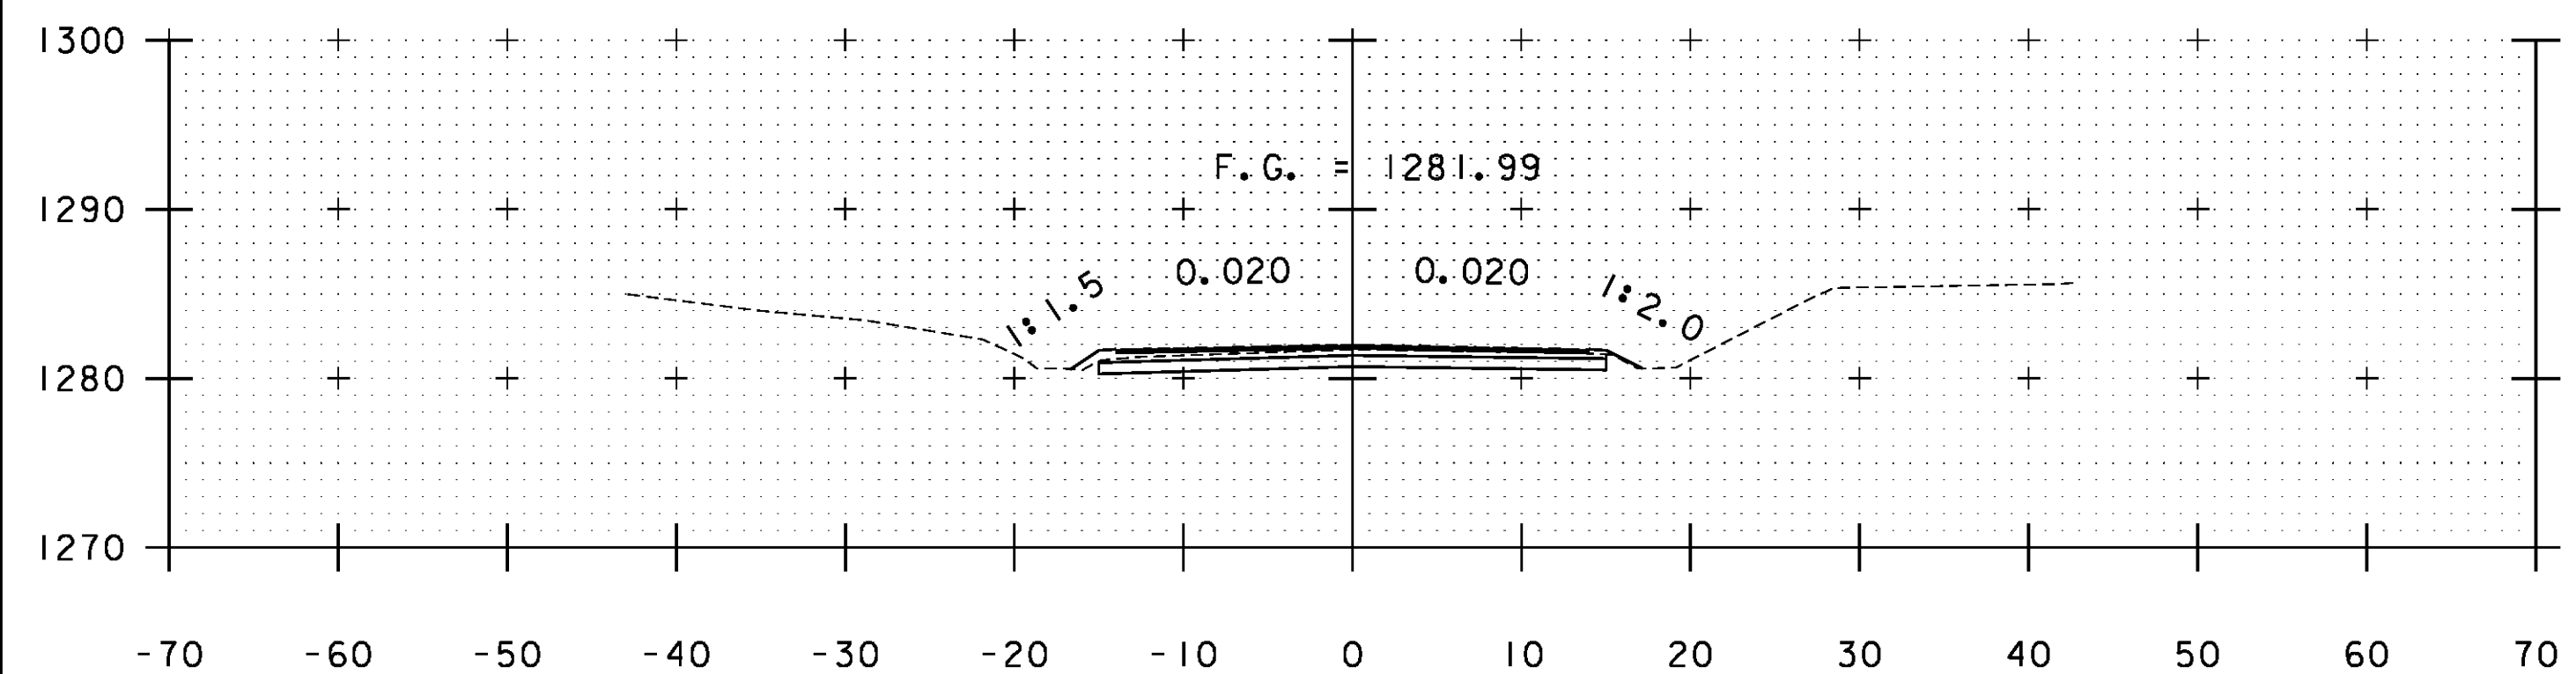

A 182+50

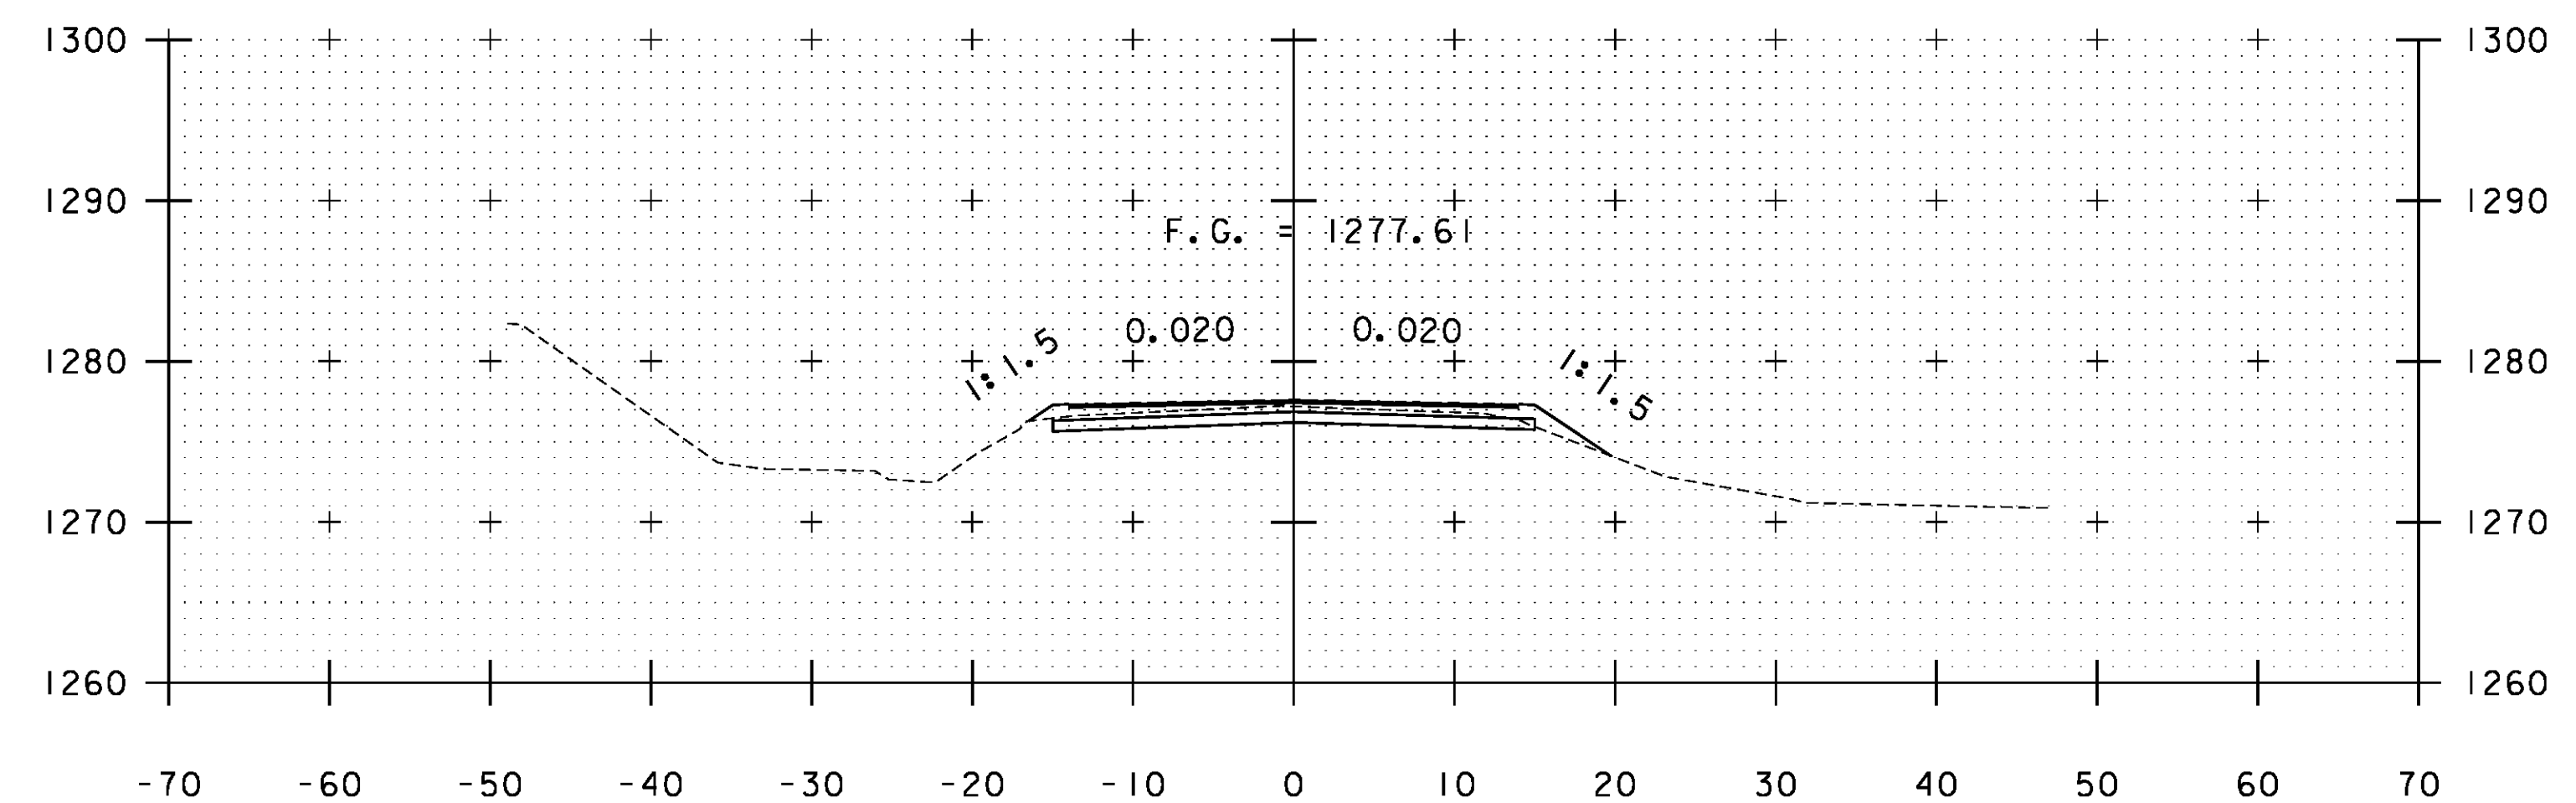

A 184+00

STA. A 182+50 TO STA. A 185+00

|                                  |                      |
|----------------------------------|----------------------|
| PROJECT NAME: WARDBORO-JAMAICA   |                      |
| PROJECT NUMBER: ER STP 013-1(17) |                      |
| FILE NAME: xs.dgn                | PLOT DATE: 2/26/2014 |
| PROJECT LEADER: K. UPMAL         | DRAWN BY: B. KIPP    |
| DESIGNED BY: B. KIPP             | CHECKED BY: HSD      |
| CROSS SECTIONS                   | SHEET 245 OF 444     |