




A 197+50

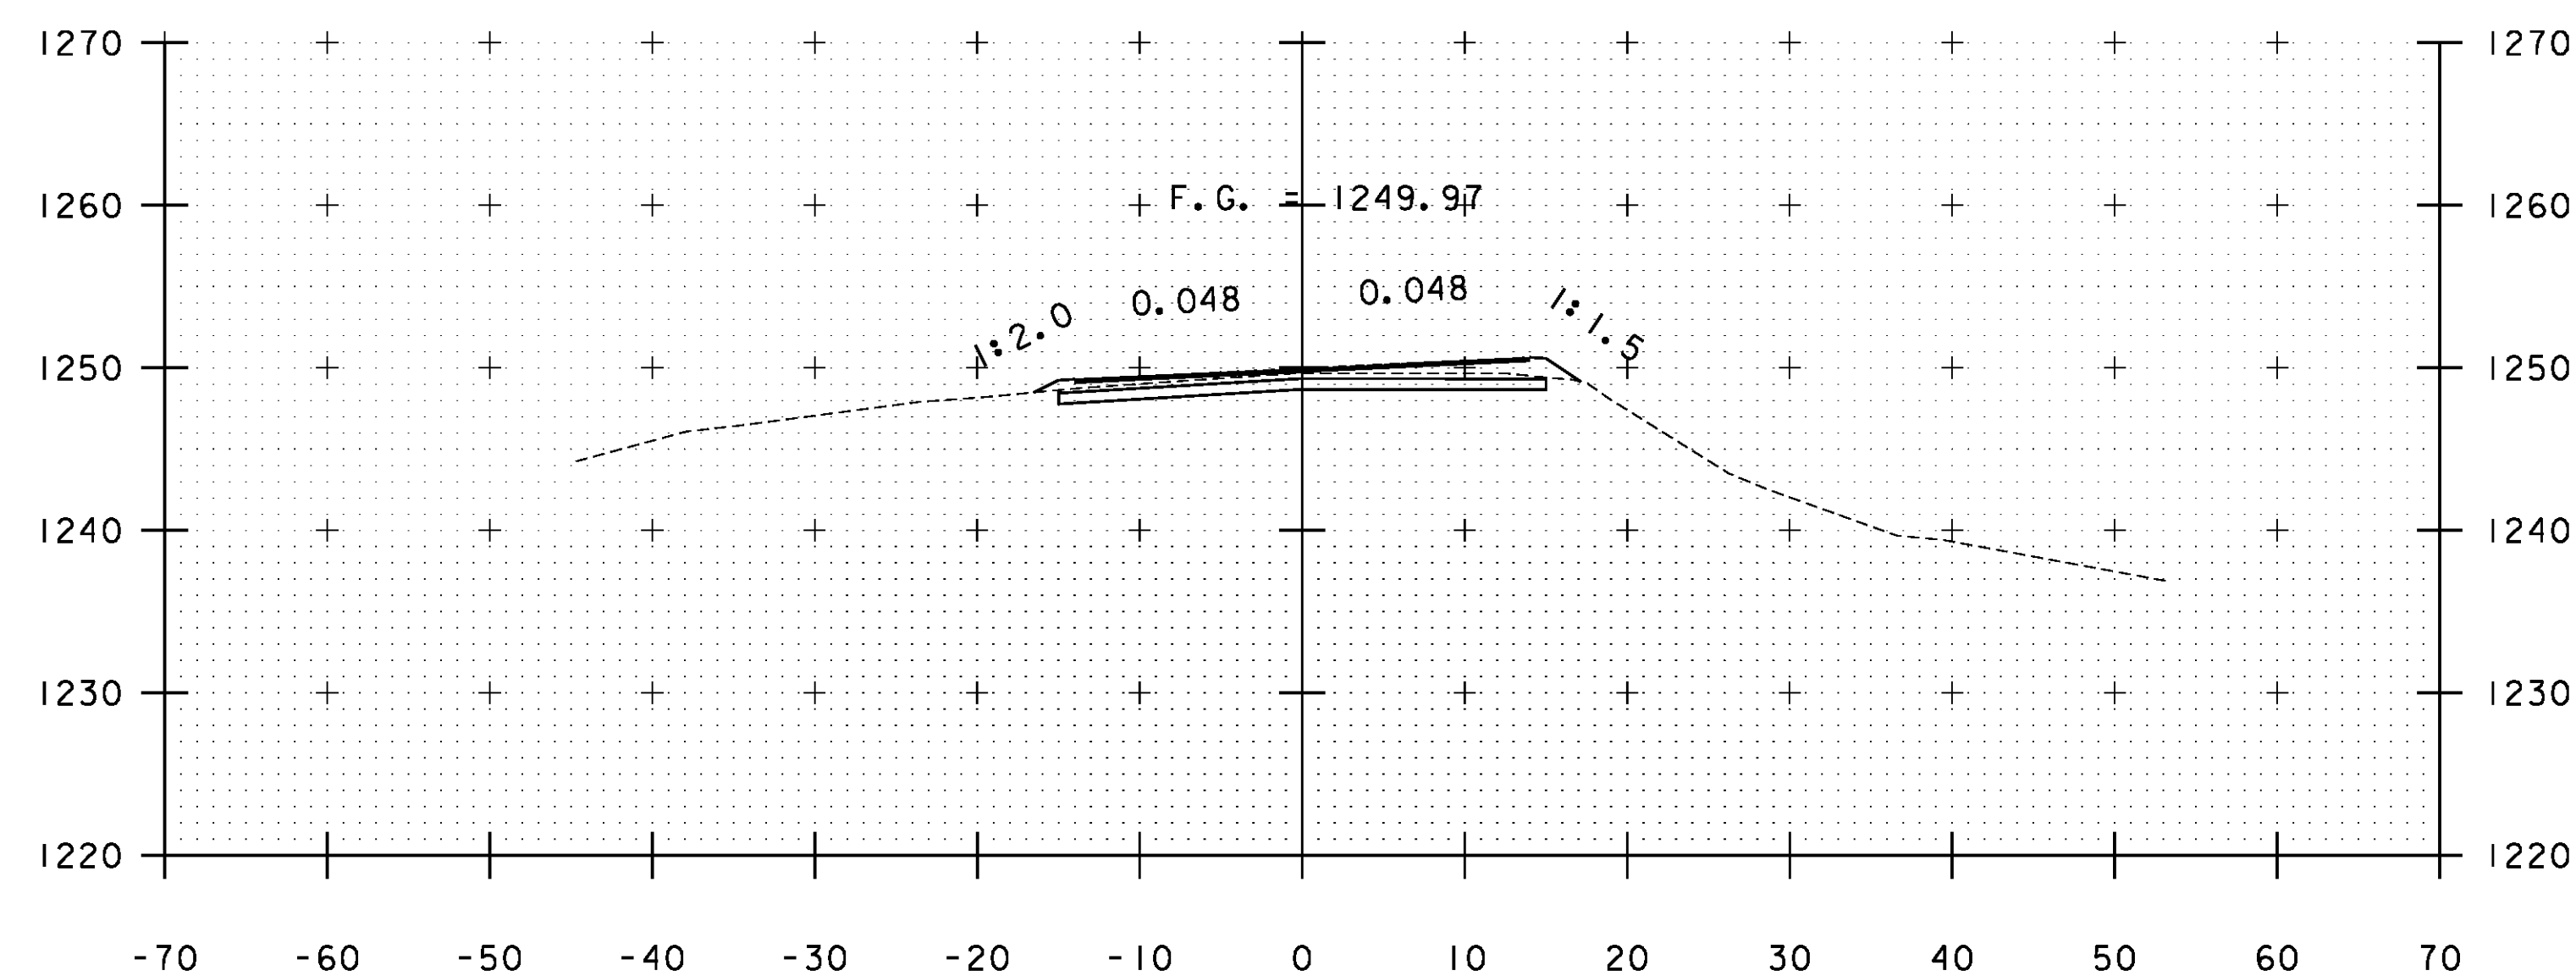

A 198+50

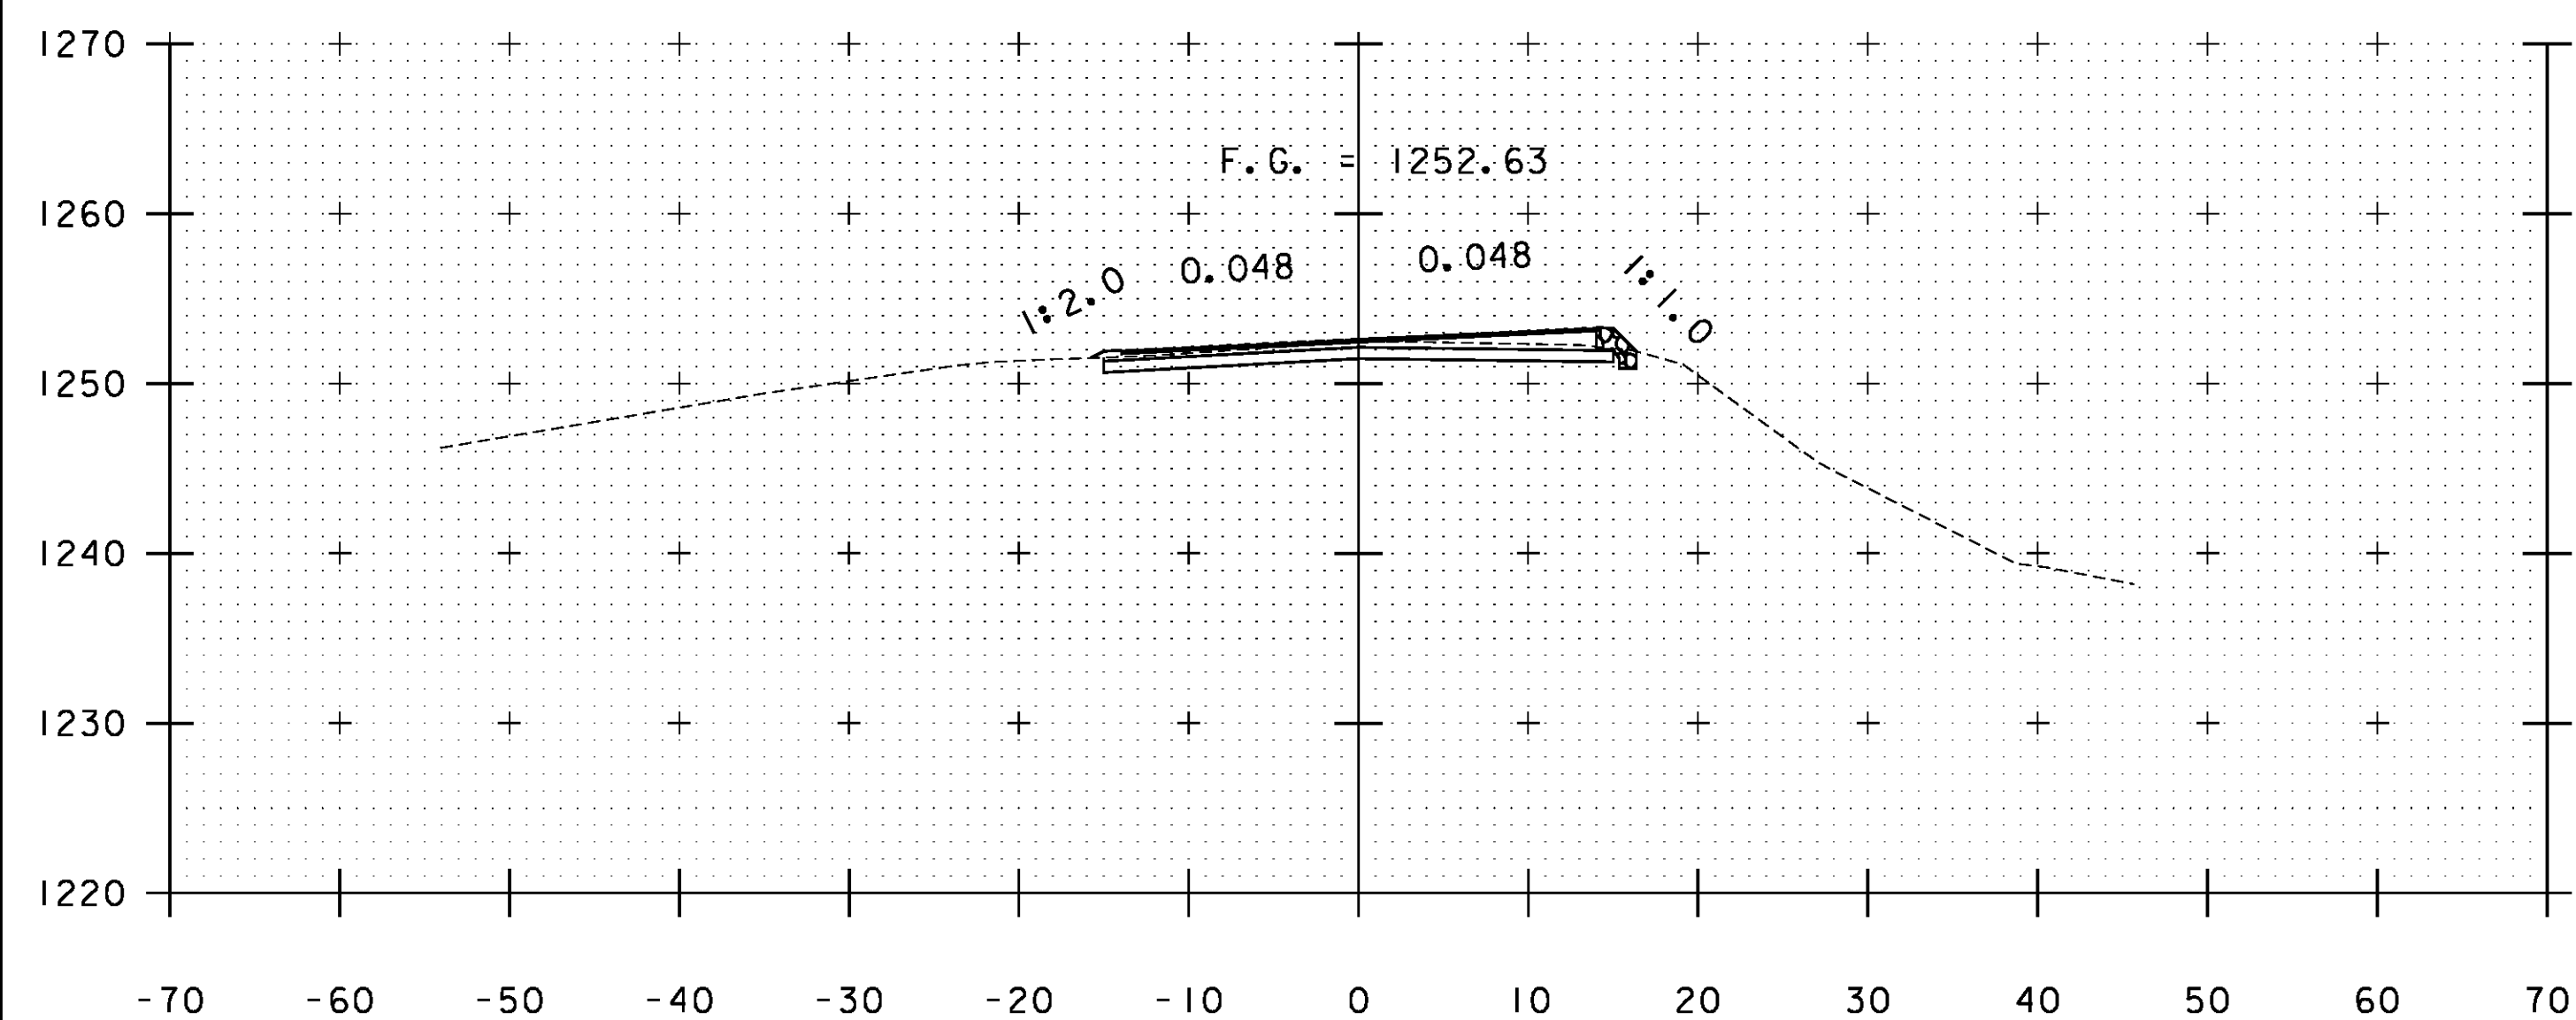

A 197+00

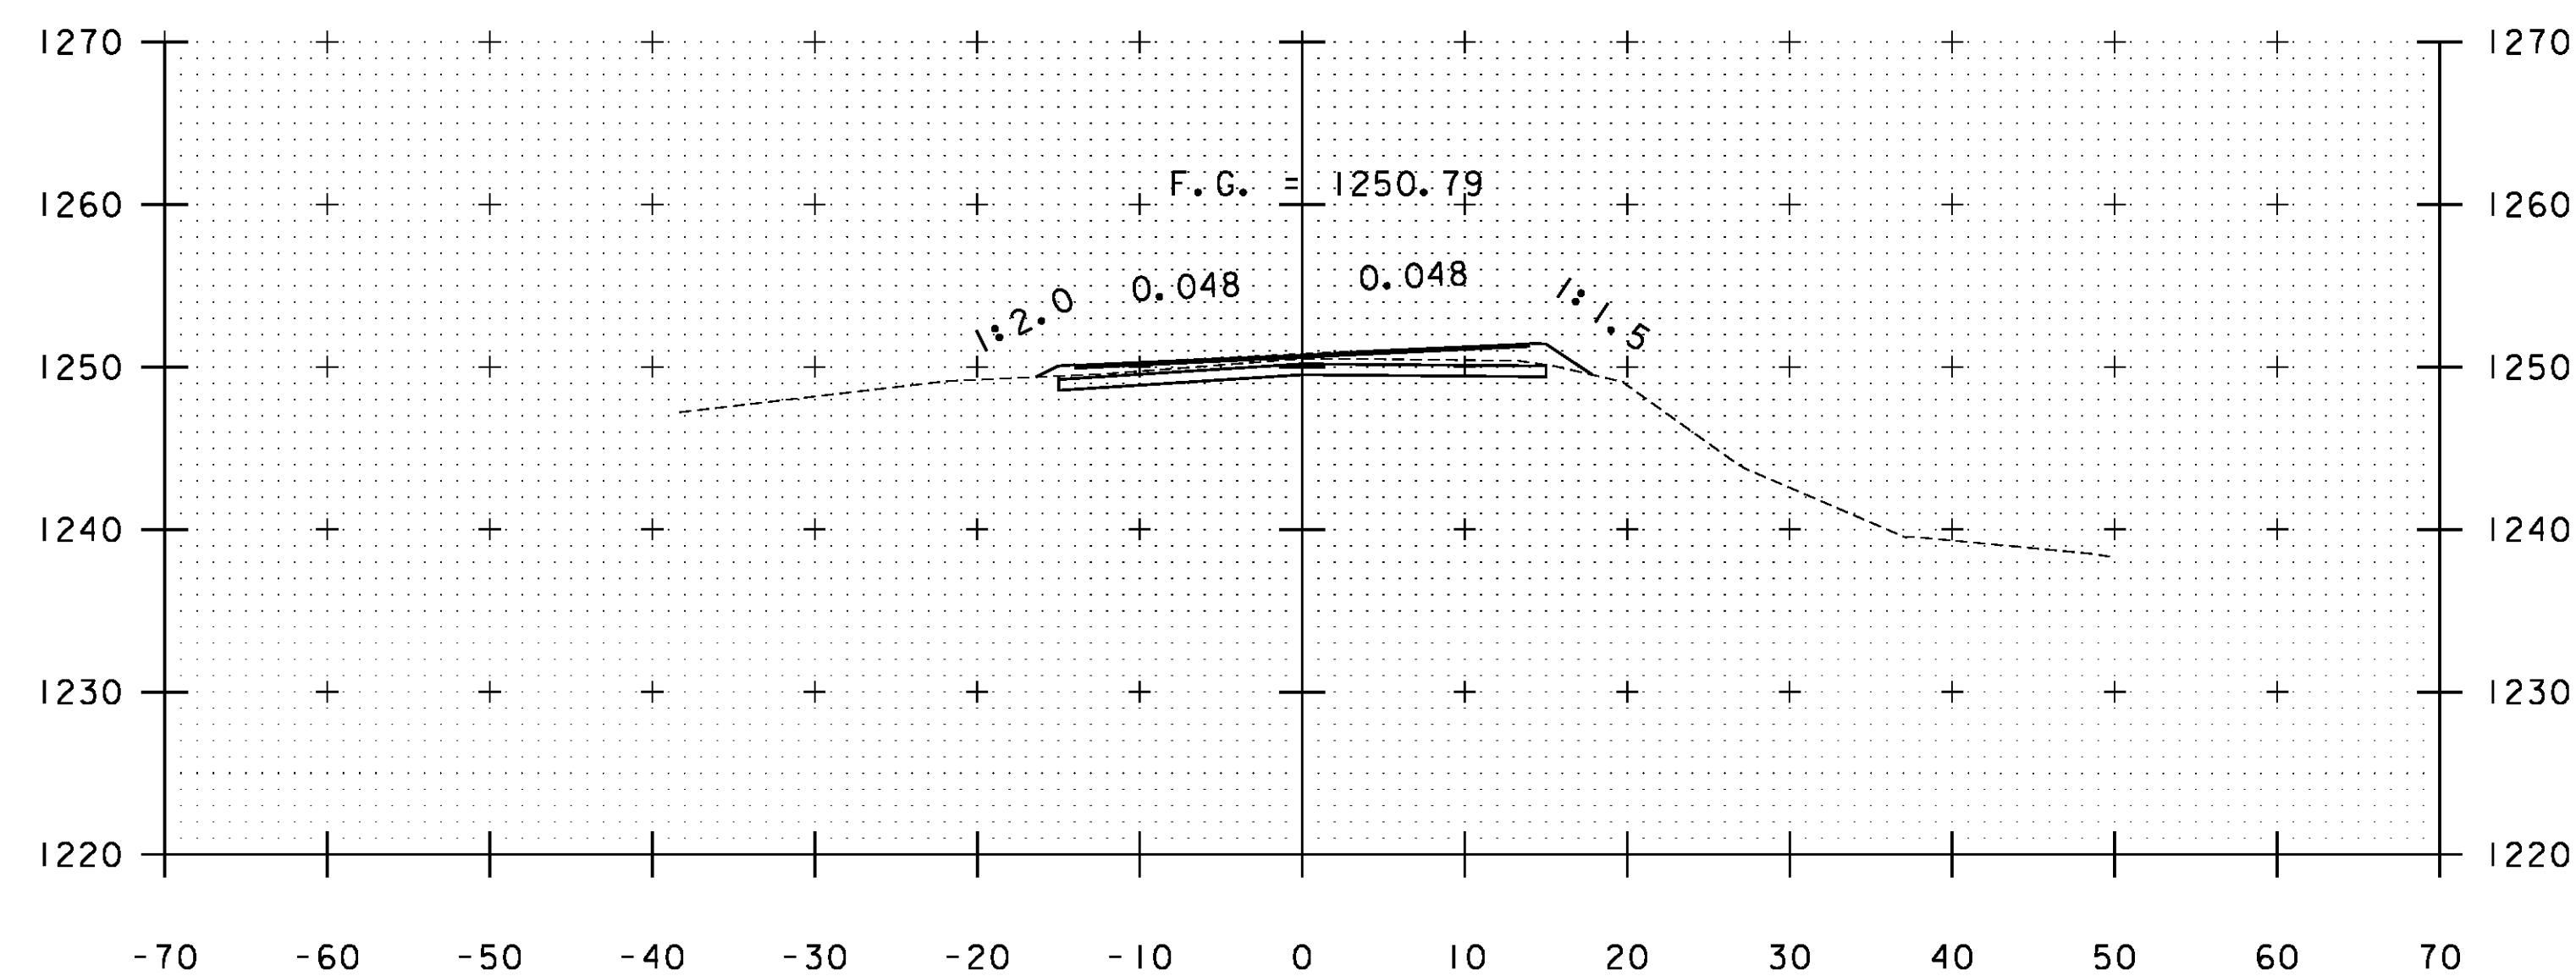

A 198+00

STA. A 197+00 TO STA. A 198+50

PROJECT NAME: WARDBORO-JAMAICA	PLOT DATE: 2/26/2014
PROJECT NUMBER: ER STP 013-1(17)	DRAWN BY: B. KIPP
FILE NAME: xs.dgn	CHECKED BY: HSD
PROJECT LEADER: K. UPMAL	SHEET 251 OF 444
DESIGNED BY: B. KIPP	
CROSS SECTIONS	