




A 200+00

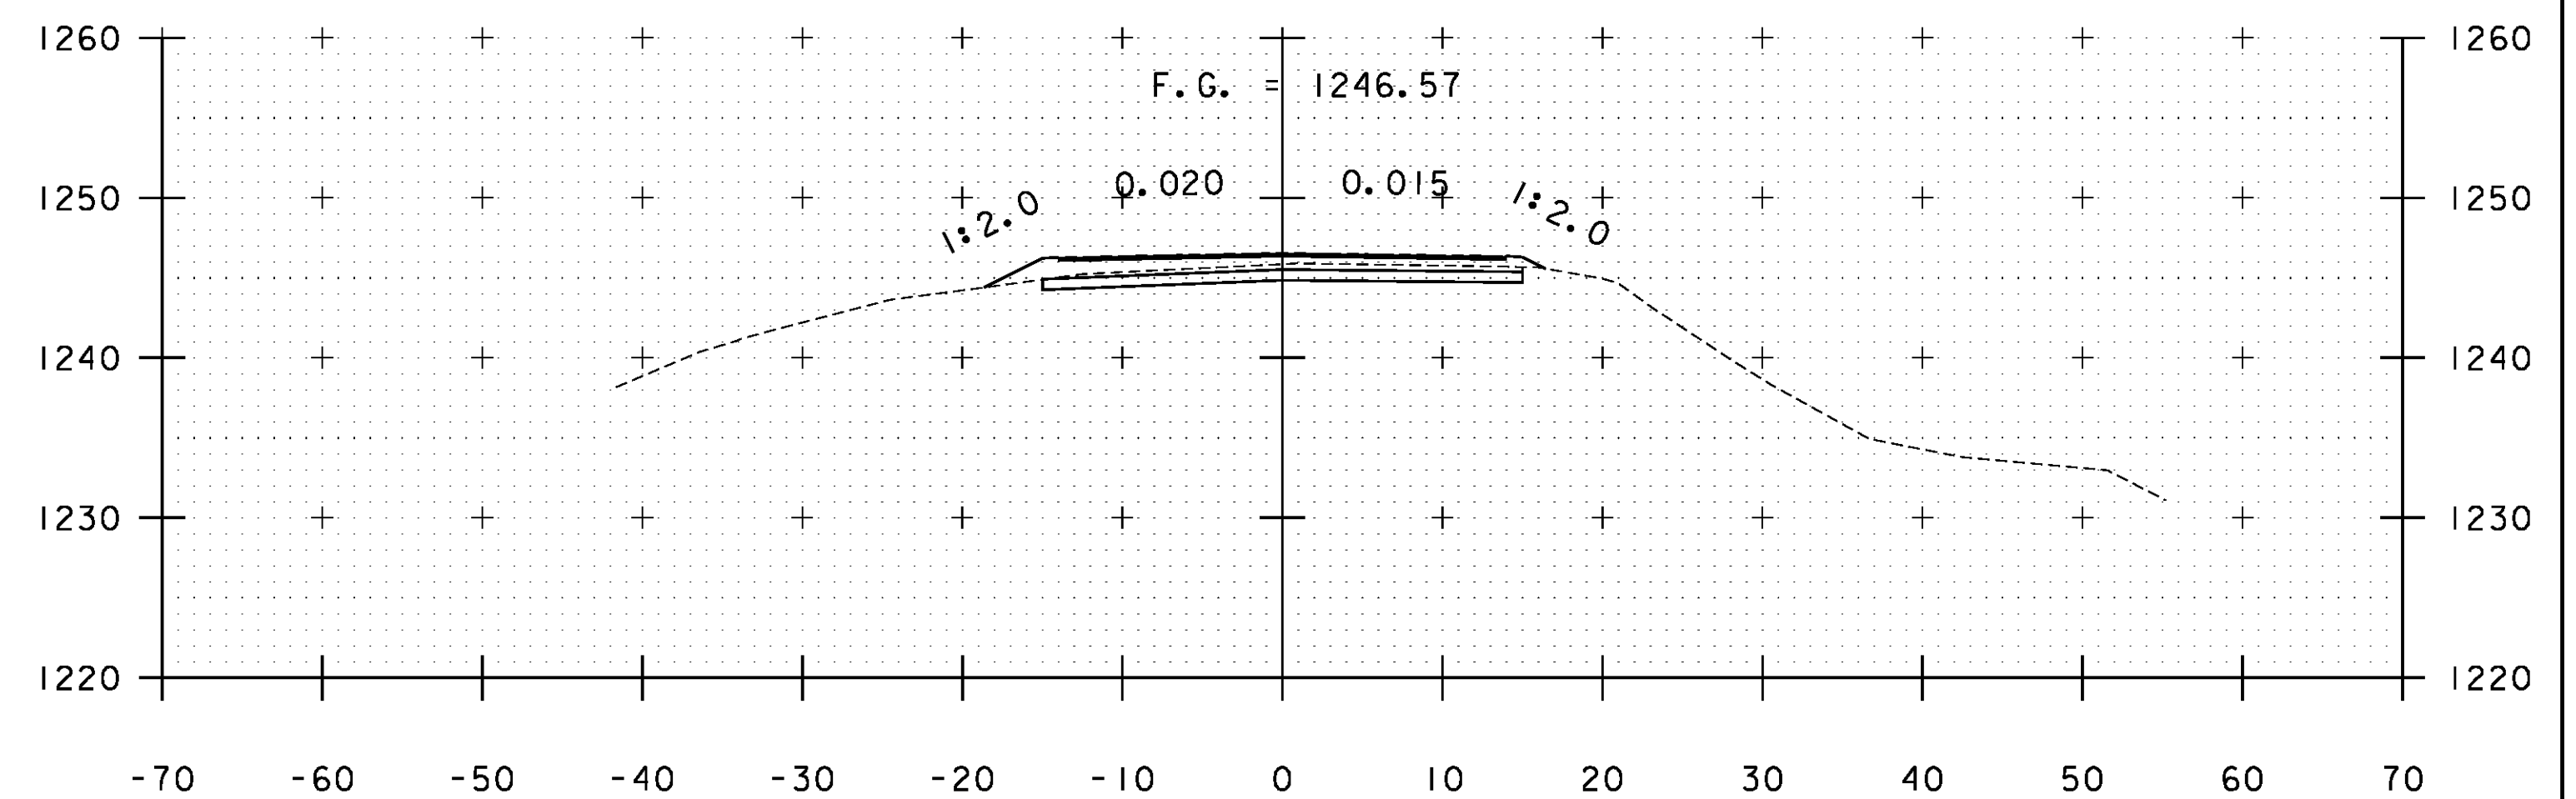


A 201+00

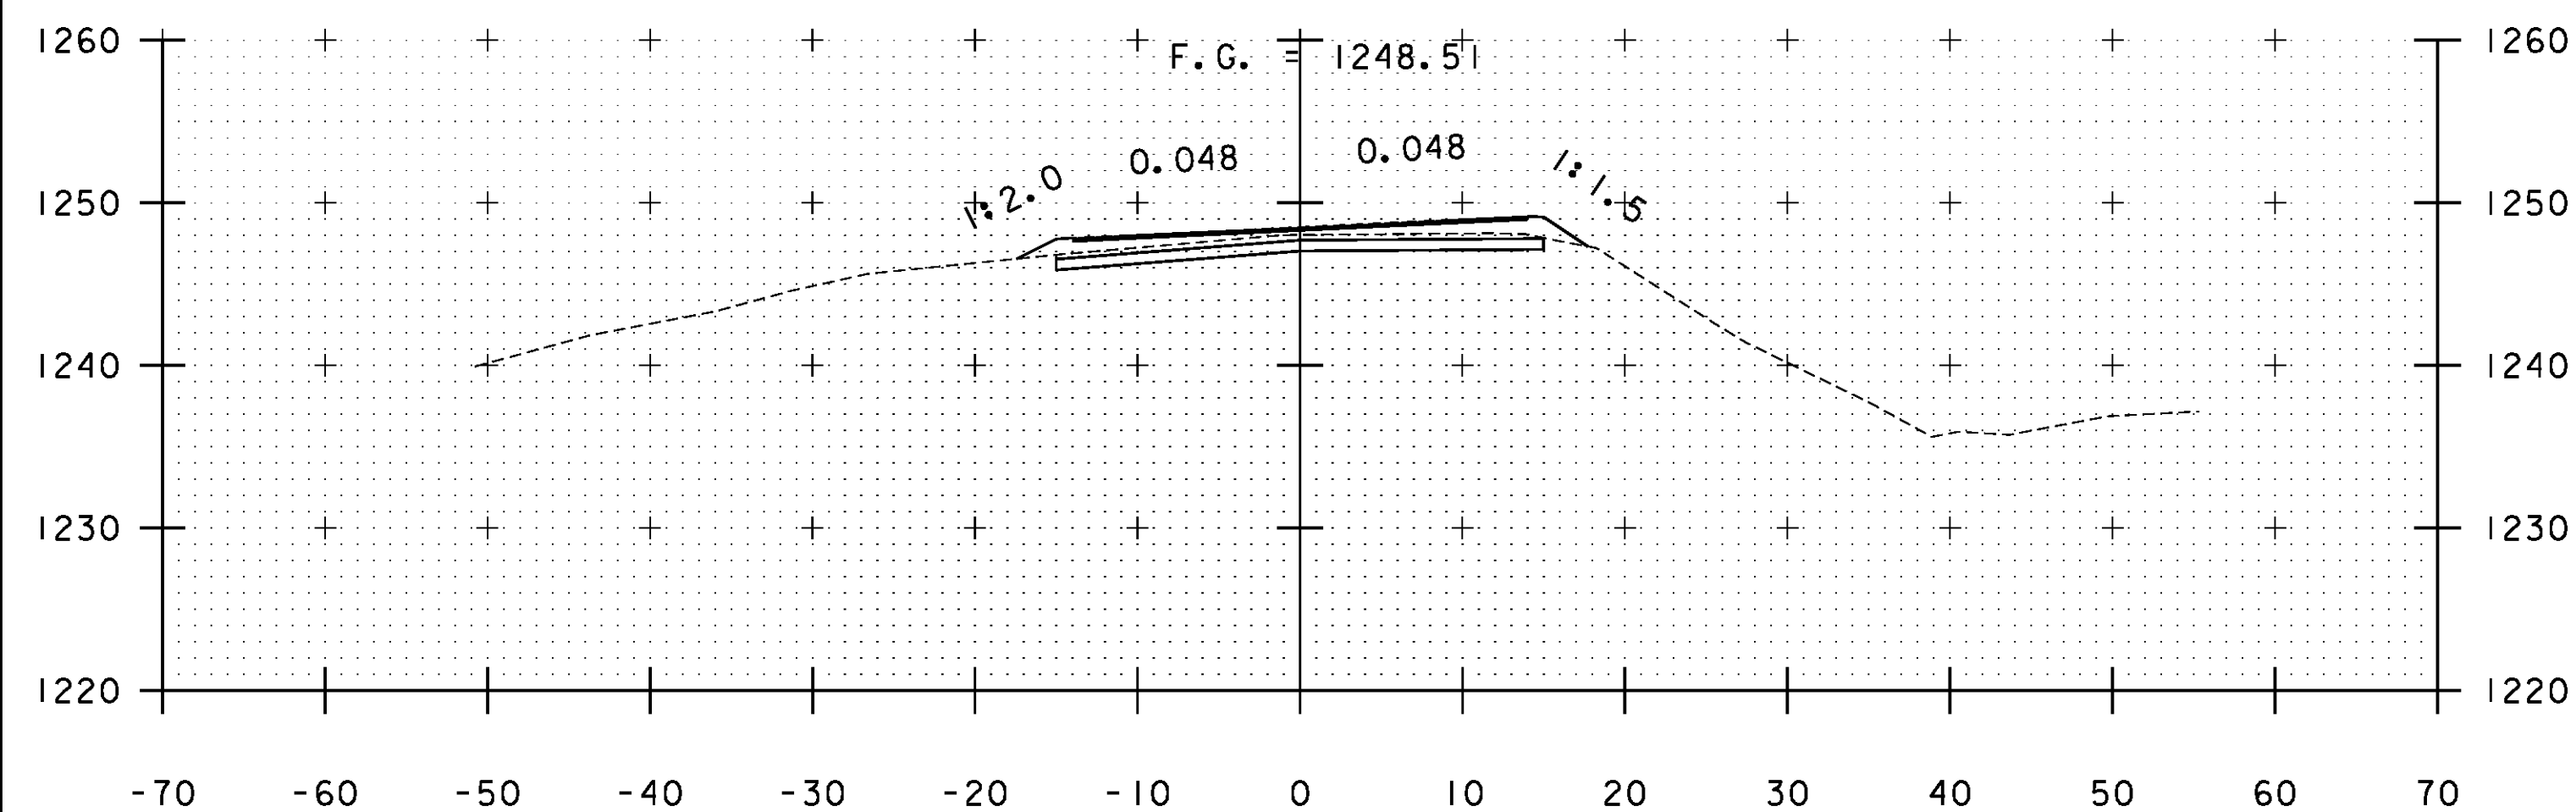

A 199+50

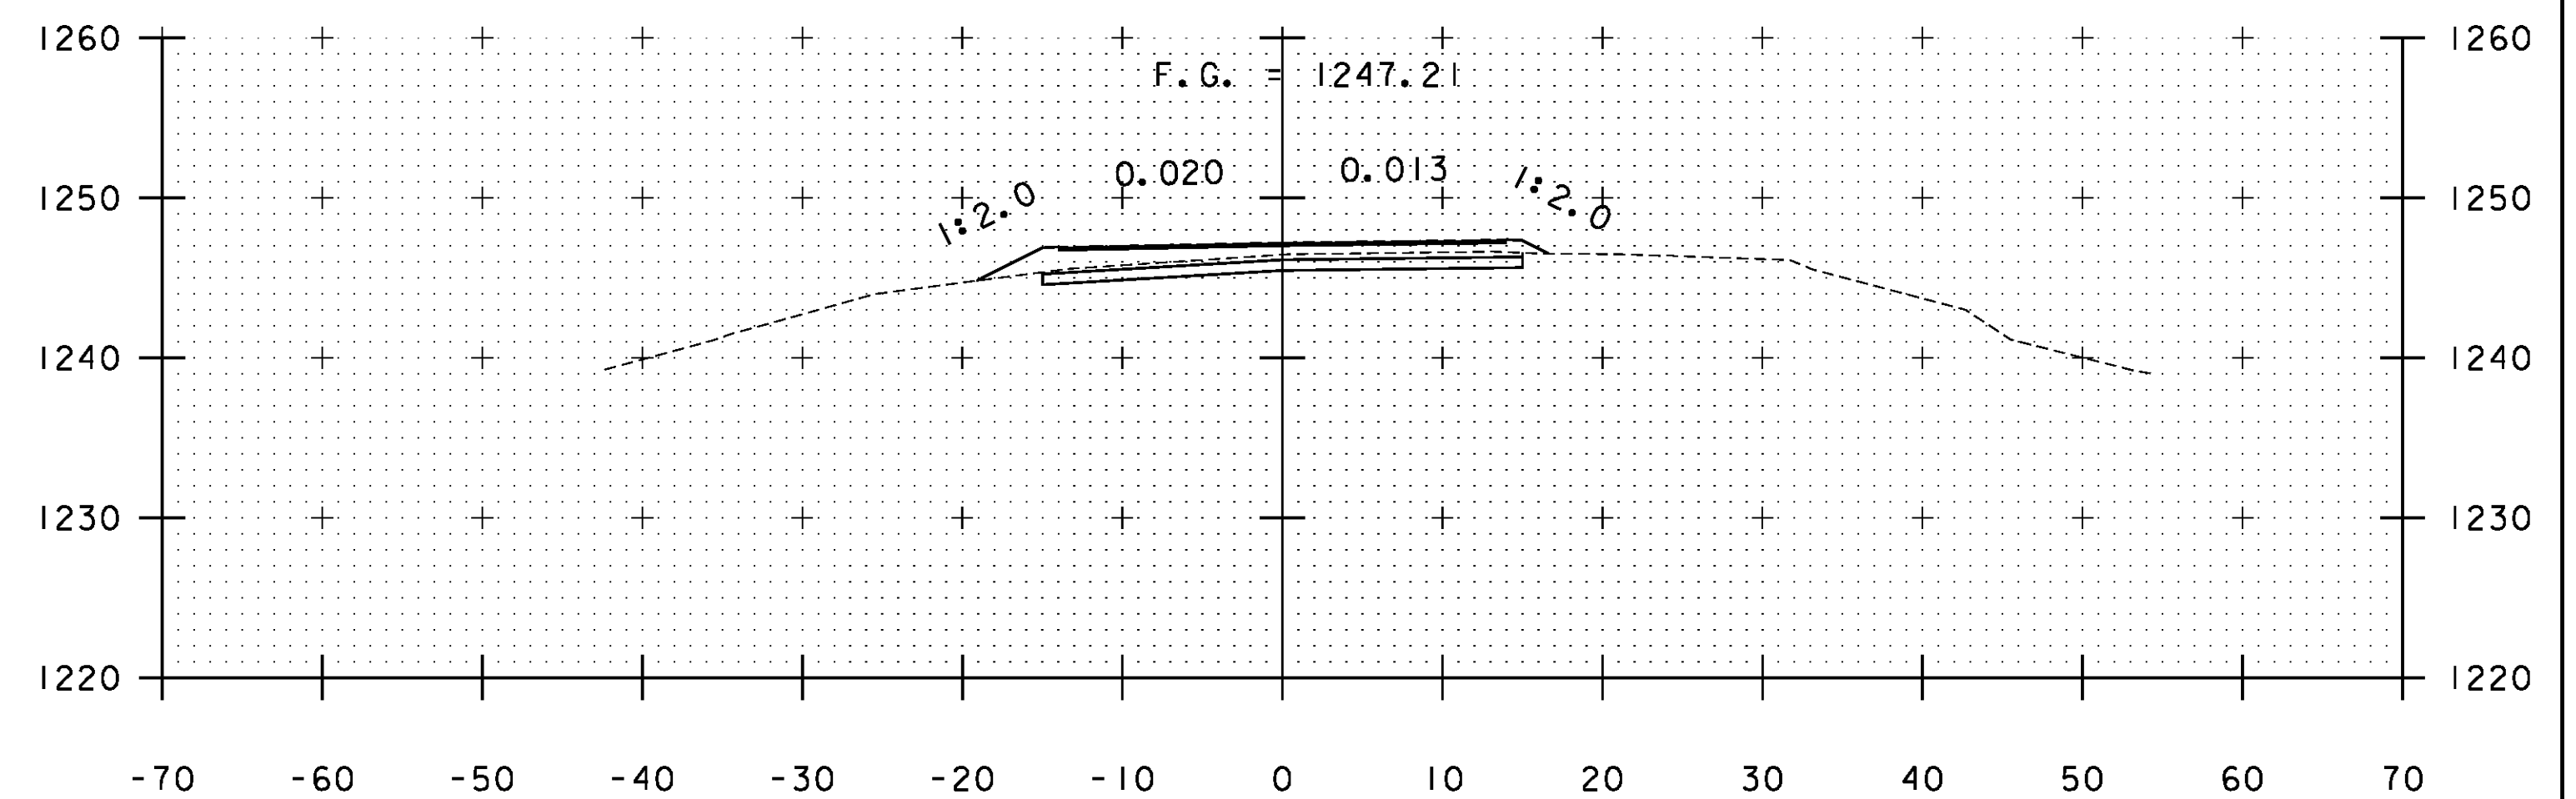

A 200+50

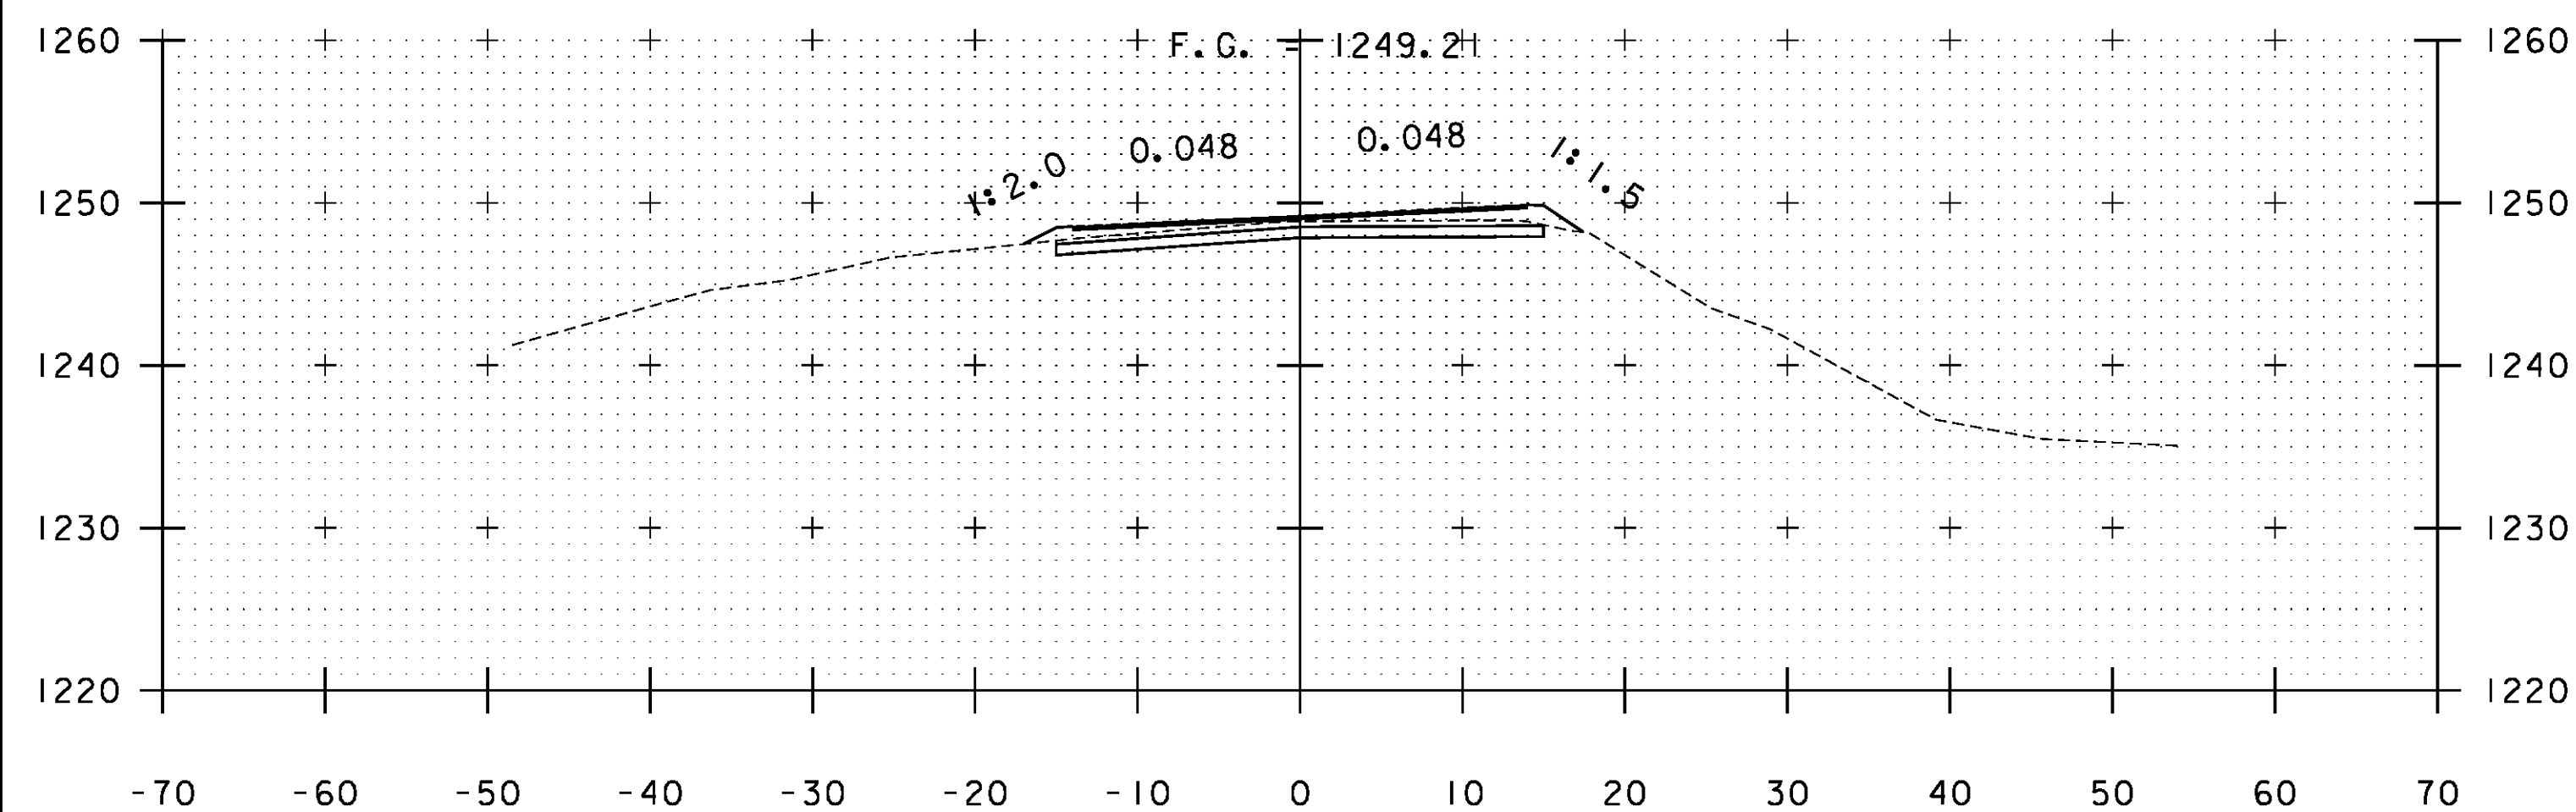

A 199+00

STA. A 199+00 TO STA. A 201+00

PROJECT NAME: WARDSBORO-JAMAICA	PLOT DATE: 2/26/2014
PROJECT NUMBER: ER STP 013-1(17)	DRAWN BY: B. KIPP
FILE NAME: xs.dgn	CHECKED BY: HSD
PROJECT LEADER: K. UPMAL	SHEET 252 OF 444
DESIGNED BY: B. KIPP	
CROSS SECTIONS	