




A 202+00

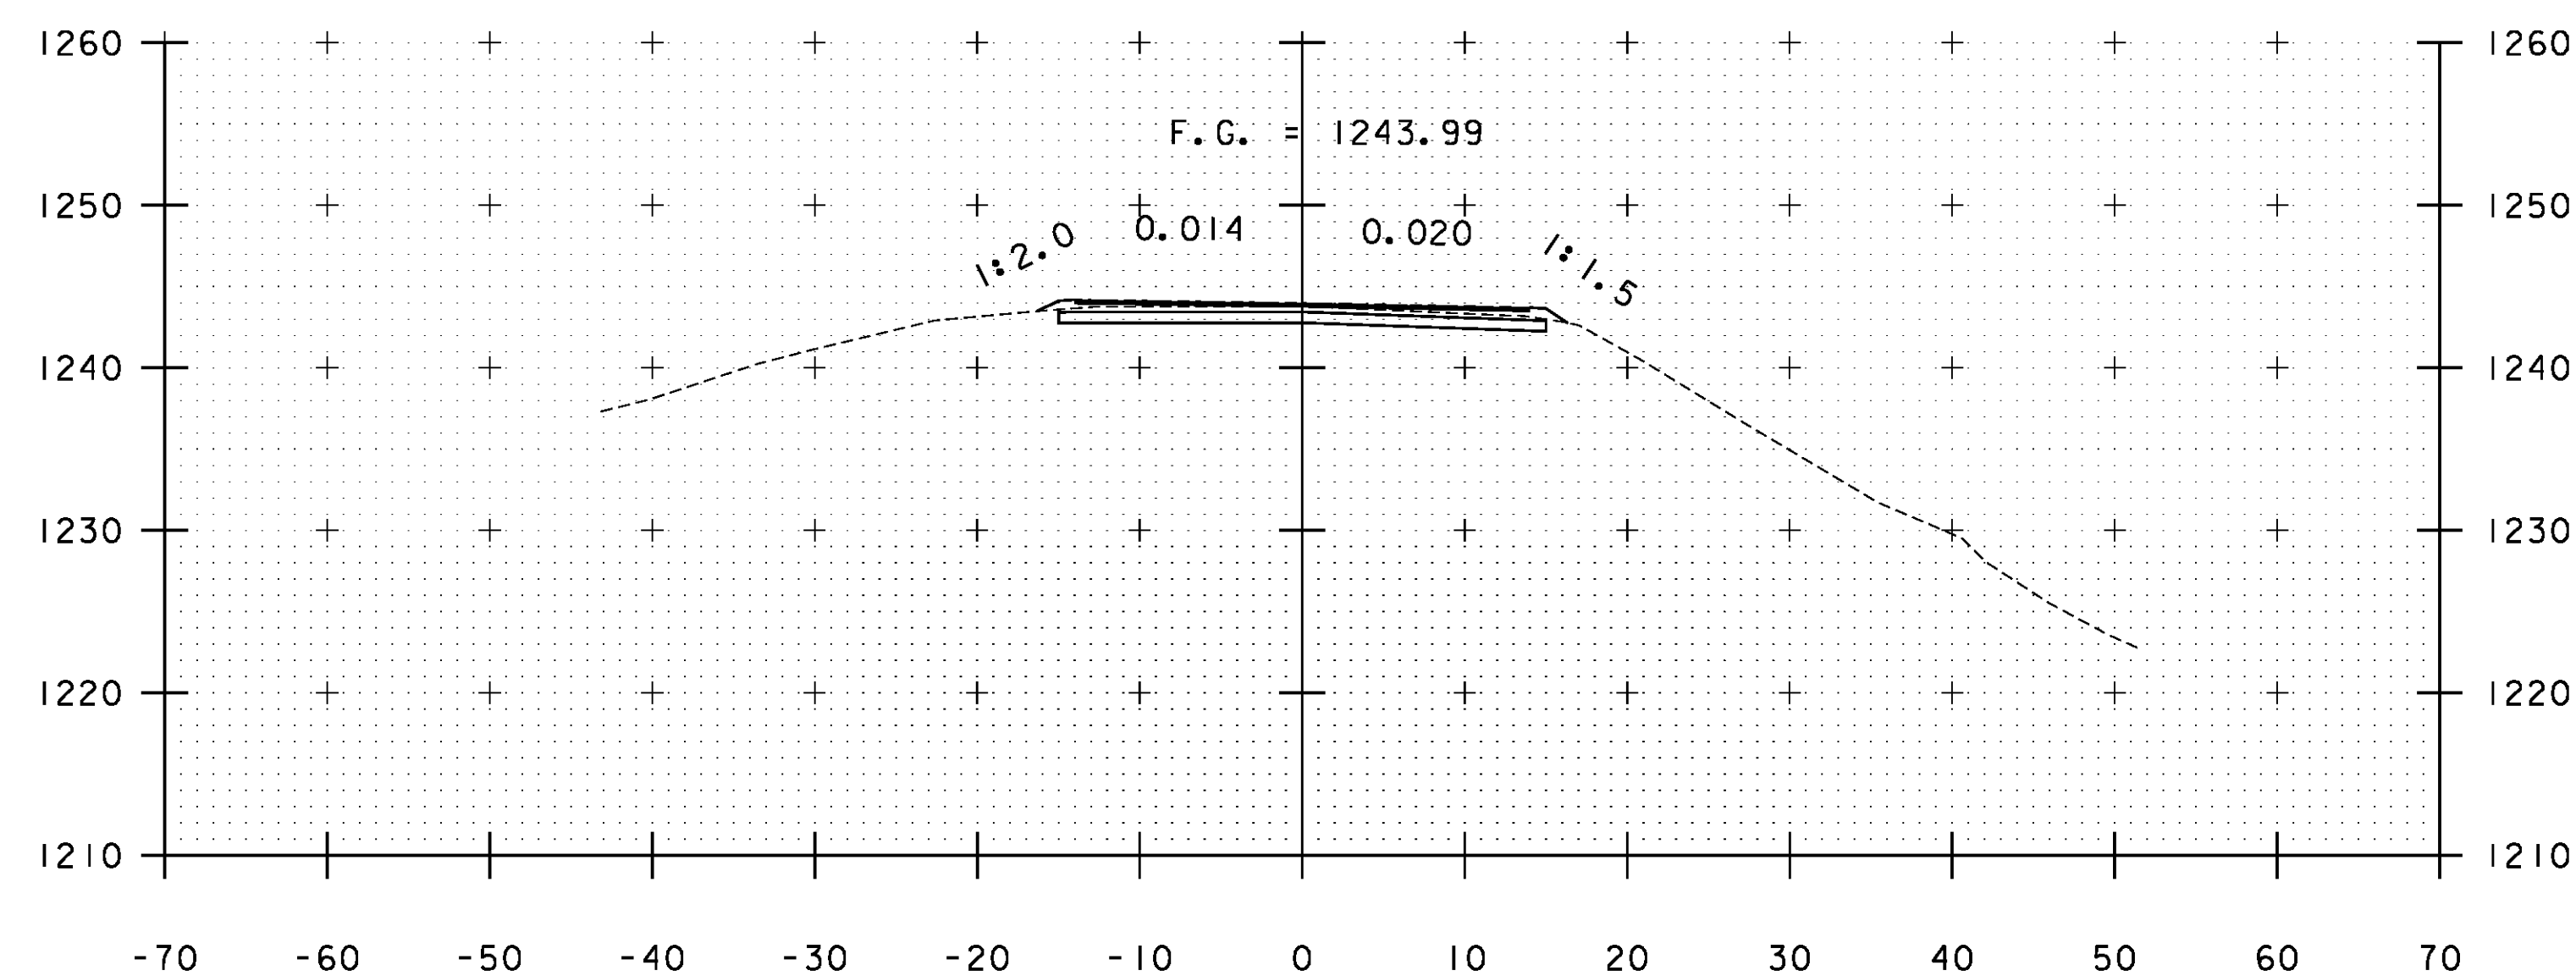

A 203+00

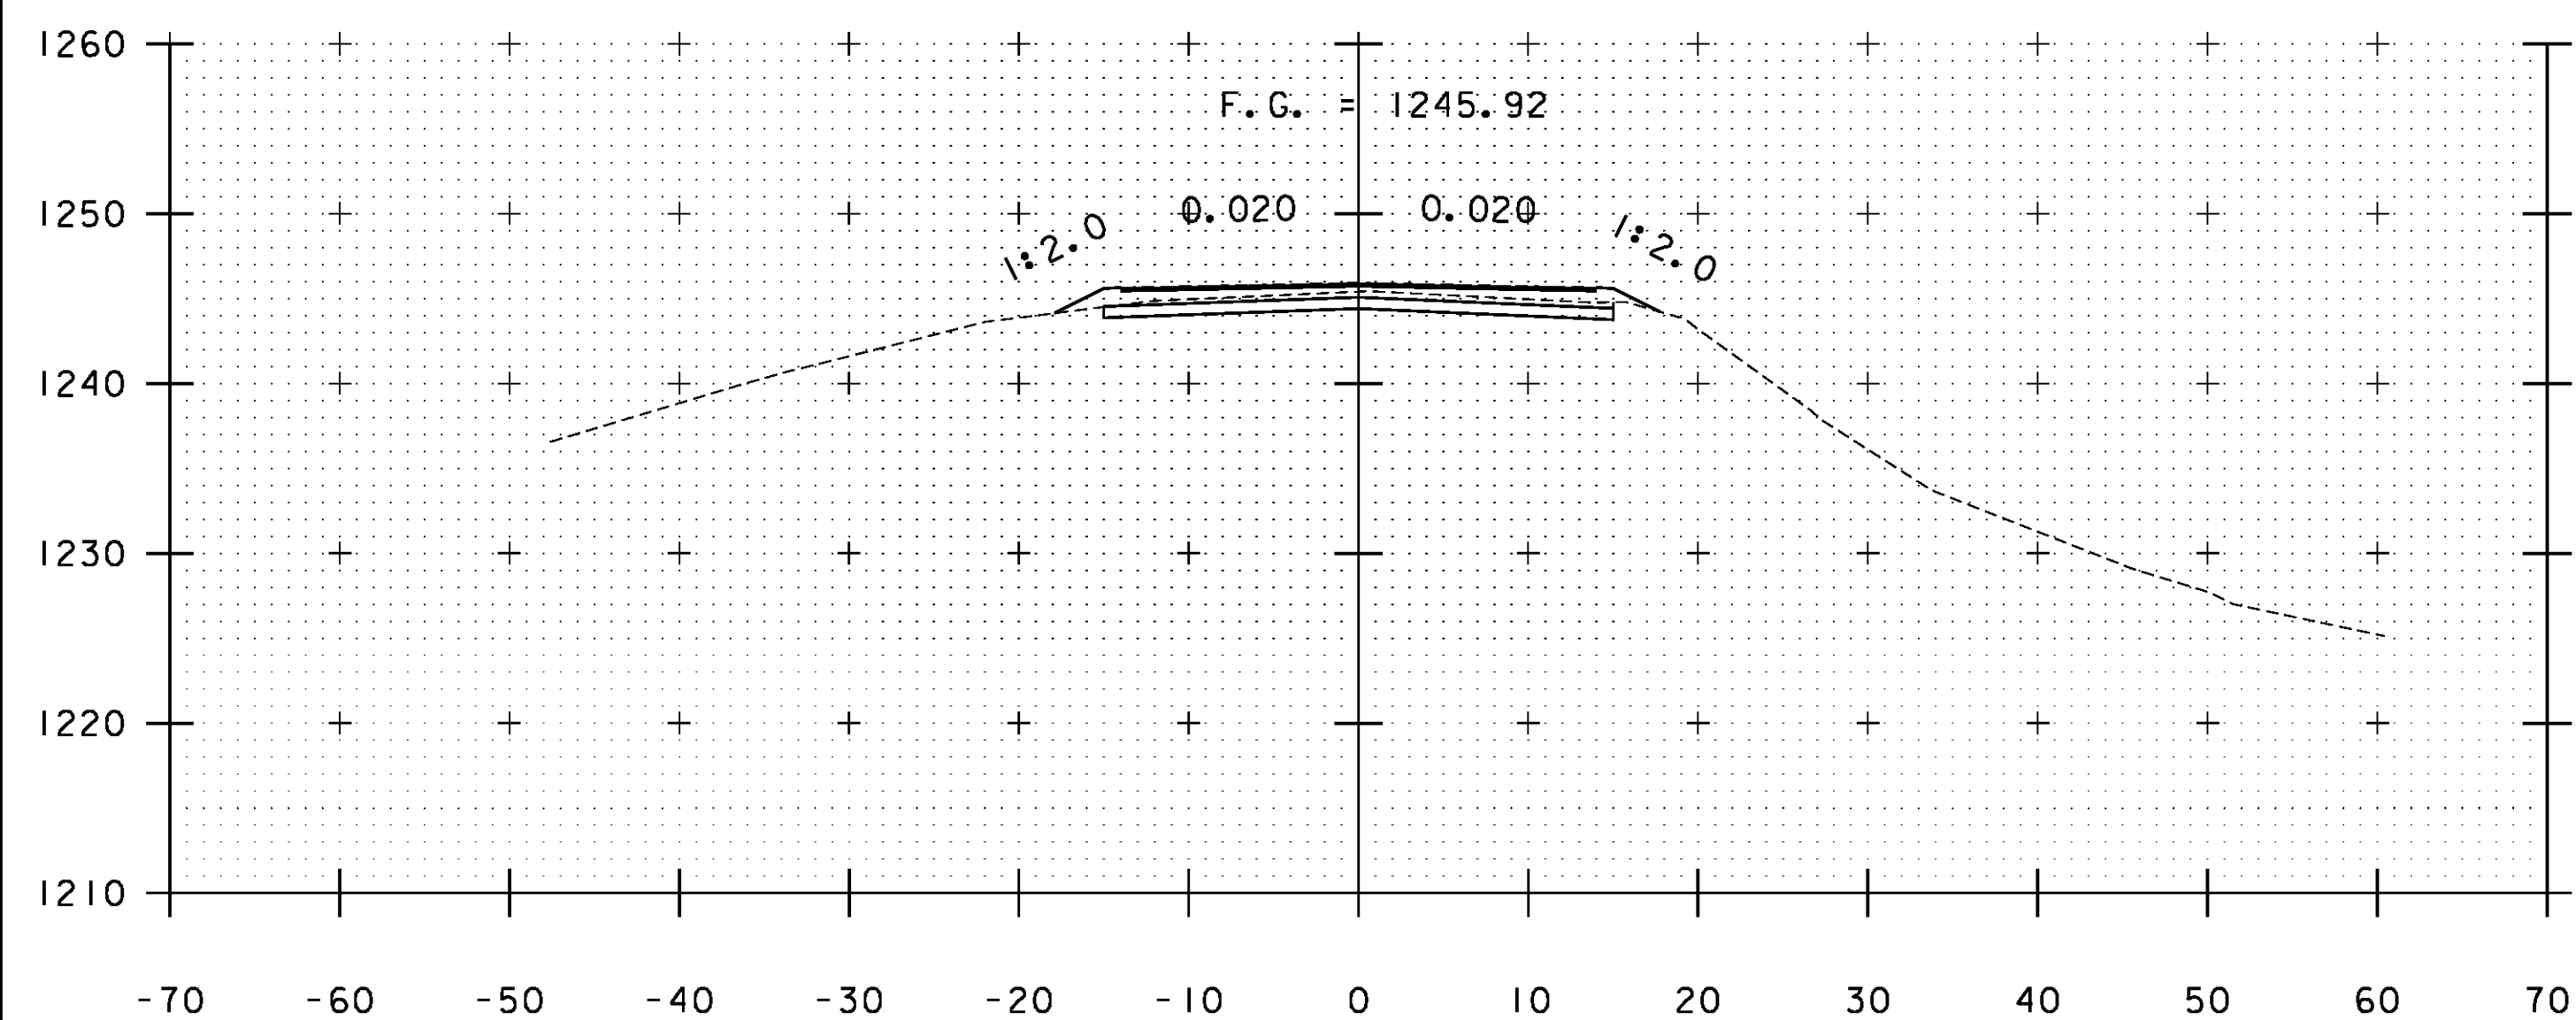

A 201+50

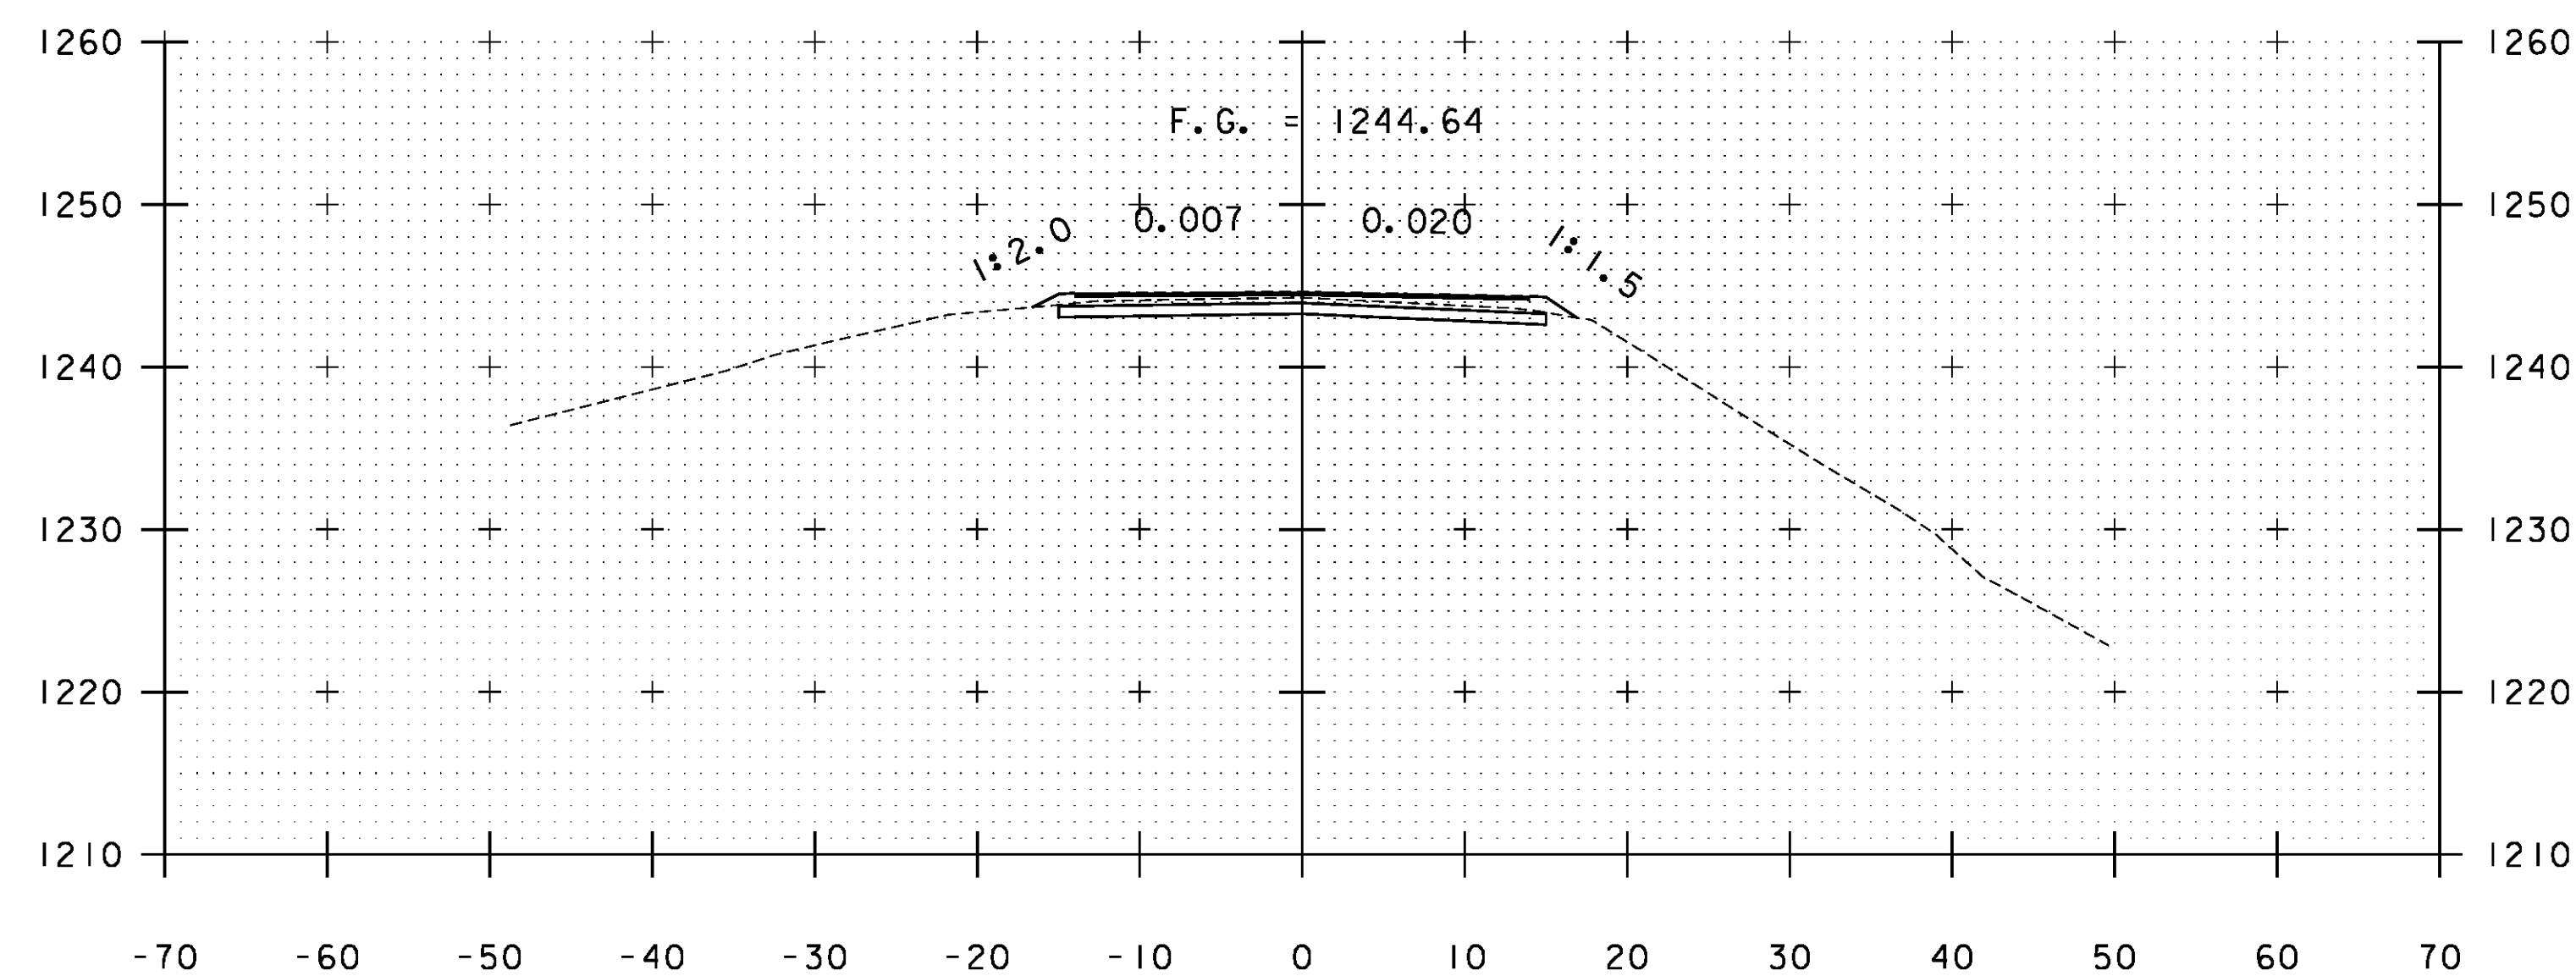

A 202+50

STA. A 201+50 TO STA. A 203+00

PROJECT NAME: WARDBORO-JAMAICA	PLOT DATE: 2/26/2014
PROJECT NUMBER: ER STP 013-1(17)	DRAWN BY: B. KIPP
FILE NAME: xs.dgn	CHECKED BY: HSD
PROJECT LEADER: K. UPMAL	SHEET 253 OF 444
DESIGNED BY: B. KIPP	
CROSS SECTIONS	