




A 204+00

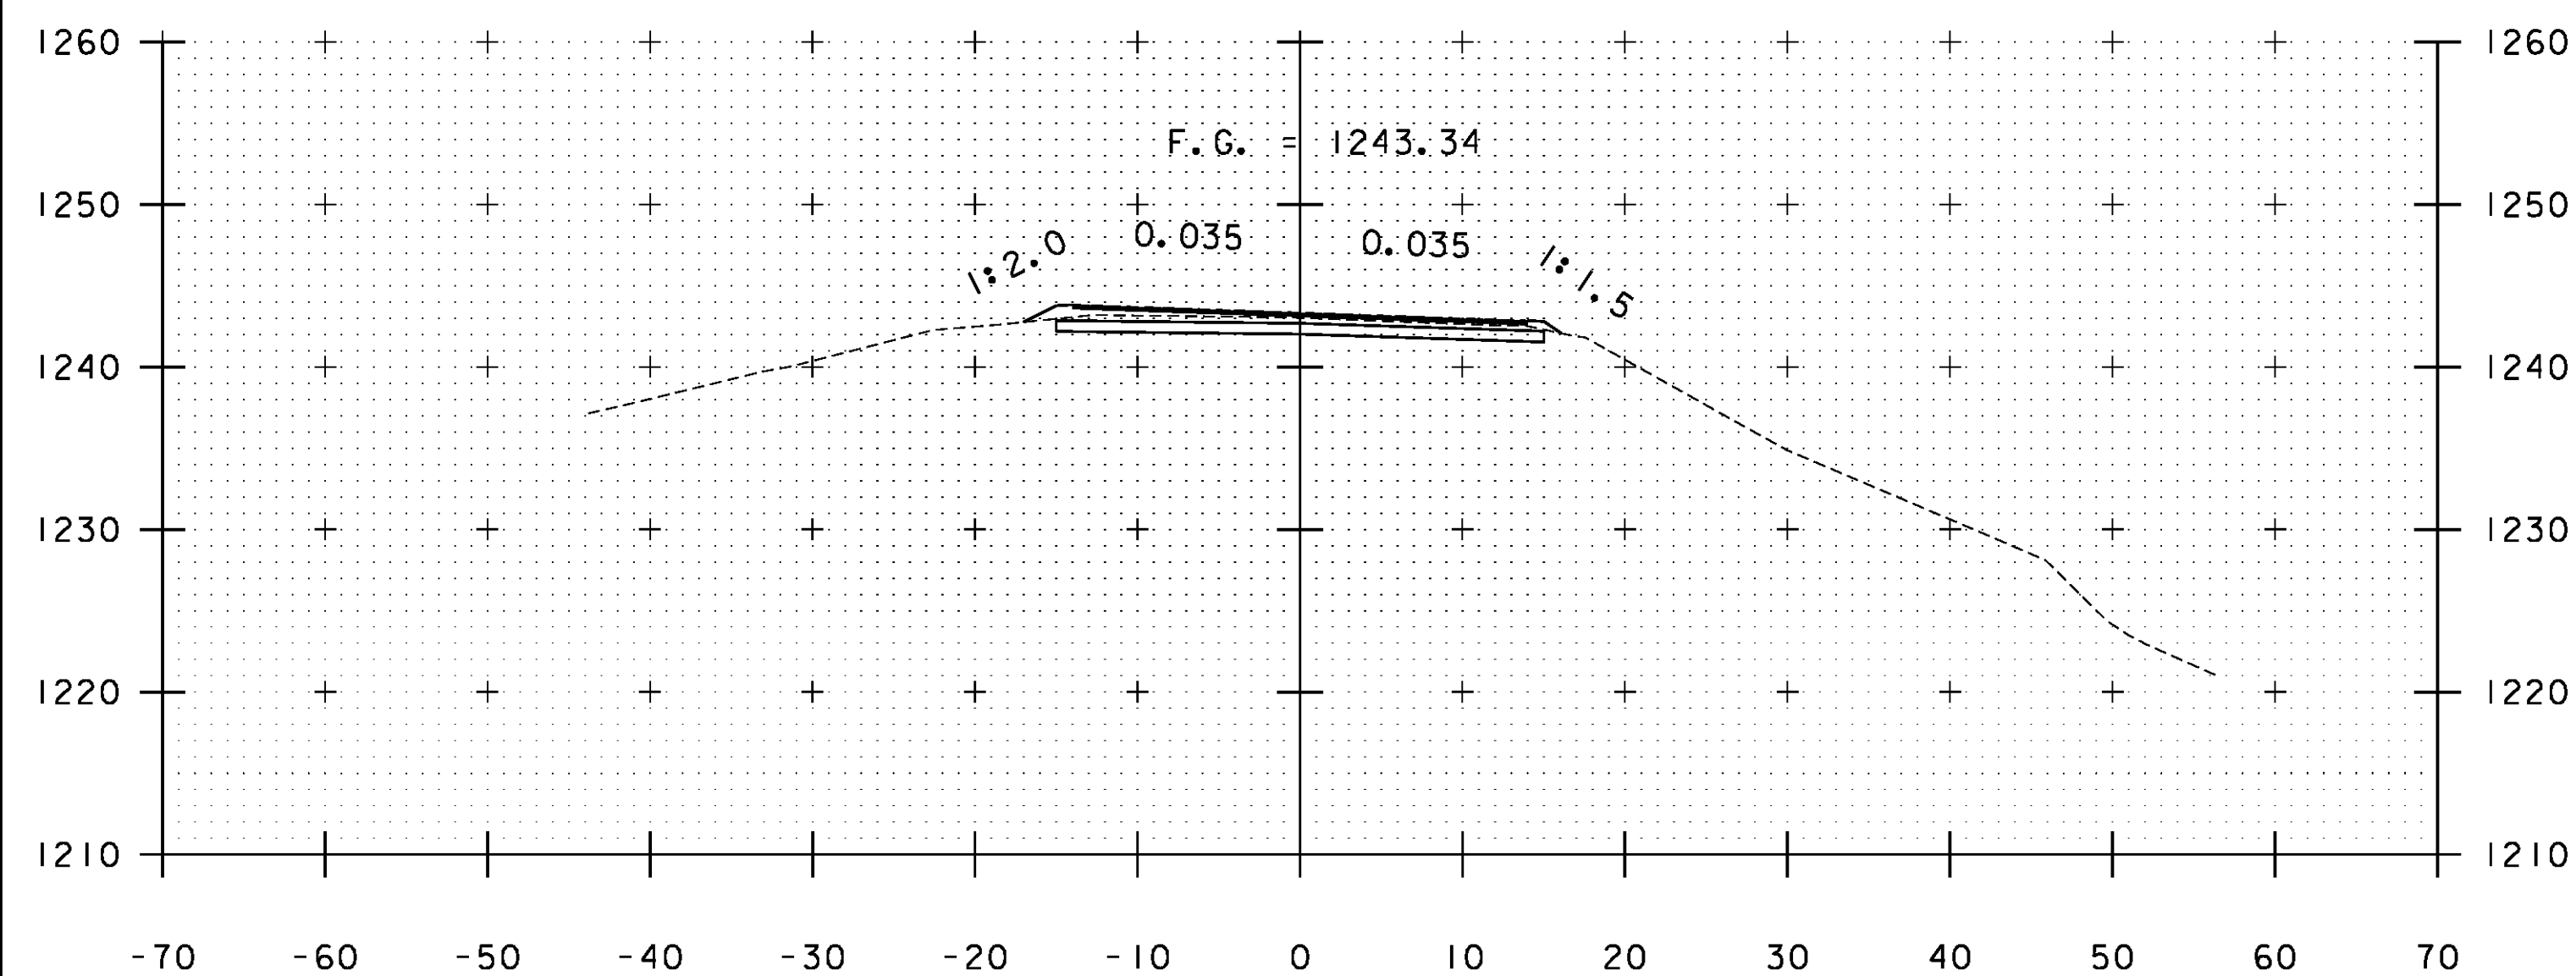

A 203+50

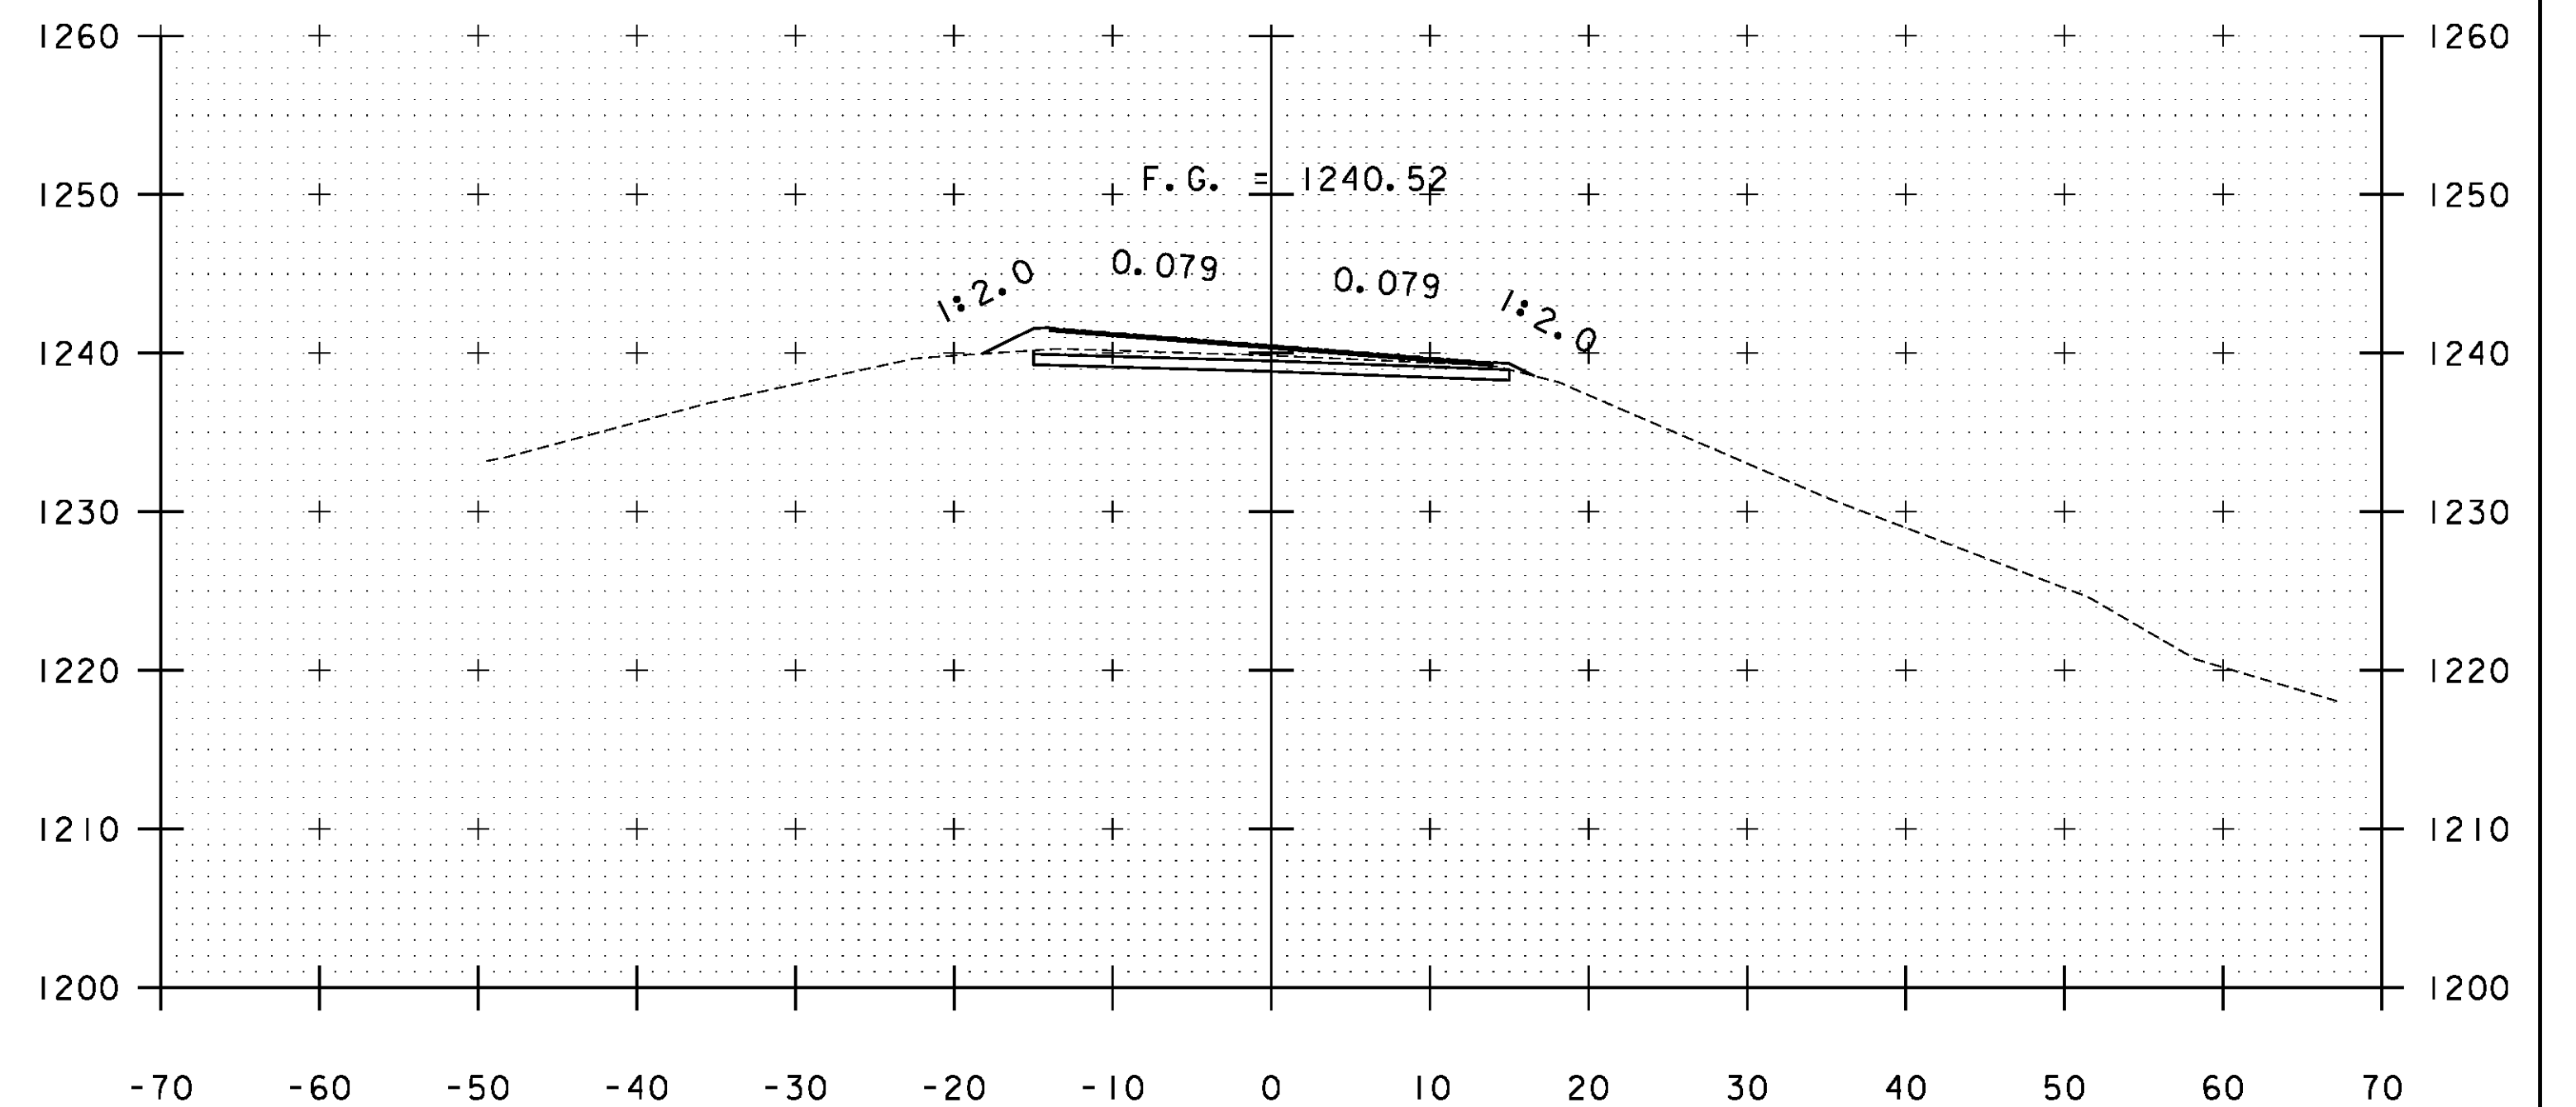

A 205+00

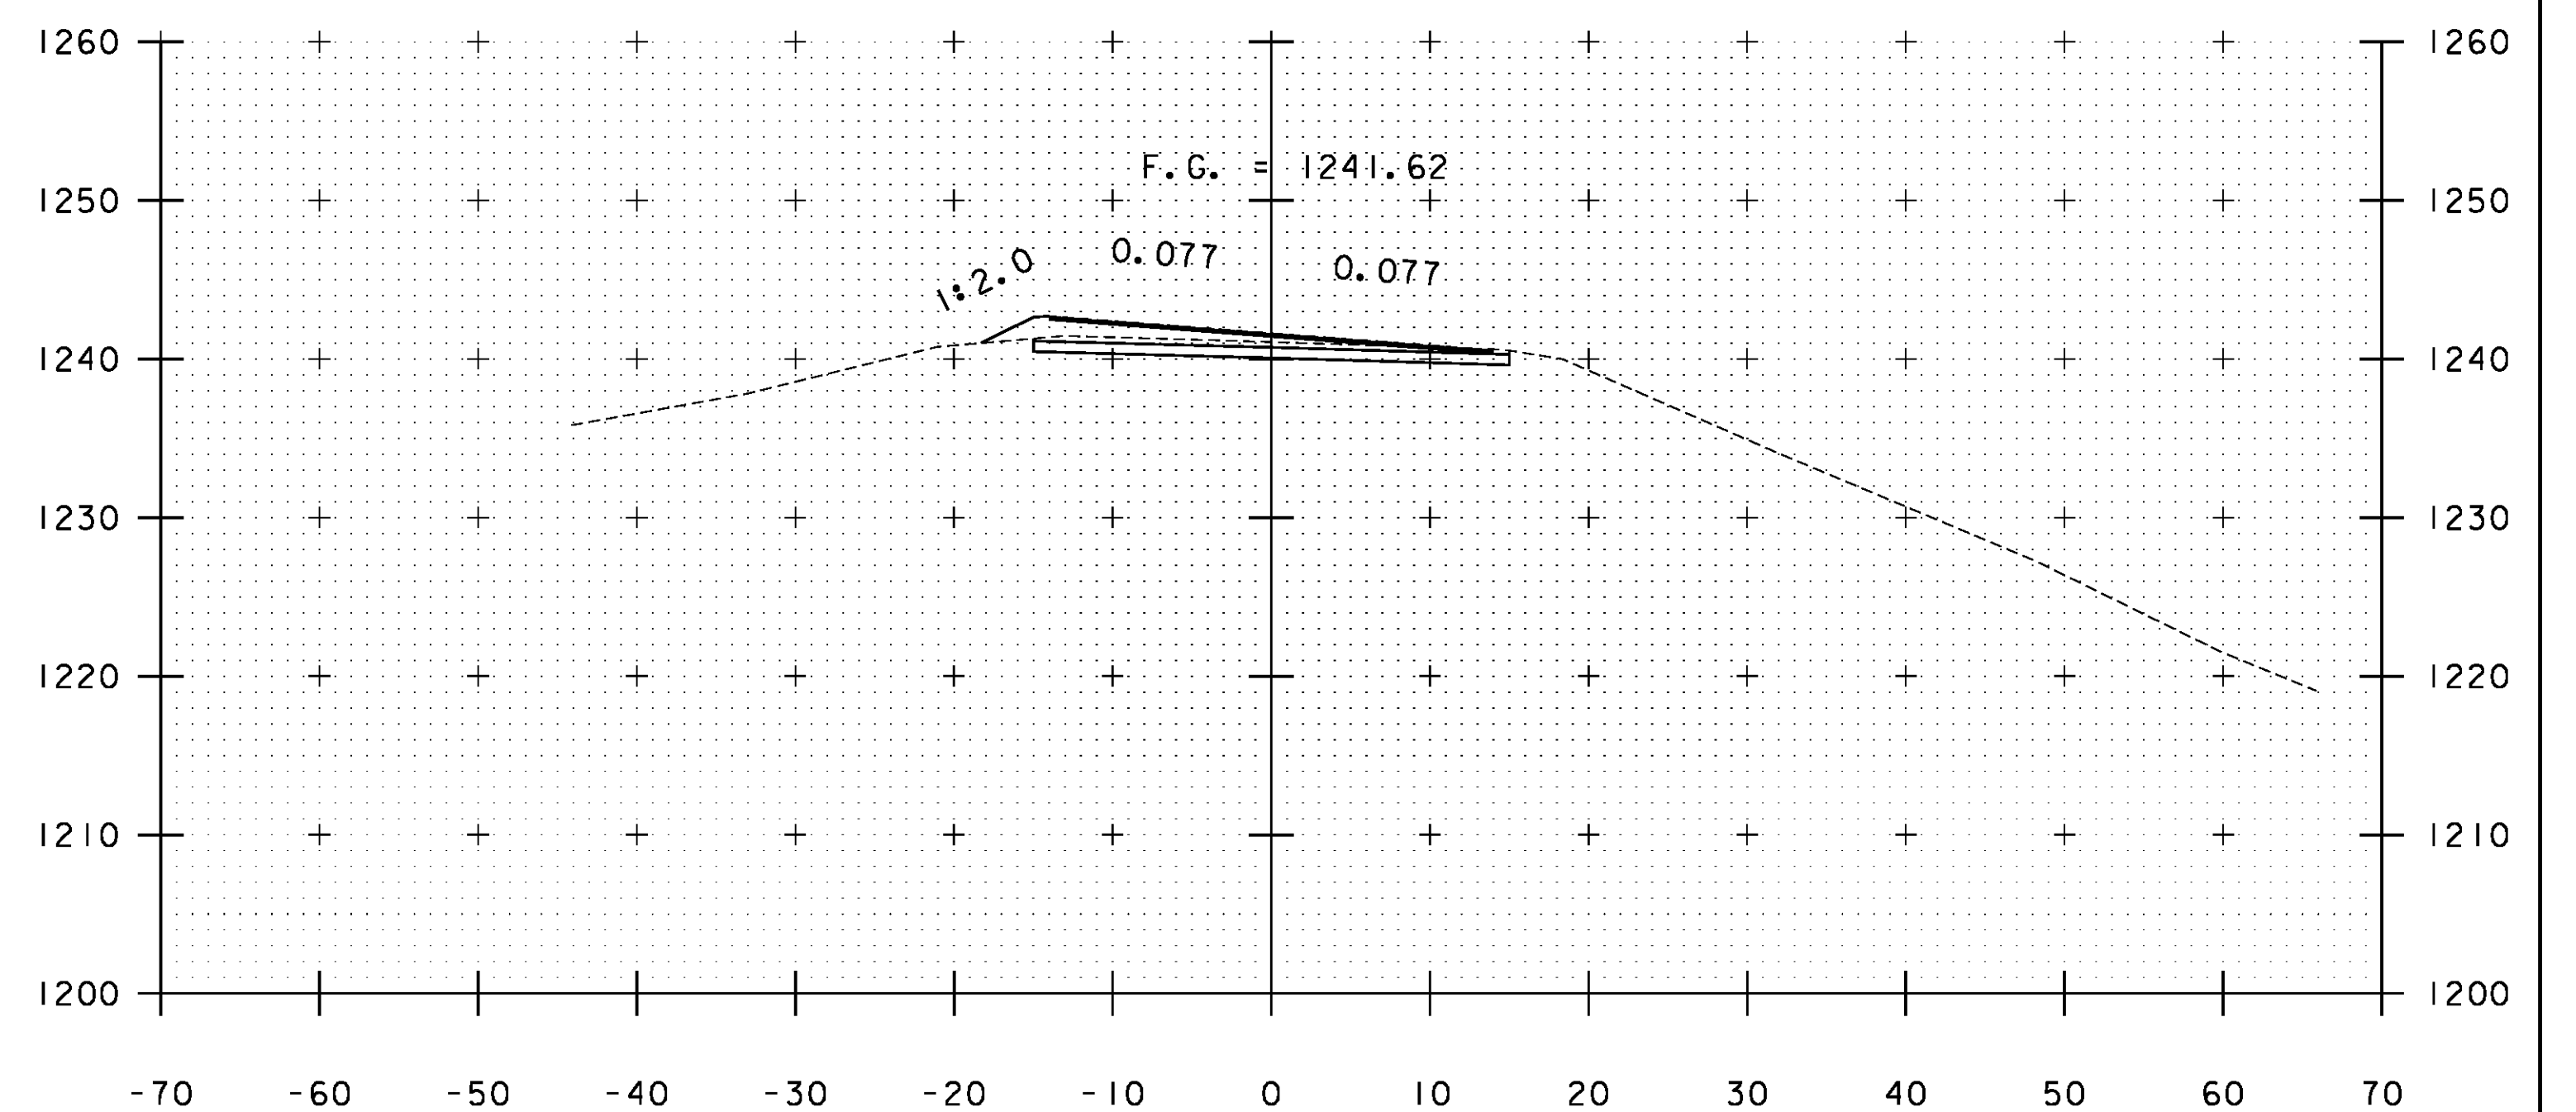

A 204+50

STA. A 203+50 TO STA. A 205+00

PROJECT NAME: WARDSBORO-JAMAICA	PLOT DATE: 2/26/2014
PROJECT NUMBER: ER STP 013-1(17)	DRAWN BY: B. KIPP
FILE NAME: xs.dgn	CHECKED BY: HSD
PROJECT LEADER: K. UPMAL	SHEET 254 OF 444
DESIGNED BY: B. KIPP	
CROSS SECTIONS	