




A 213+00

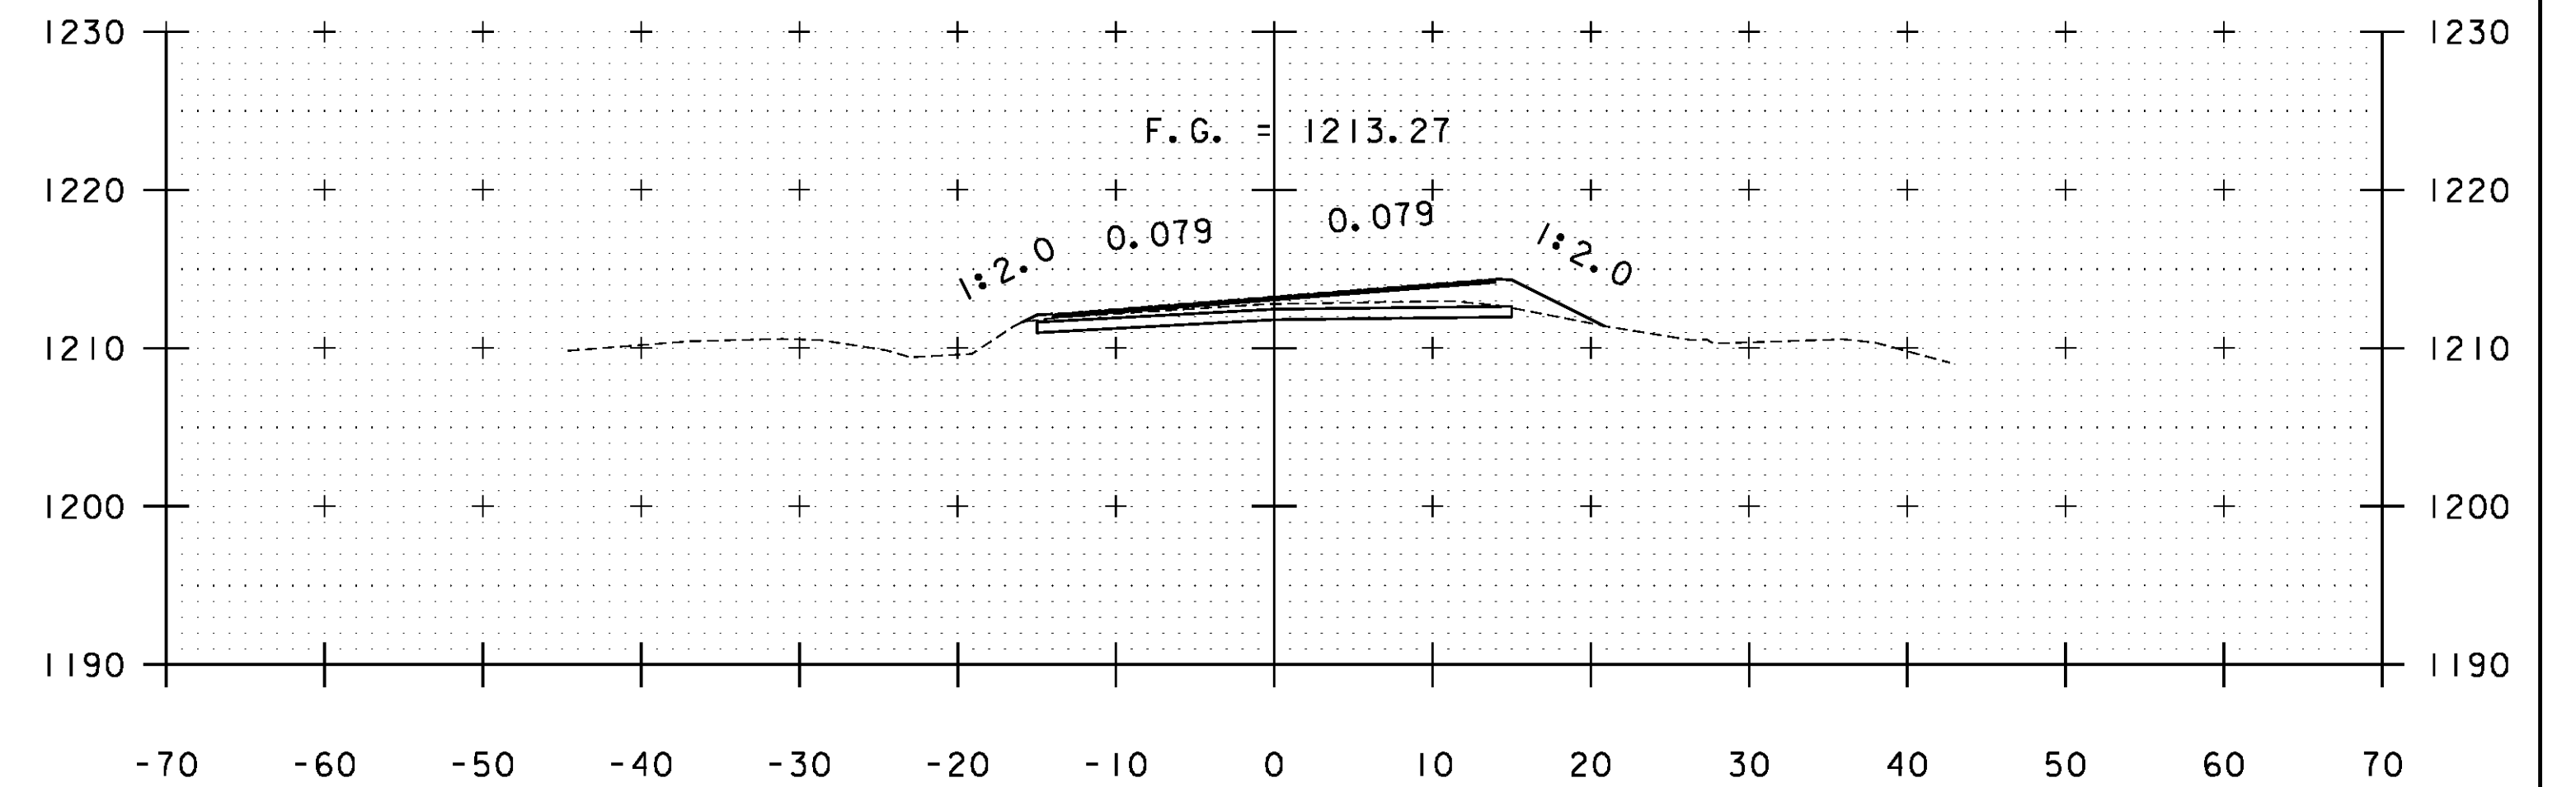


A 214+50

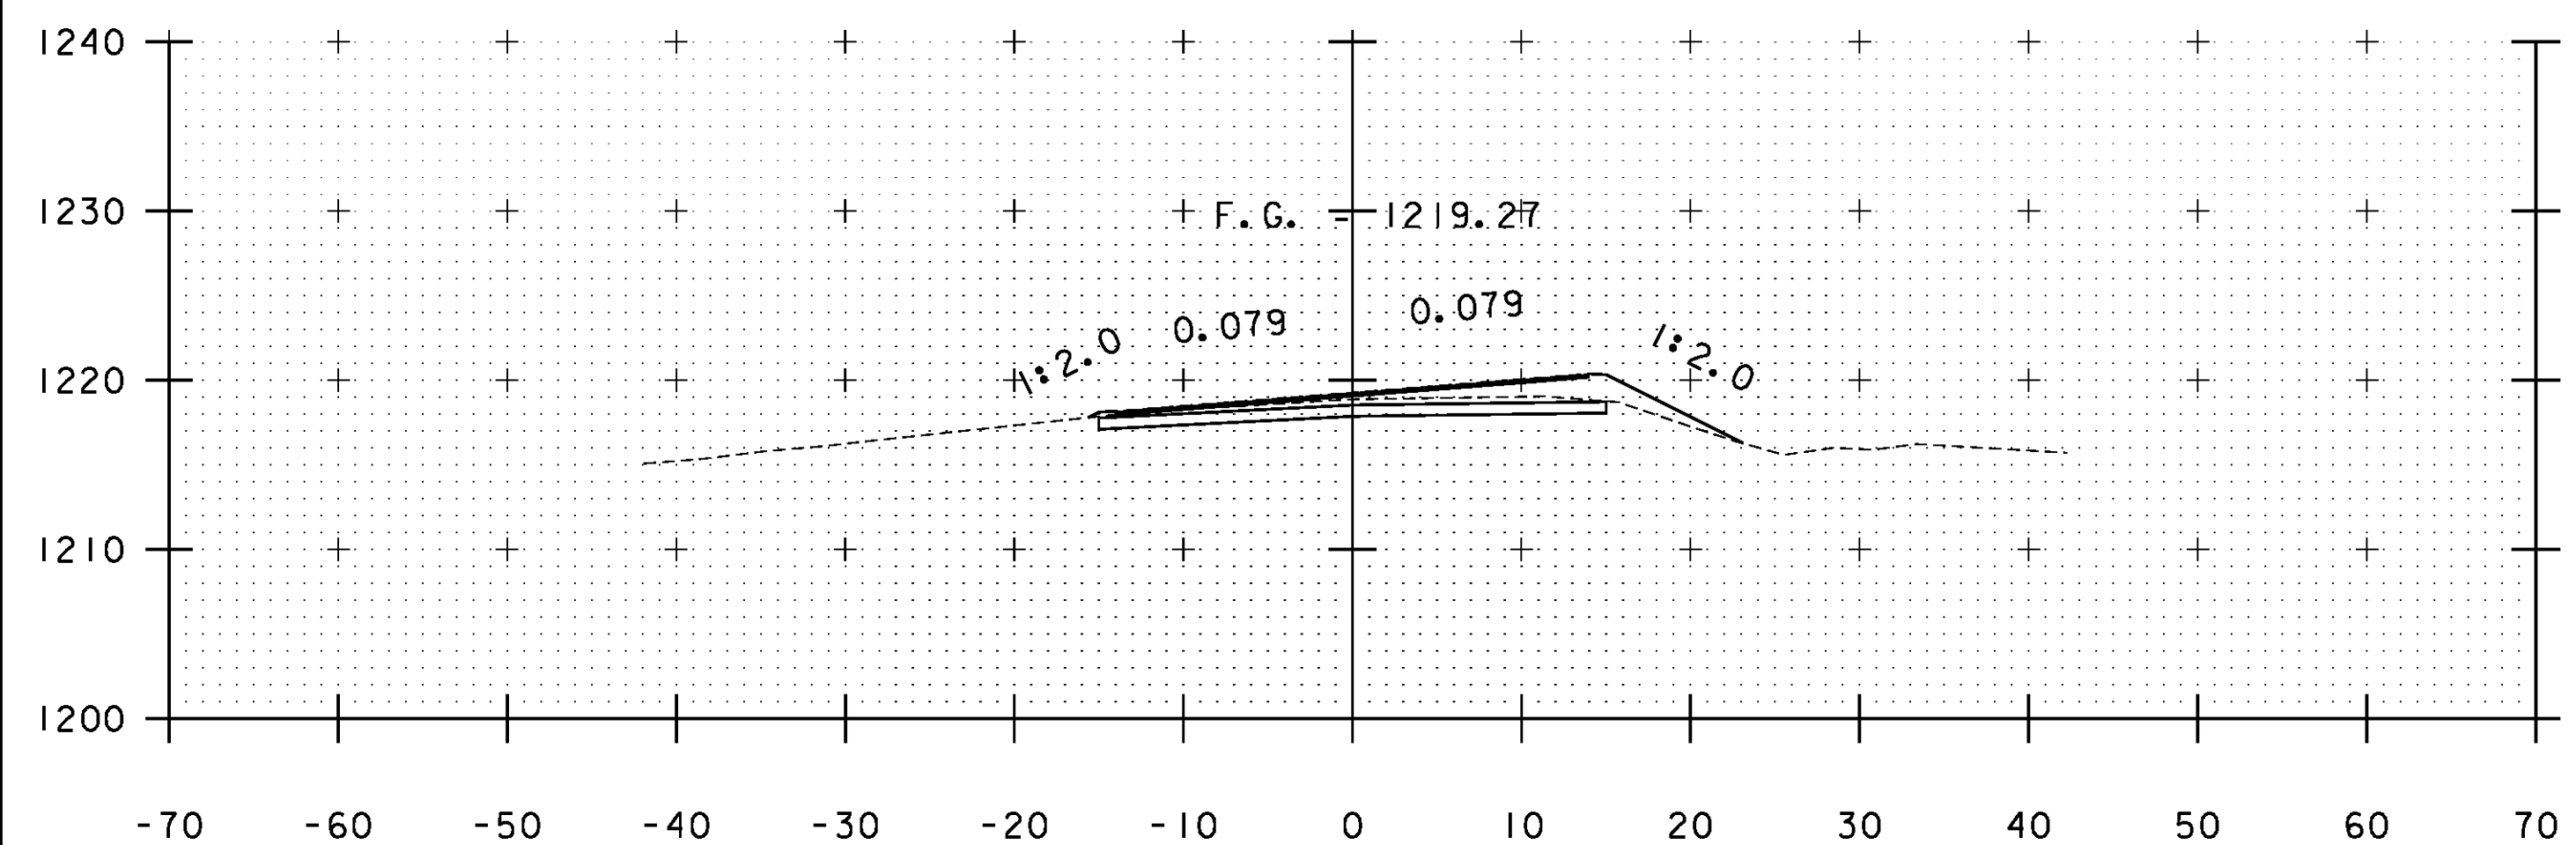


A 212+50

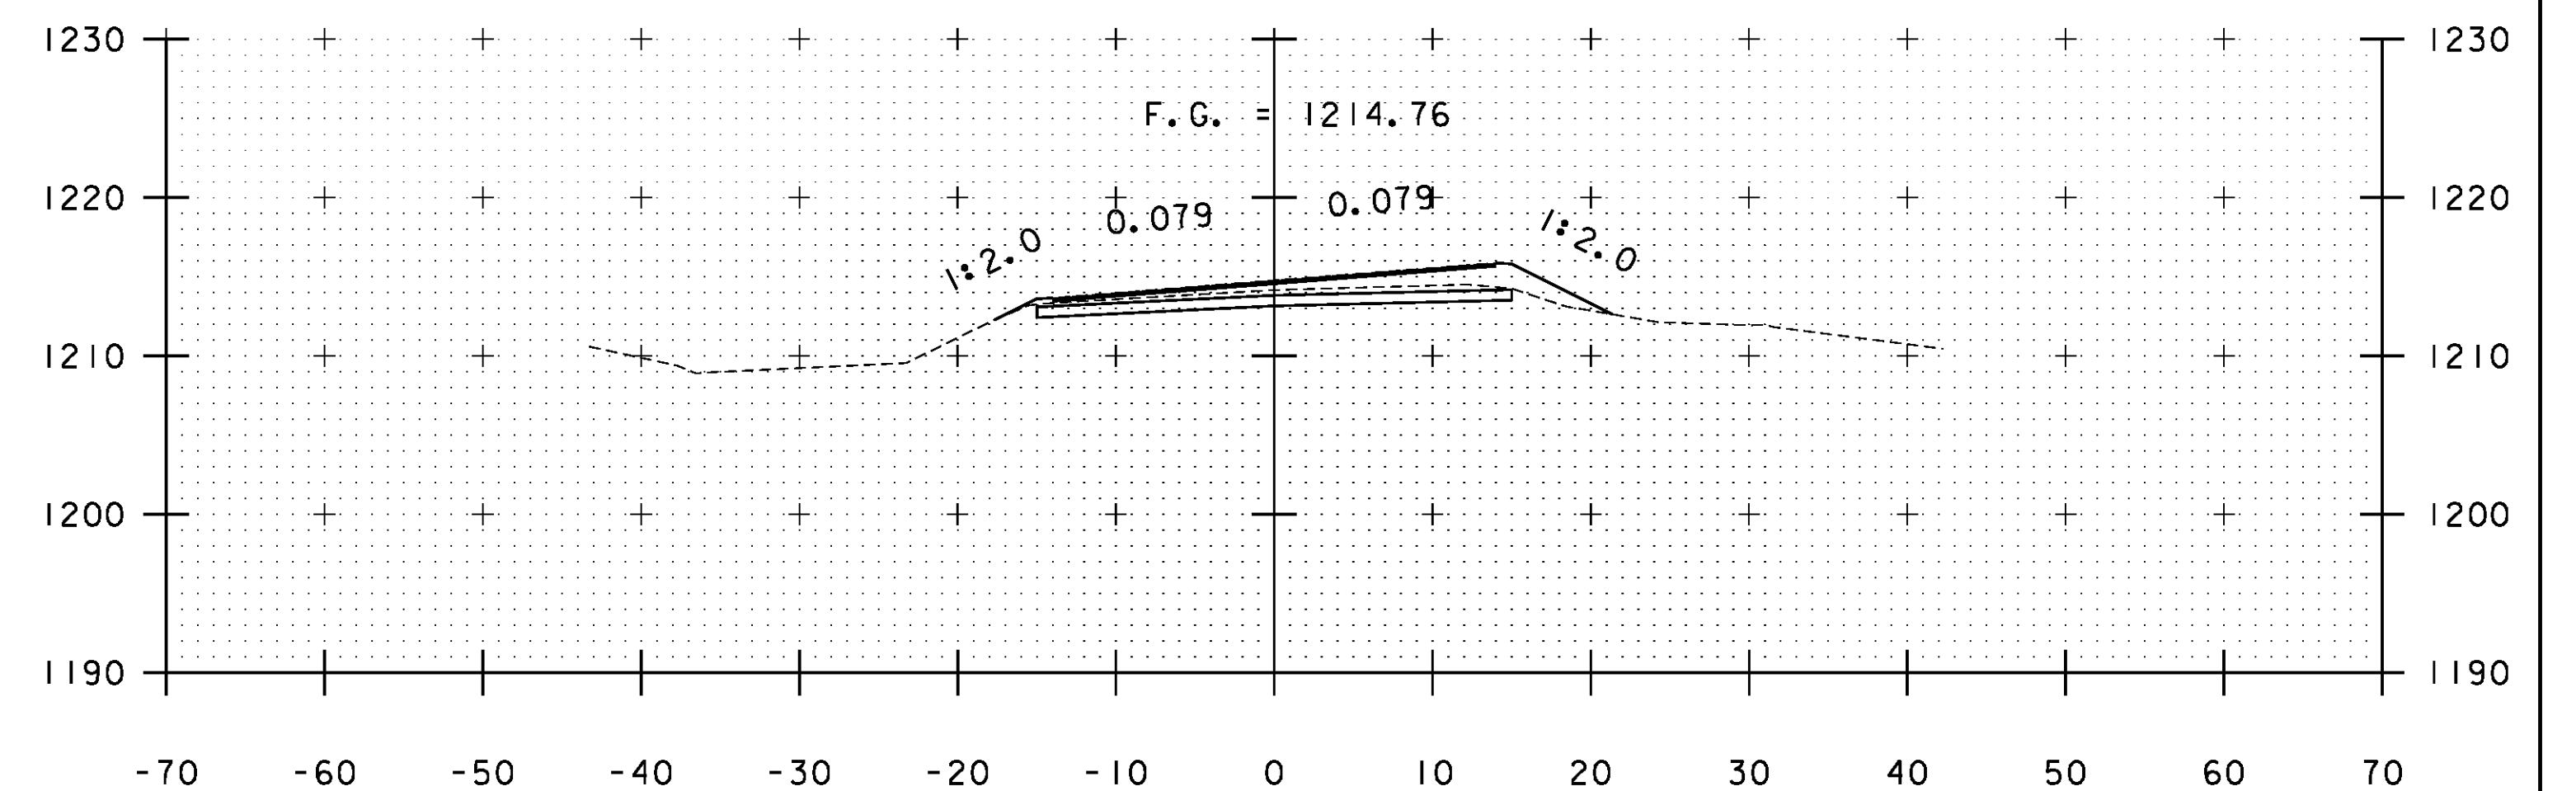

A 214+00

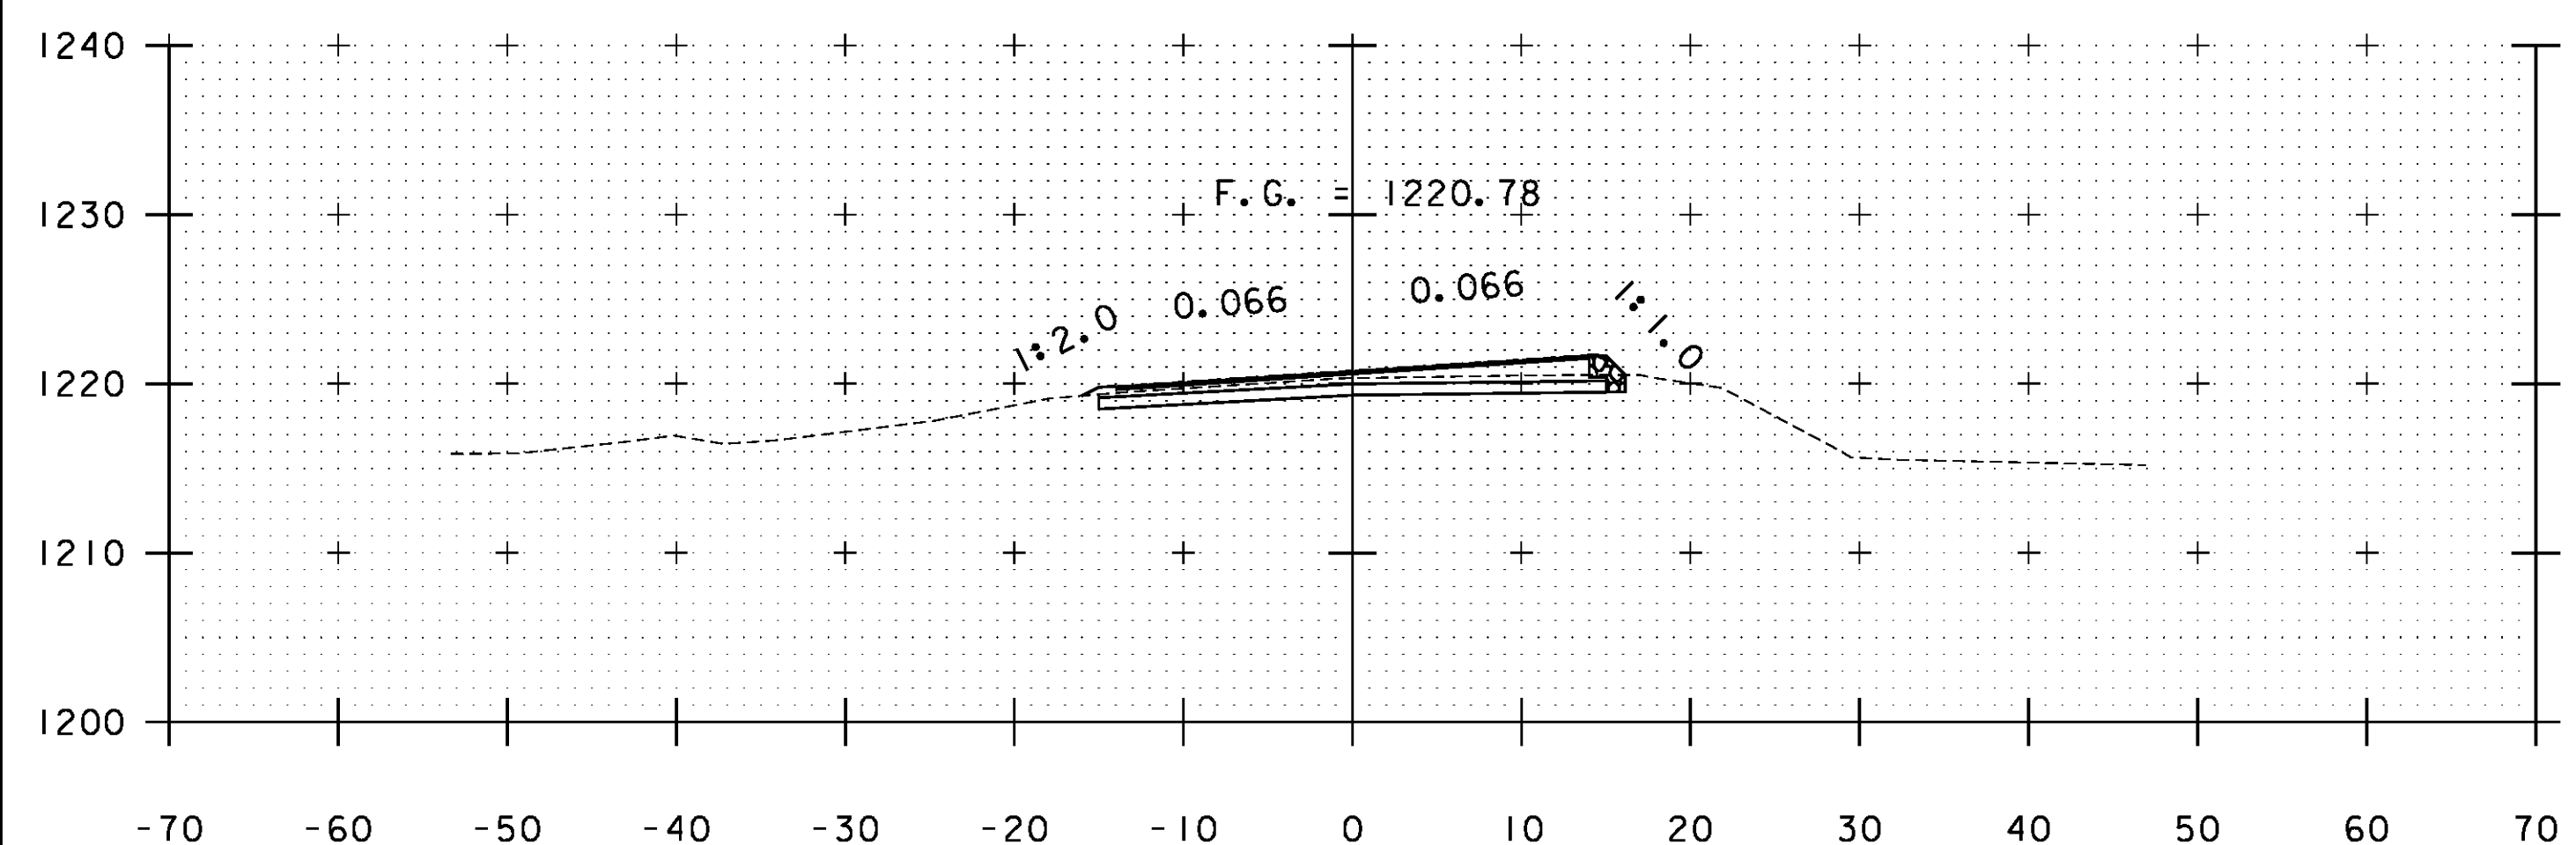

A 212+00

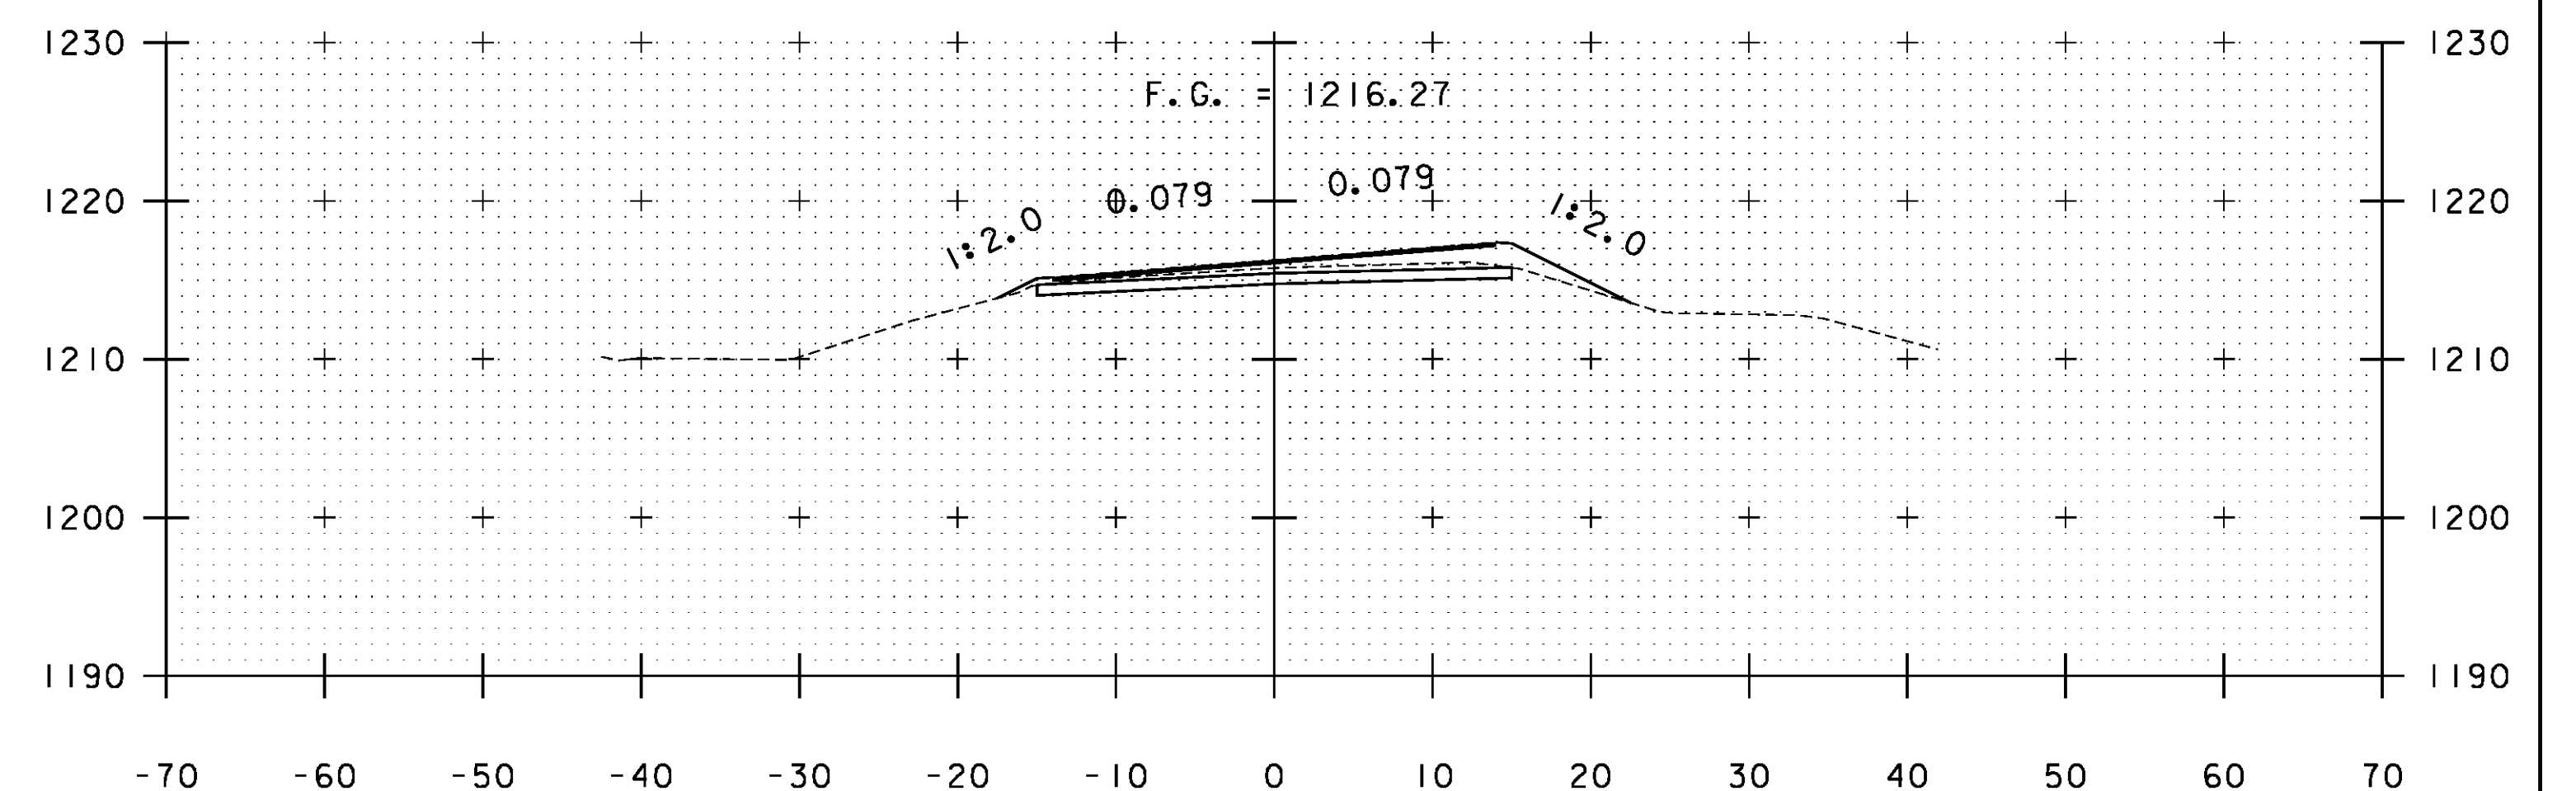

A 213+50

STA. A 212+00 TO STA. A 214+50

PROJECT NAME: WARDBORO-JAMAICA	
PROJECT NUMBER: ER STP 013-1(17)	
FILE NAME: xs.dgn	PLOT DATE: 2/26/2014
PROJECT LEADER: K. UPMAL	DRAWN BY: B. KIPP
DESIGNED BY: B. KIPP	CHECKED BY: HSD
CROSS SECTIONS	SHEET 258 OF 444