




A 218+50

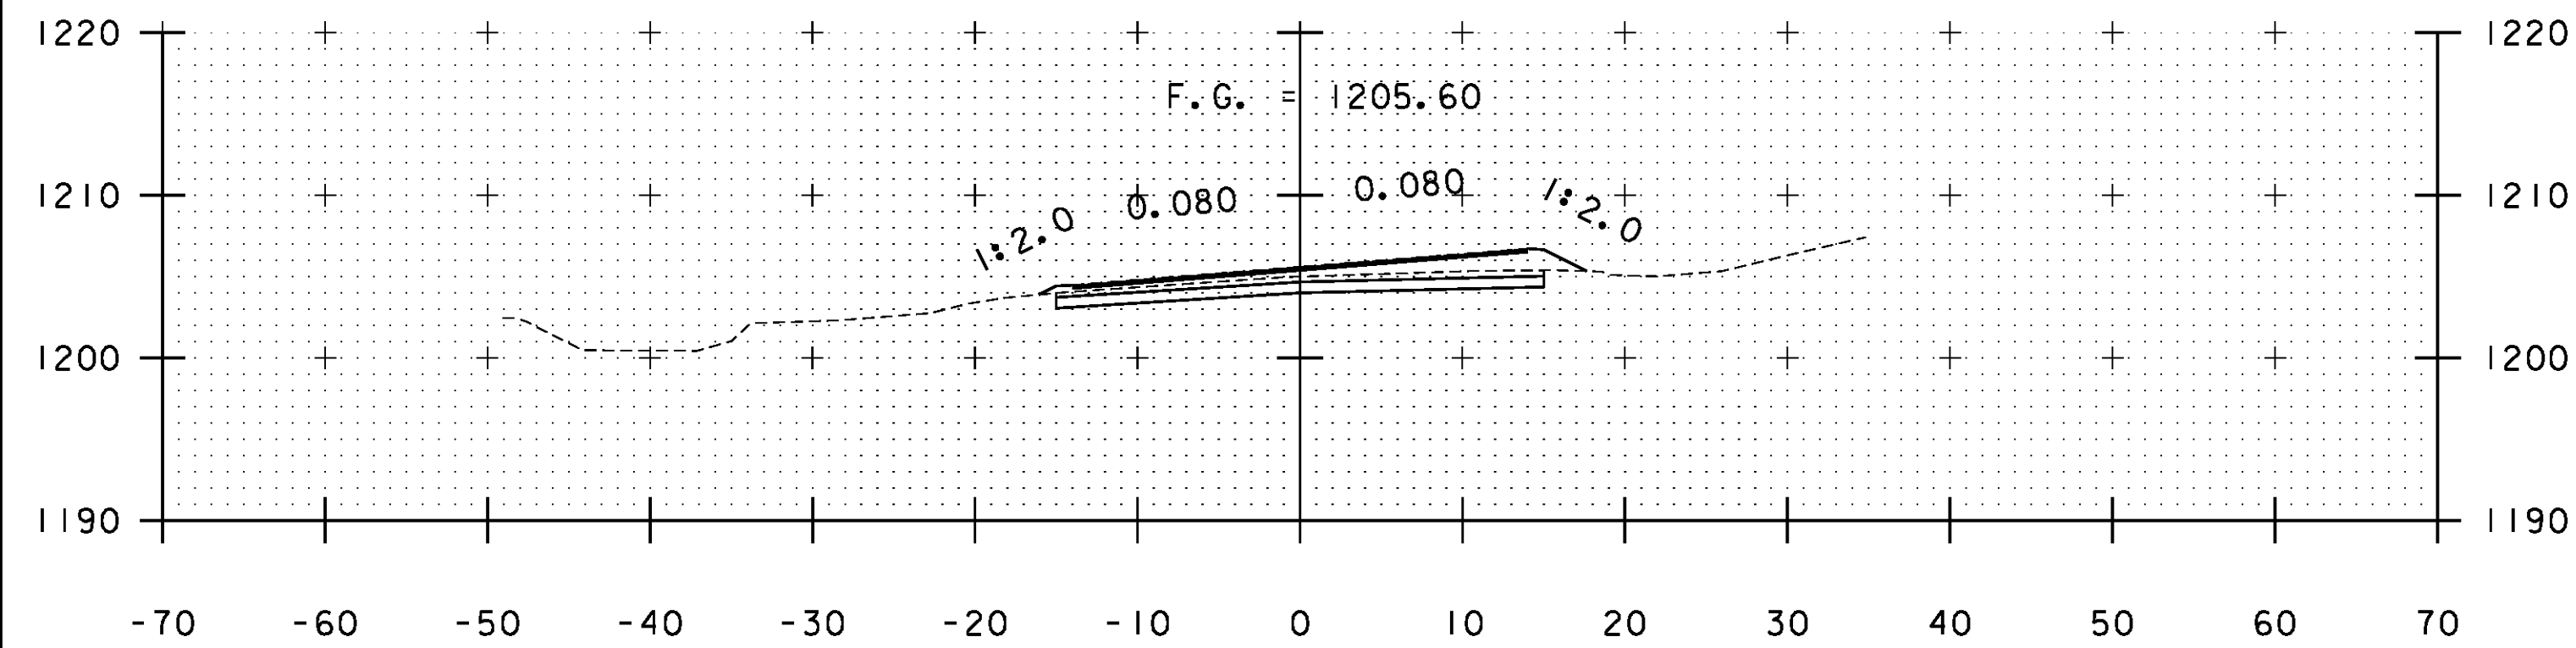


A 218+00

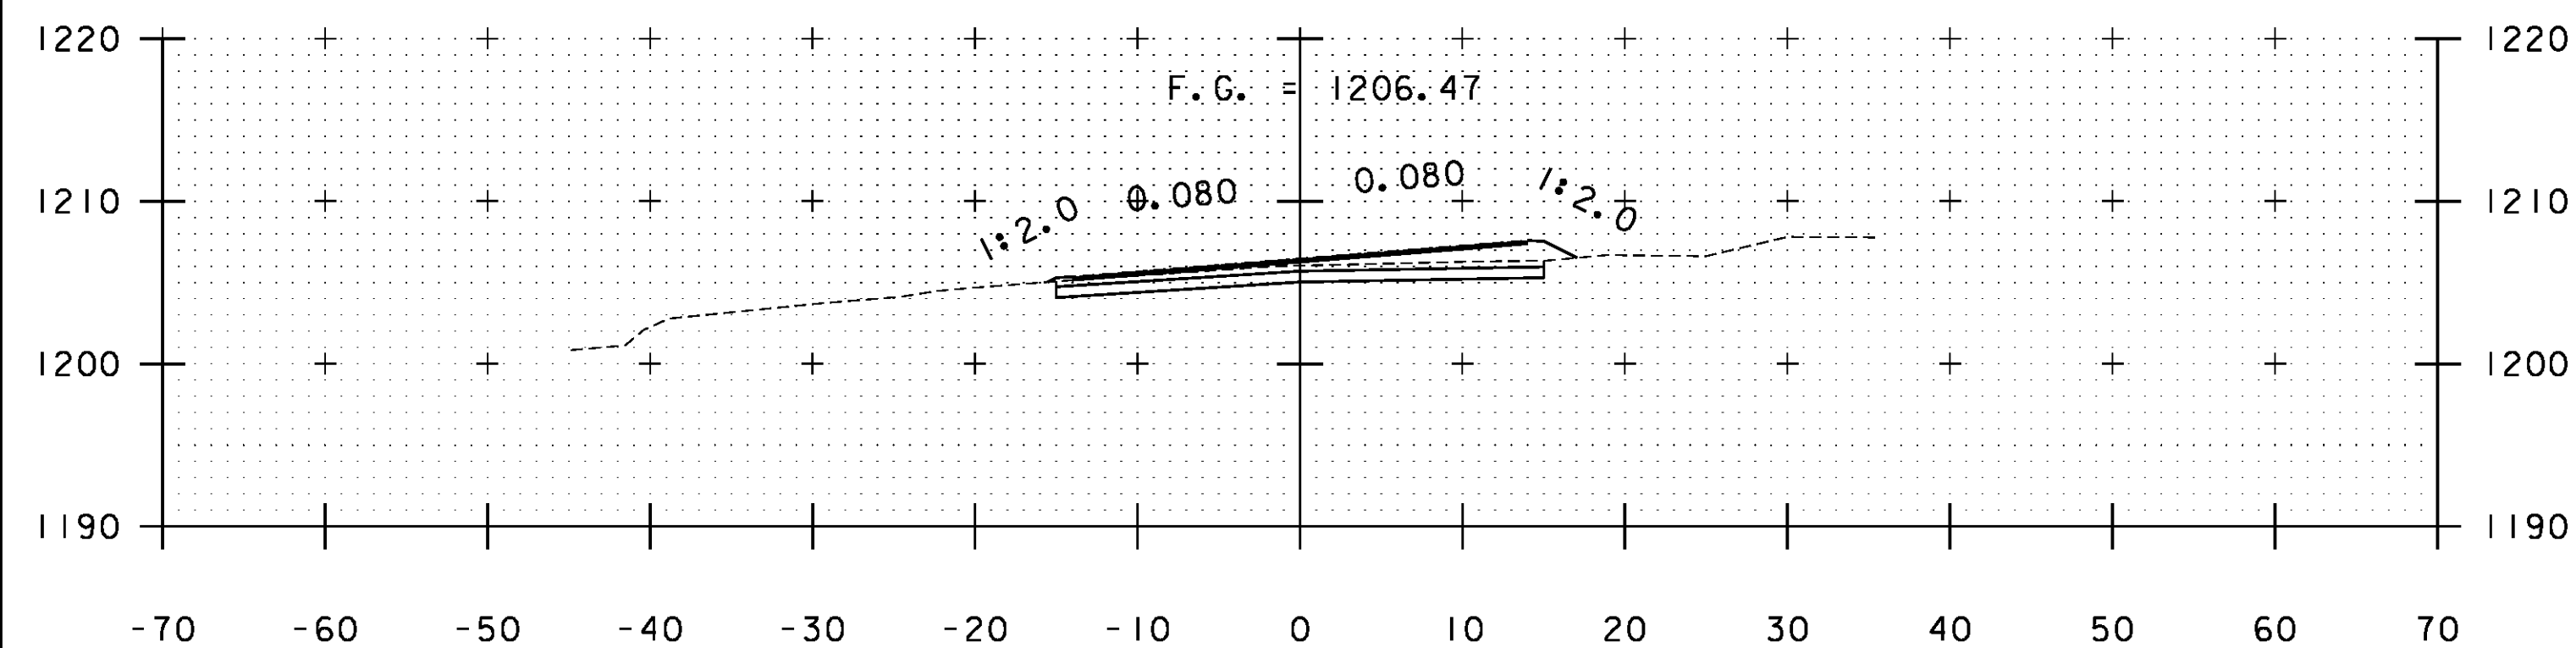


A 217+50

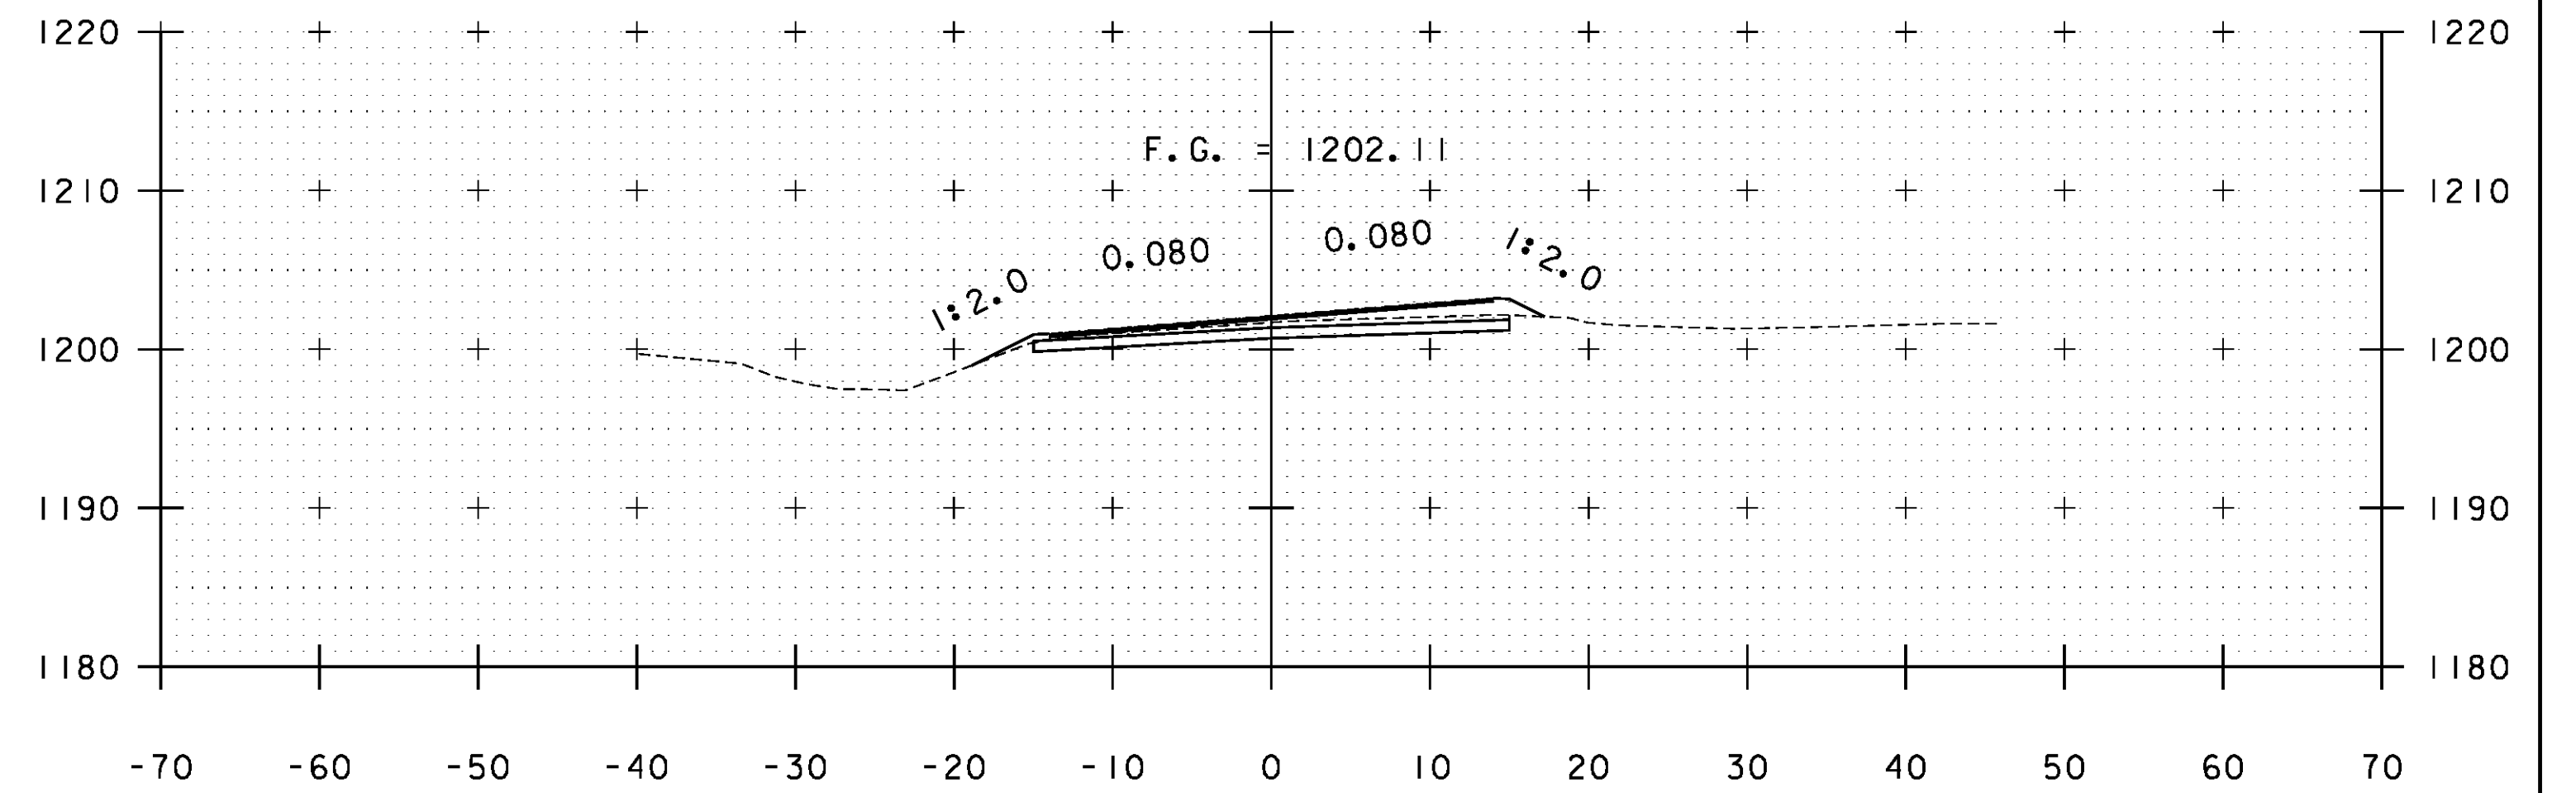

A 220+00

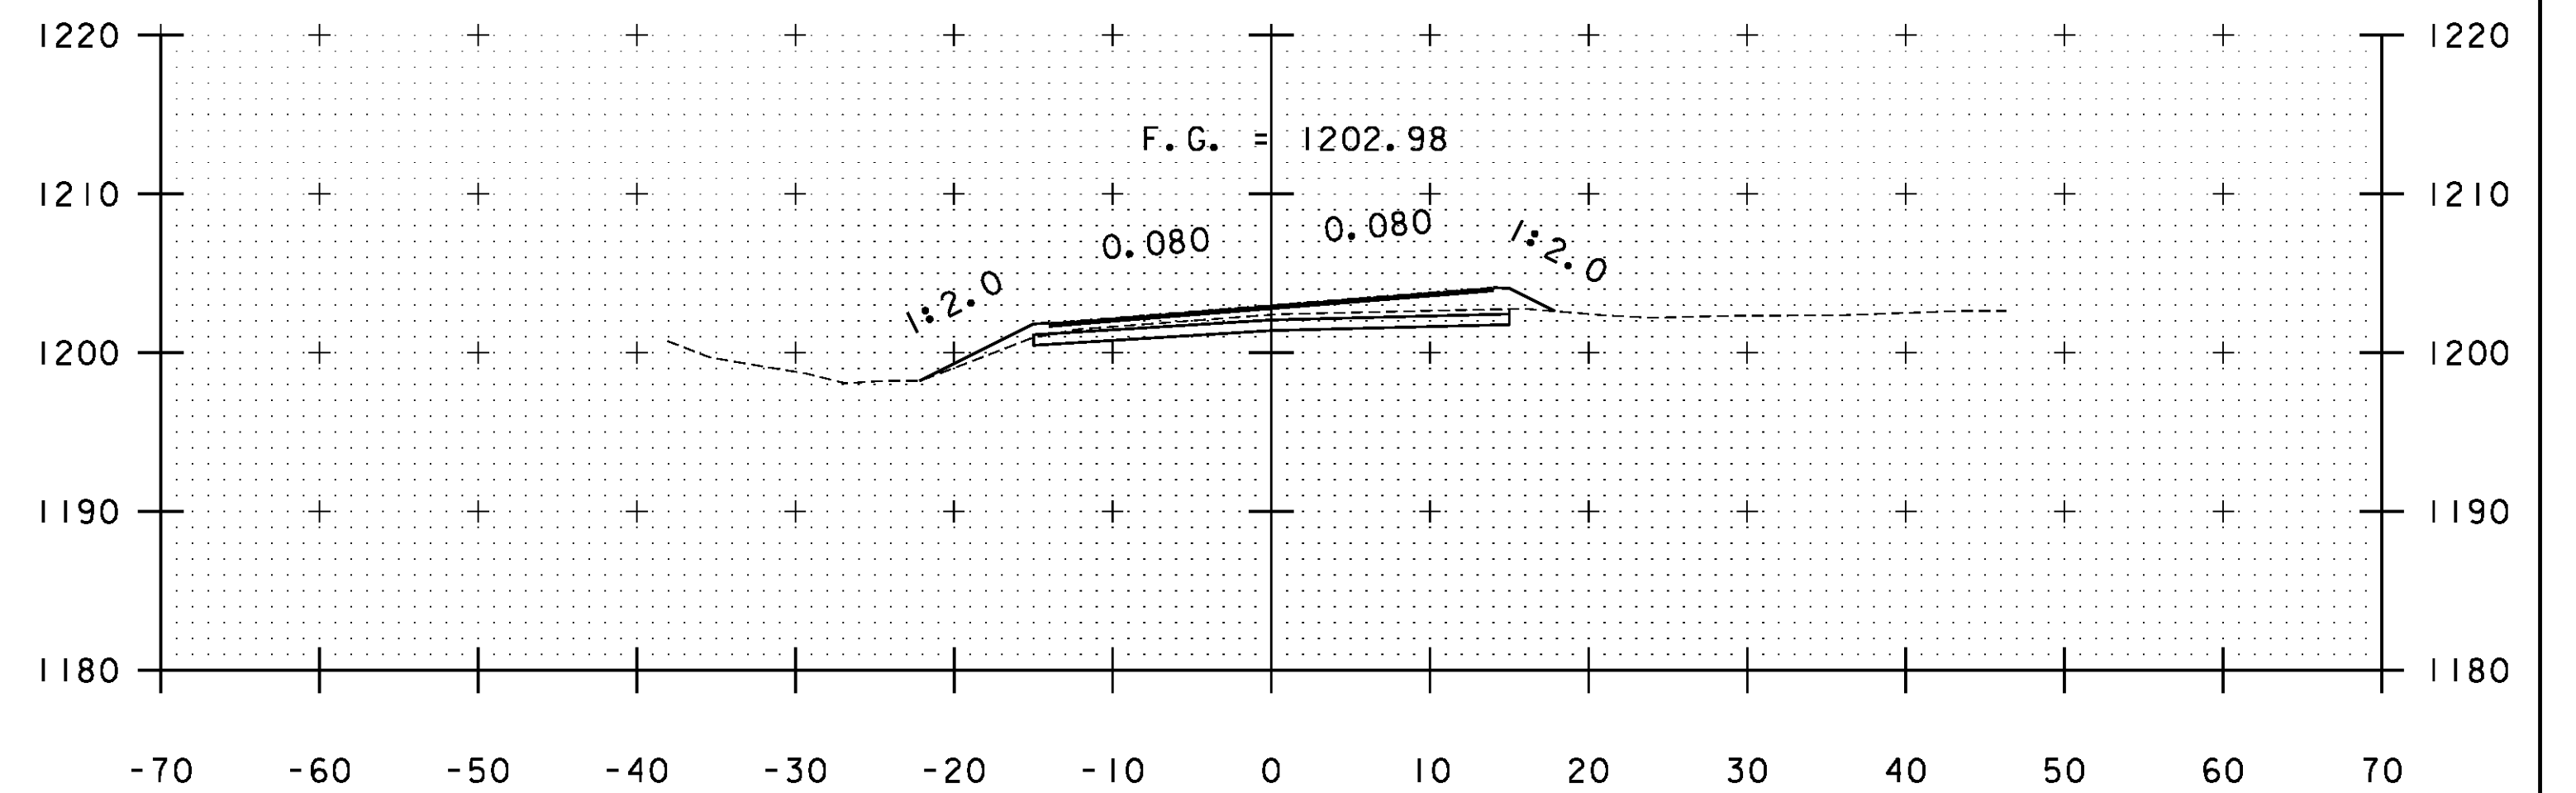

A 219+50

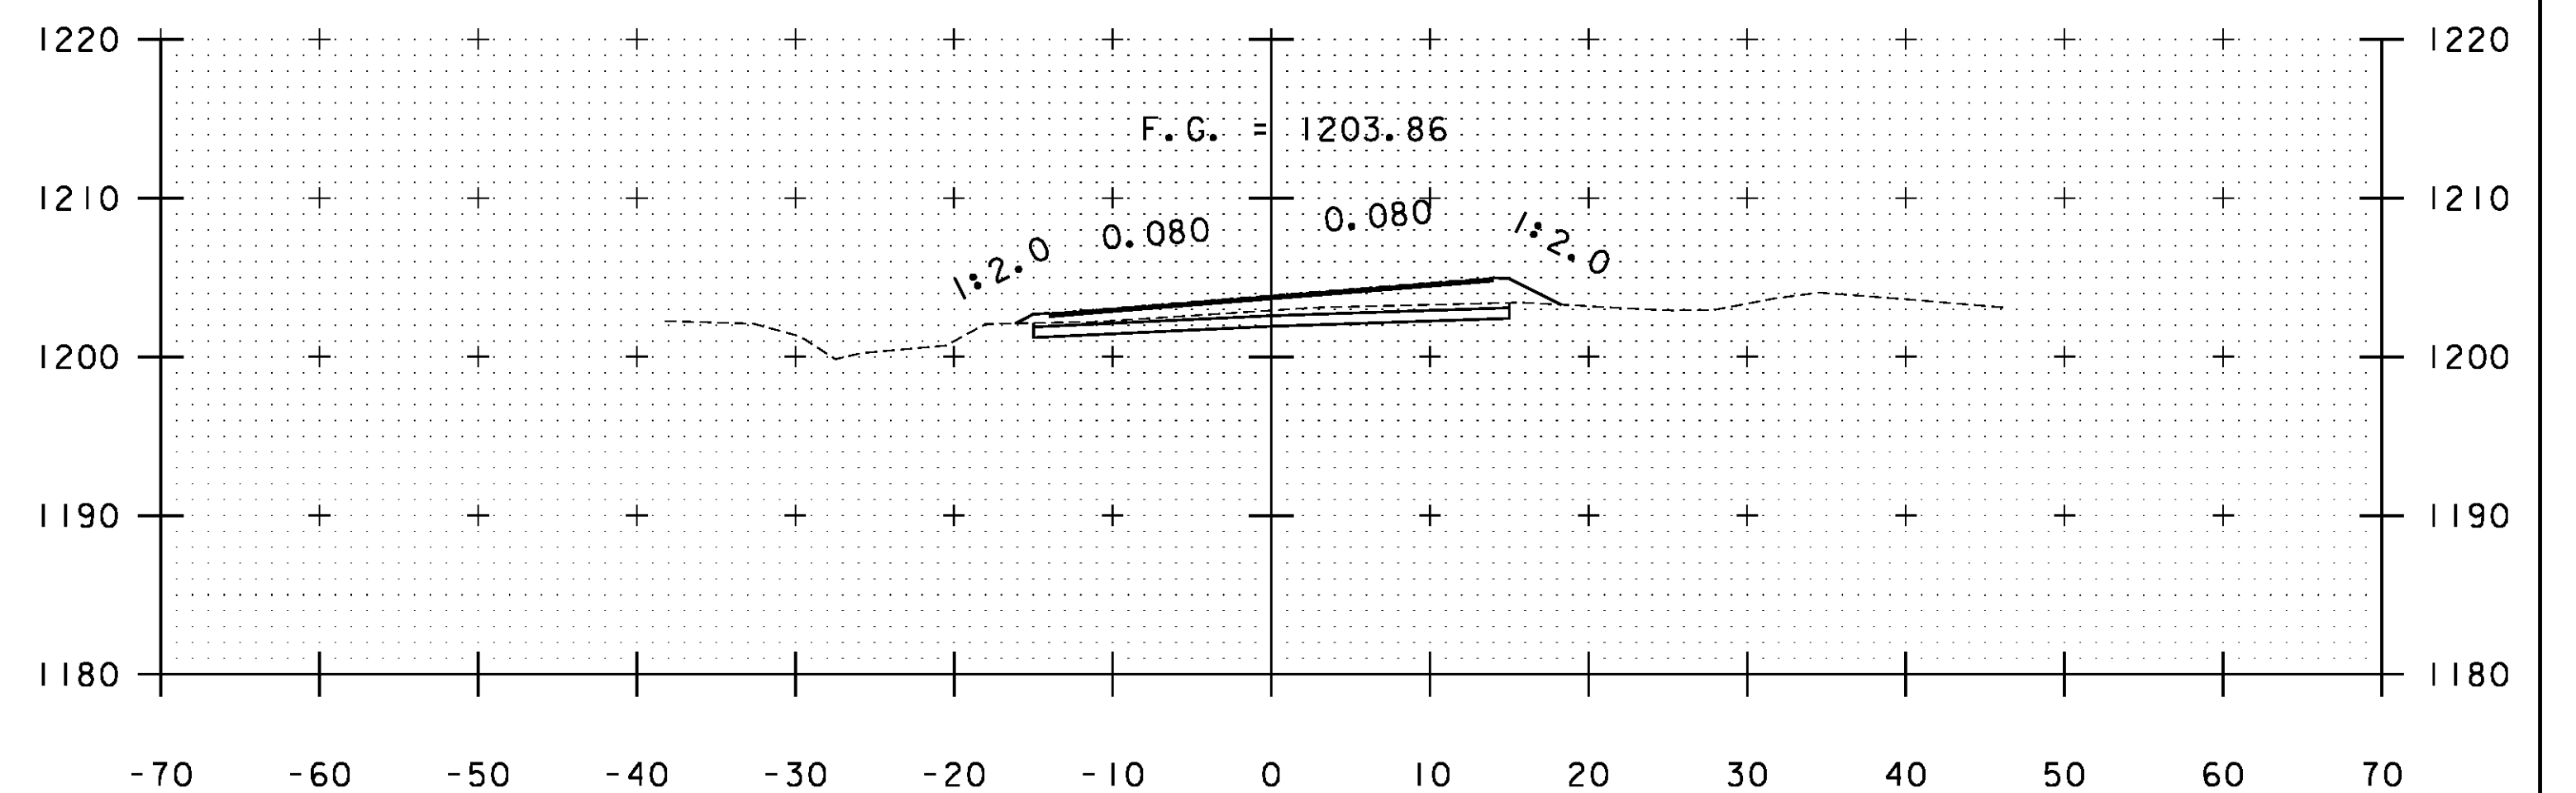

A 219+00

STA. A 217+50 TO STA. A 220+00

PROJECT NAME: WARDBORO-JAMAICA	PLOT DATE: 2/26/2014
PROJECT NUMBER: ER STP 013-1(17)	DRAWN BY: B. KIPP
FILE NAME: xs.dgn	CHECKED BY: HSD
PROJECT LEADER: K. UPMAL	SHEET 260 OF 444
DESIGNED BY: B. KIPP	
CROSS SECTIONS	