




A 224+00

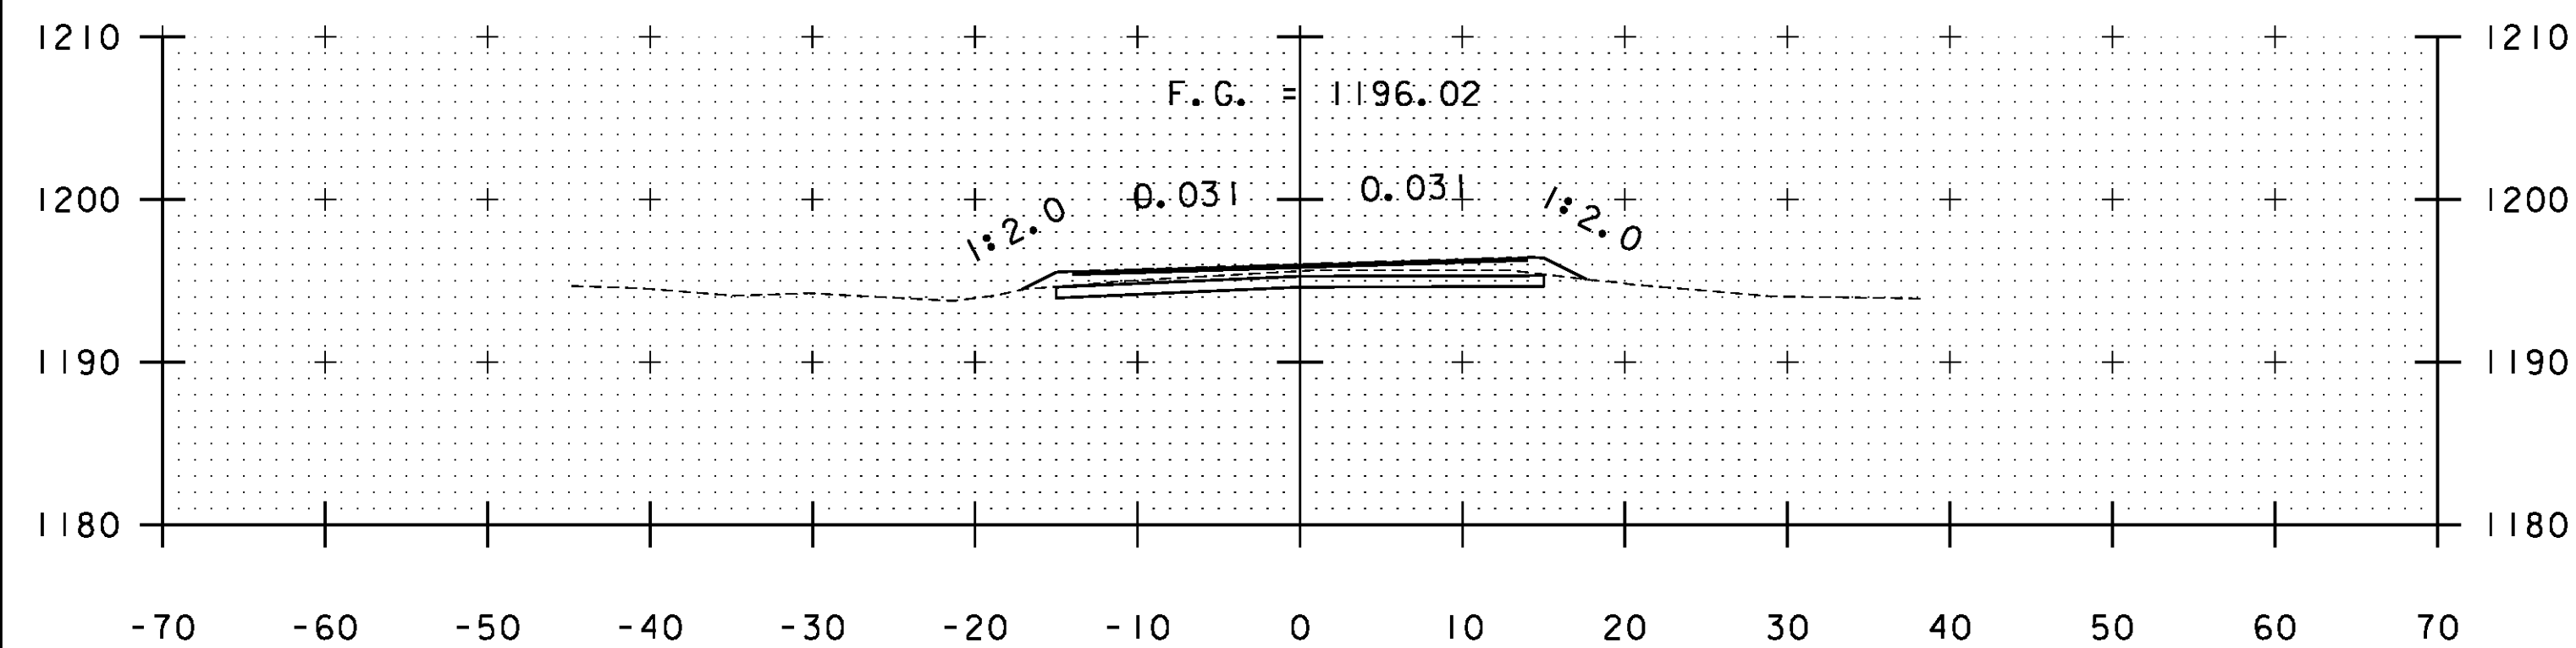


A 223+50

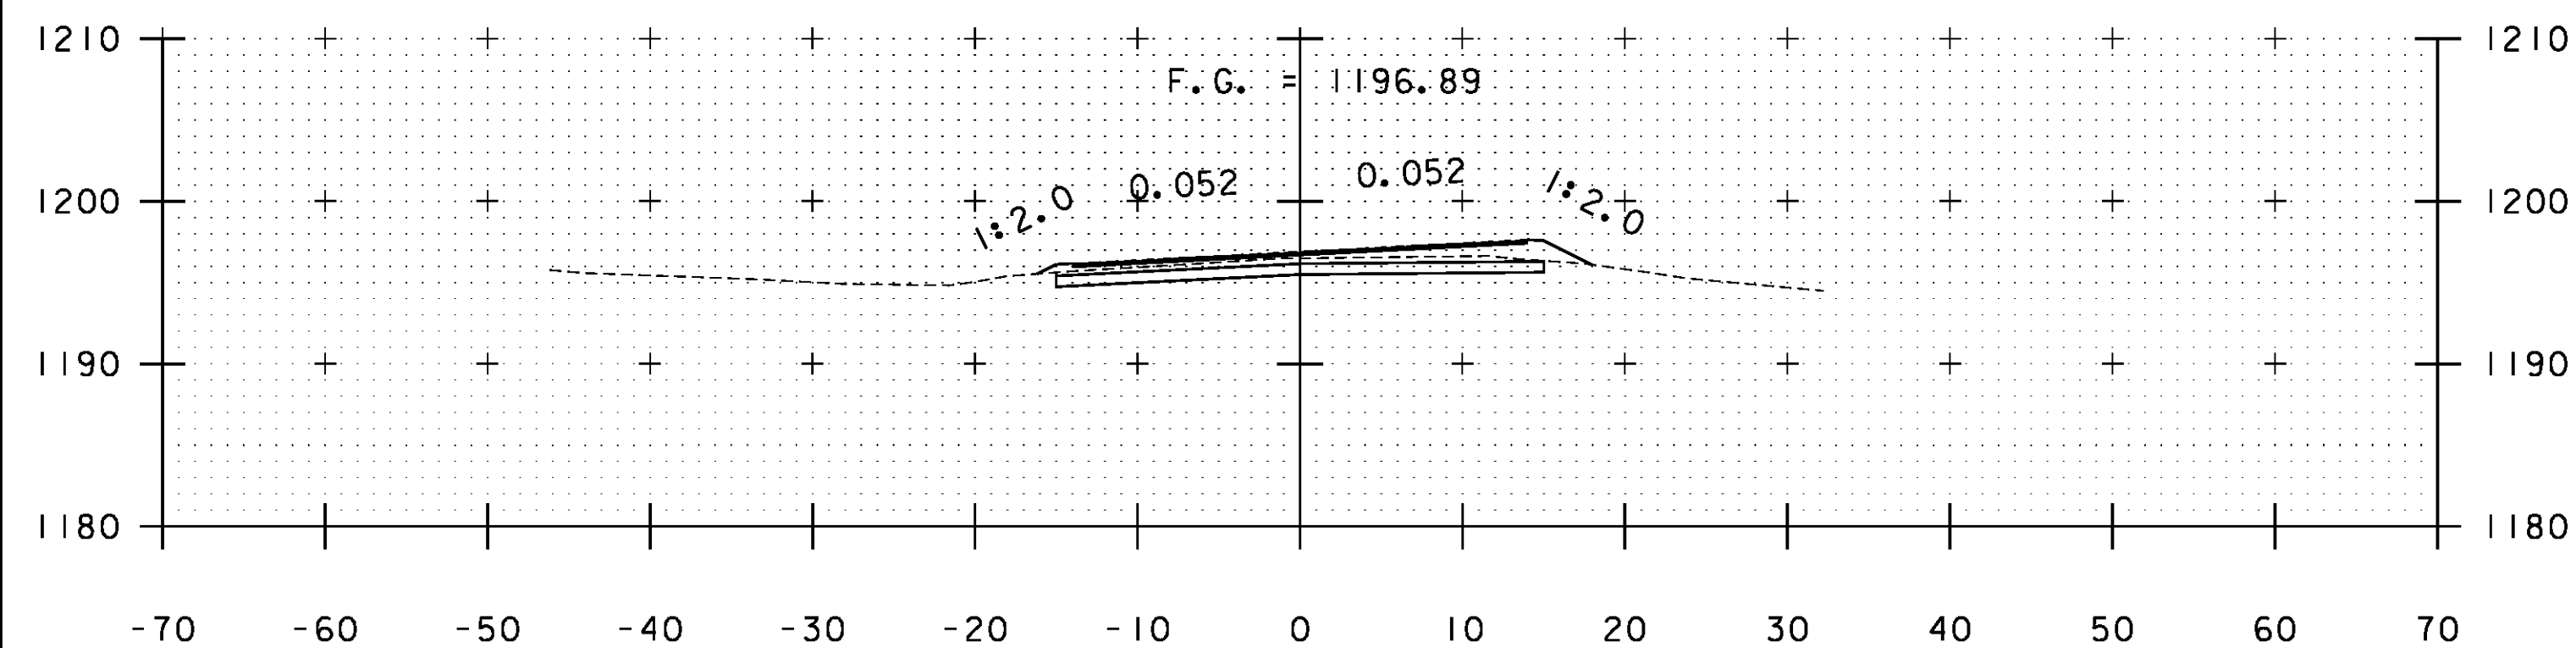


A 223+00

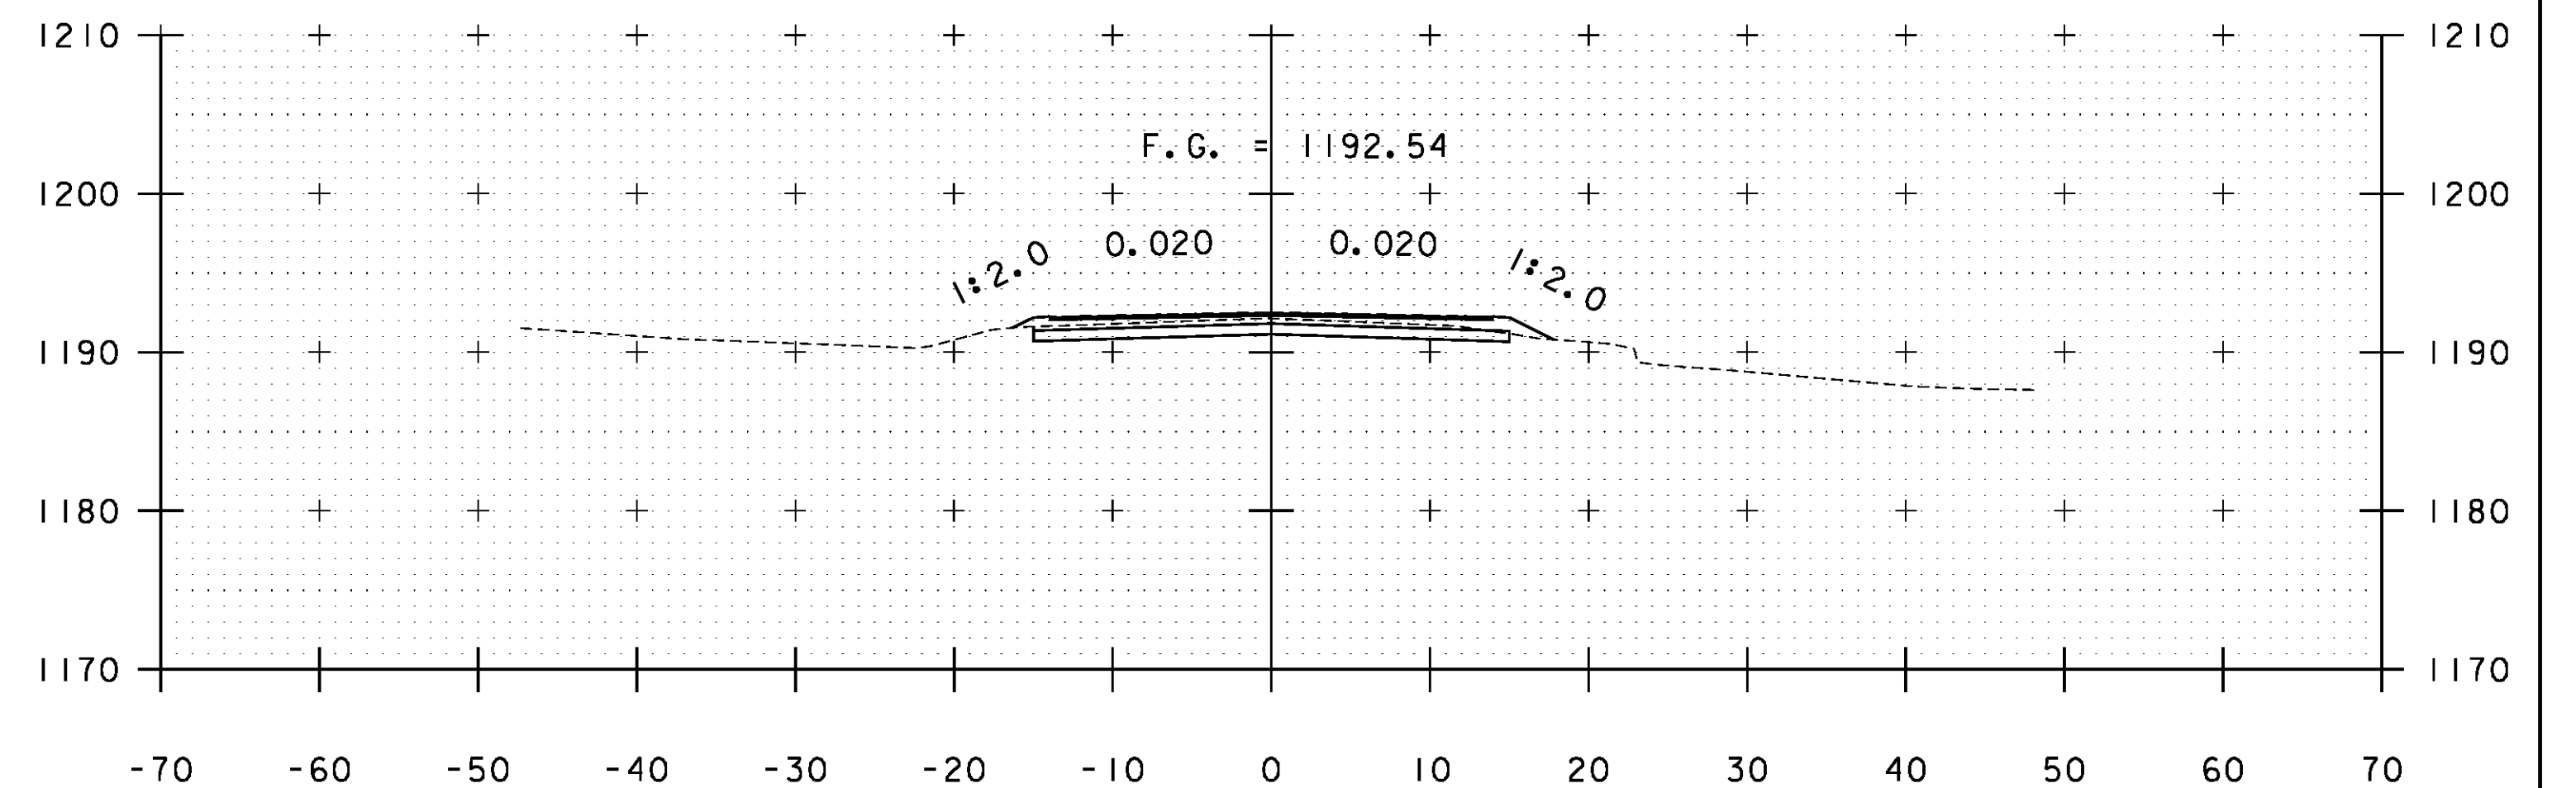

A 225+50

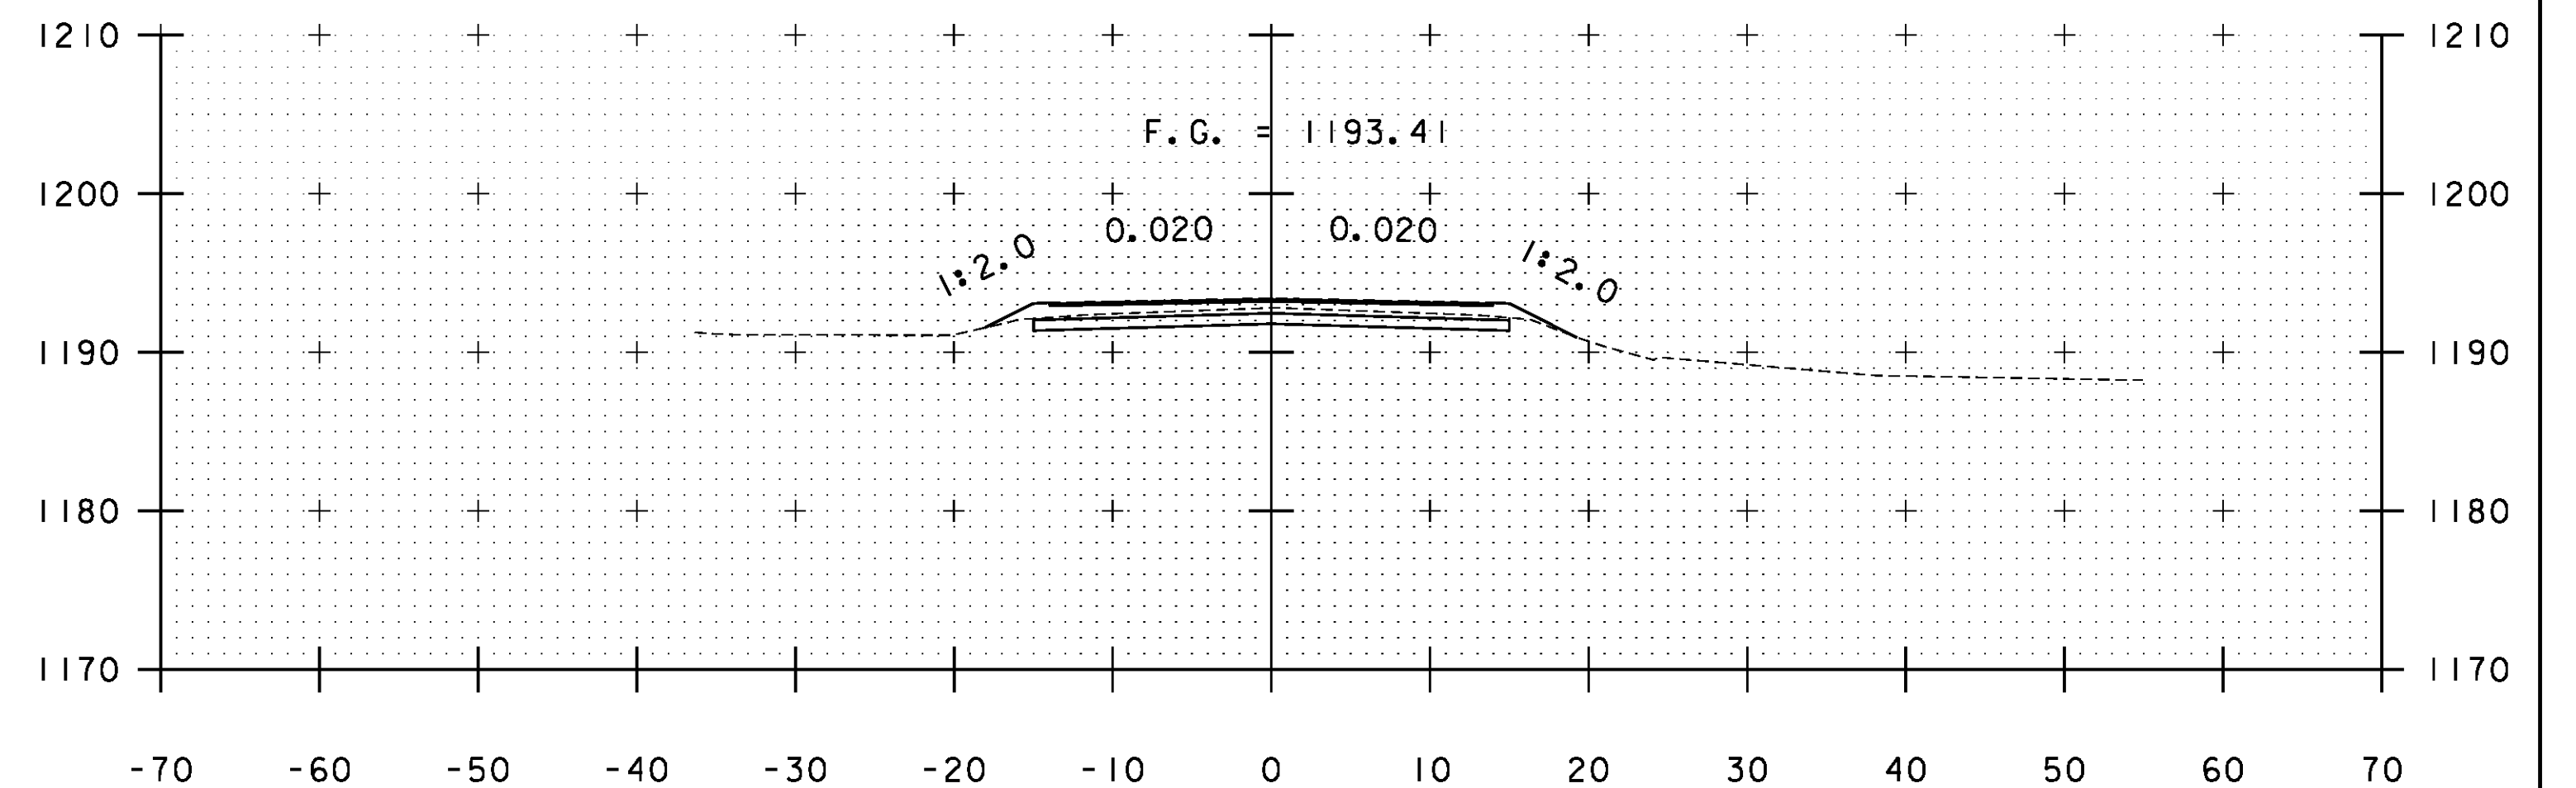

A 225+00

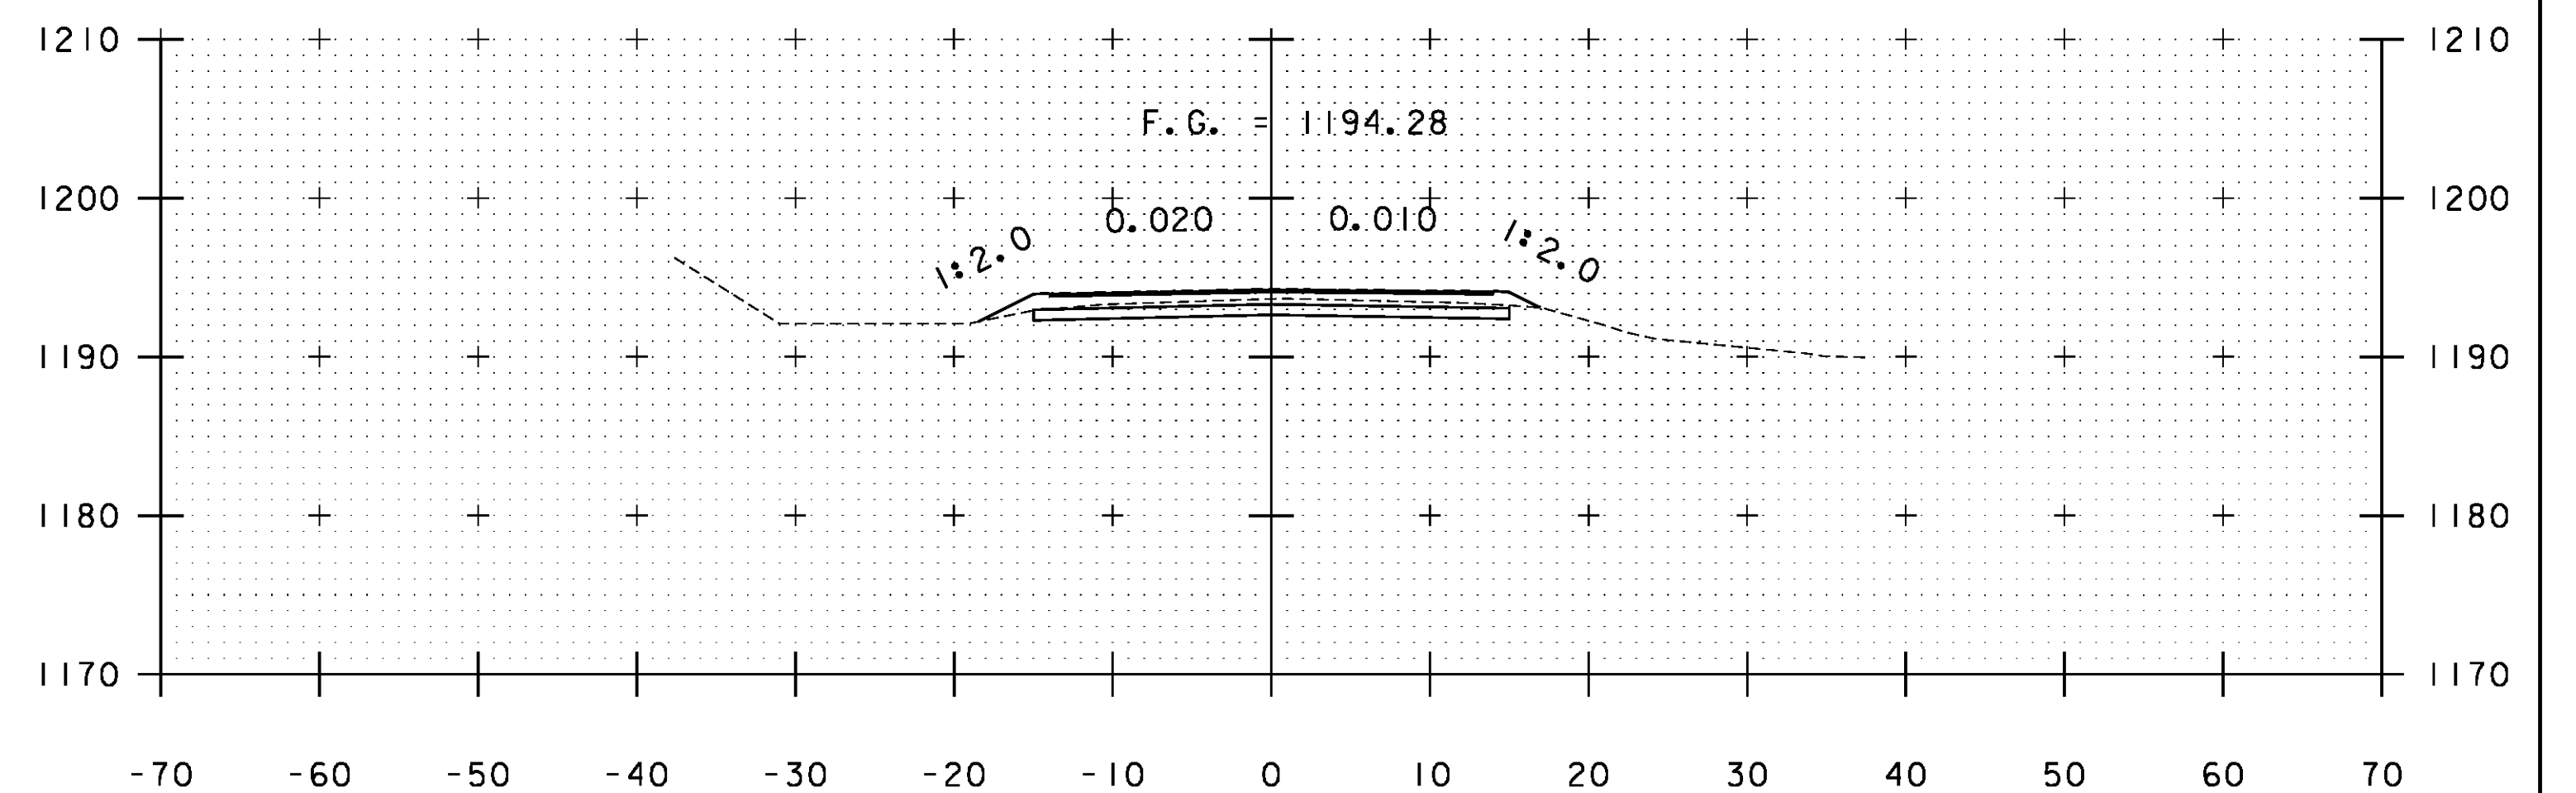

A 224+50

STA. A 223+00 TO STA. A 225+50

PROJECT NAME: WARDBORO-JAMAICA	PLOT DATE: 2/26/2014
PROJECT NUMBER: ER STP 013-1(17)	DRAWN BY: B. KIPP
FILE NAME: xs.dgn	CHECKED BY: HSD
PROJECT LEADER: K. UPMAL	SHEET 262 OF 444
DESIGNED BY: B. KIPP	
CROSS SECTIONS	