




A 237+00

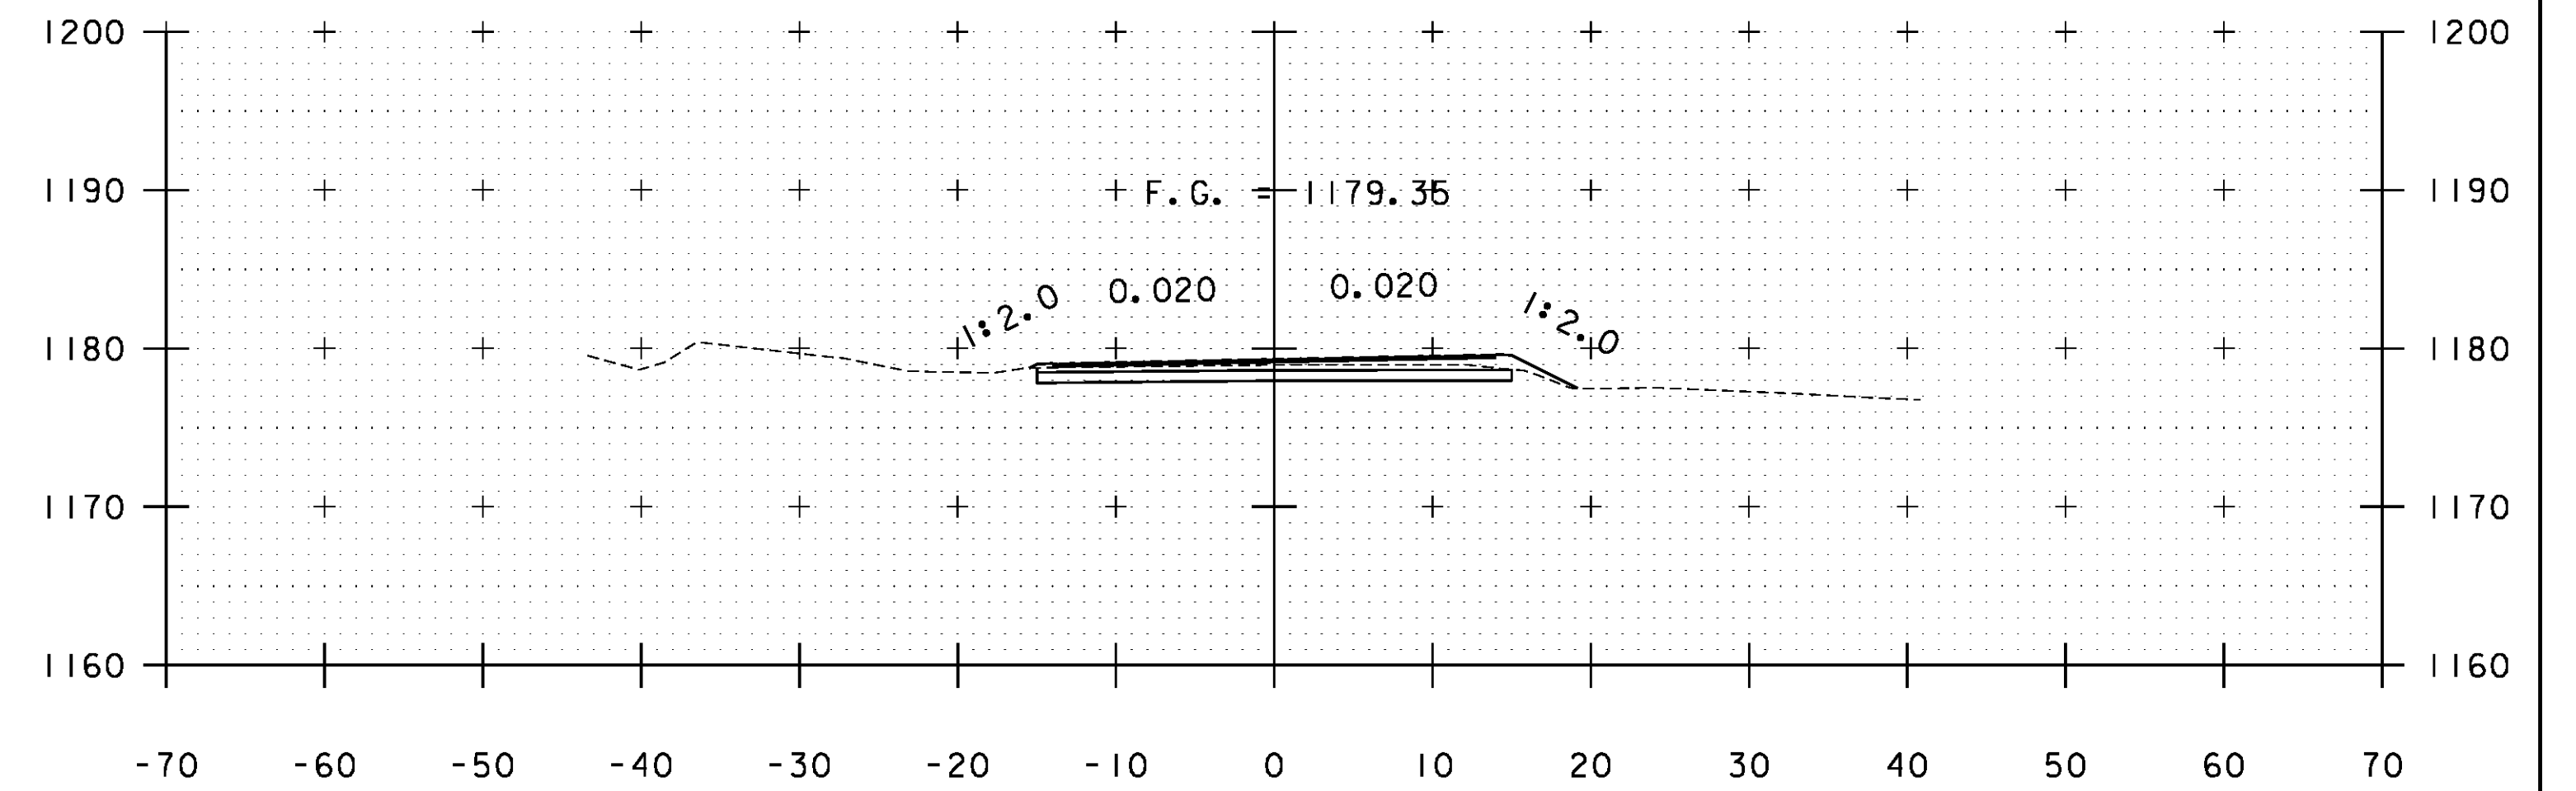


A 238+50

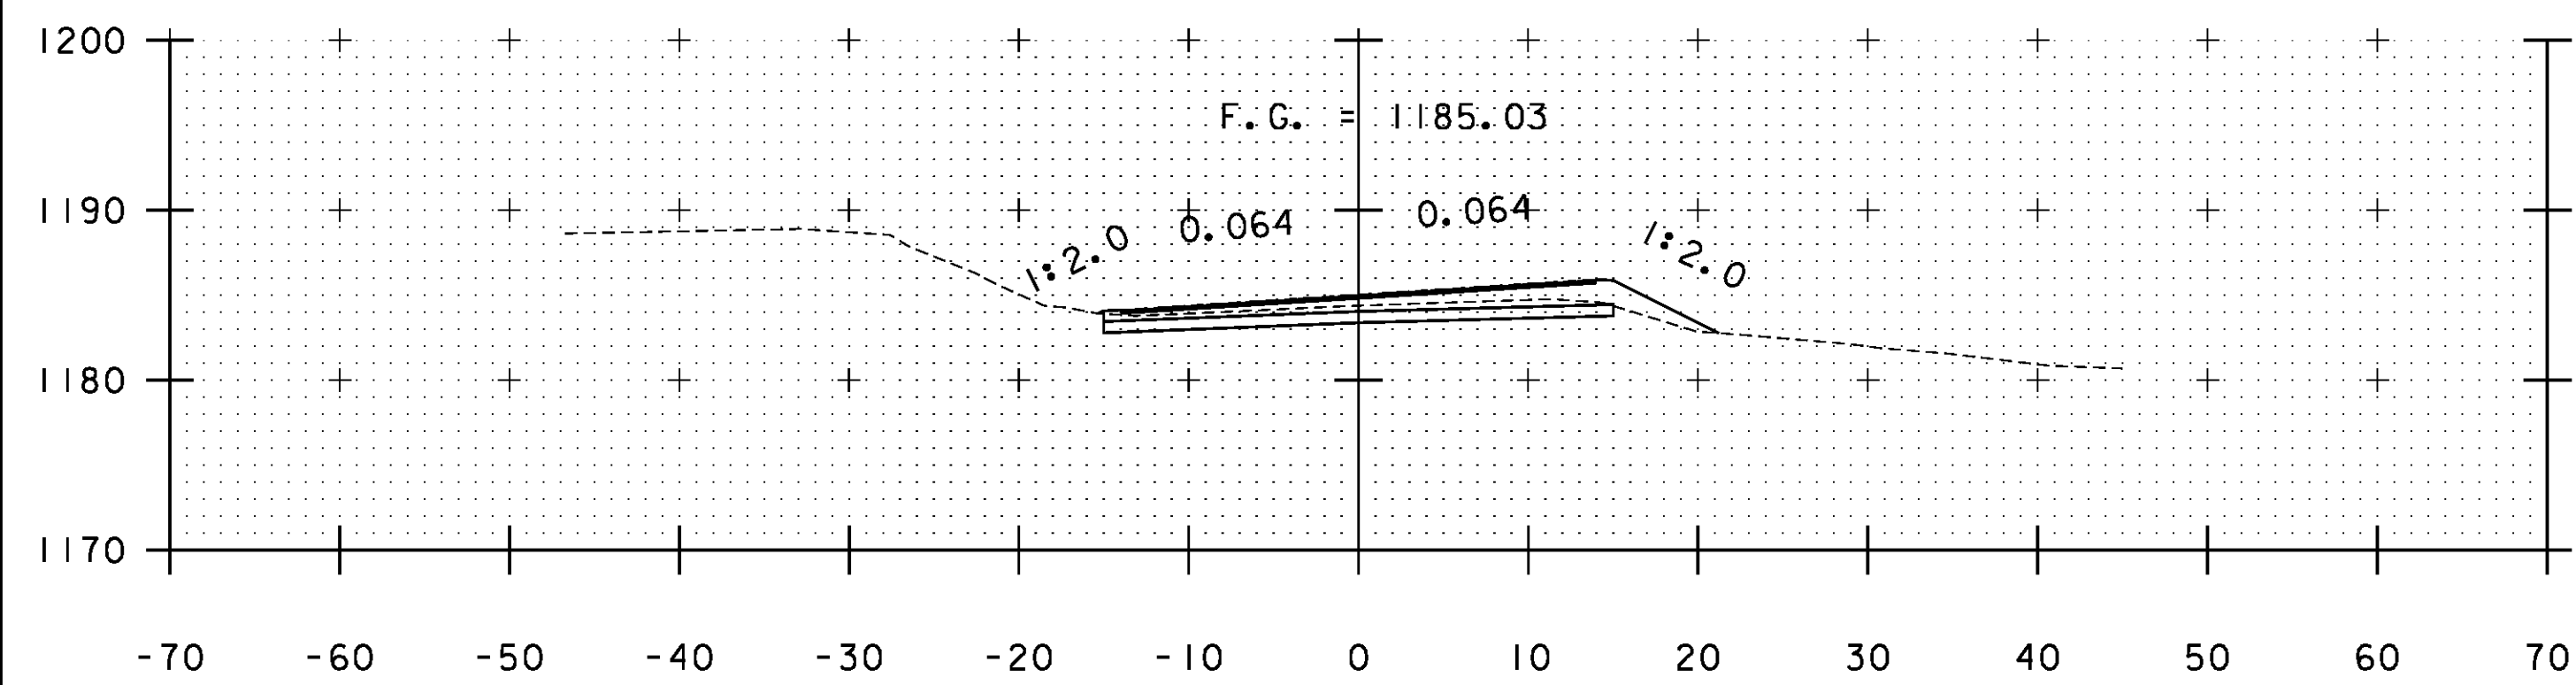


A 236+50

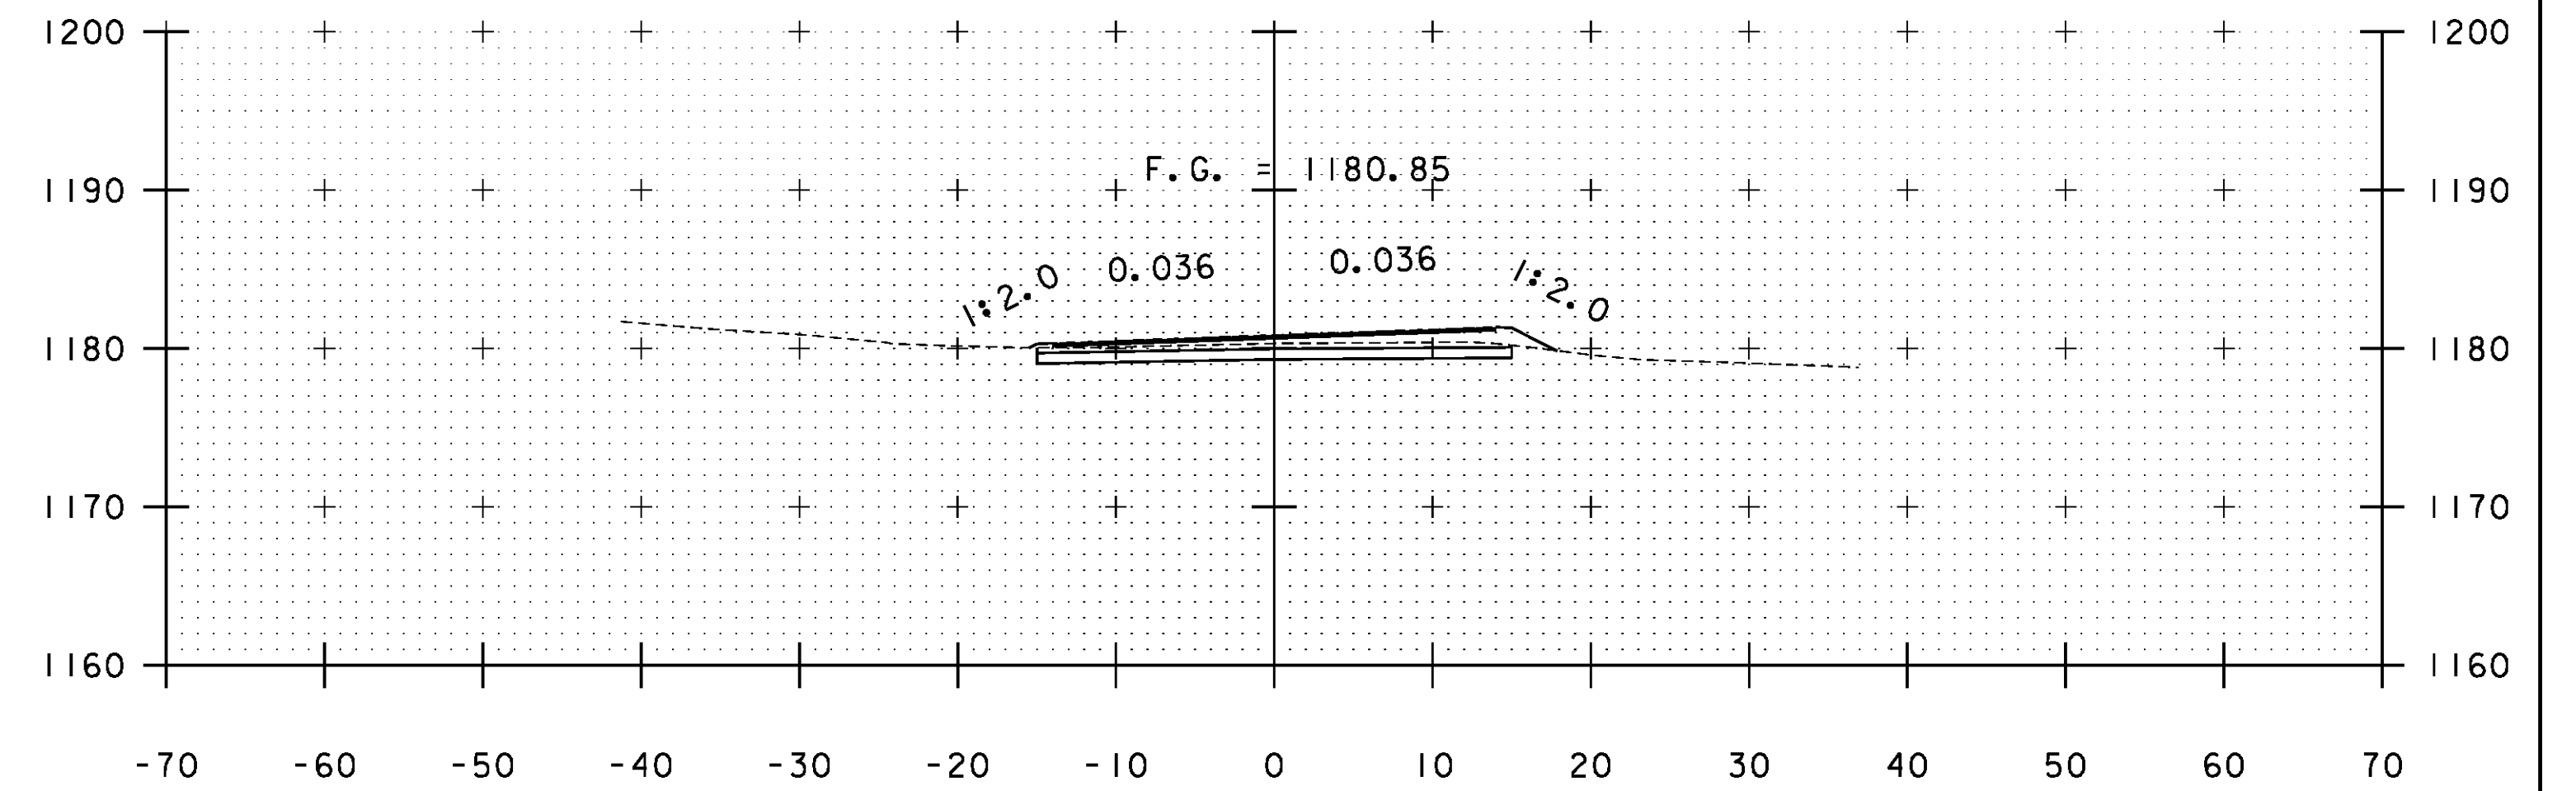

A 238+00

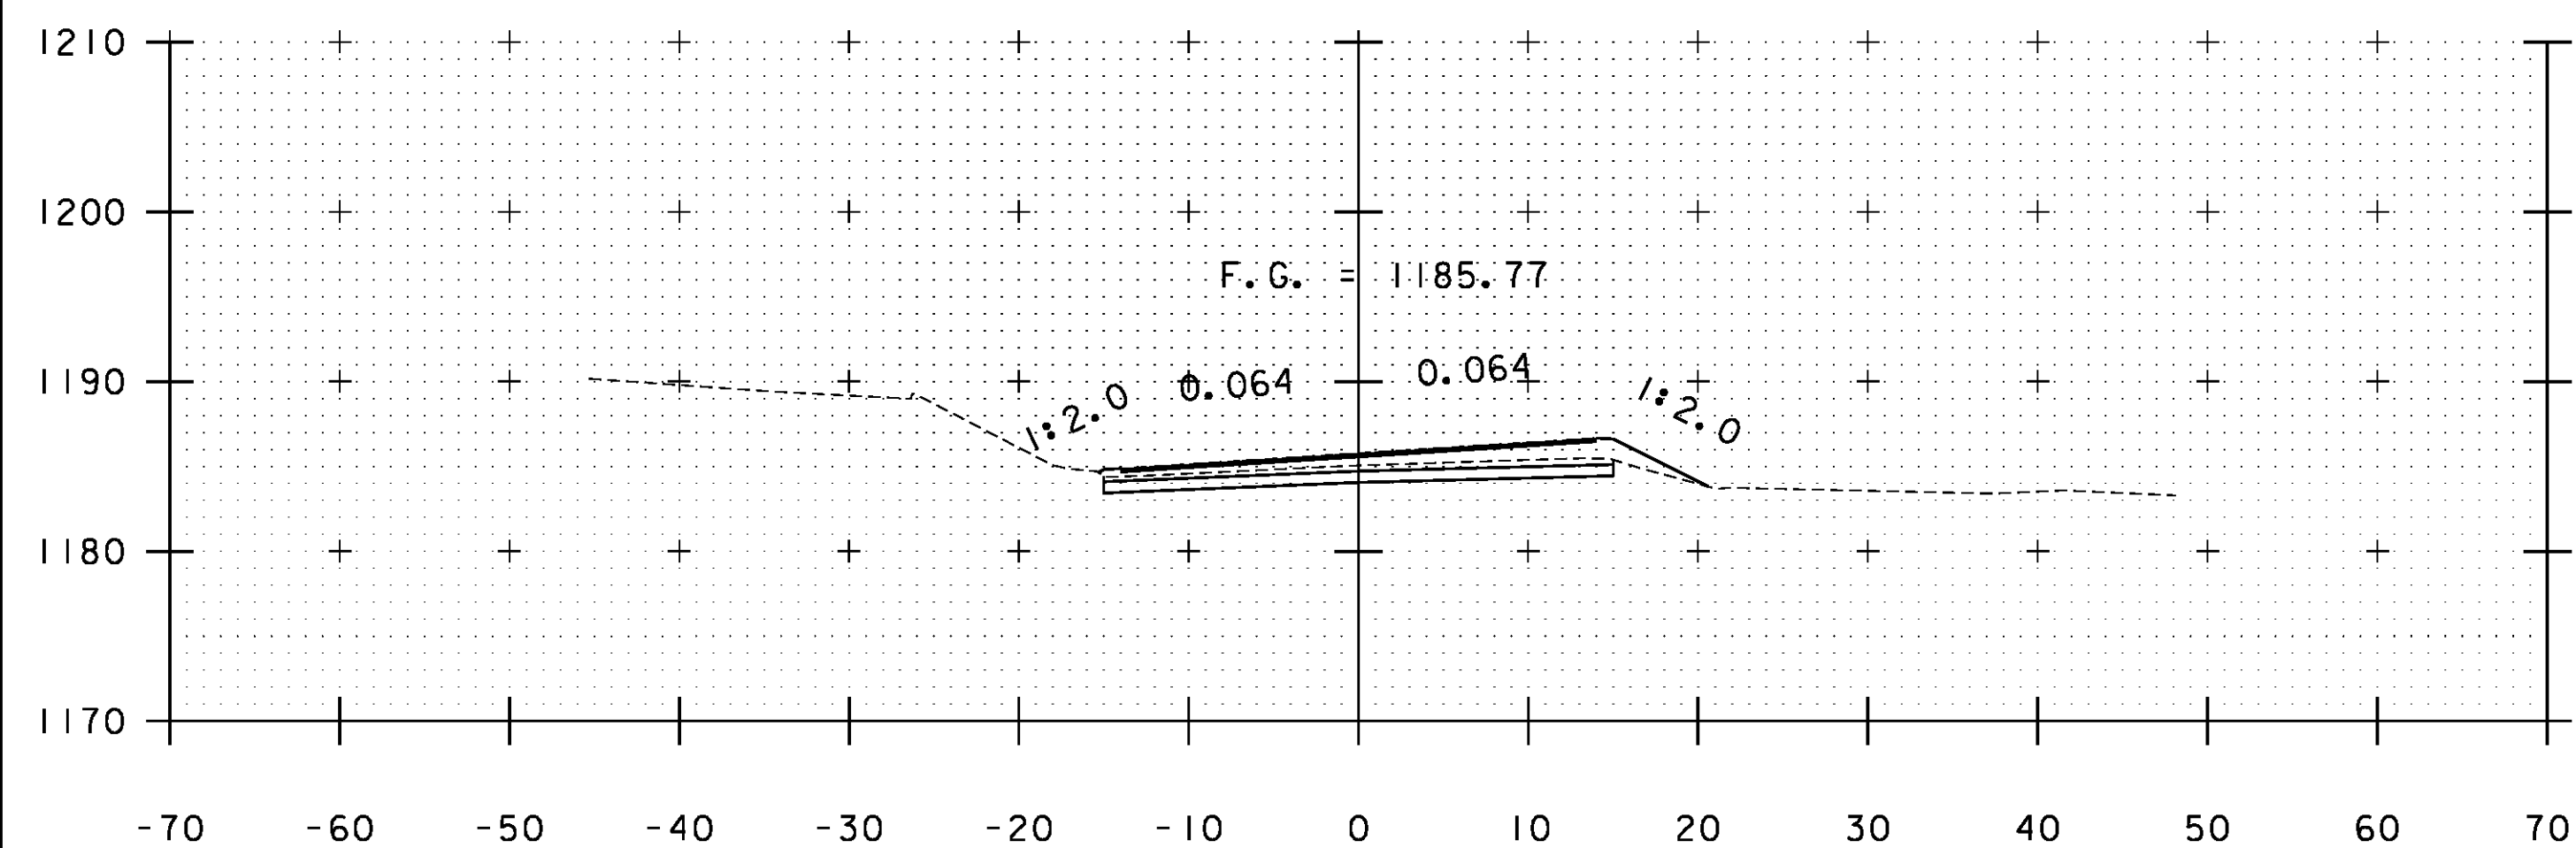

A 236+00

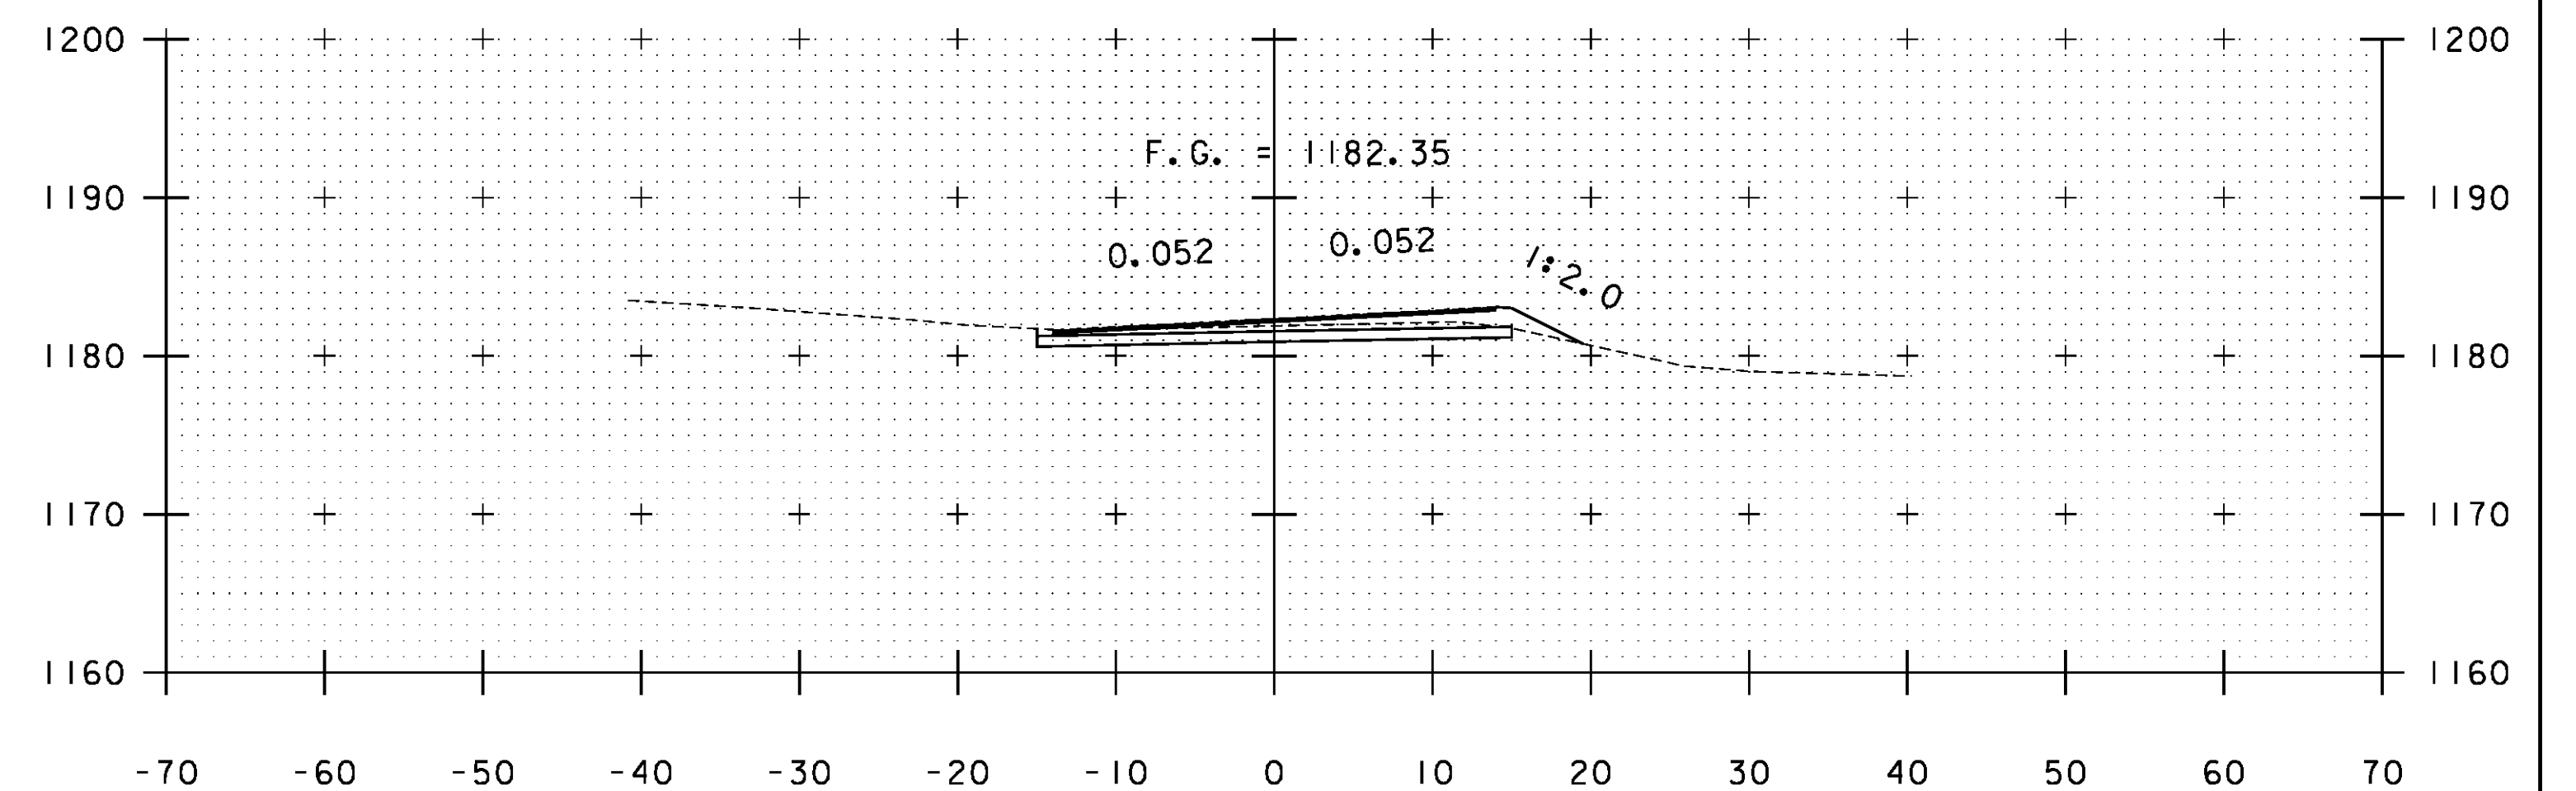

A 237+50

STA. A 236+00 TO STA. A 238+50

PROJECT NAME: WARDBORO-JAMAICA	
PROJECT NUMBER: ER STP 013-1(17)	
FILE NAME: xs.dgn	PLOT DATE: 2/26/2014
PROJECT LEADER: K. UPMAL	DRAWN BY: B. KIPP
DESIGNED BY: B. KIPP	CHECKED BY: HSD
CROSS SECTIONS	SHEET 268 OF 444