




A 249+37

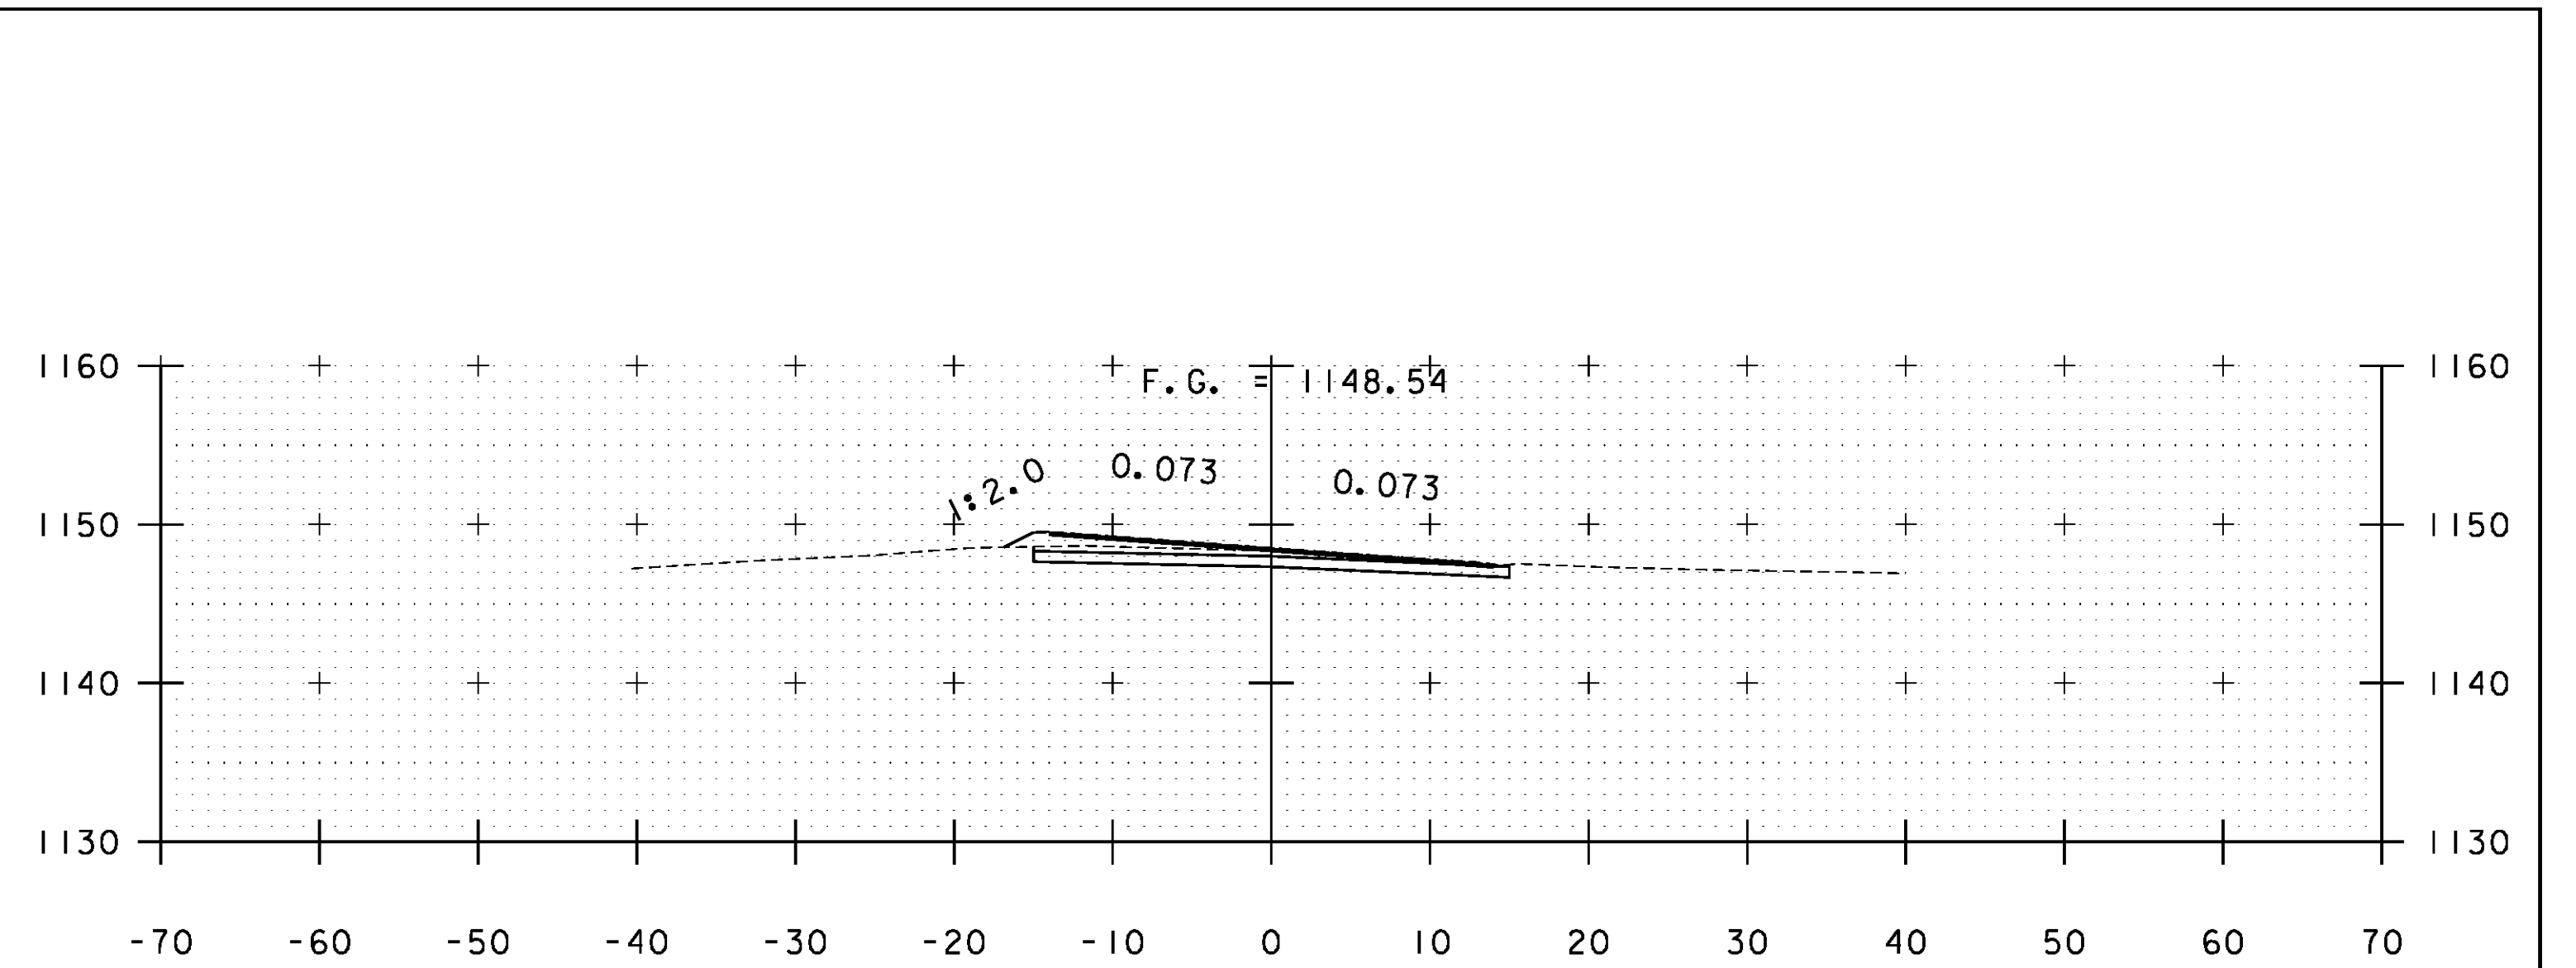


A 250+50

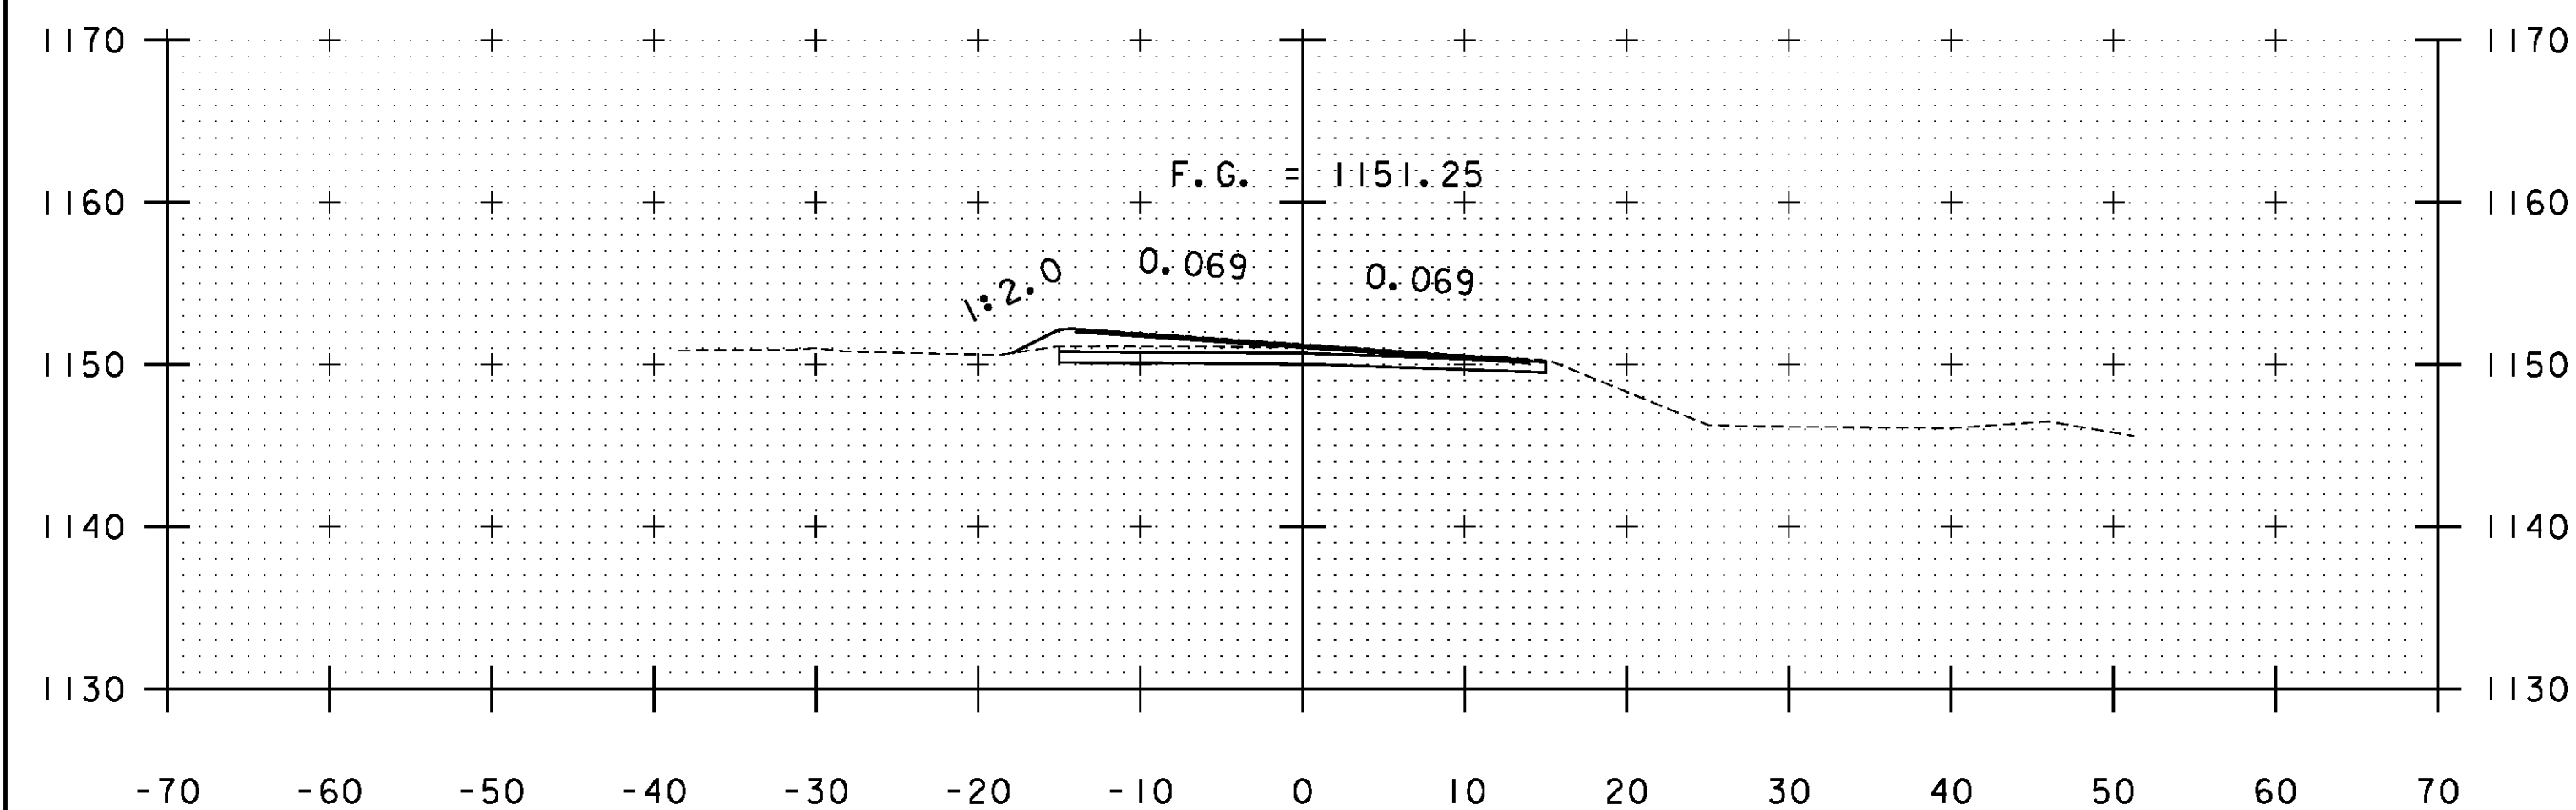


A 249+00

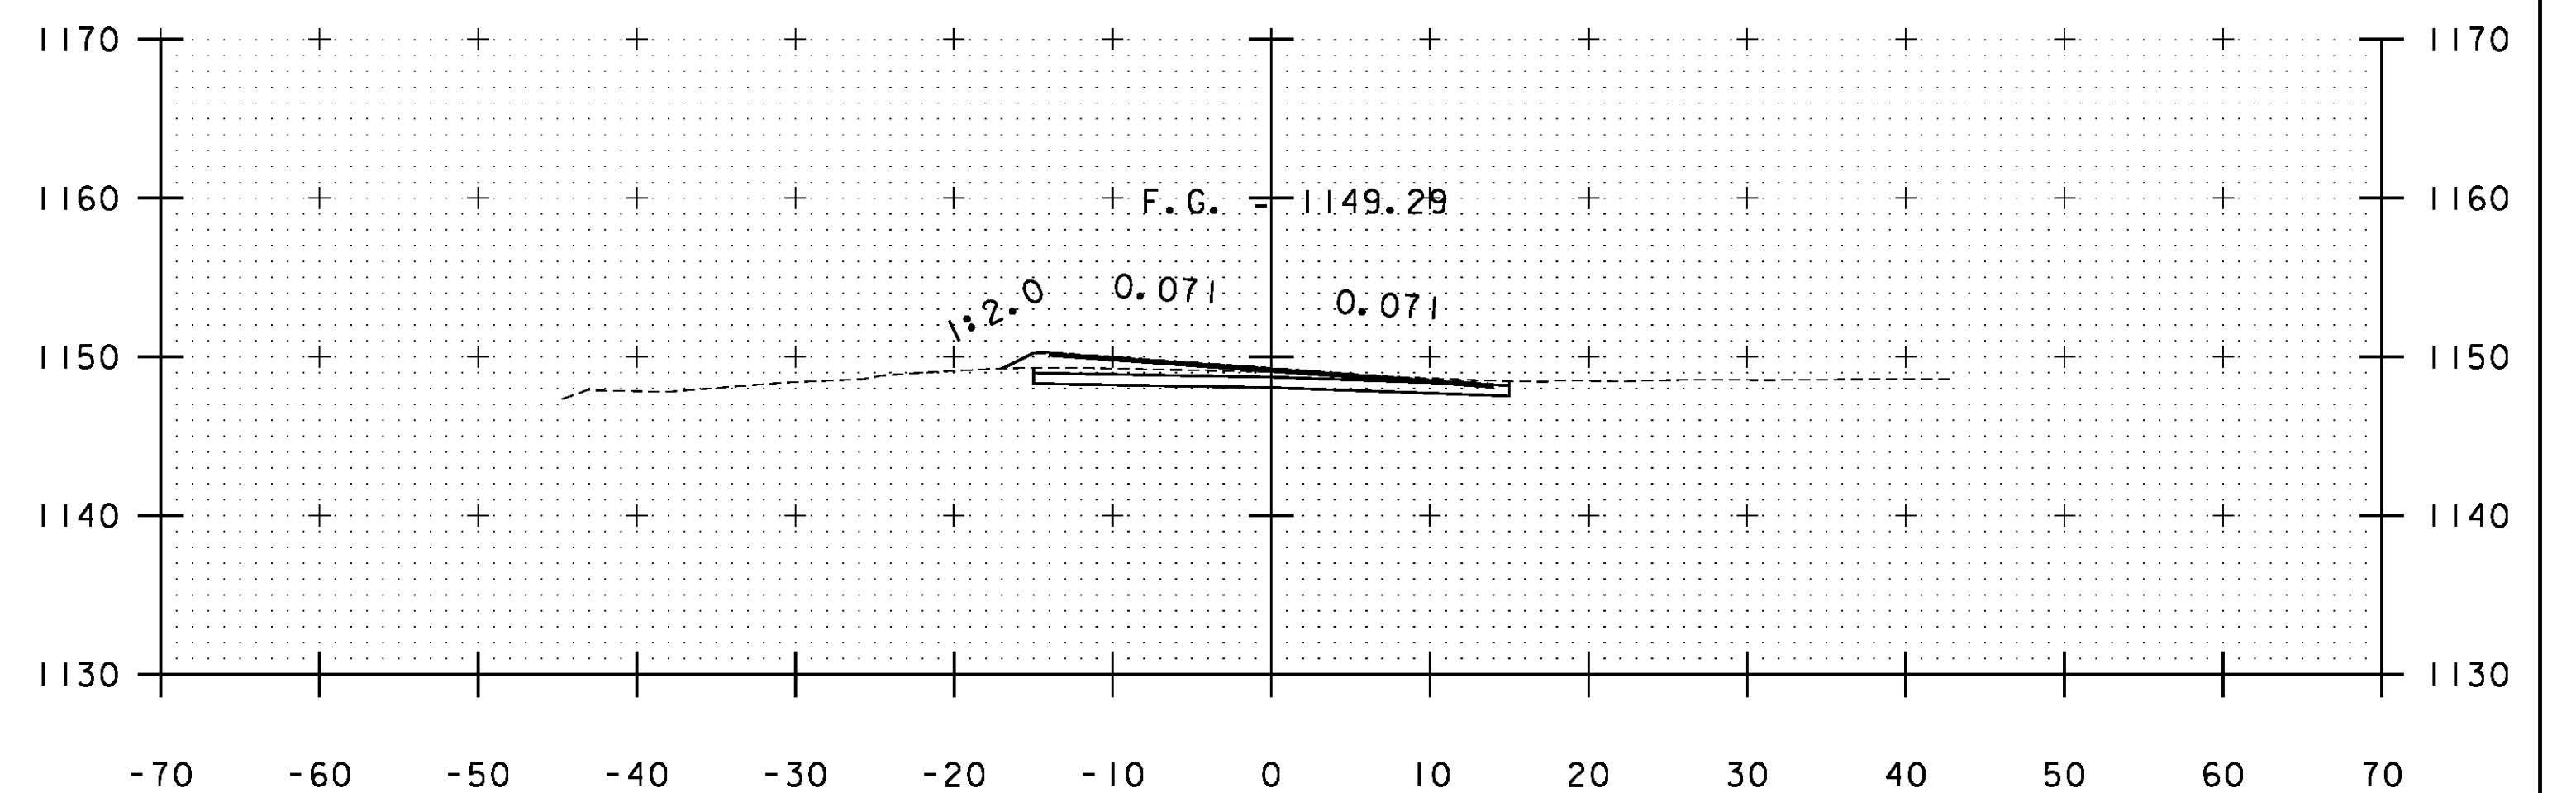

A 250+00

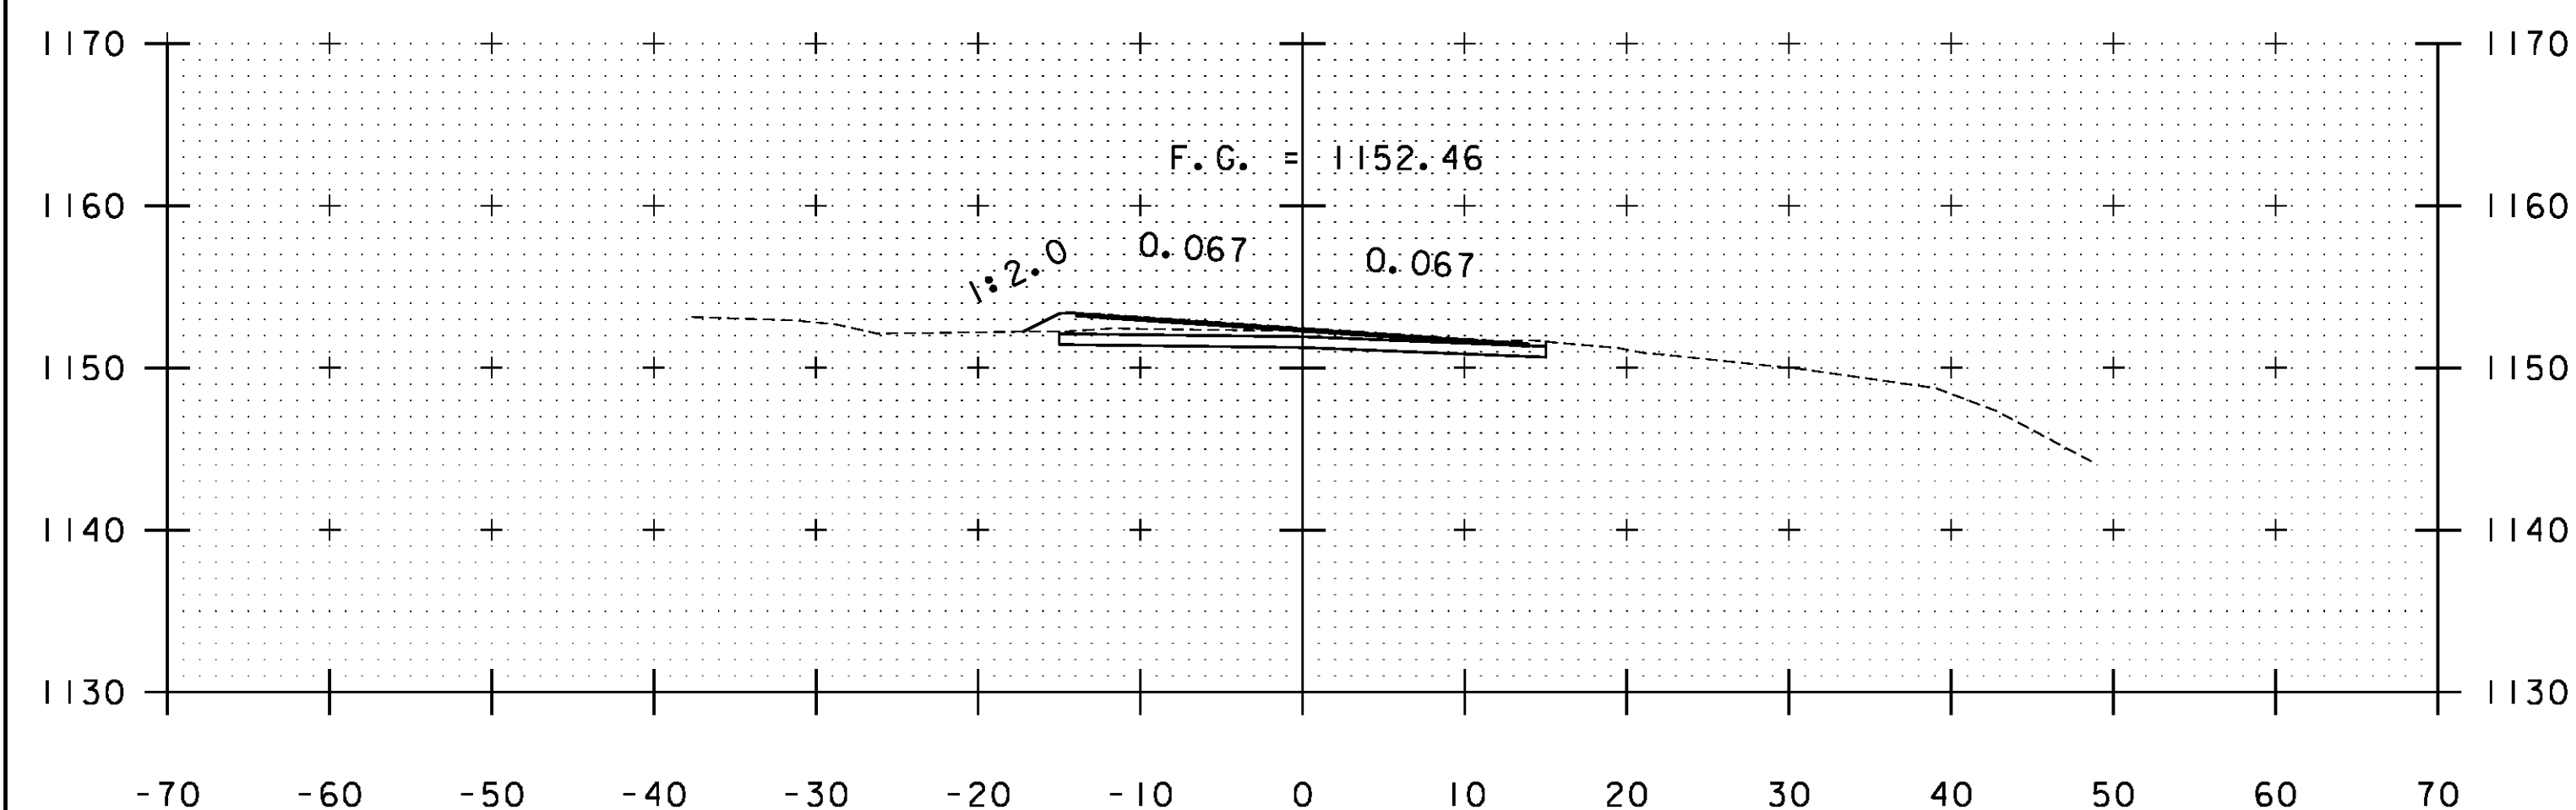

A 248+50

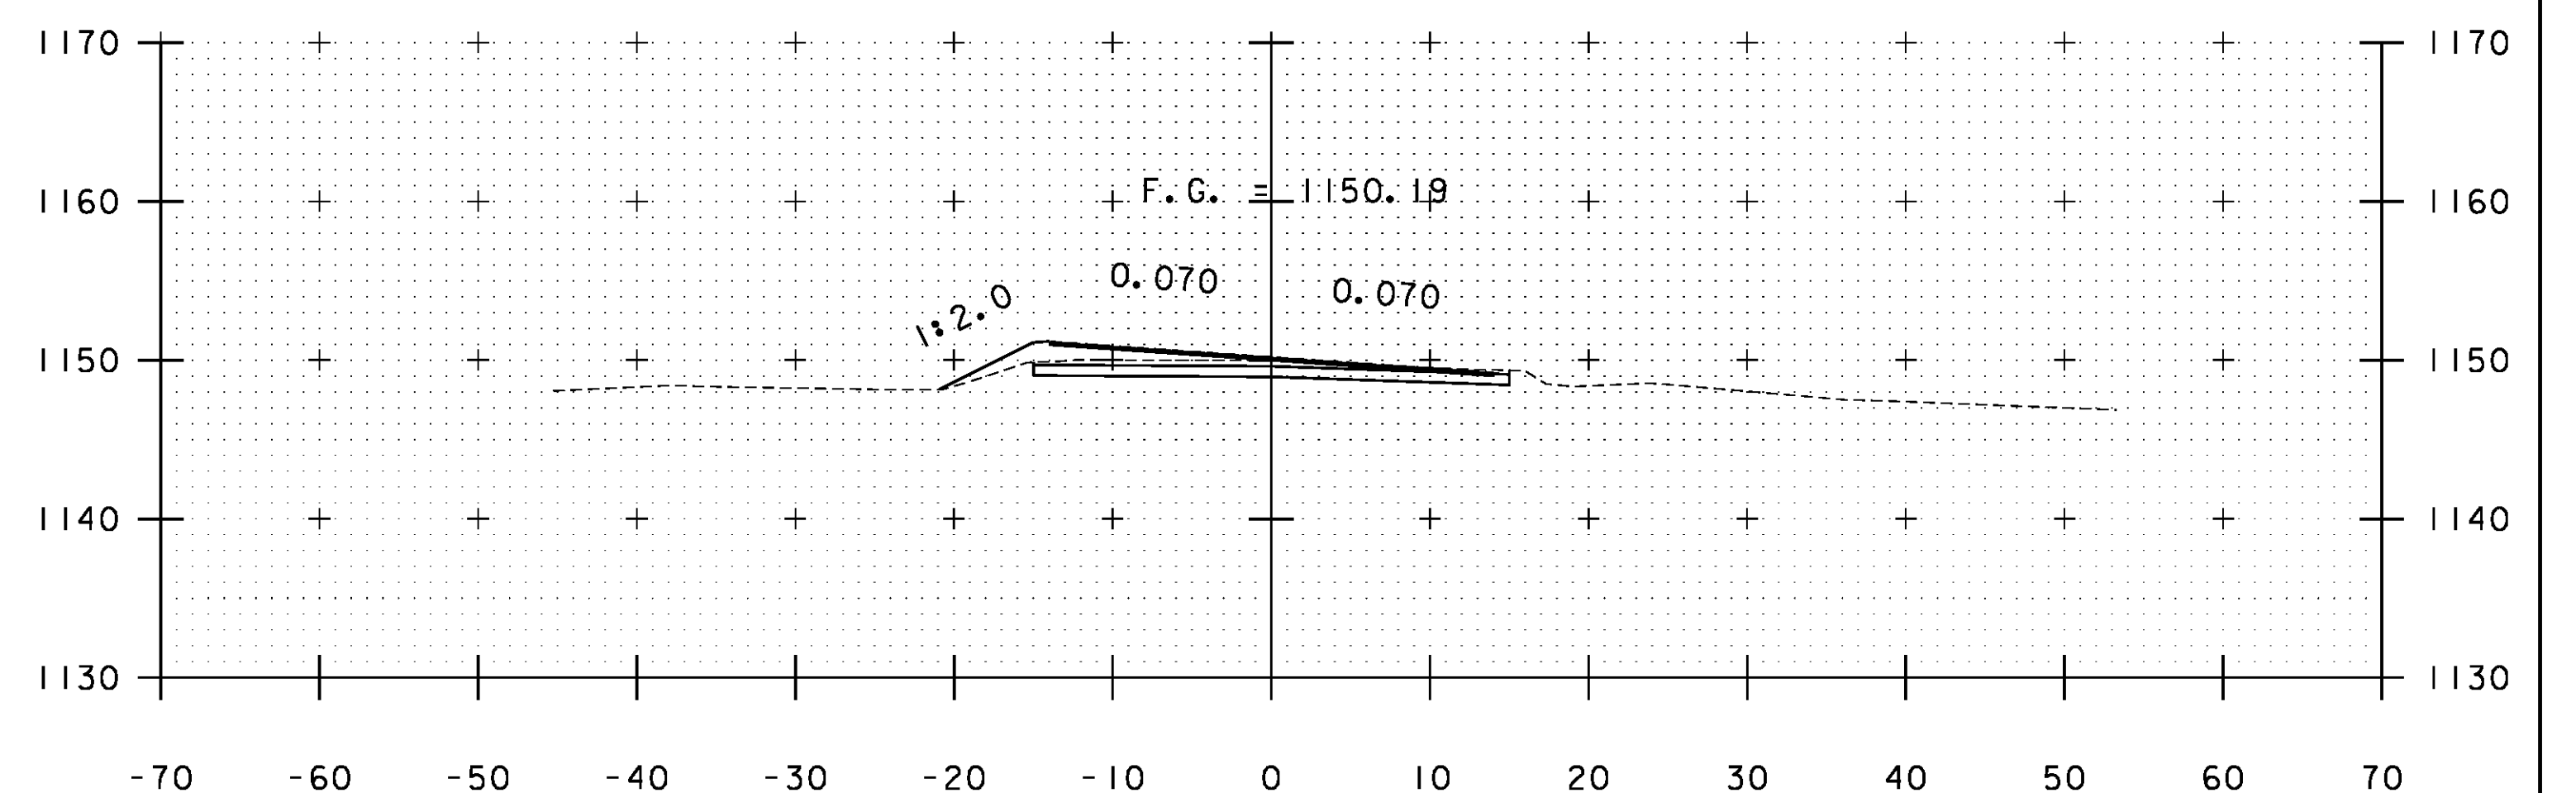

A 249+50

STA. A 248+50 TO STA. A 250+50

PROJECT NAME: WARDBORO-JAMAICA	PLOT DATE: 2/26/2014
PROJECT NUMBER: ER STP 013-1(17)	DRAWN BY: B. KIPP
FILE NAME: xs.dgn	CHECKED BY: HSD
PROJECT LEADER: K. UPMAL	SHEET 273 OF 444
DESIGNED BY: B. KIPP	
CROSS SECTIONS	