




A 252+00

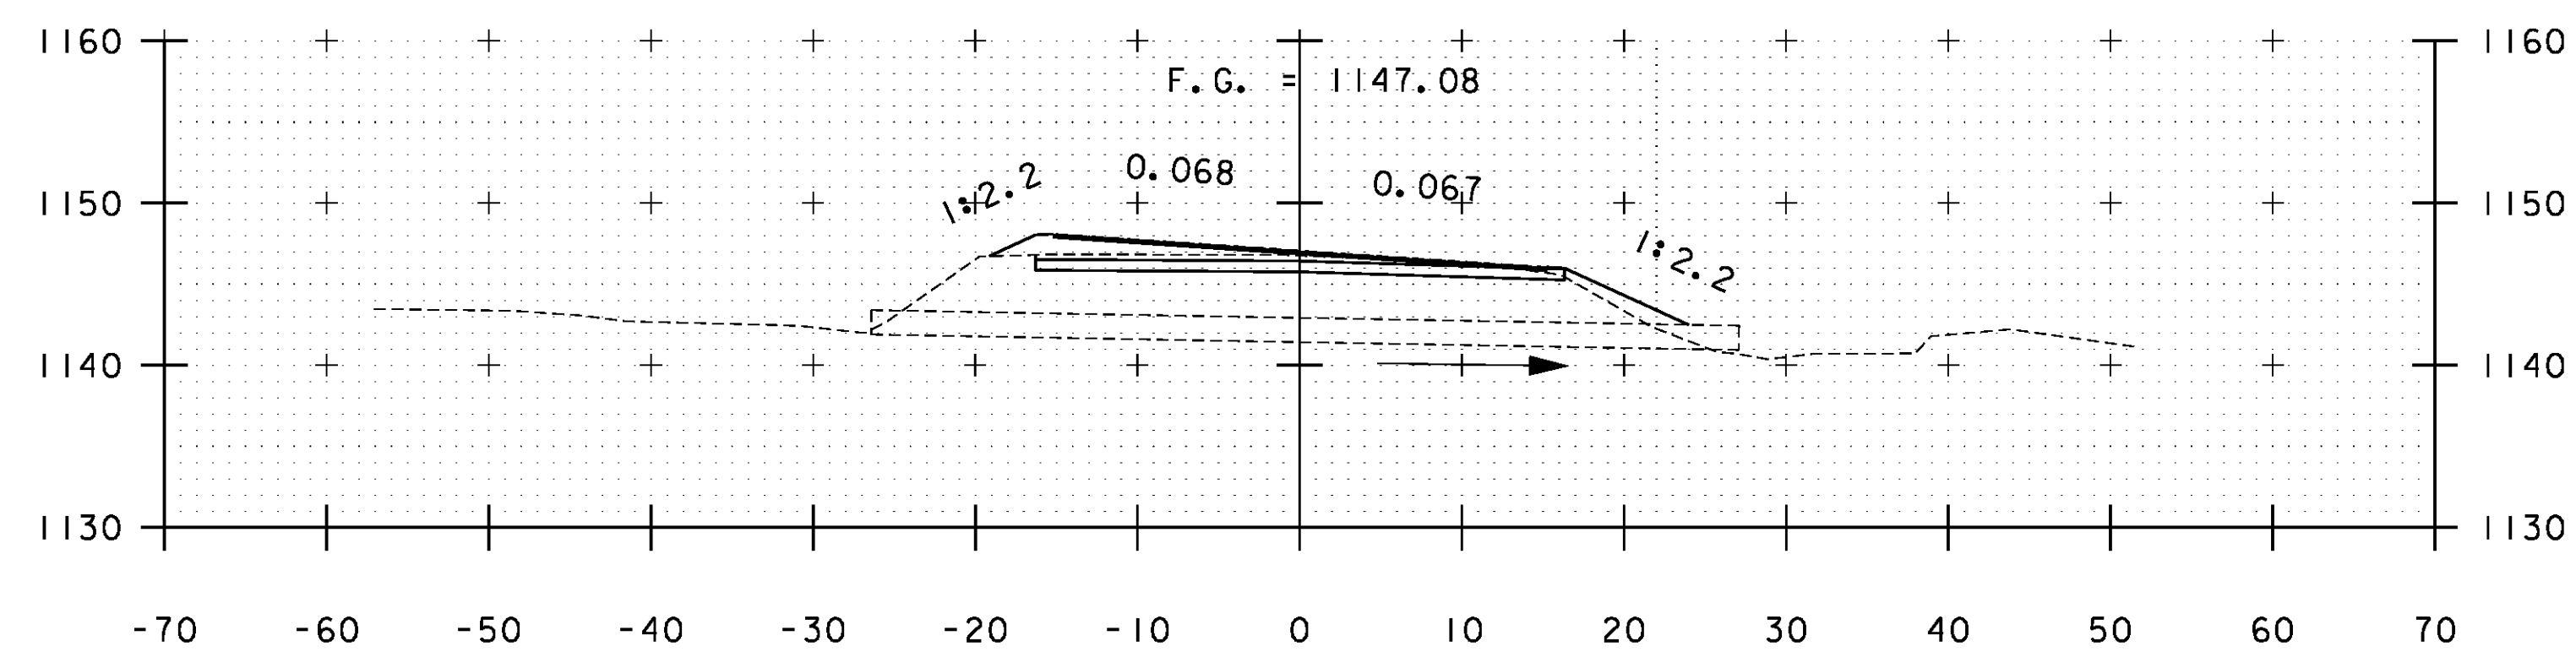


A 253+07

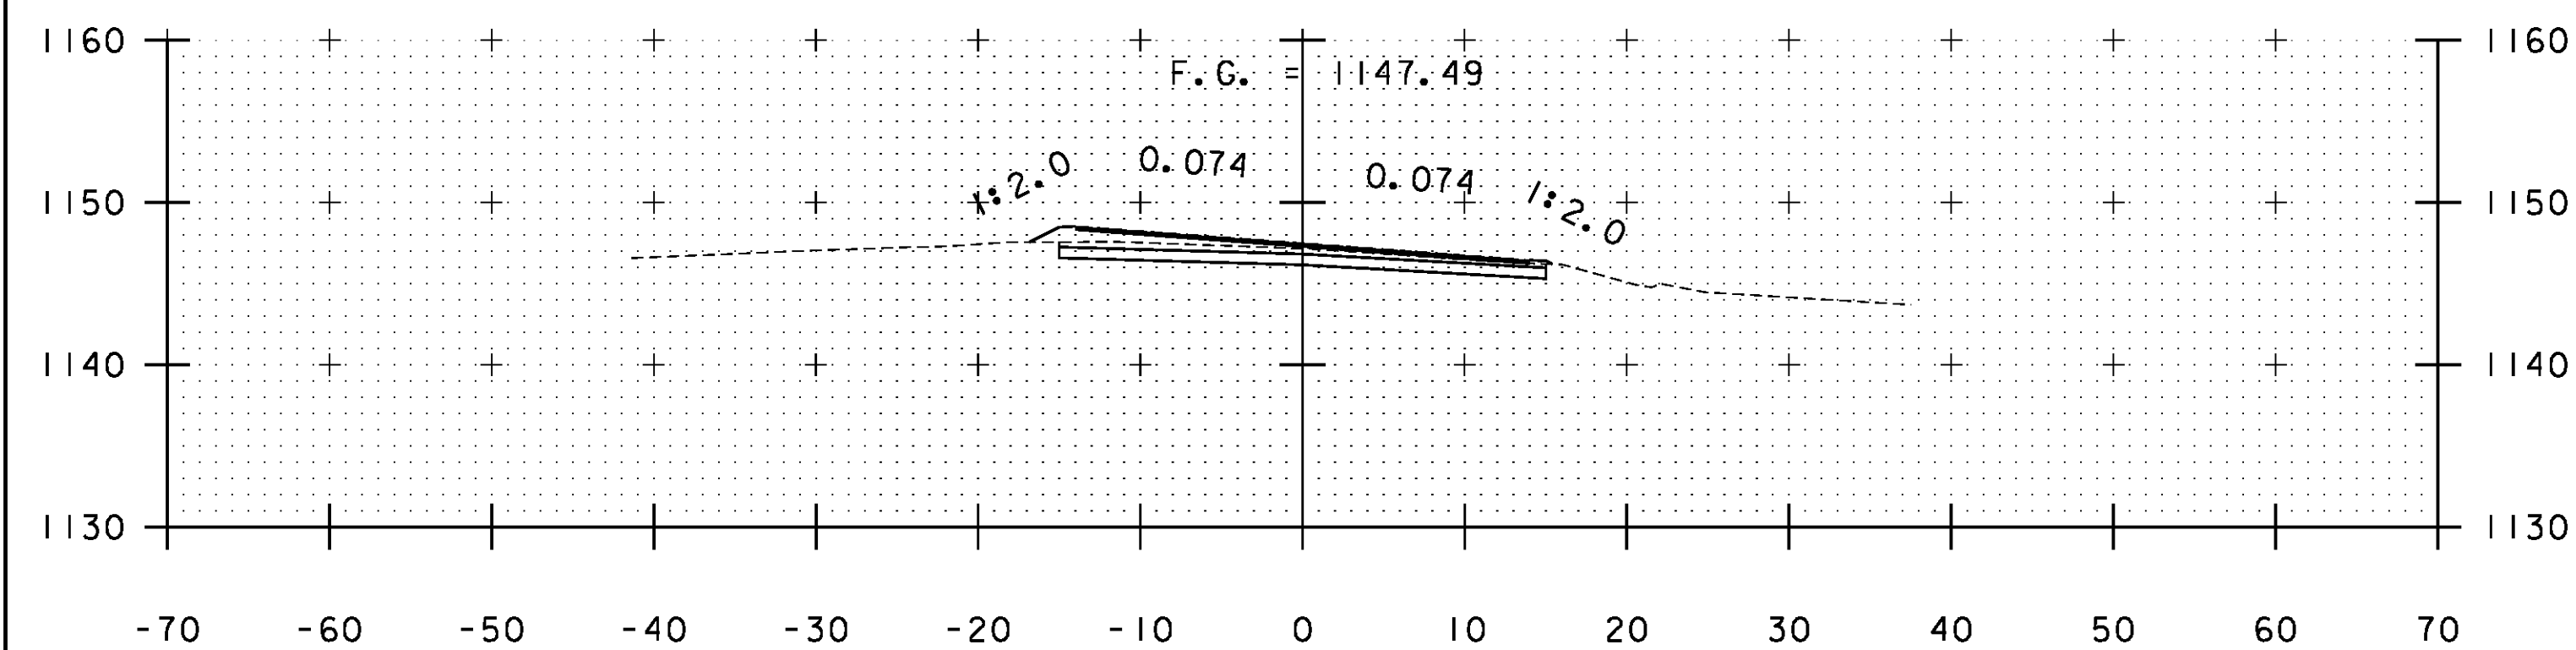


A 251+50

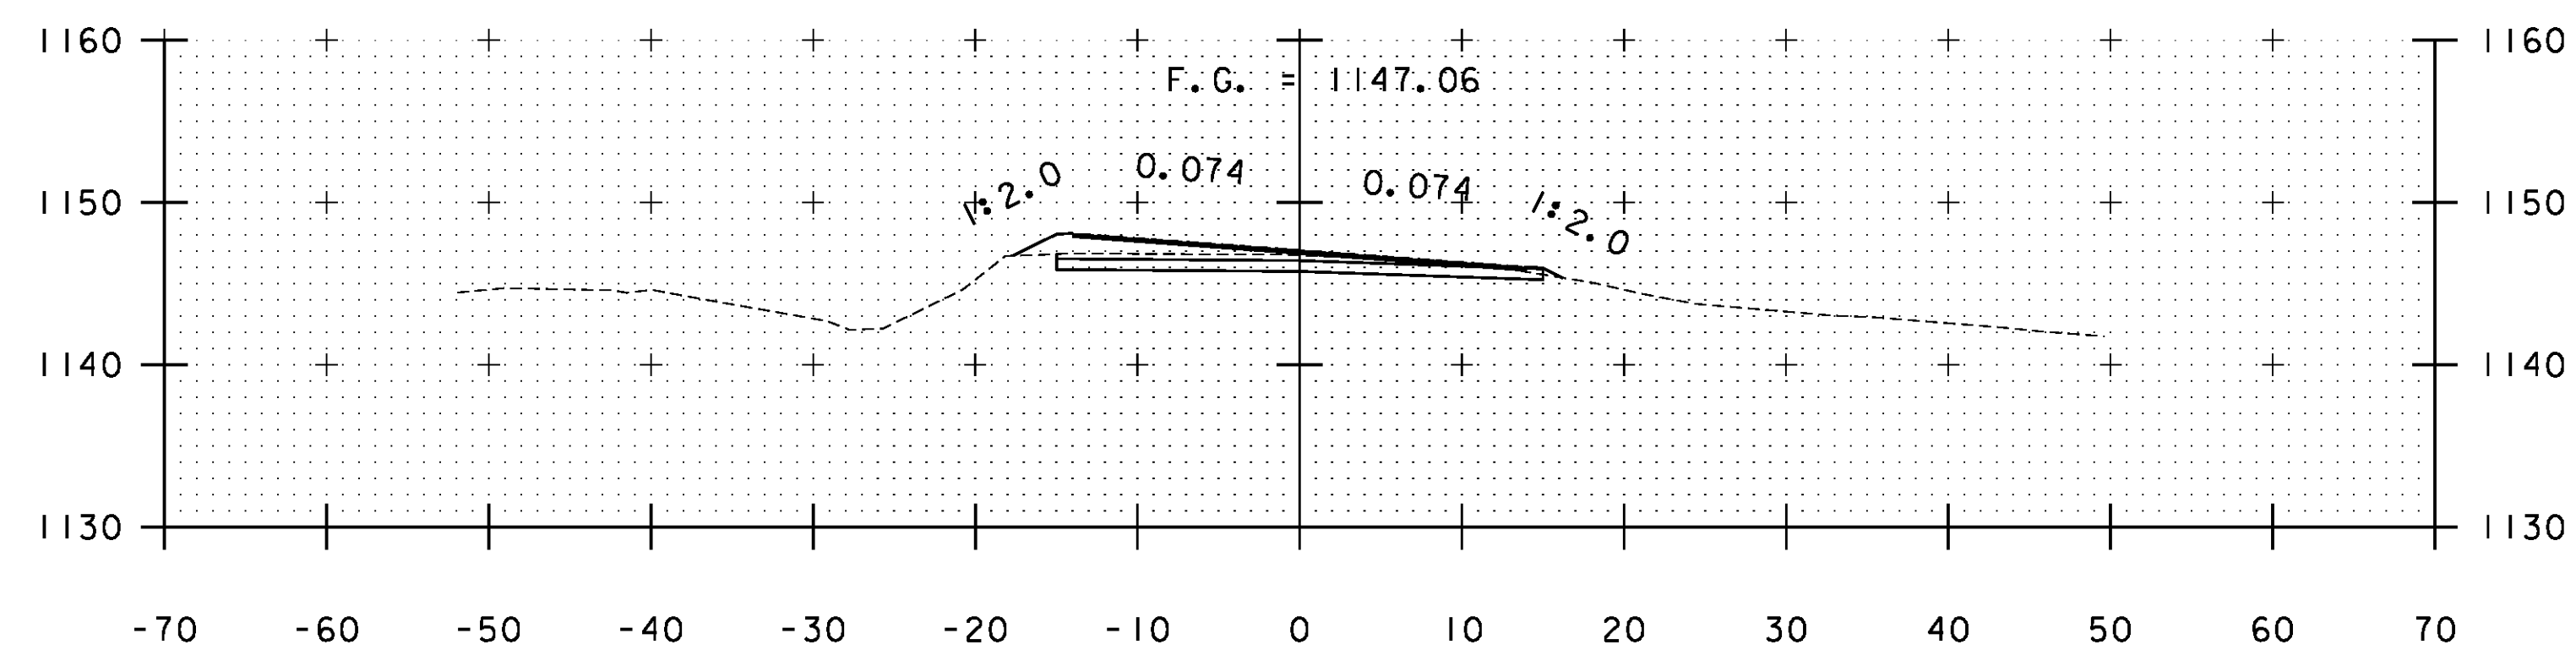

A 253+00

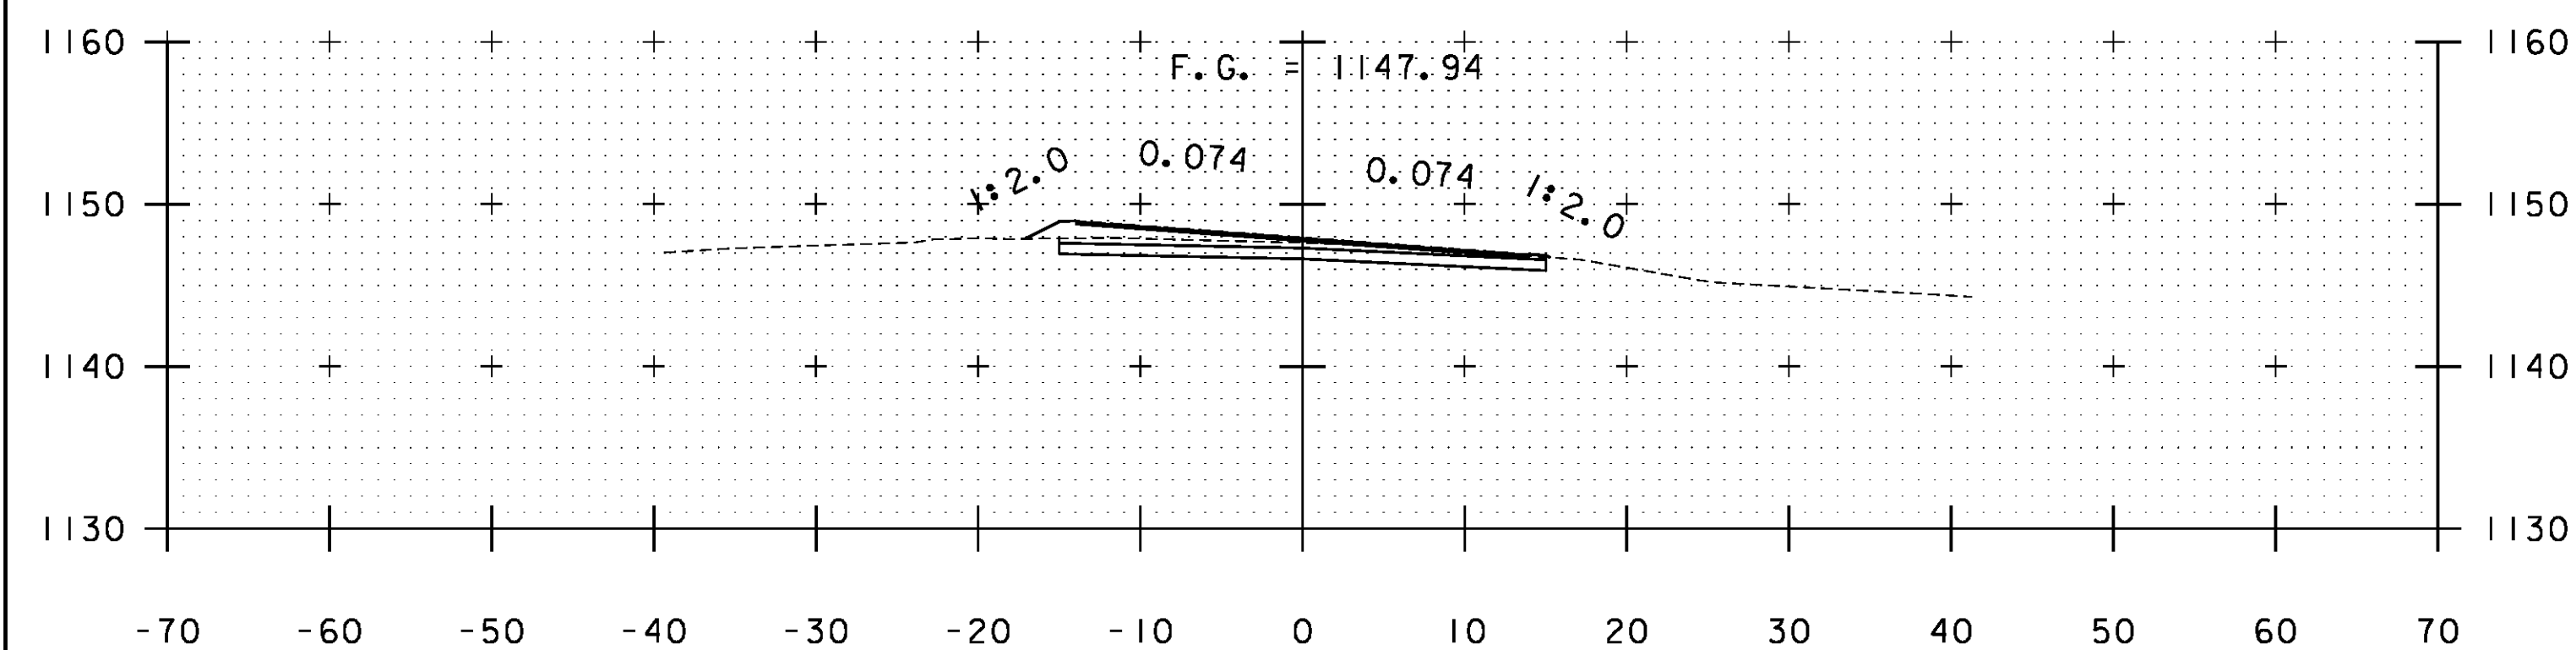

A 251+00

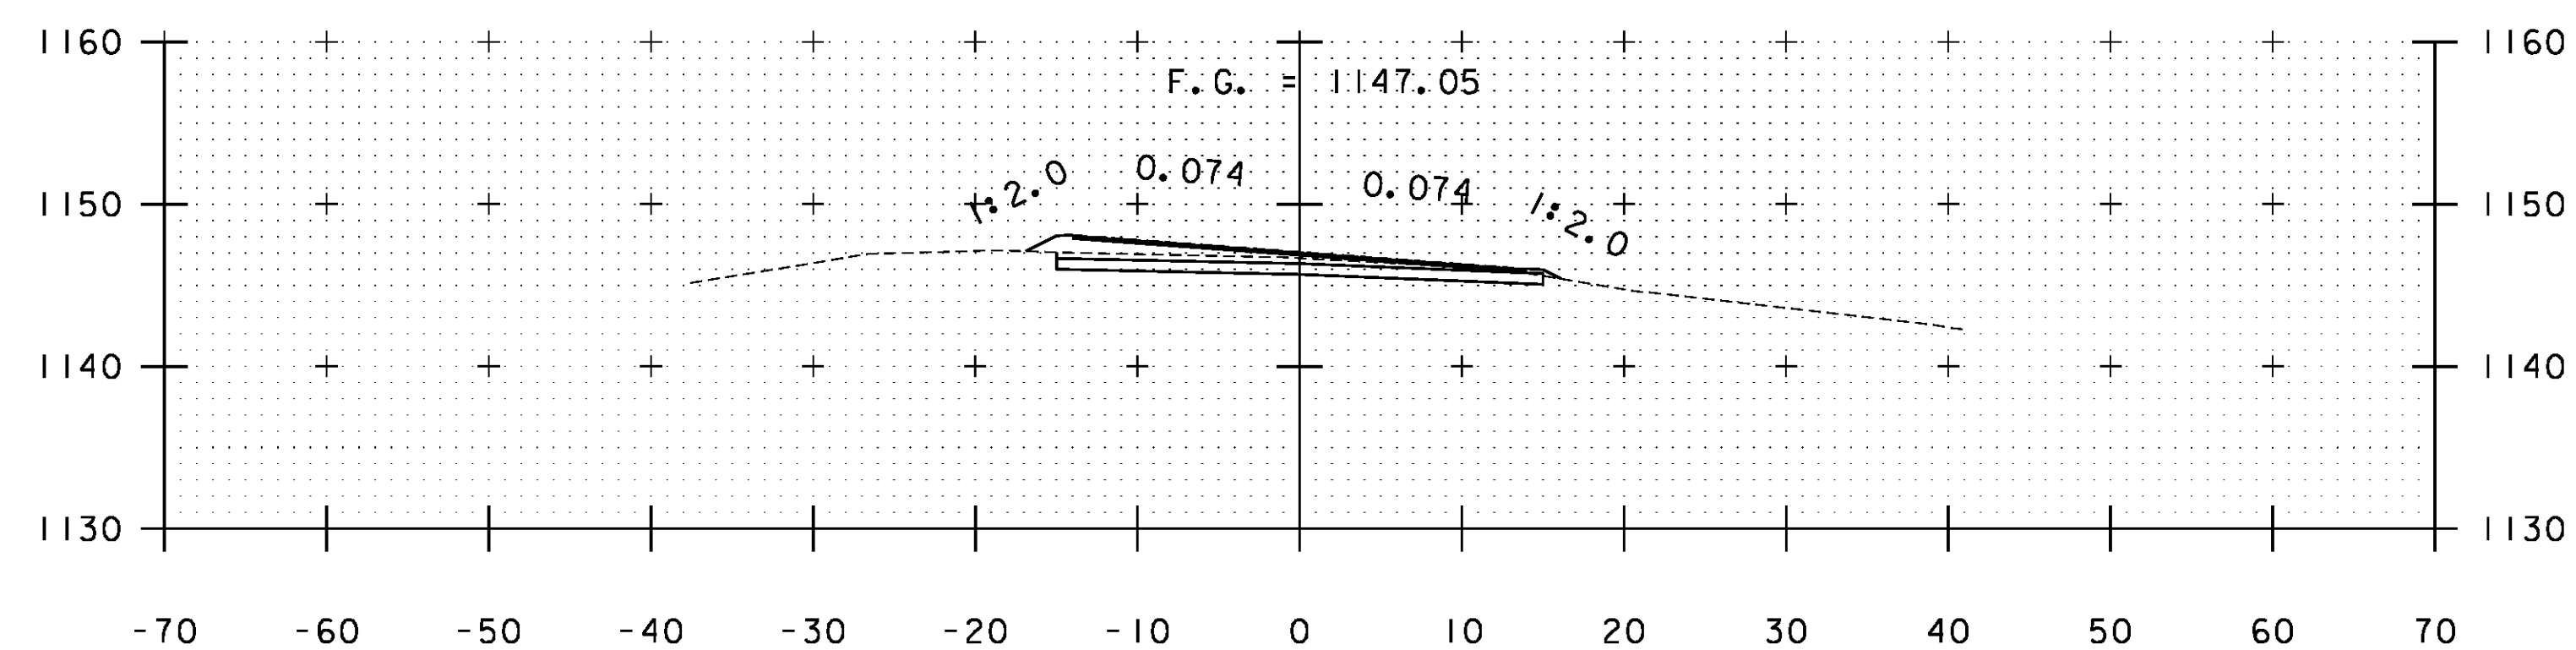

A 252+50

STA. A 251+00 TO STA. A 253+07

PROJECT NAME: WARDBORO-JAMAICA	
PROJECT NUMBER: ER STP 013-1(17)	
FILE NAME: xs.dgn	PLOT DATE: 2/26/2014
PROJECT LEADER: K. UPMAL	DRAWN BY: B. KIPP
DESIGNED BY: B. KIPP	CHECKED BY: HSD
CROSS SECTIONS	SHEET 274 OF 444