




A 254+50

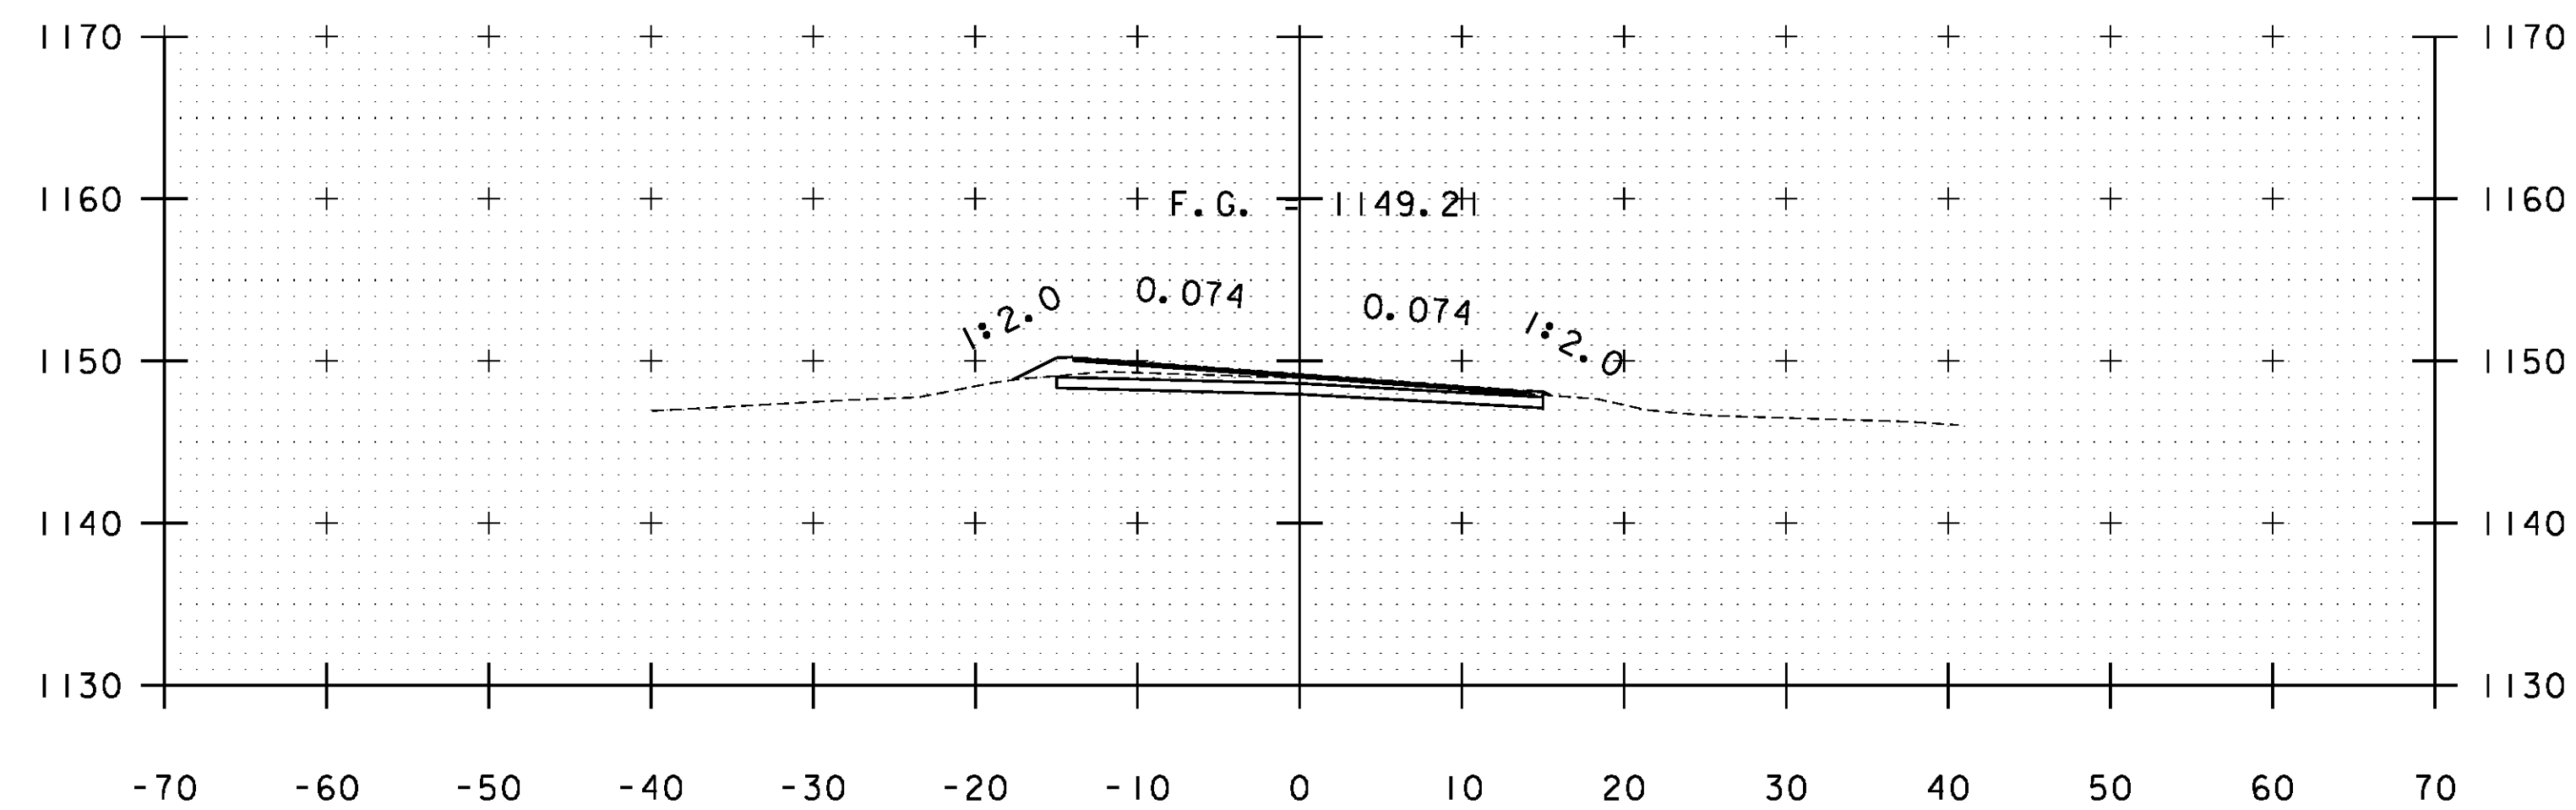


A 255+50

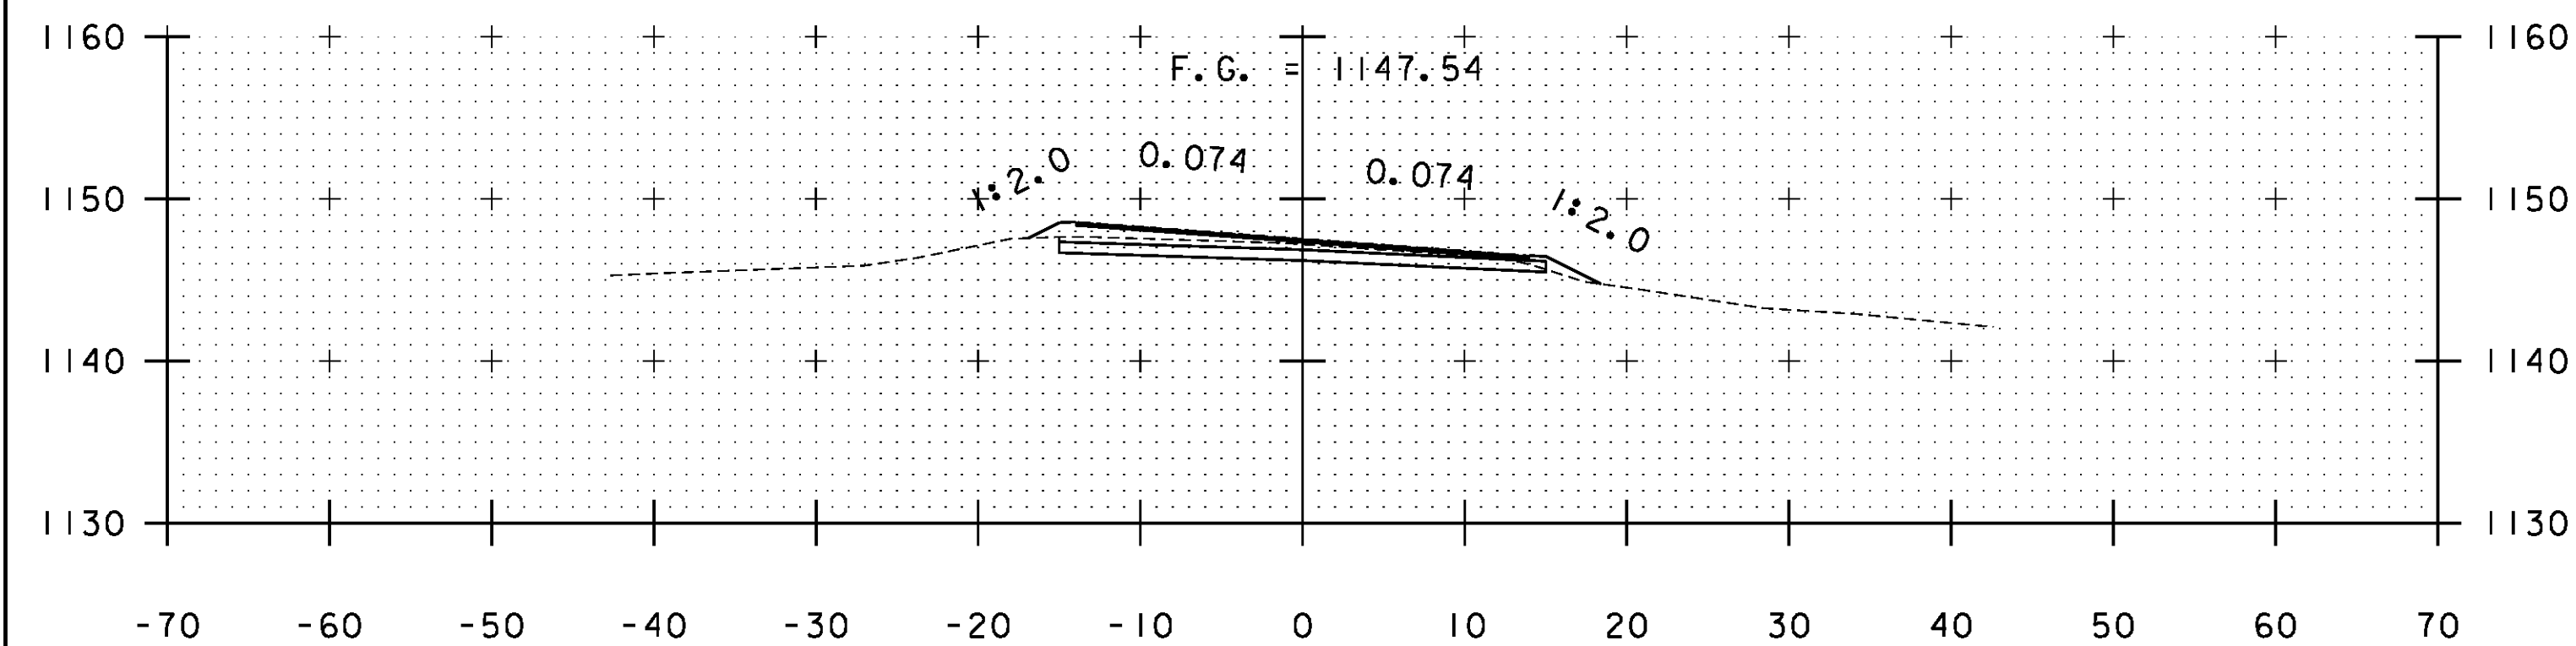

A 254+00

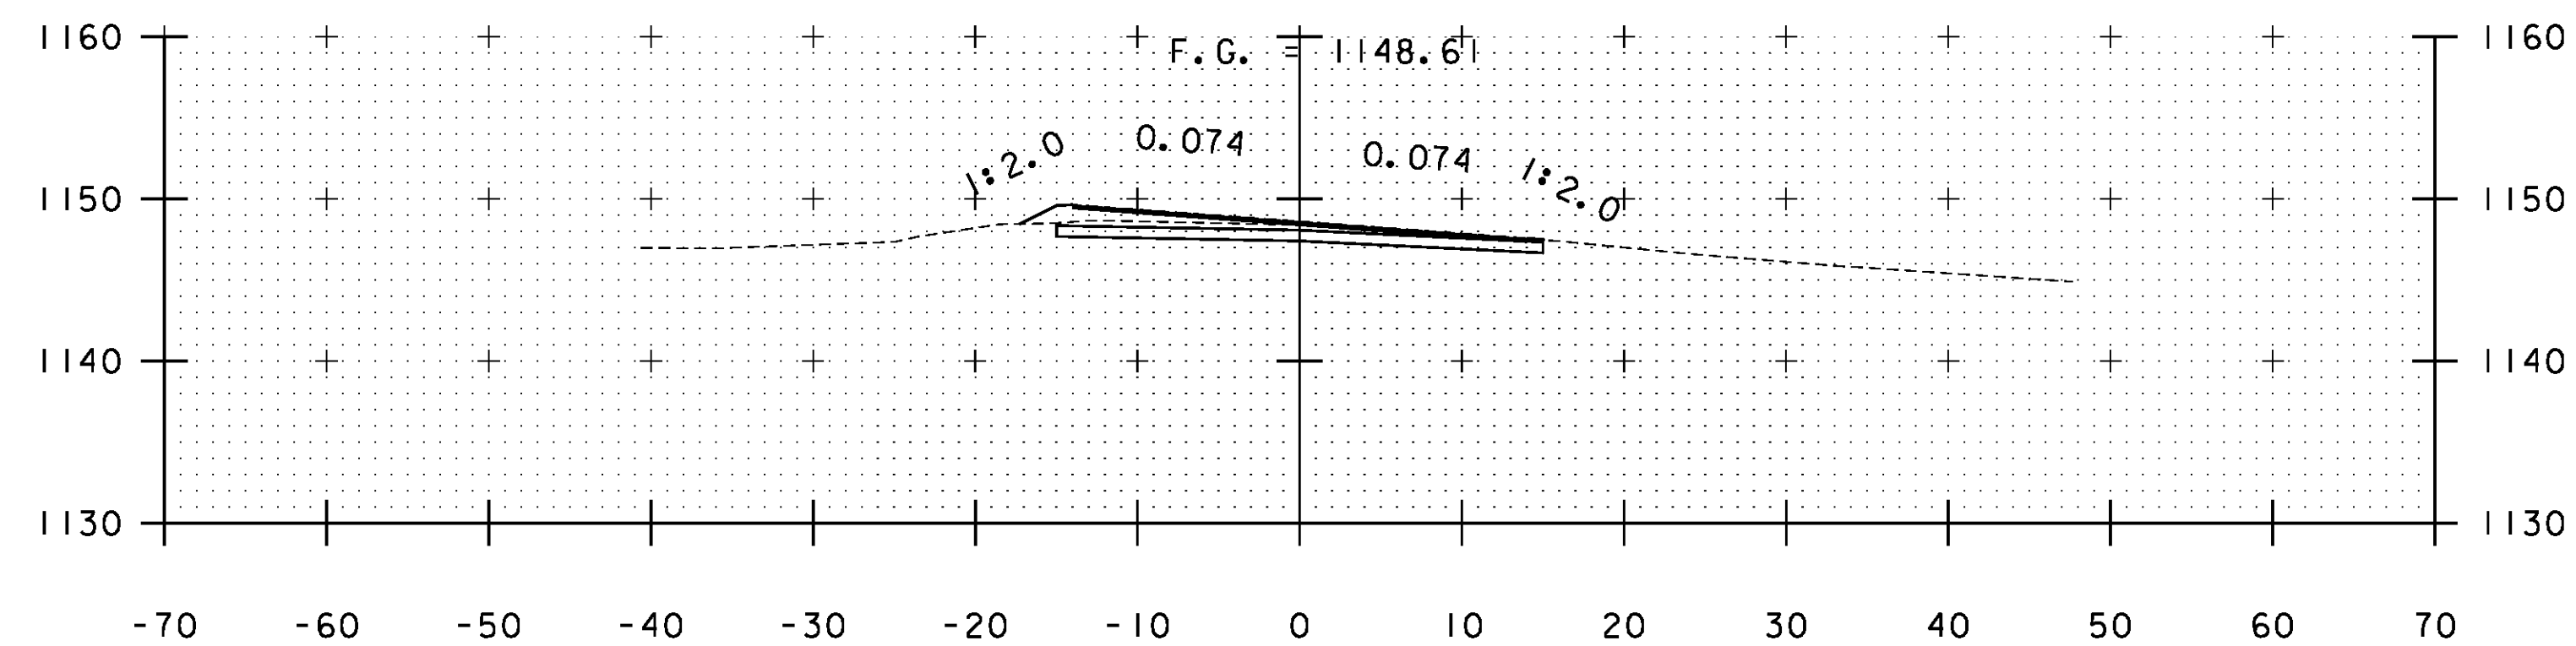

A 255+00

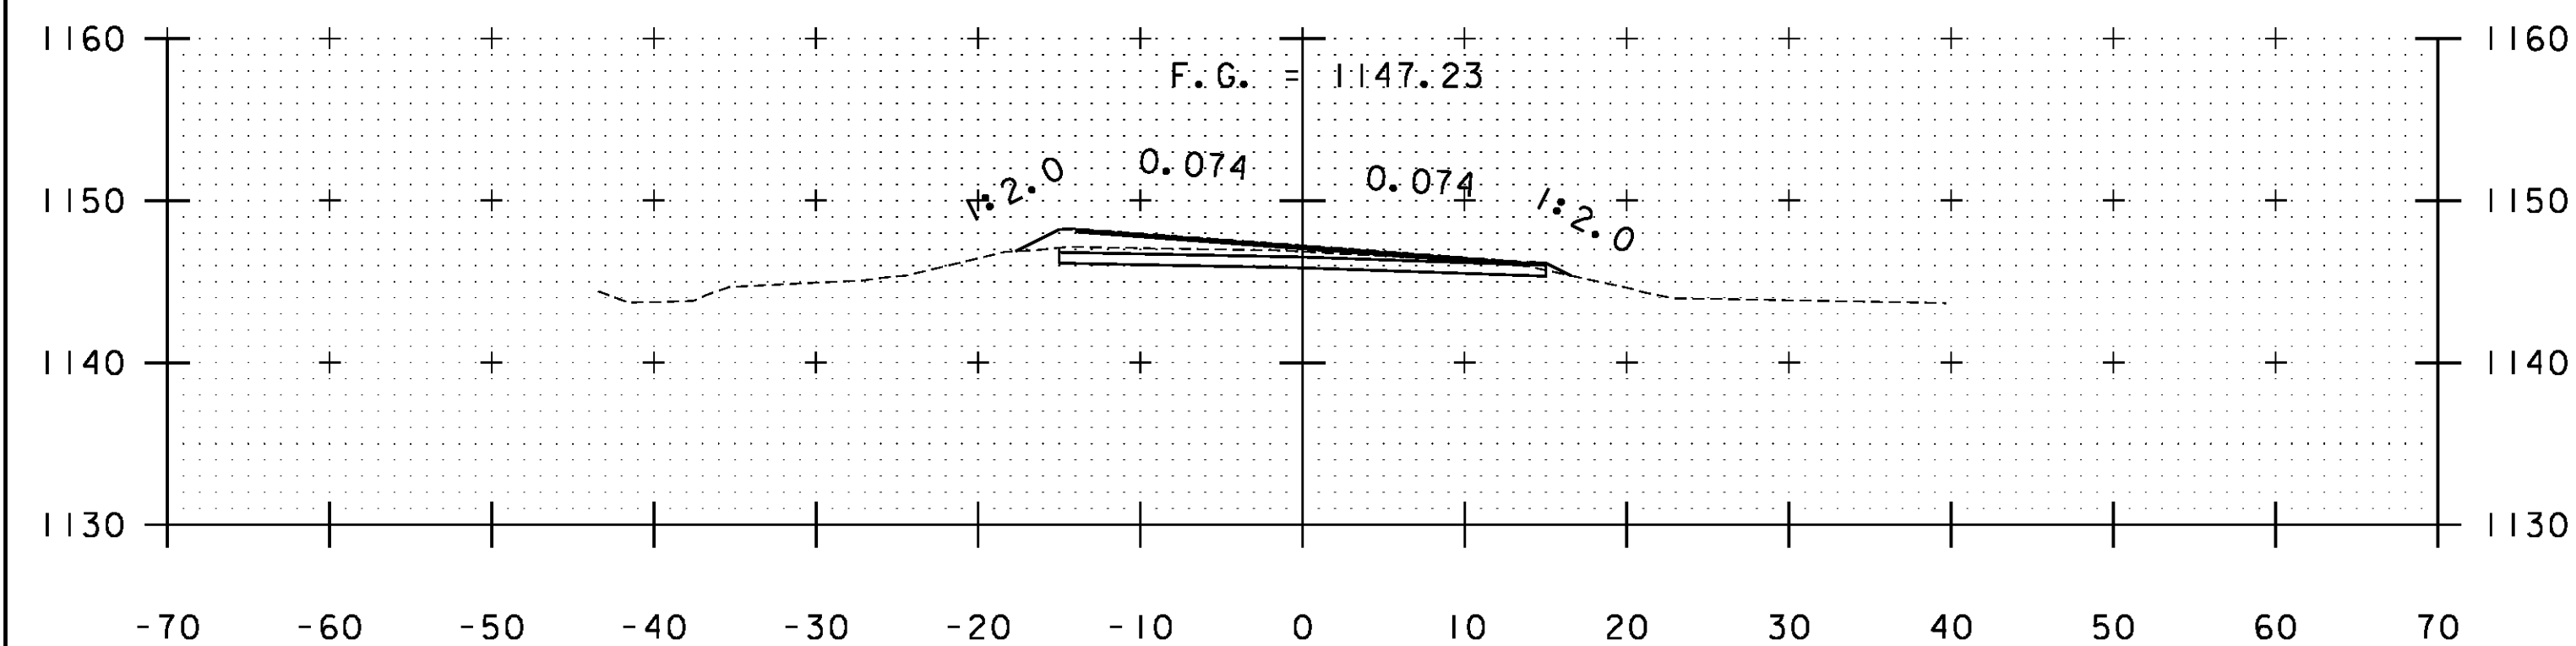

A 253+50

STA. A 253+50 TO STA. A 255+50

PROJECT NAME: WARDBORO-JAMAICA	PLOT DATE: 2/26/2014
PROJECT NUMBER: ER STP 013-1(17)	DRAWN BY: B. KIPP
FILE NAME: xs.dgn	CHECKED BY: HSD
PROJECT LEADER: K. UPMAL	SHEET 275 OF 444
DESIGNED BY: B. KIPP	CROSS SECTIONS