




A 263+00

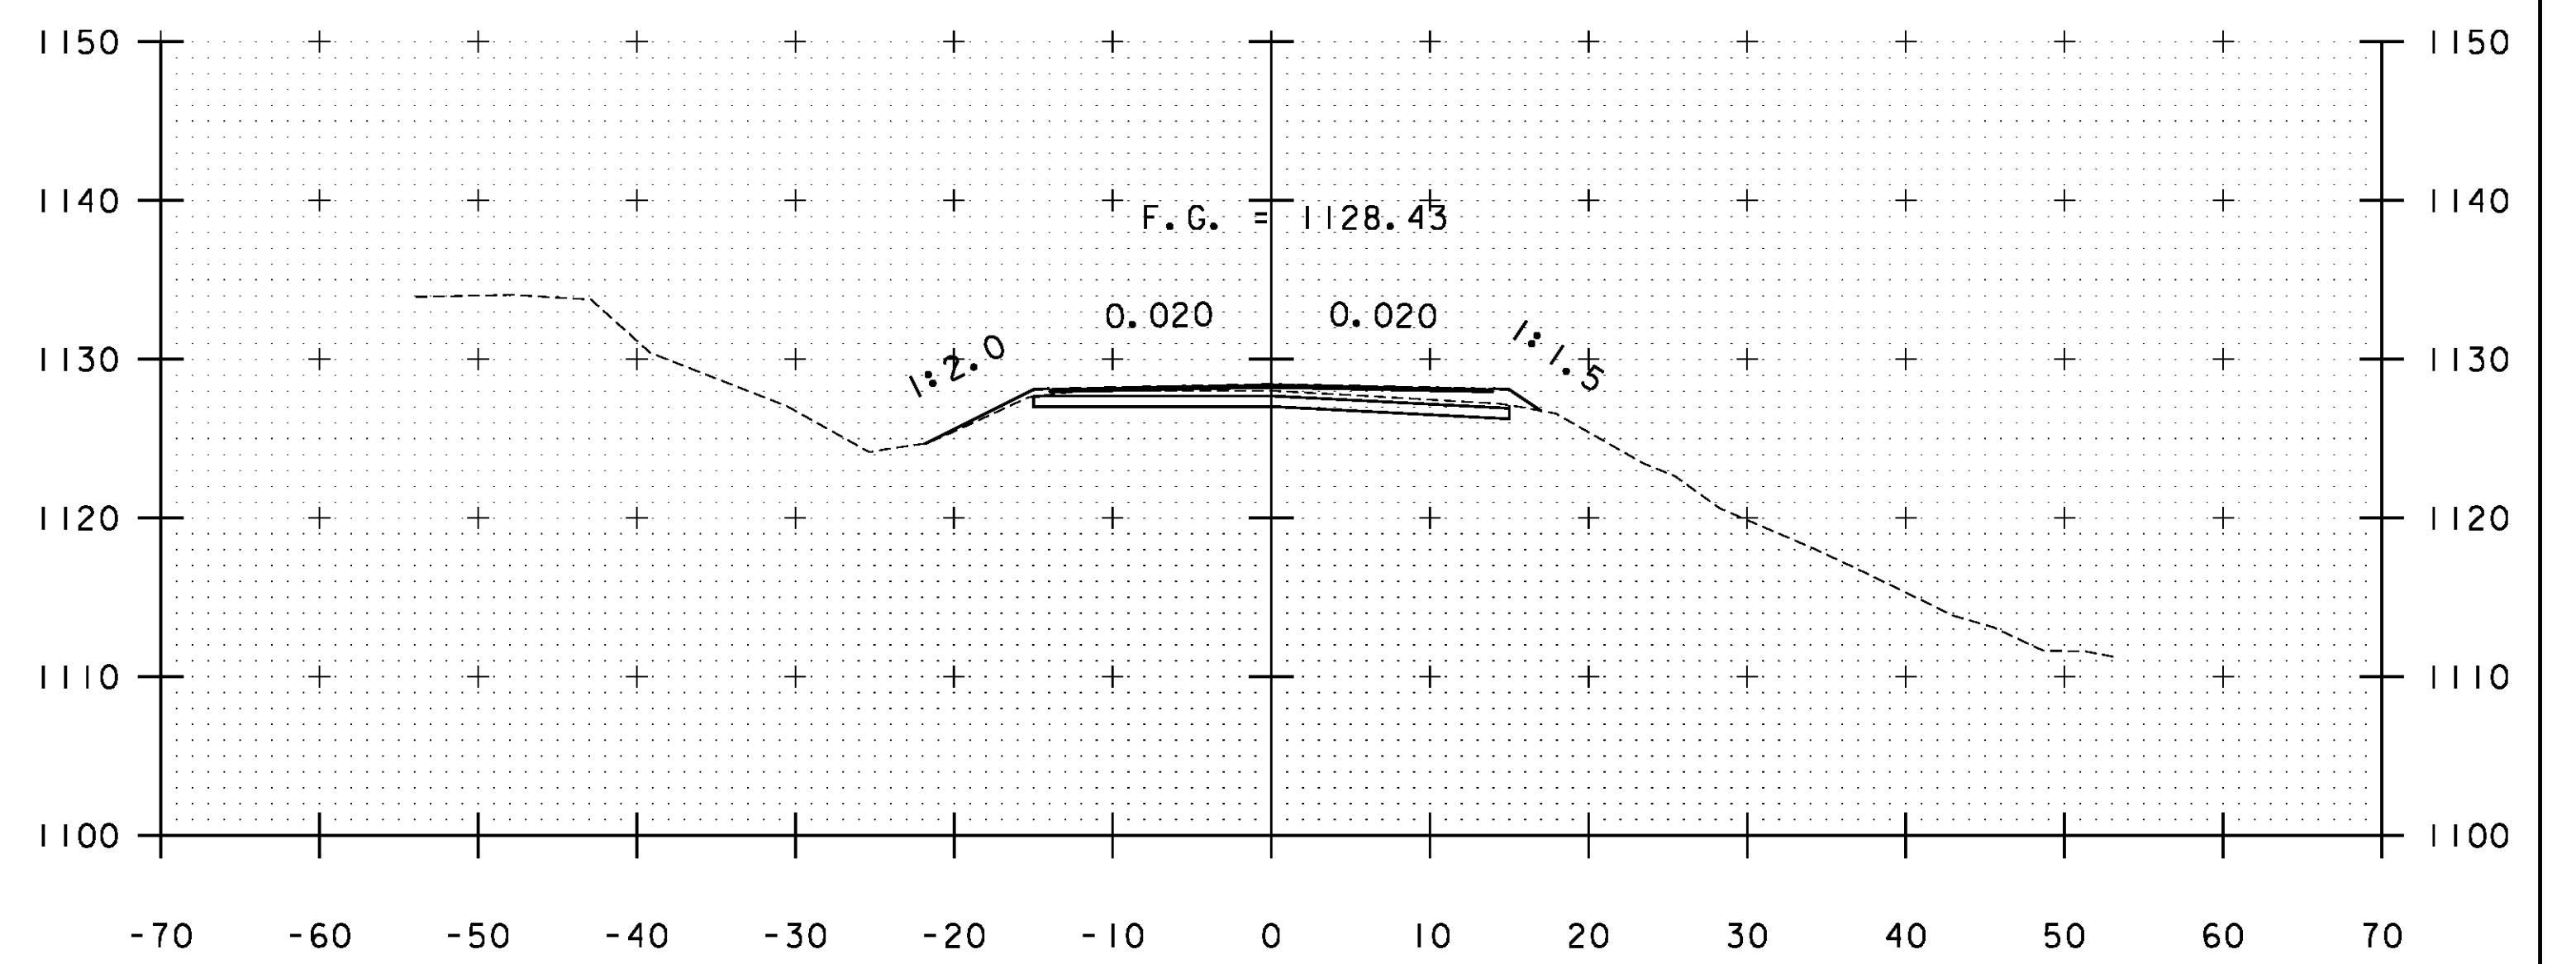

A 264+00

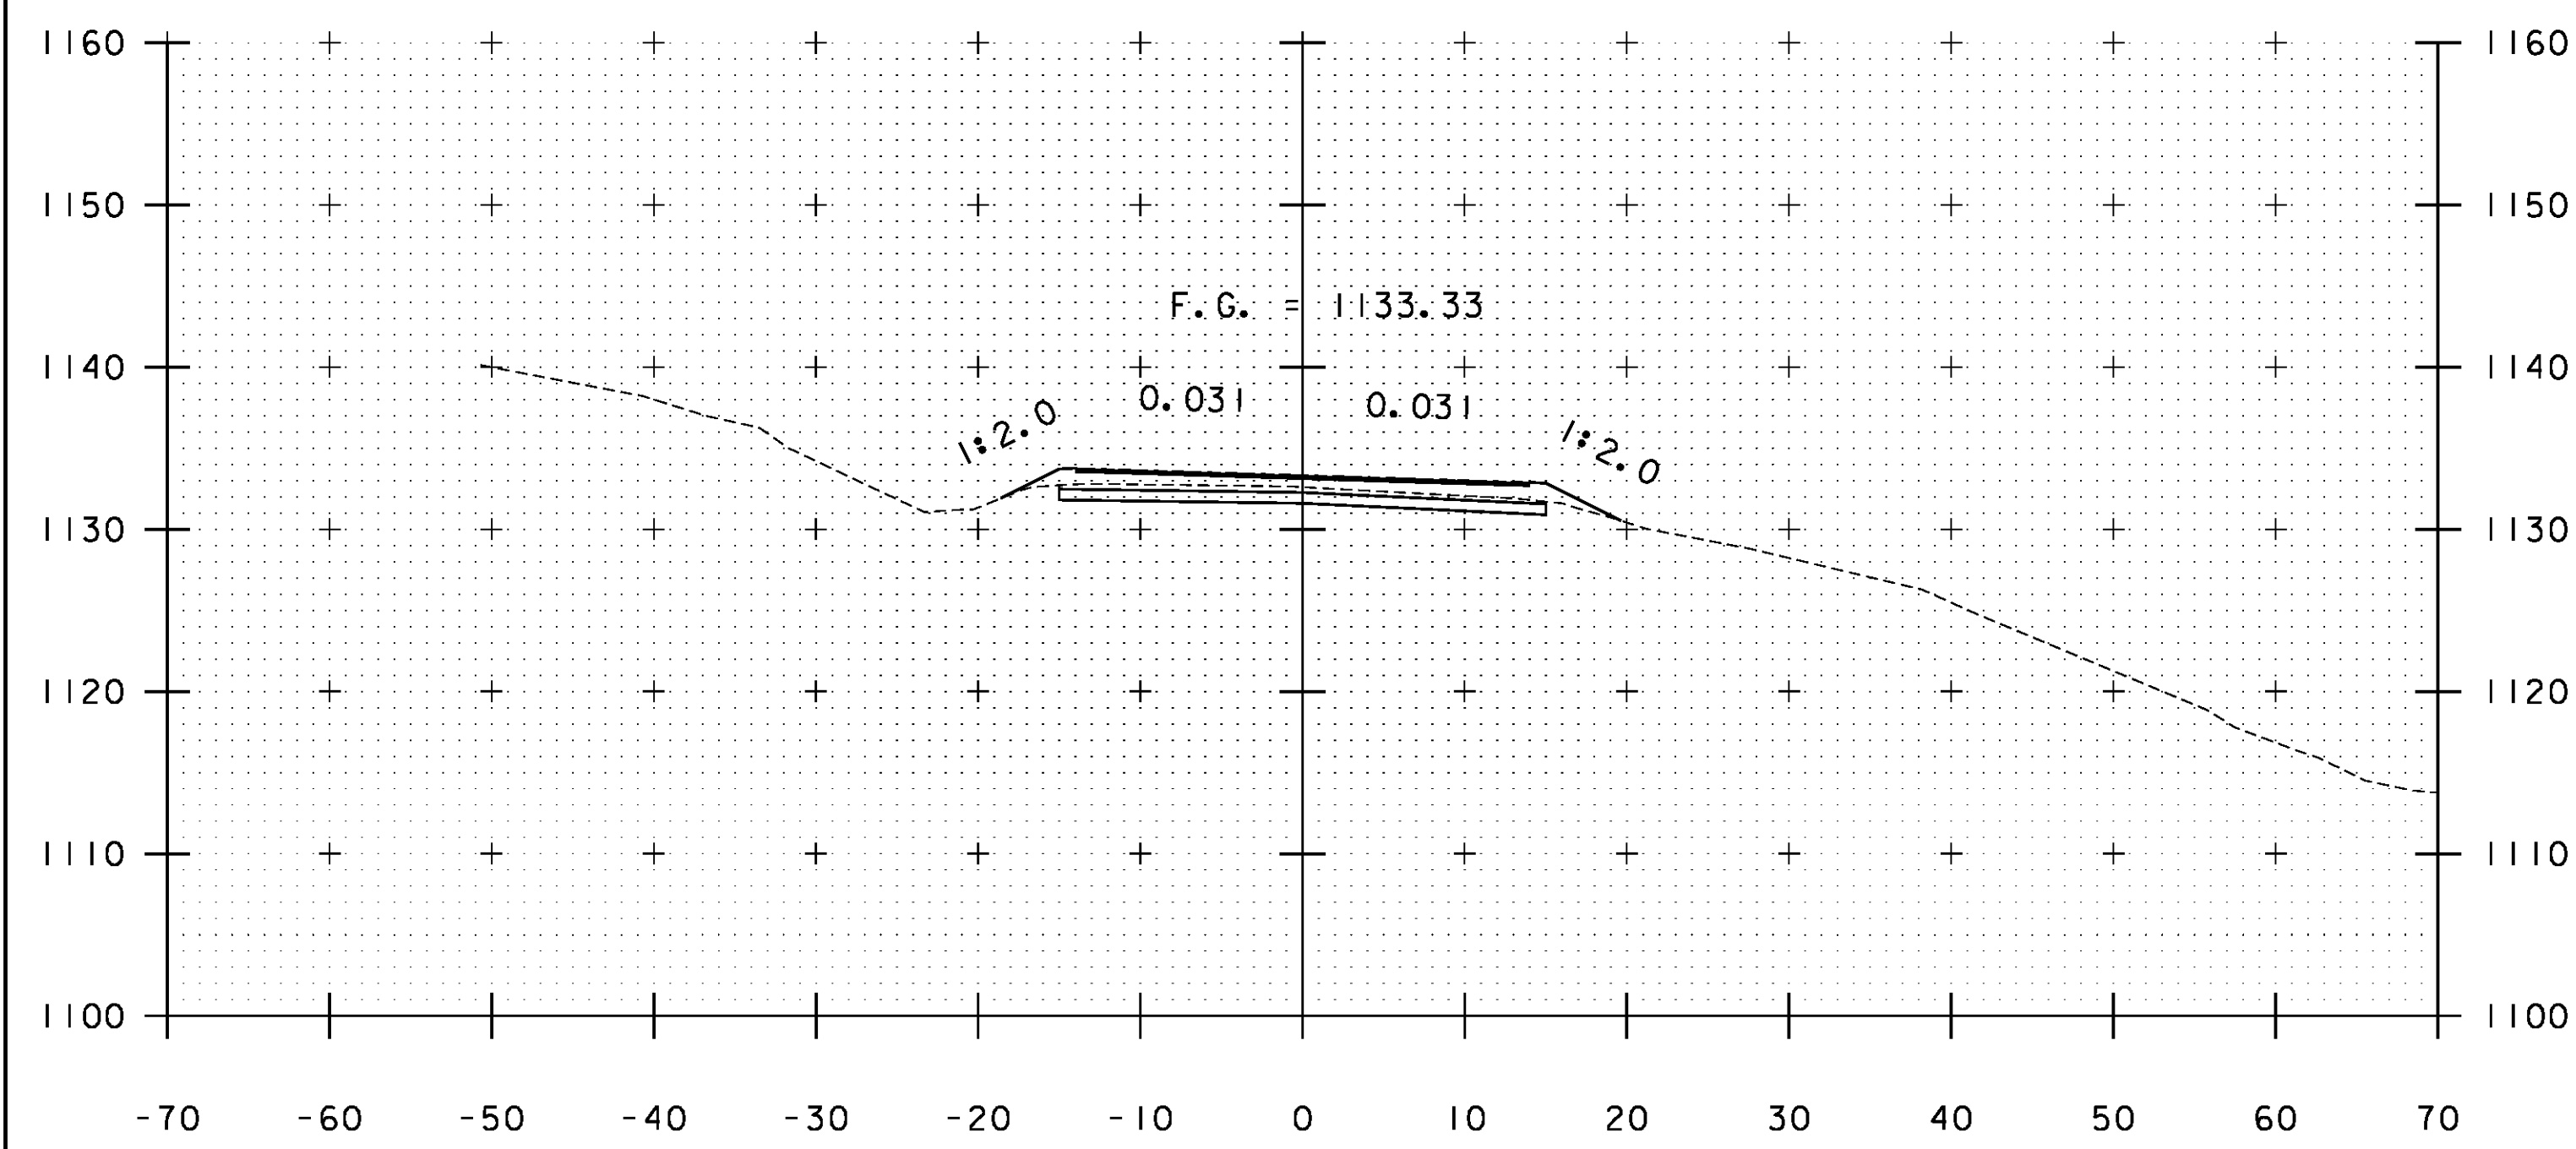

A 262+50

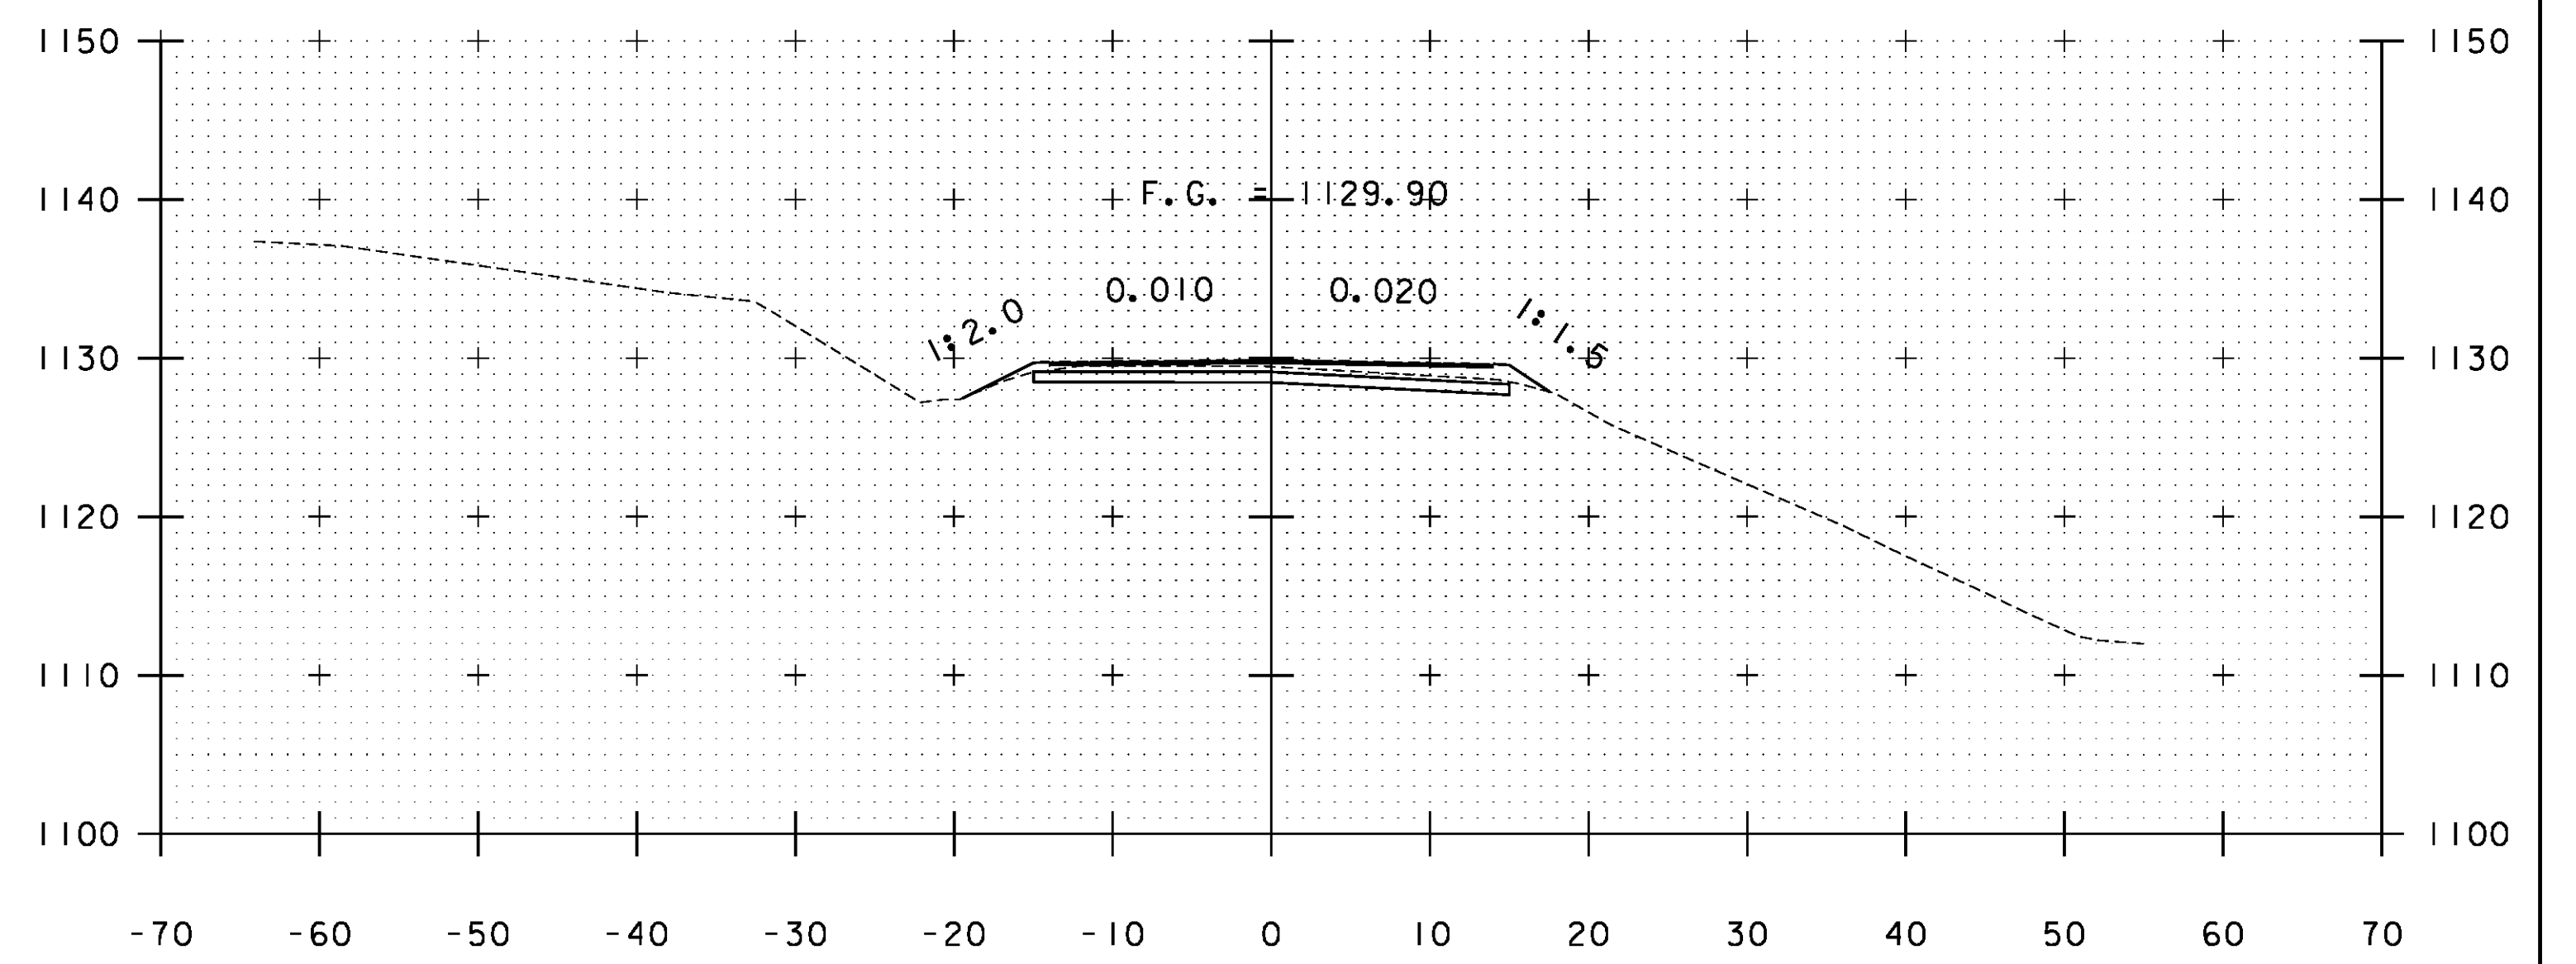

A 263+50

STA. A 262+50 TO STA. A 264+00

PROJECT NAME:	WARDSBORO-JAMAICA	FILE NAME:	xs.dgn	PLOT DATE:	2/26/2014
PROJECT NUMBER:	ER STP 013-1(17)	PROJECT LEADER:	K. UPMAL	DRAWN BY:	B. KIPP
		DESIGNED BY:	B. KIPP	CHECKED BY:	HSD
		CROSS SECTIONS		SHEET	279 OF 444