




A 266+50

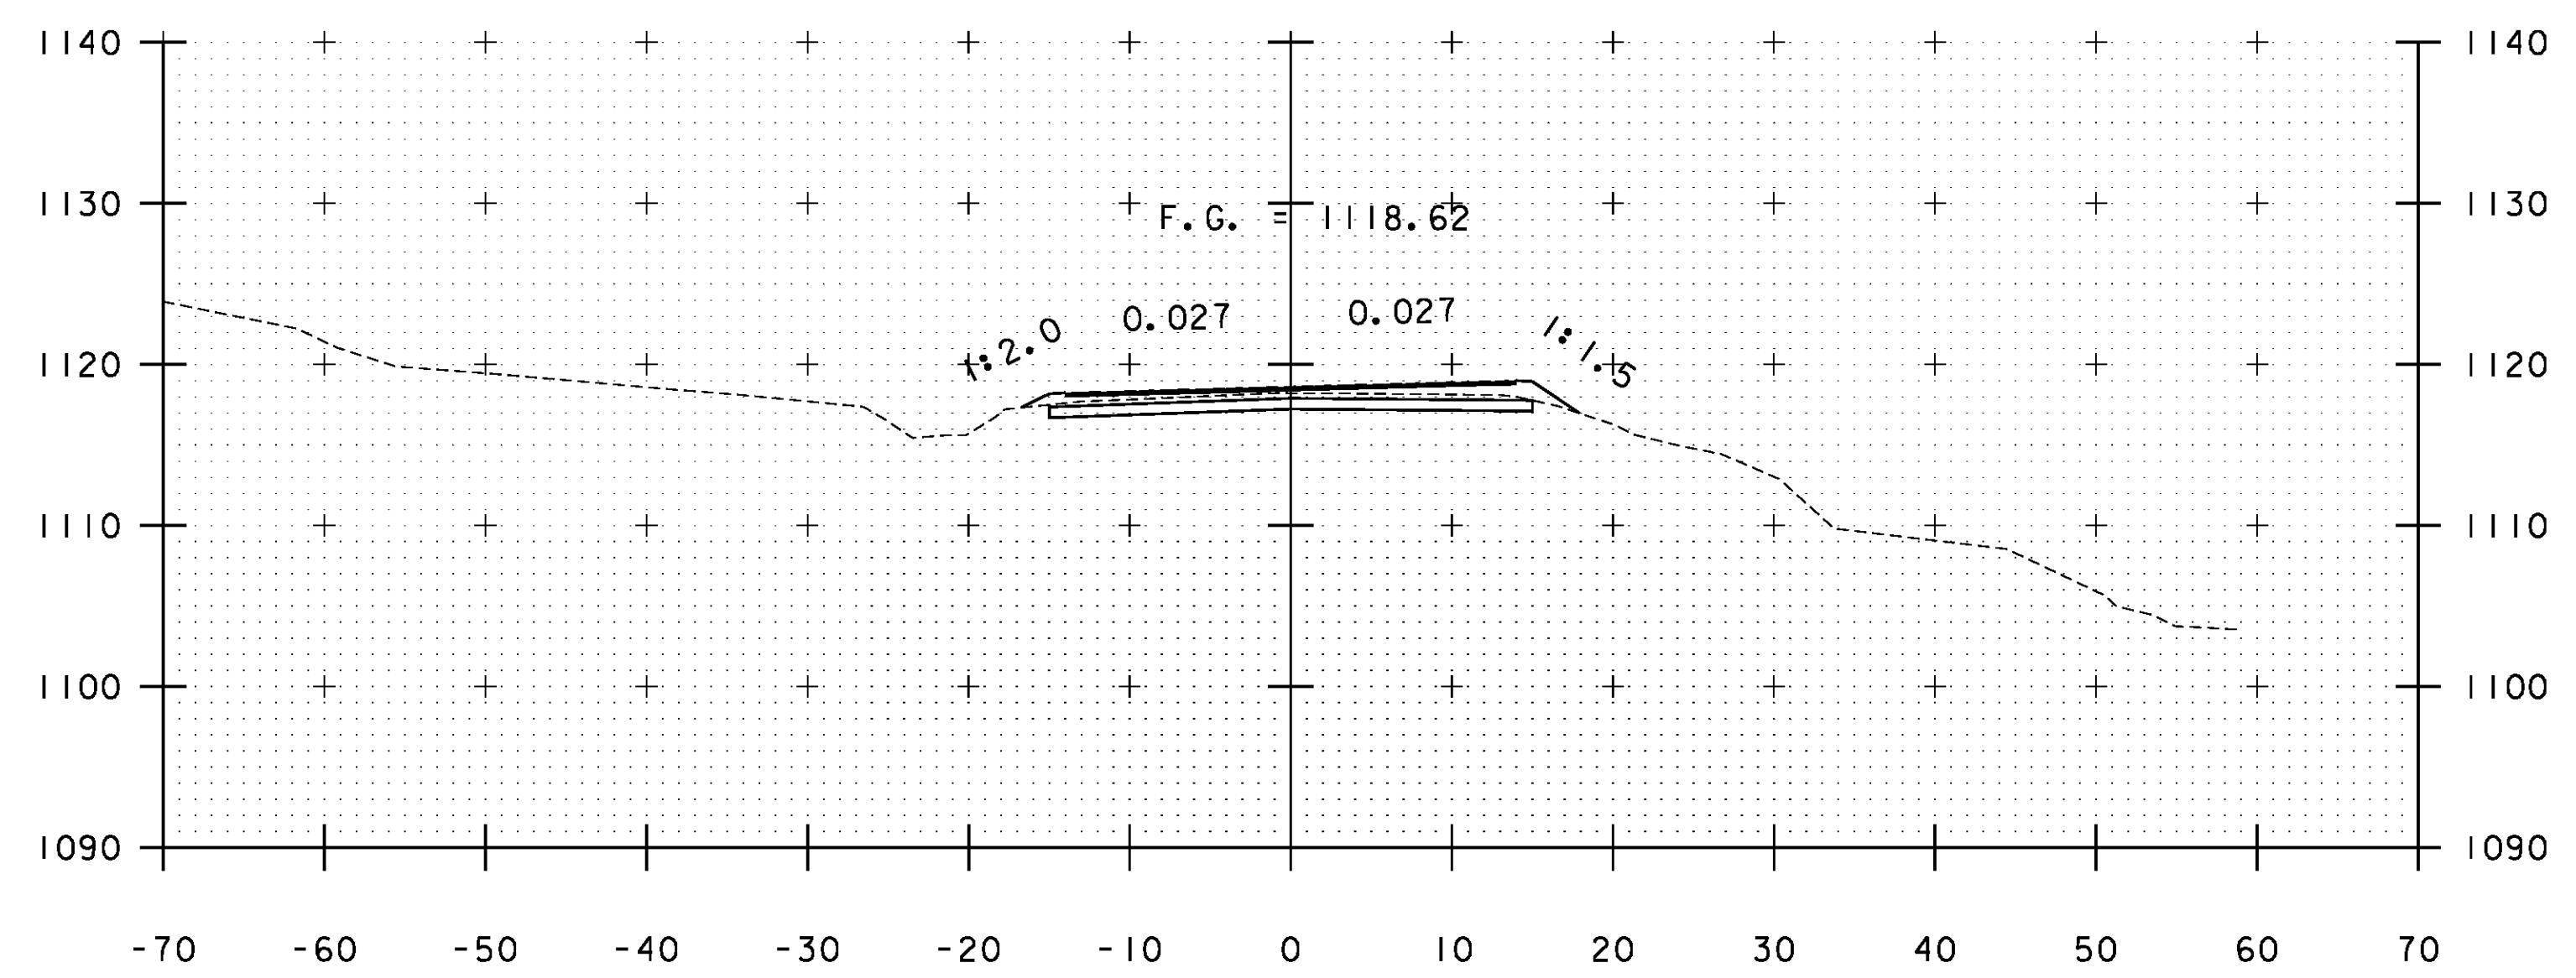

A 267+50

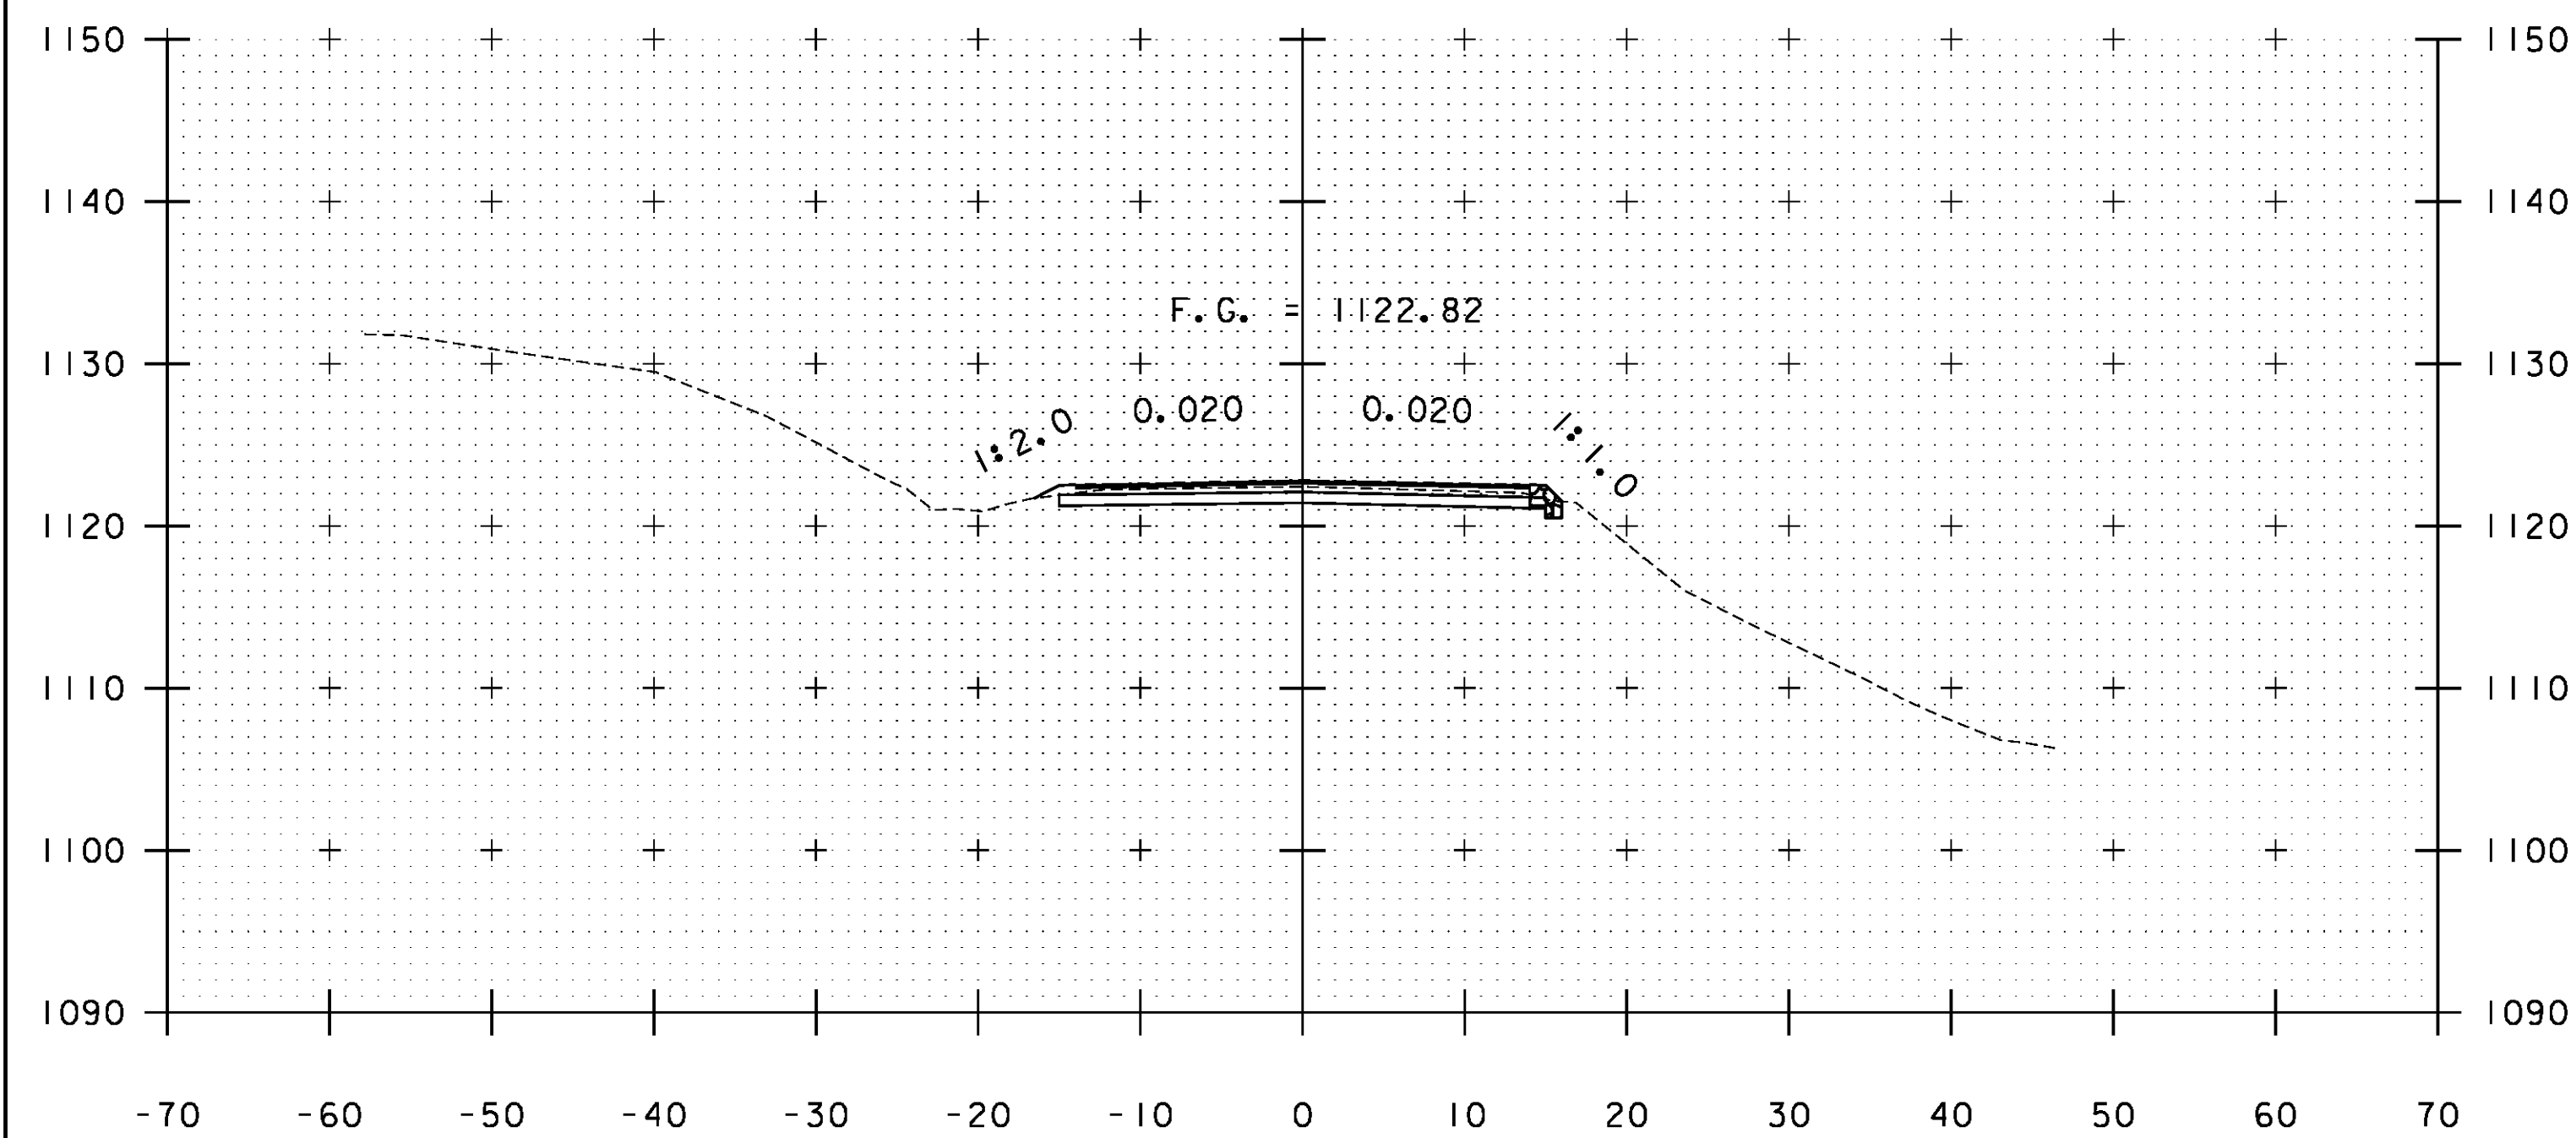

A 266+00

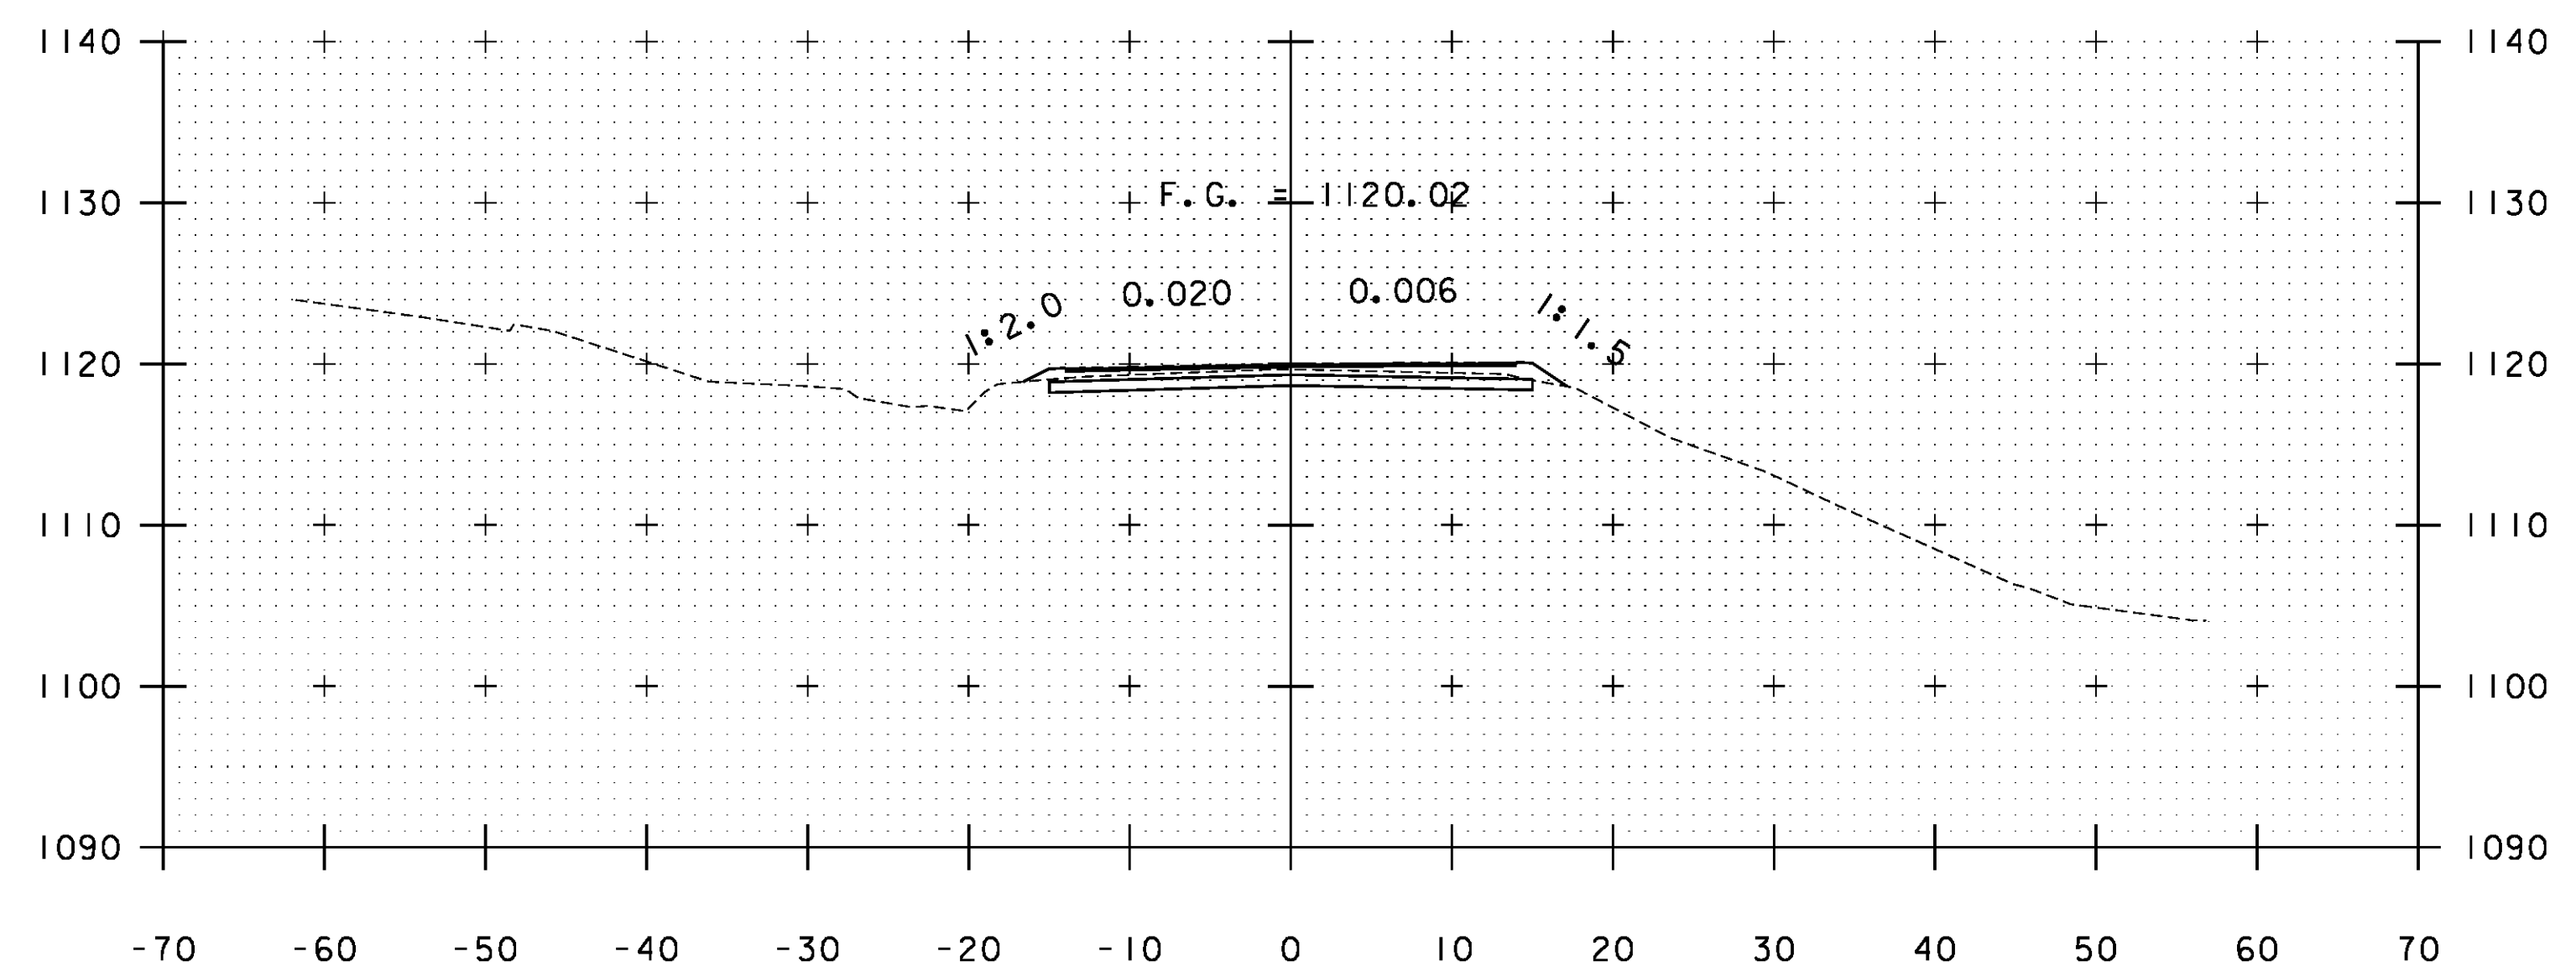

A 267+00

STA. A 266+00 TO STA. A 267+50

| | | | | | |
|-----------------|-------------------|-----------------|----------|-------------|------------|
| PROJECT NAME: | WARDSBORO-JAMAICA | FILE NAME: | xs.dgn | PLOT DATE: | 2/26/2014 |
| PROJECT NUMBER: | ER STP 013-1(17) | PROJECT LEADER: | K. UPMAL | DRAWN BY: | B. KIPP |
| | | DESIGNED BY: | B. KIPP | CHECKED BY: | HSD |
| | | CROSS SECTIONS | | SHEET | 281 OF 444 |