




A 274+50

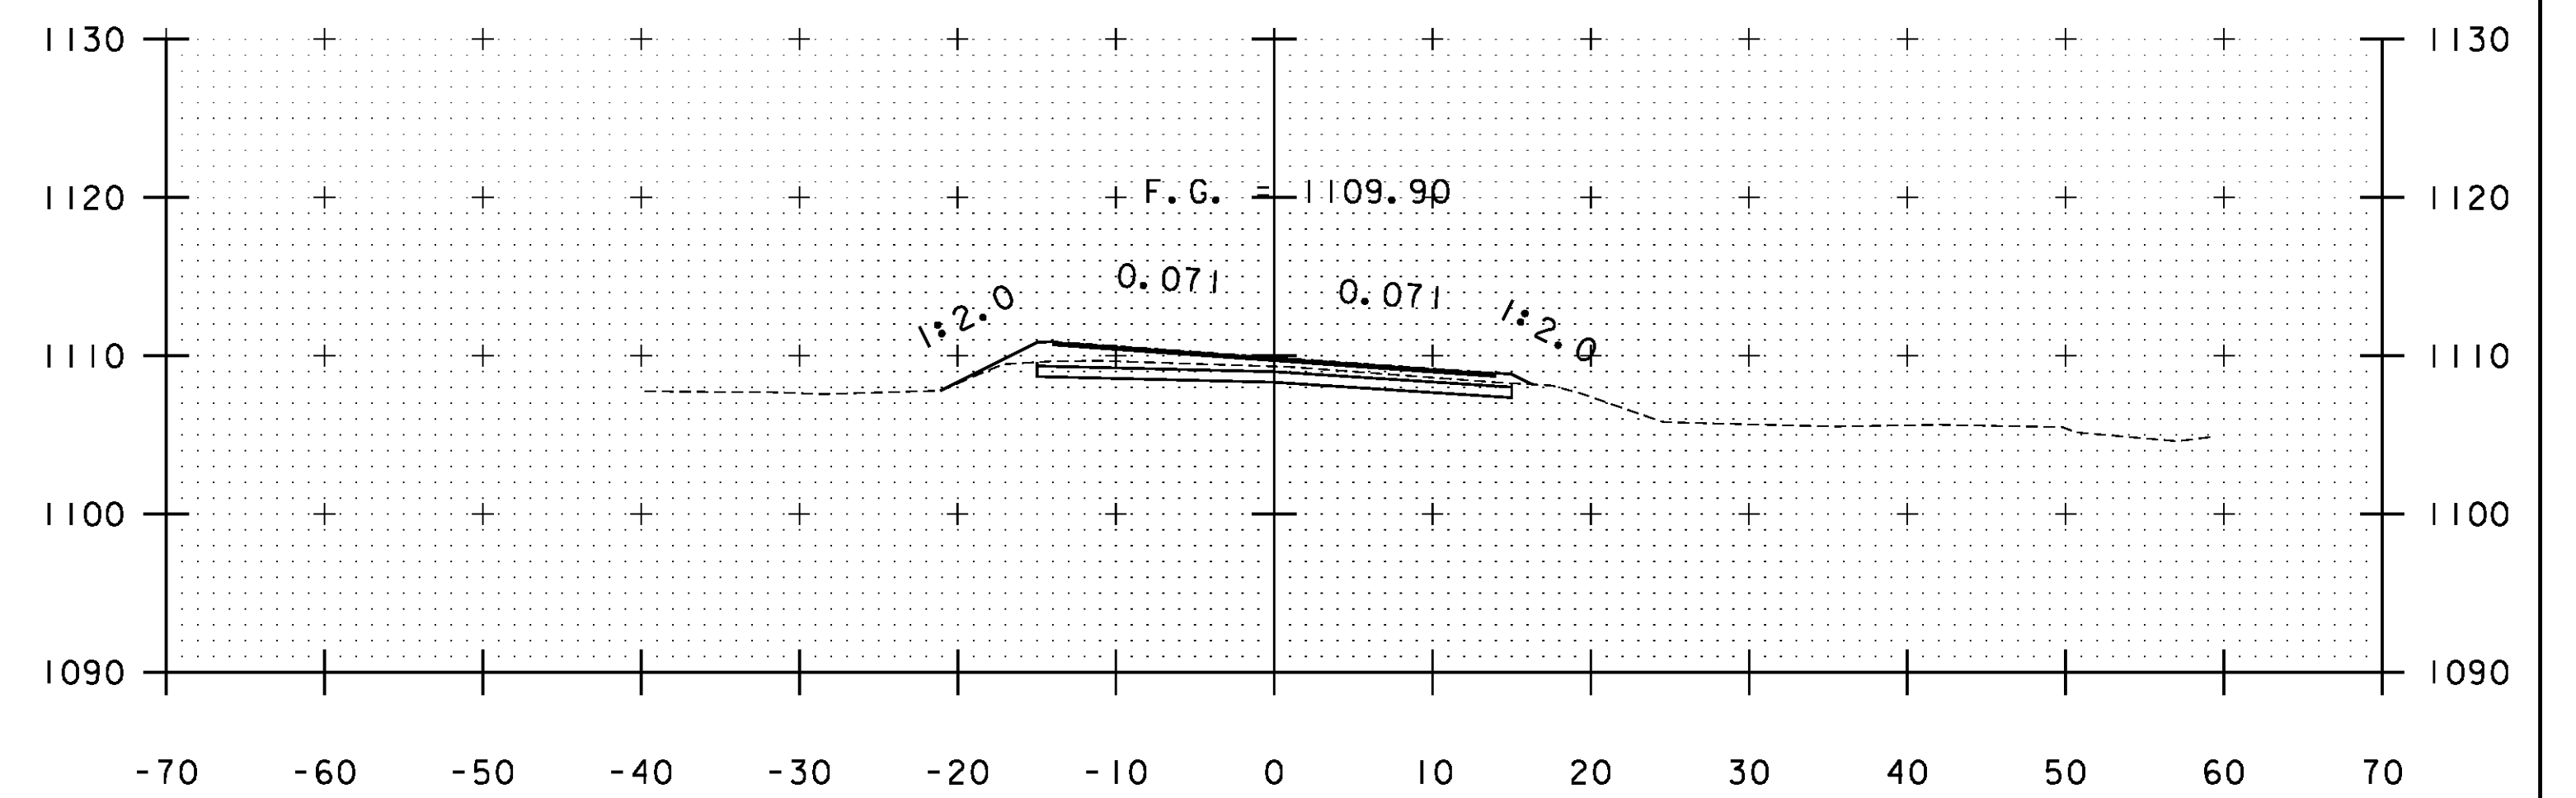

A 274+00

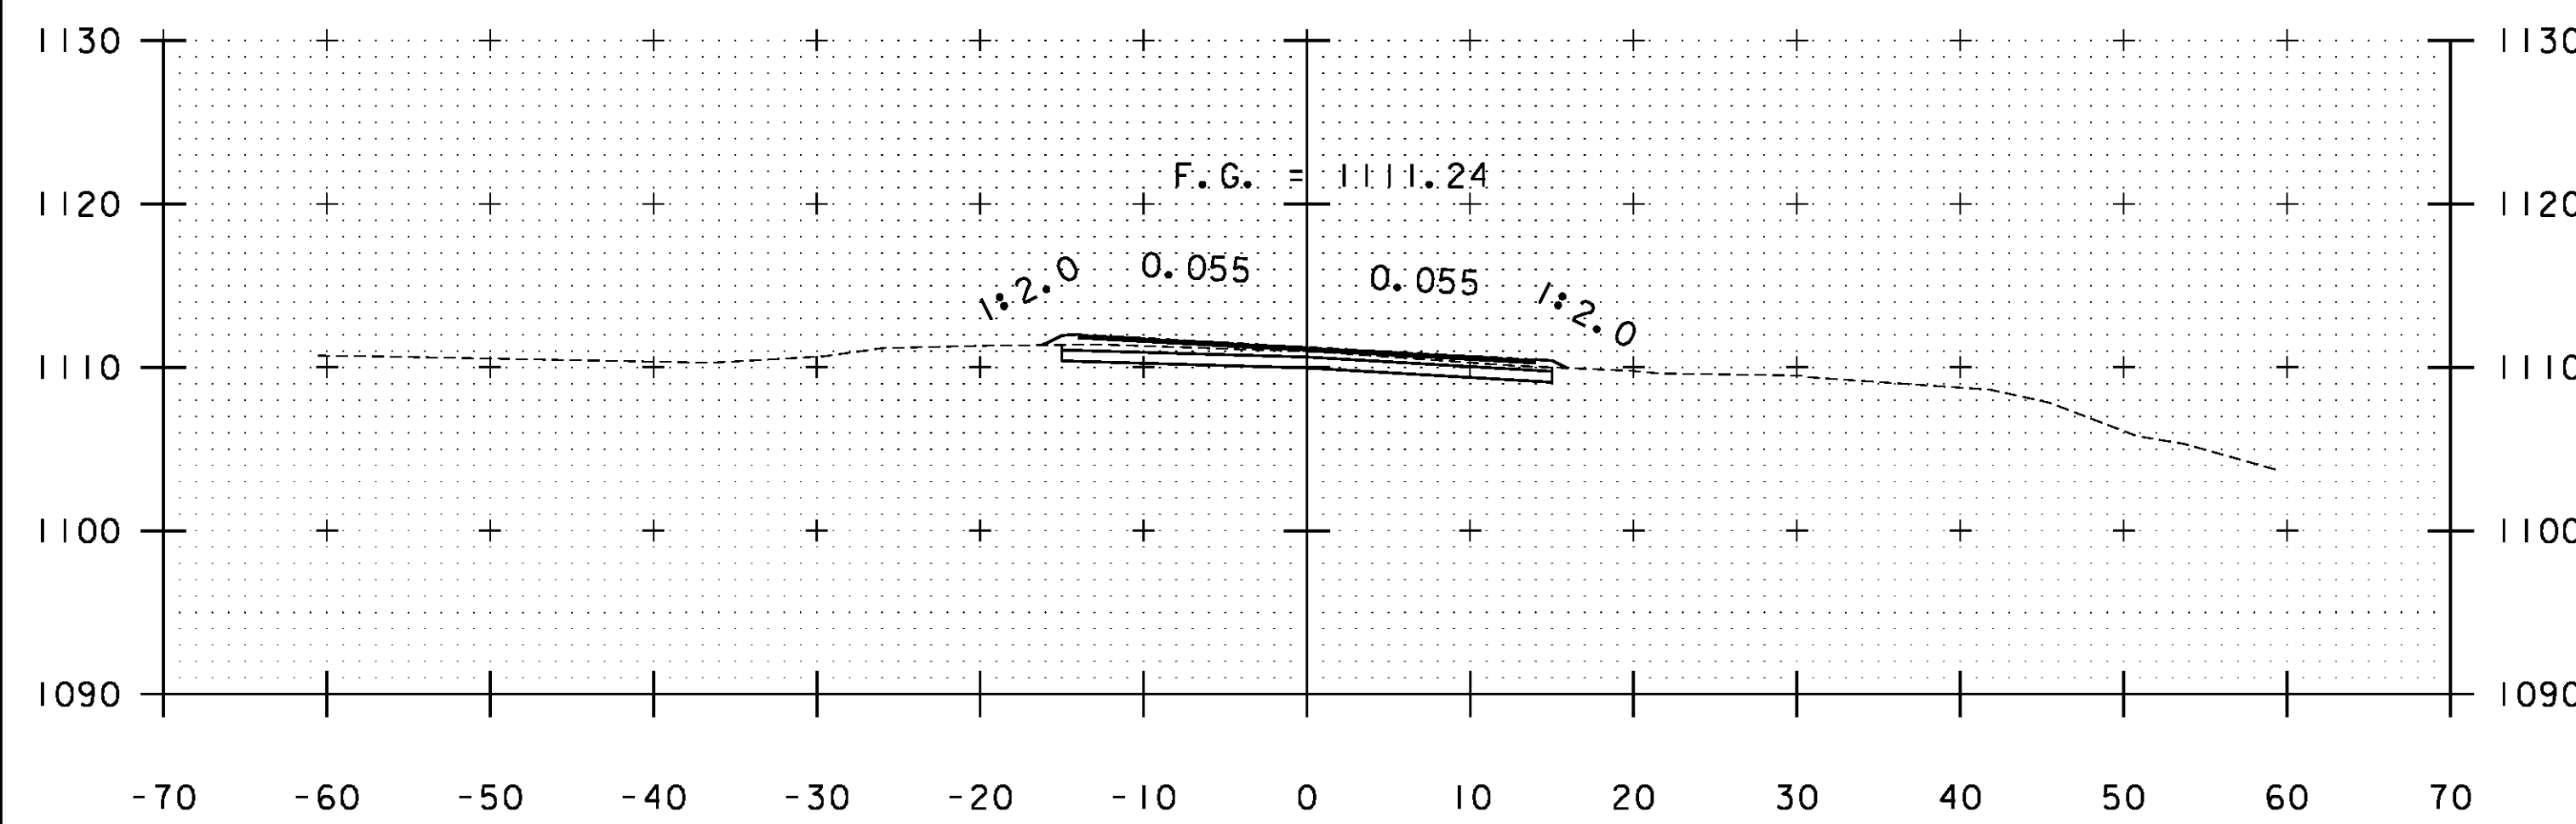

A 273+00

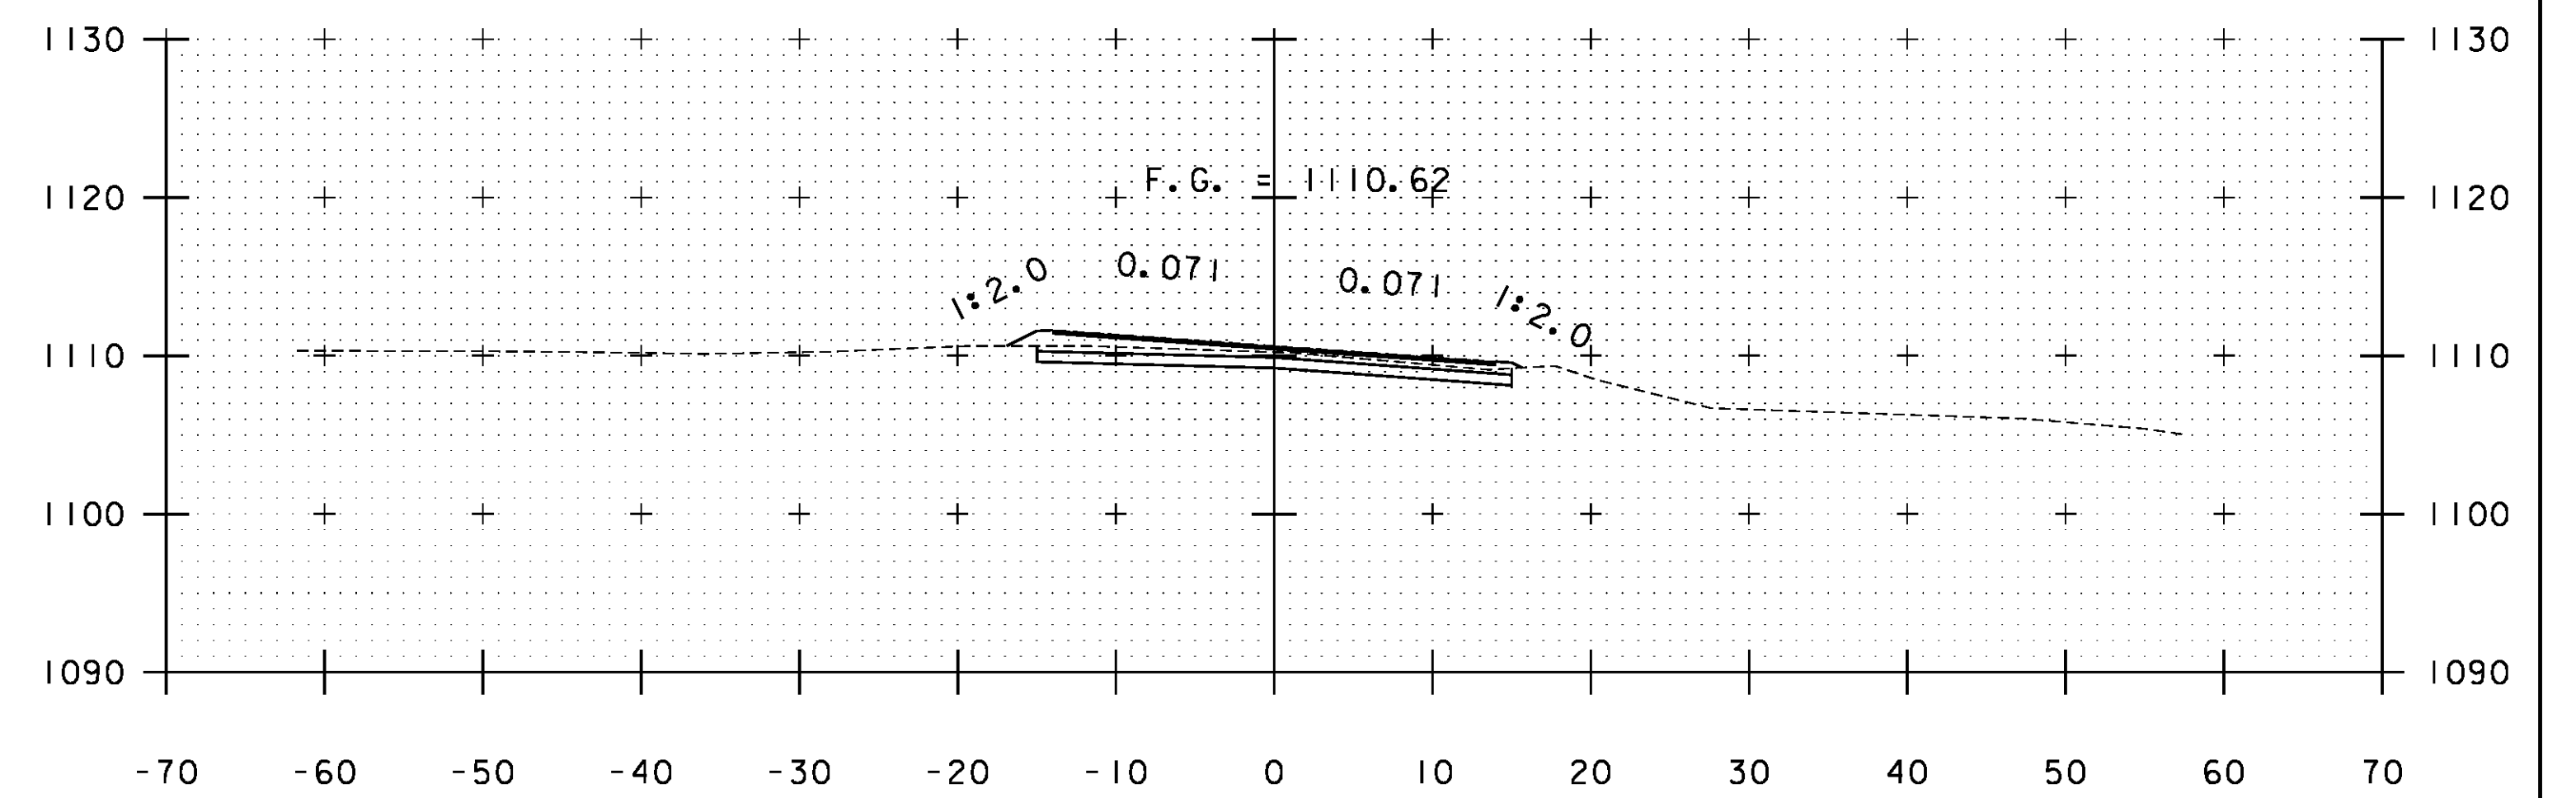

A 273+50

STA. A 273+00 TO STA. A 274+50

PROJECT NAME:	WARDSBORO-JAMAICA	PLOT DATE:	2/26/2014
PROJECT NUMBER:	ER STP 013-1(17)	DRAWN BY:	B. KIPP
FILE NAME:	xs.dgn	CHECKED BY:	HSD
PROJECT LEADER:	K. UPMAL	SHEET	284 OF 444
DESIGNED BY:	B. KIPP	CROSS SECTIONS	