




A 276+00

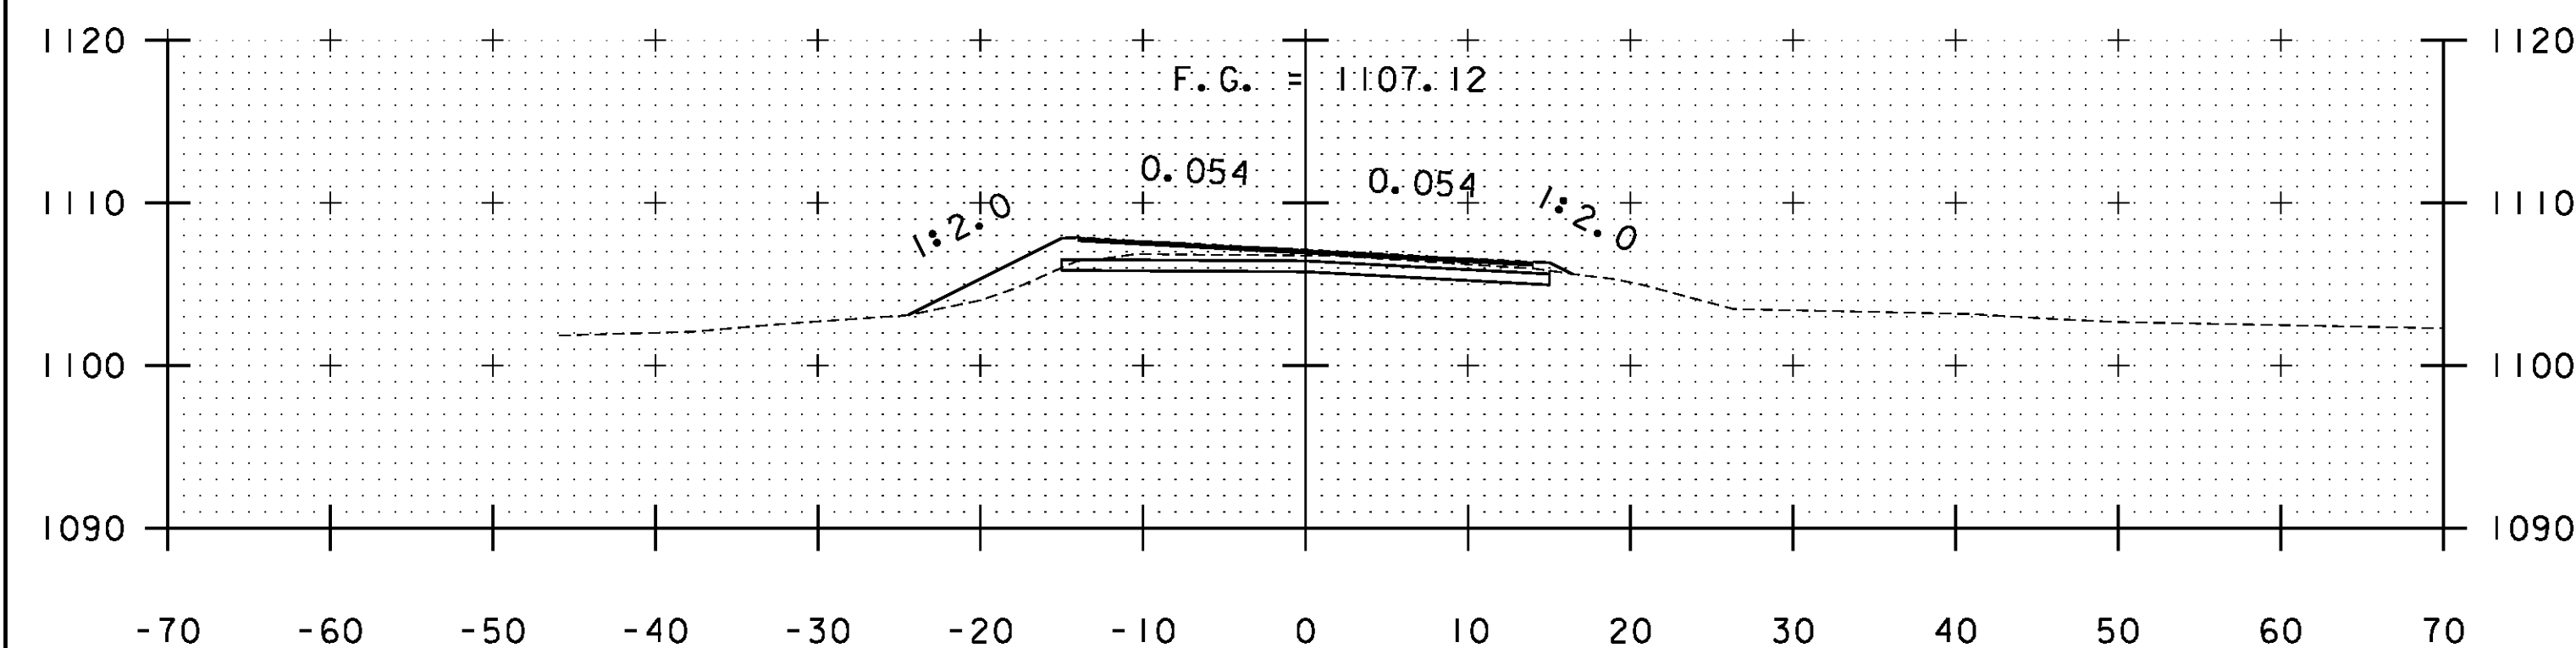


A 275+50

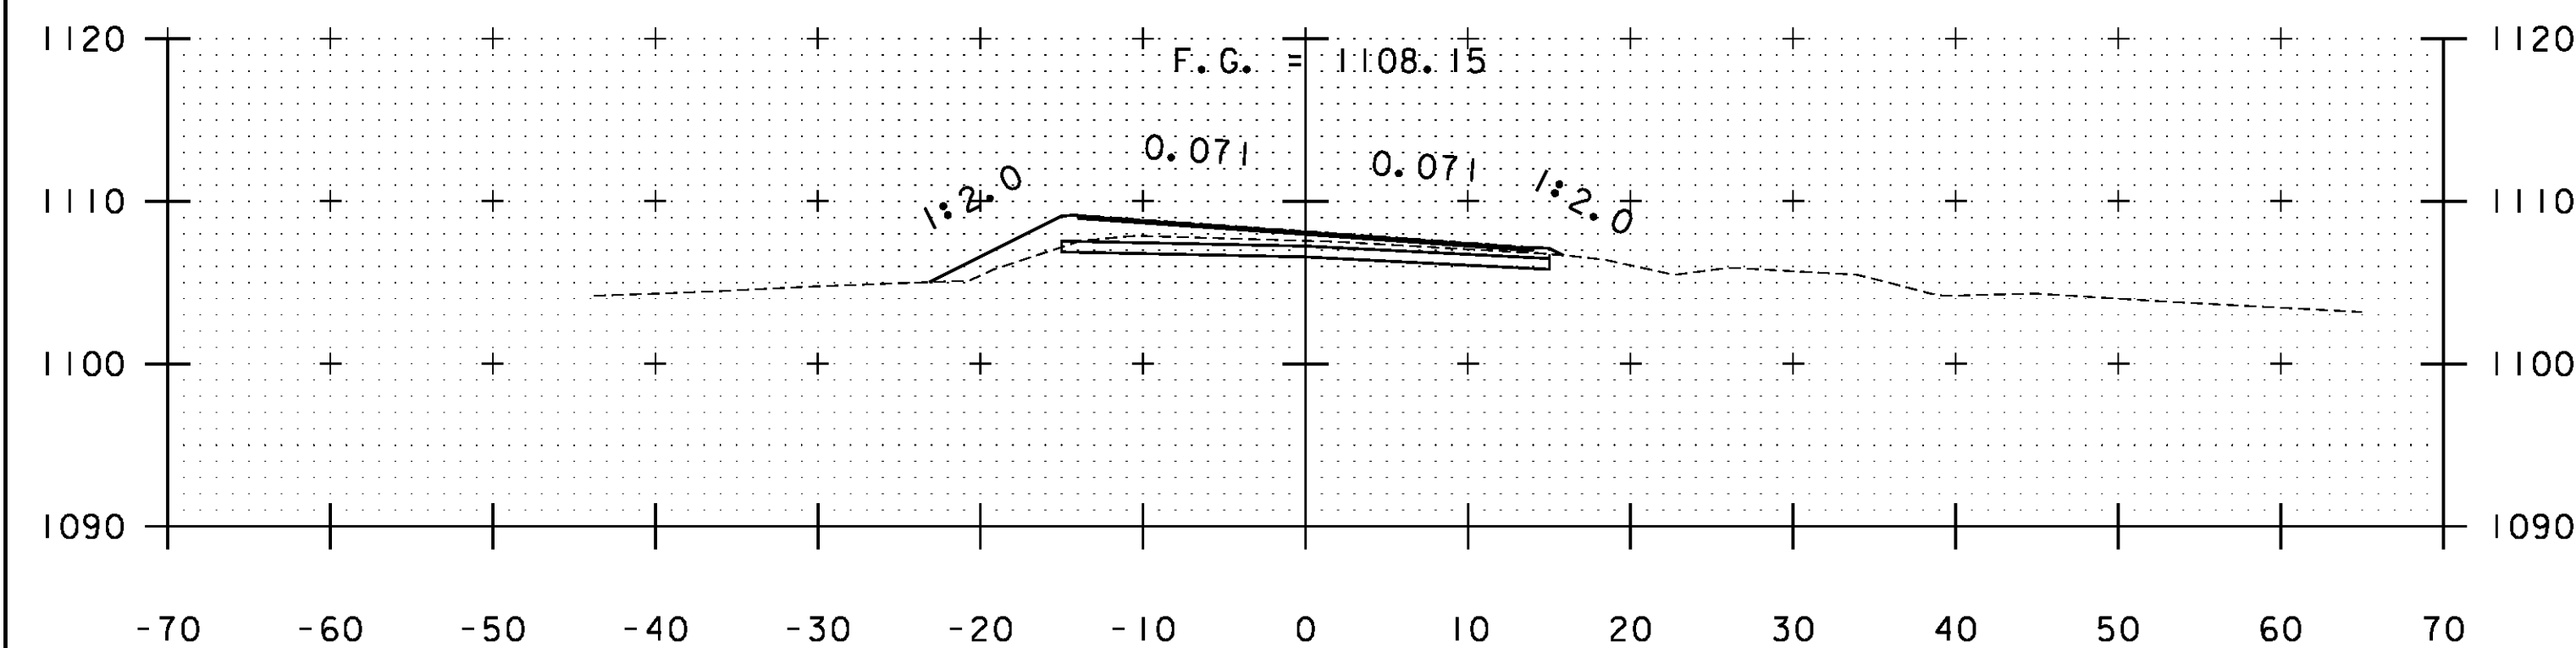


A 275+00

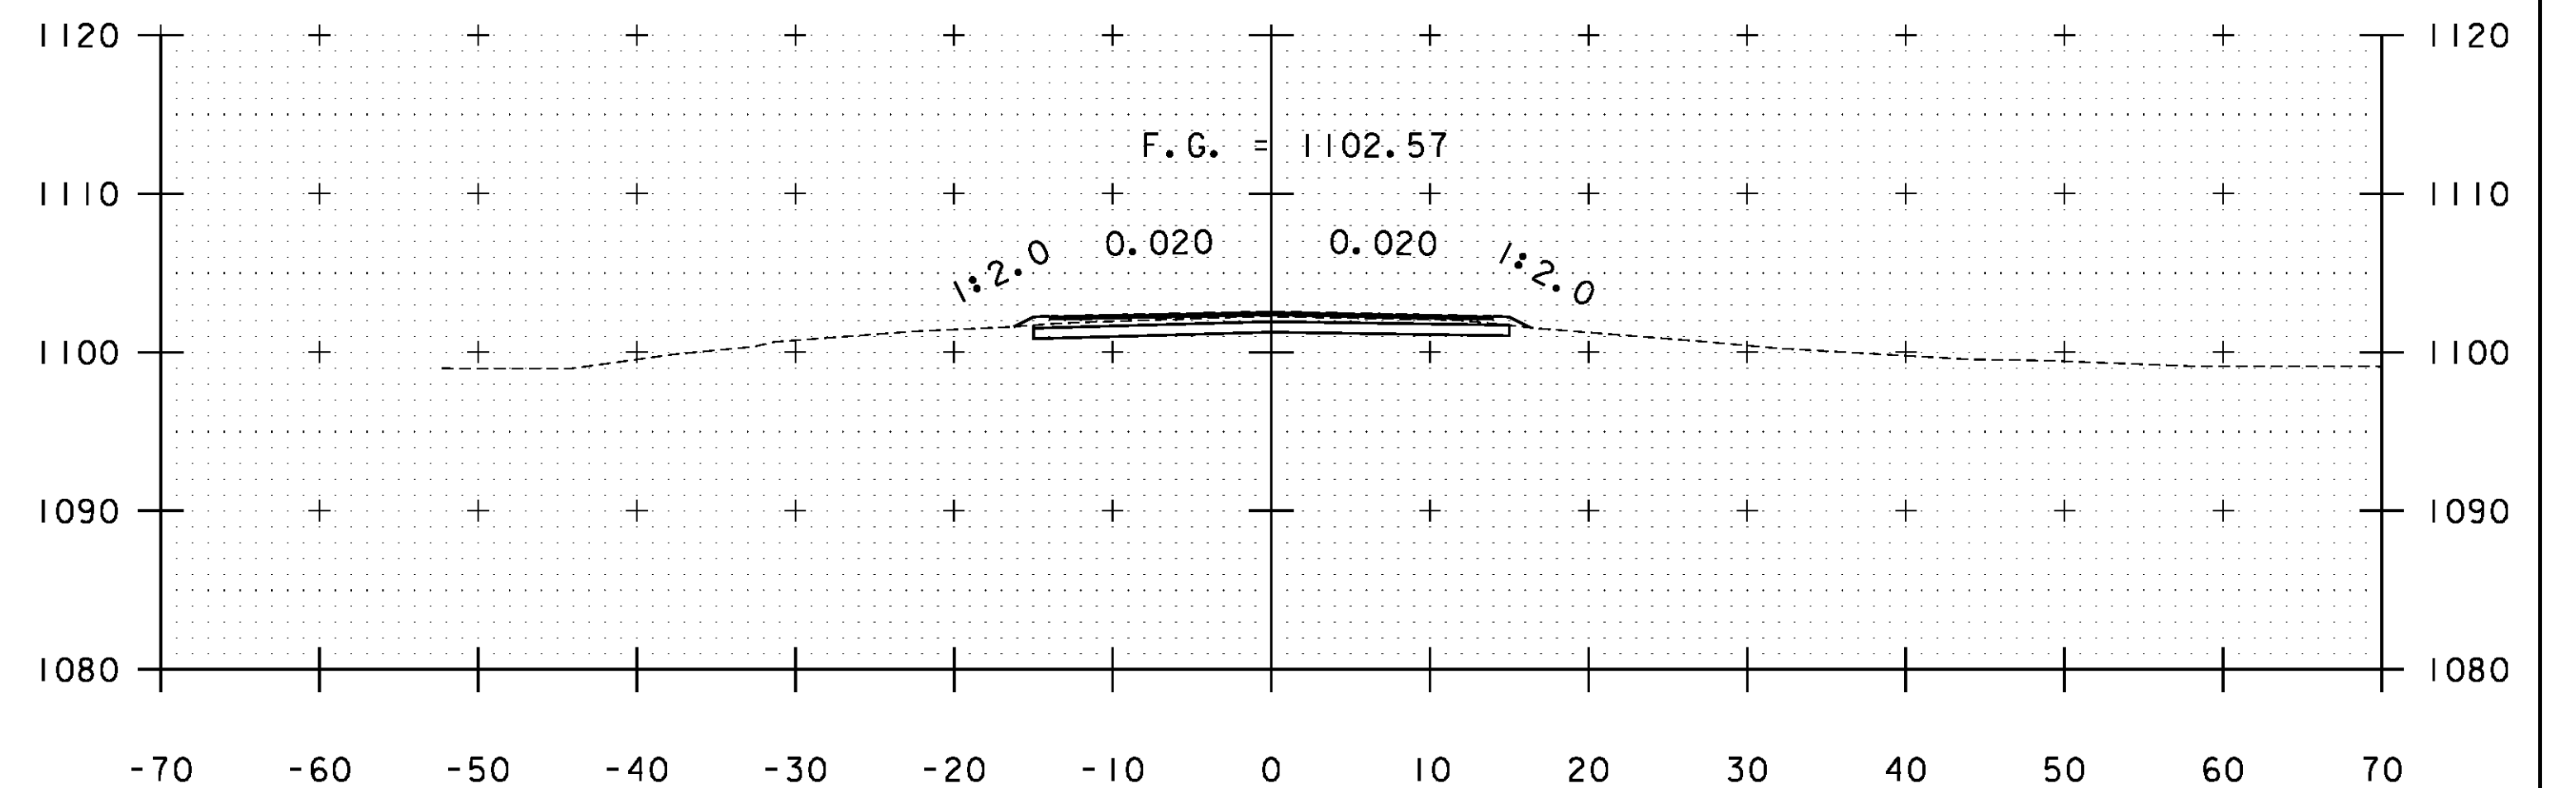

A 277+50

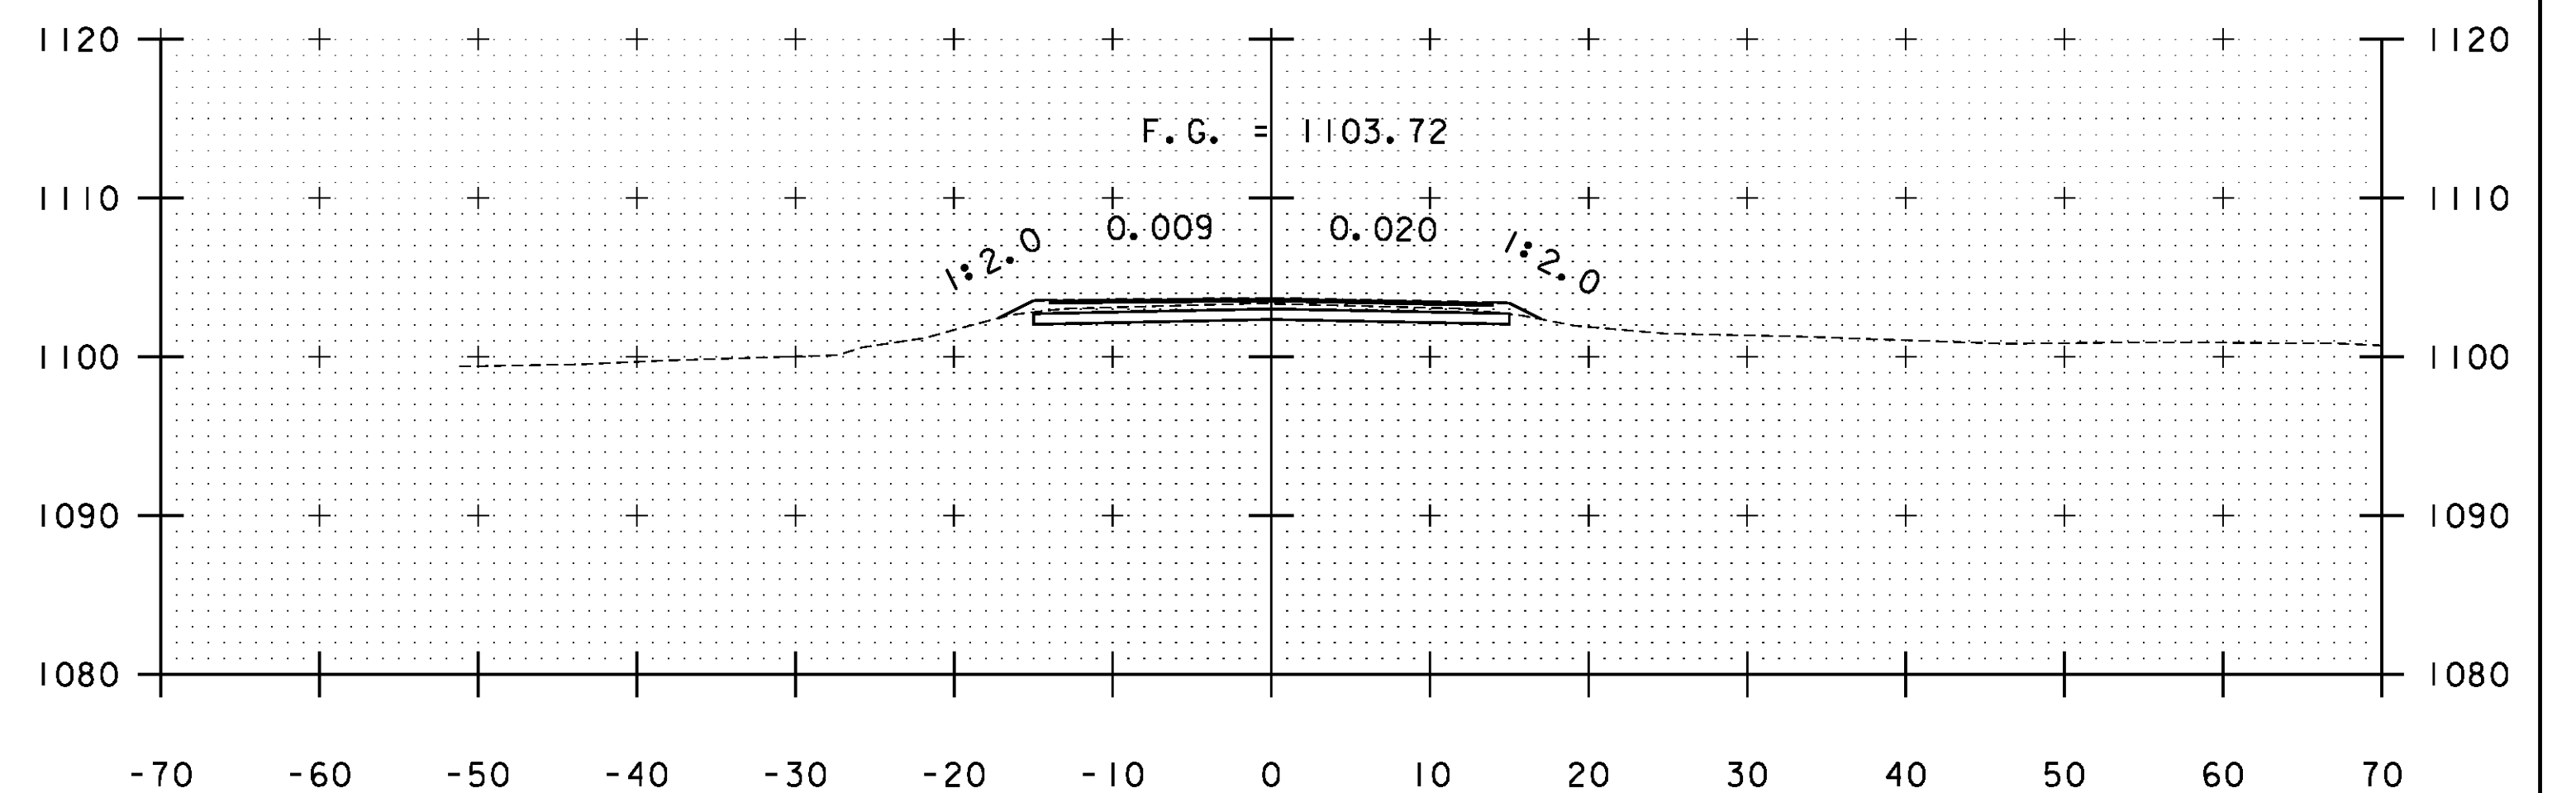

A 277+00

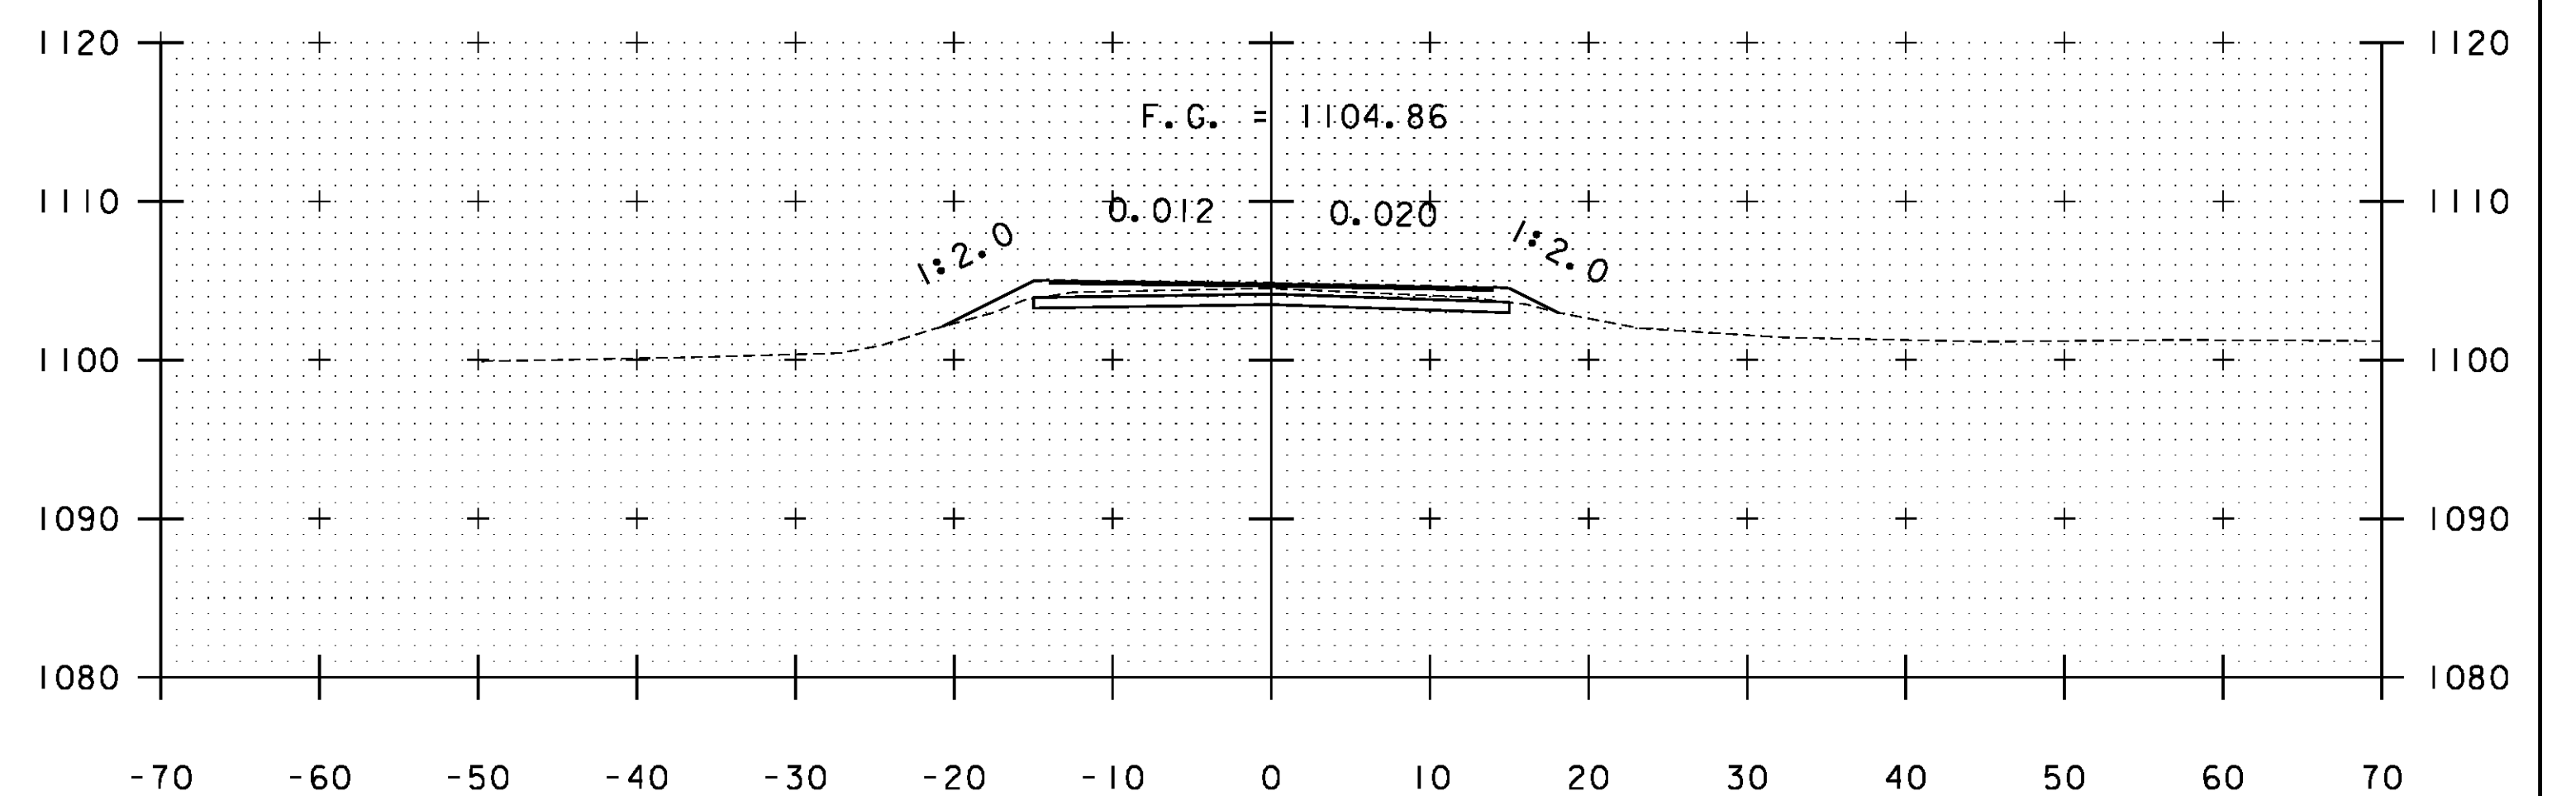

A 276+50

STA. A 275+00 TO STA. A 277+50

PROJECT NAME: WARDBORO-JAMAICA	PLOT DATE: 2/26/2014
PROJECT NUMBER: ER STP 013-1(17)	DRAWN BY: B. KIPP
FILE NAME: xs.dgn	CHECKED BY: HSD
PROJECT LEADER: K. UPMAL	SHEET 285 OF 444
DESIGNED BY: B. KIPP	
CROSS SECTIONS	