




A 279+00

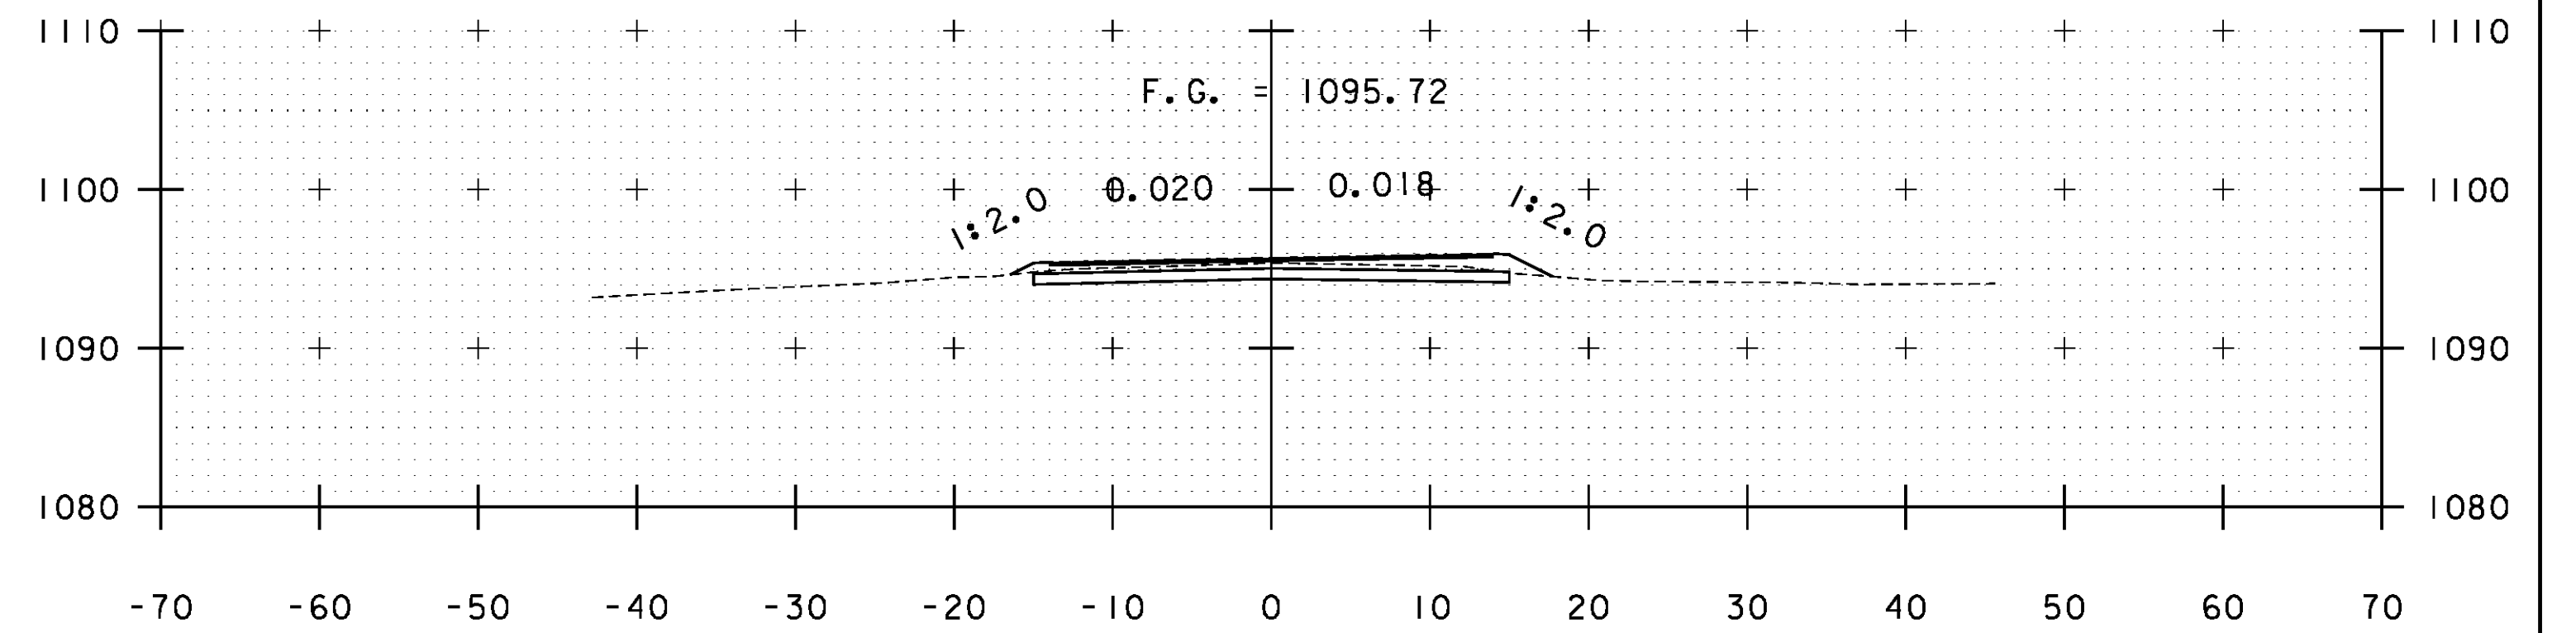


A 280+50

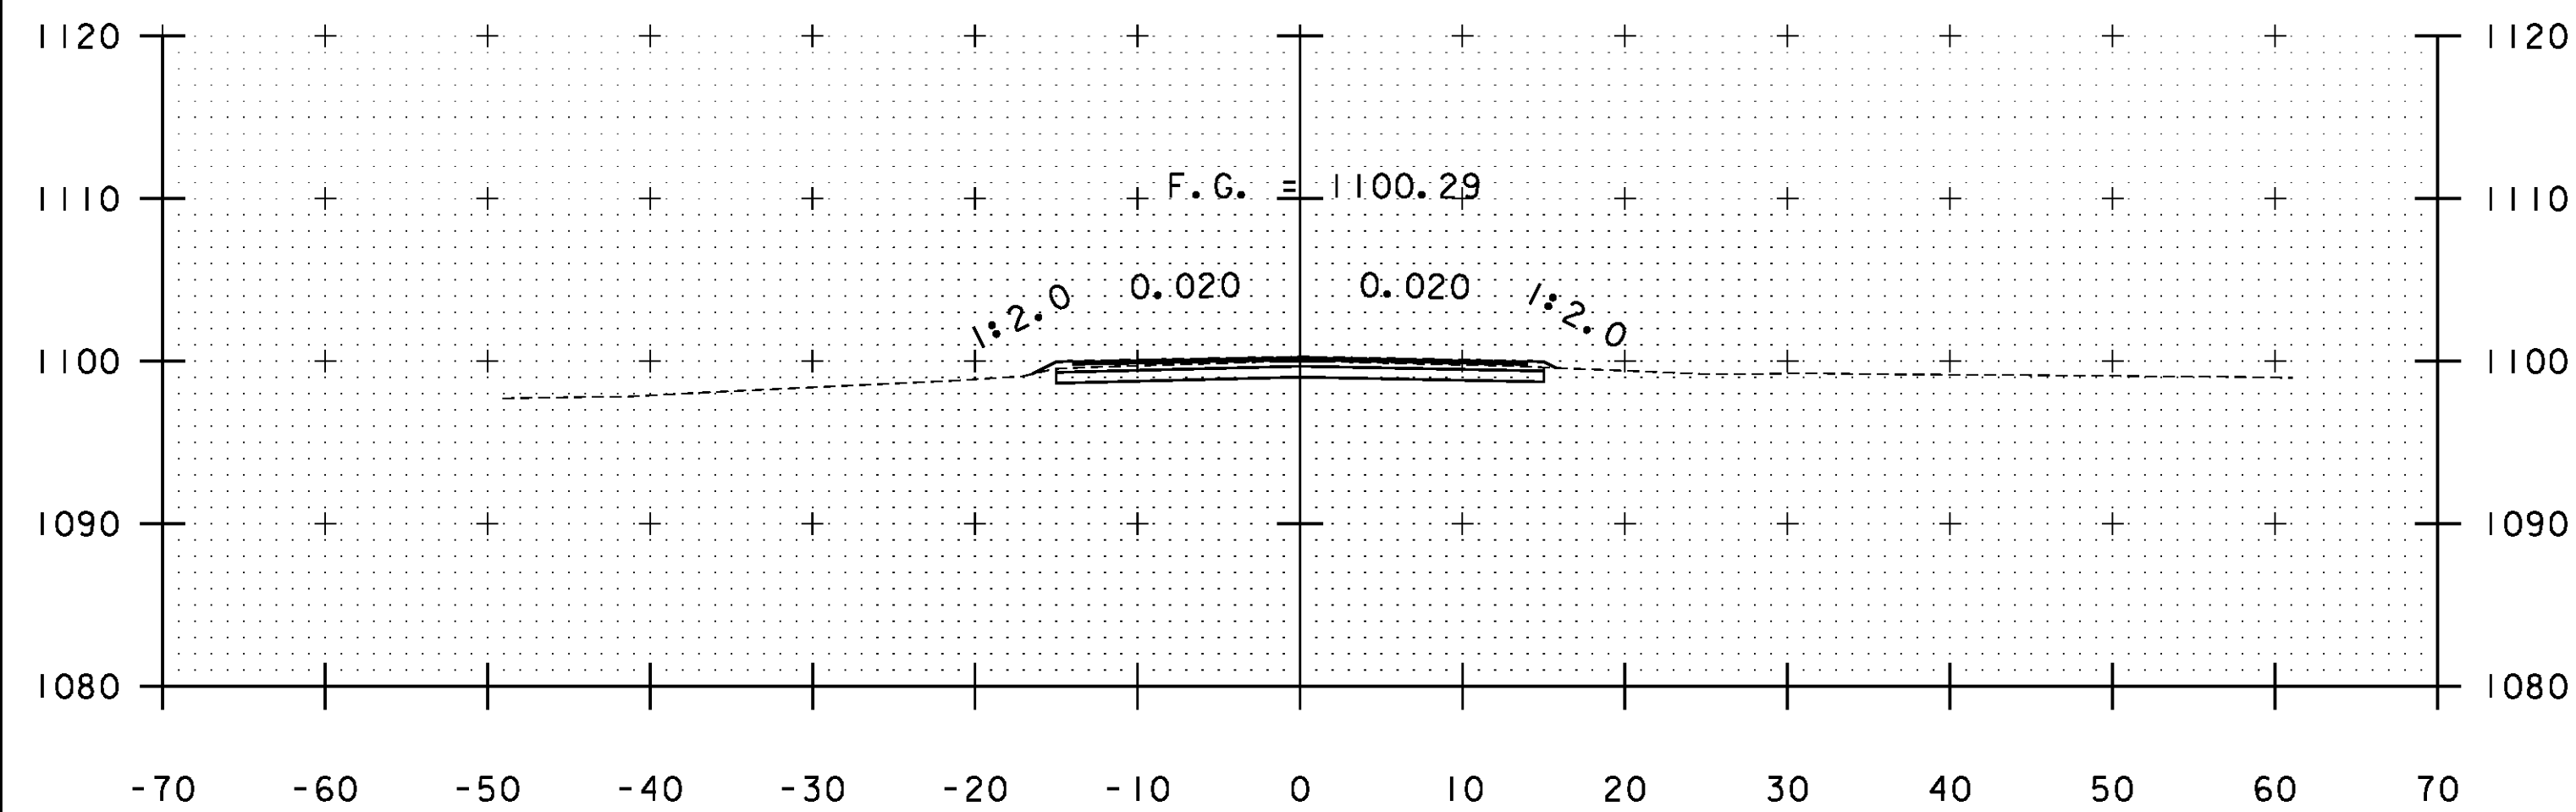


A 278+50

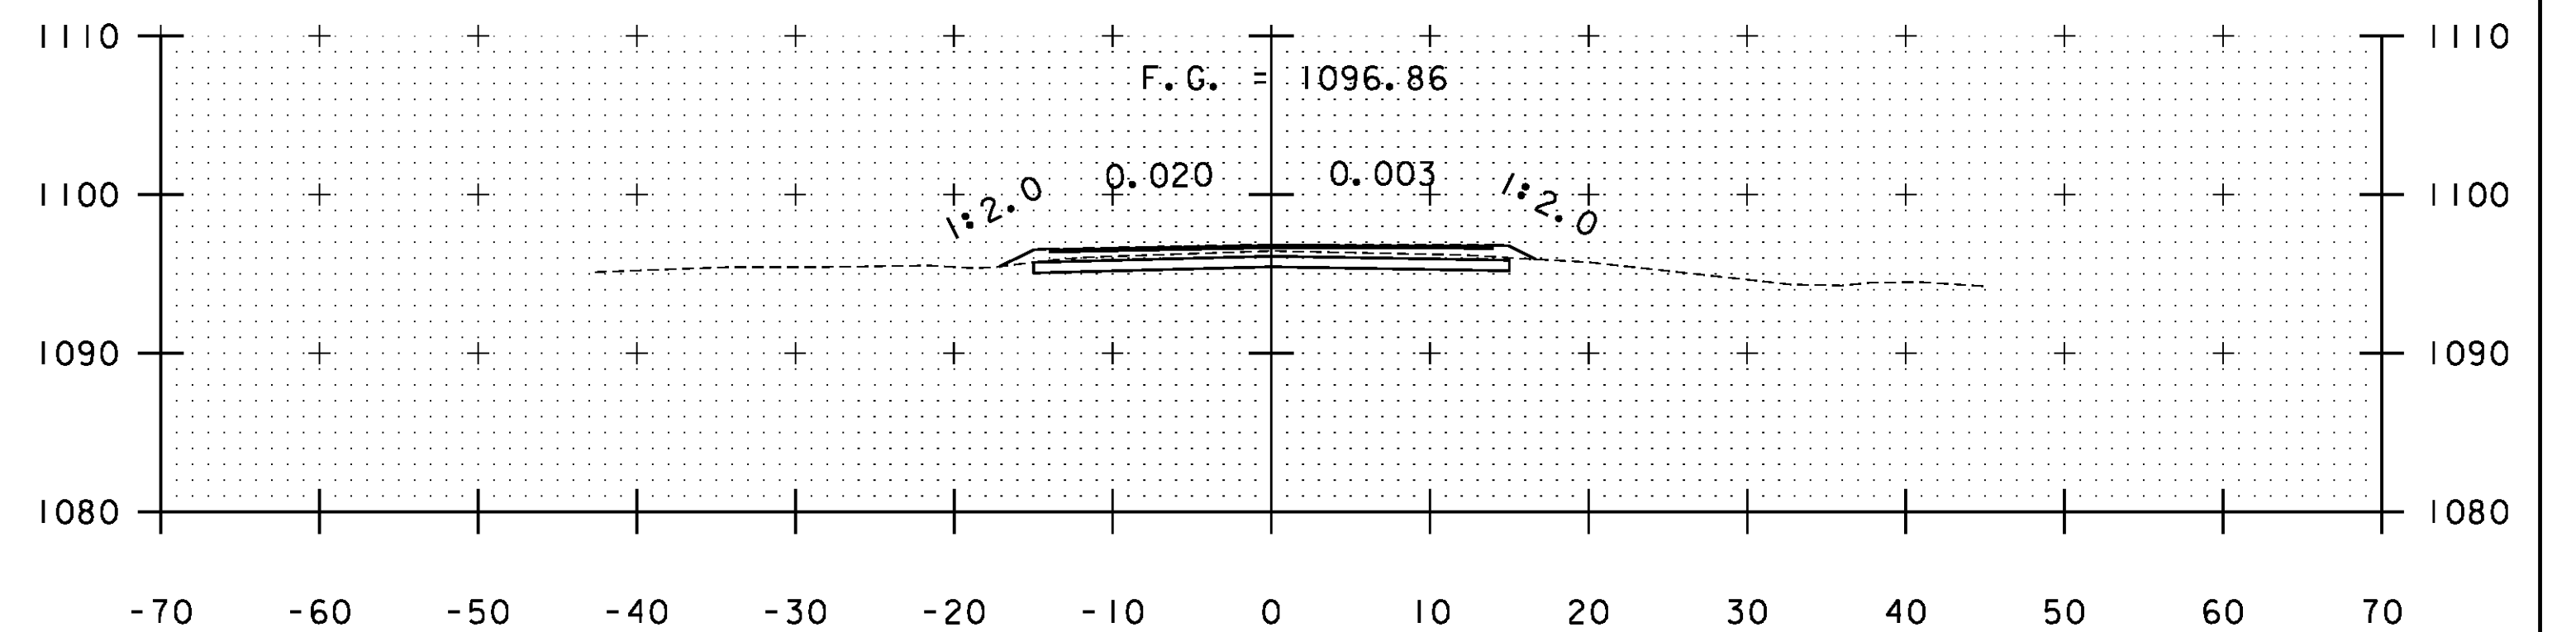

A 280+00

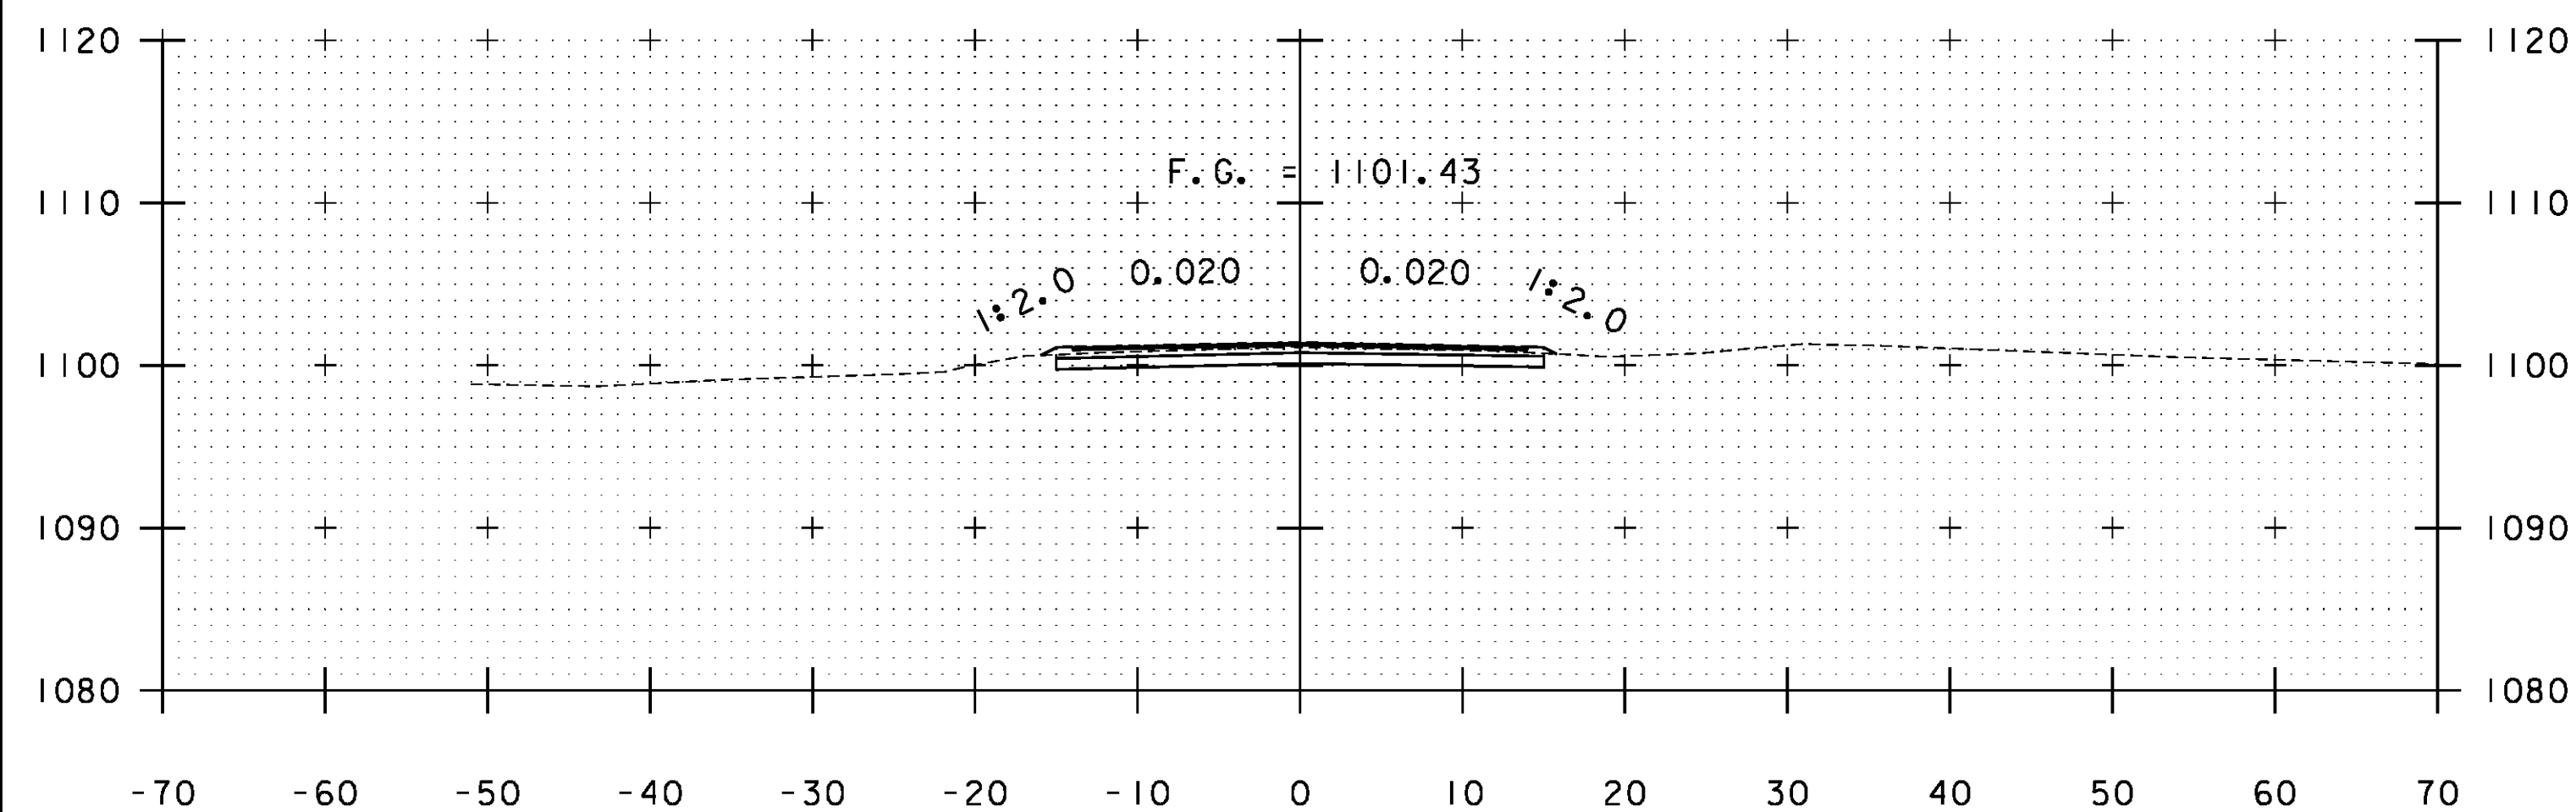

A 278+00

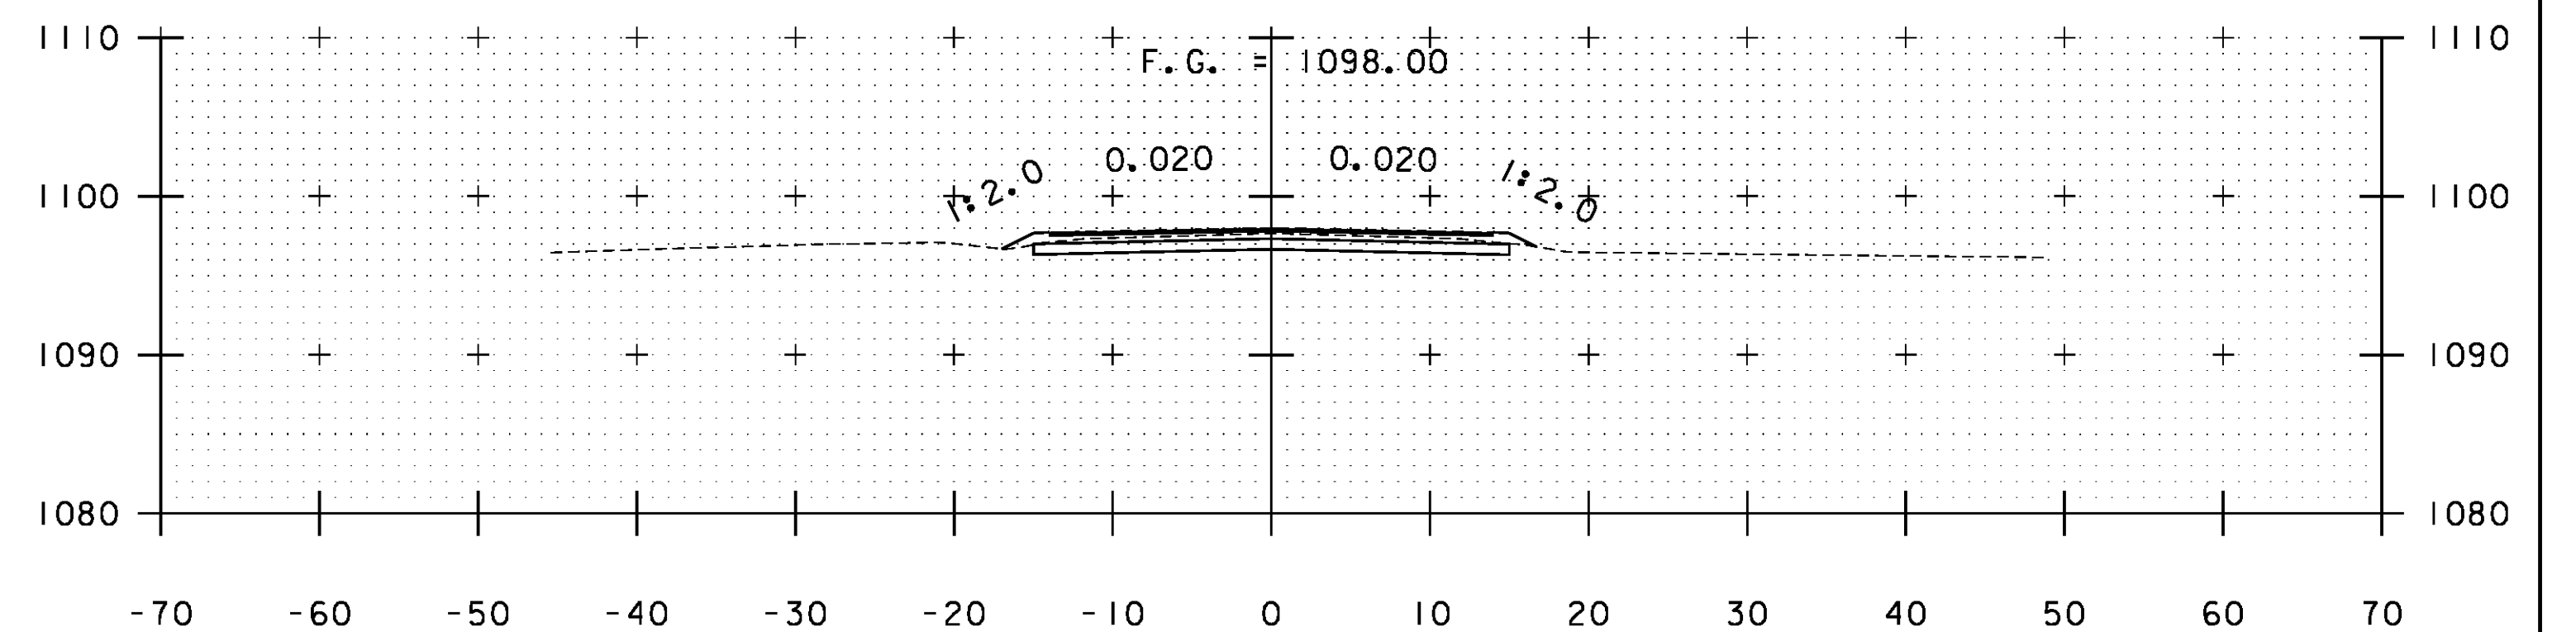

A 279+50

STA. A 278+00 TO STA. A 280+50

PROJECT NAME: WARDSBORO-JAMAICA	PLOT DATE: 2/26/2014
PROJECT NUMBER: ER STP 013-1(17)	DRAWN BY: B. KIPP
FILE NAME: xs.dgn	CHECKED BY: HSD
PROJECT LEADER: K. UPMAL	SHEET 286 OF 444
DESIGNED BY: B. KIPP	
CROSS SECTIONS	