




A 282+00

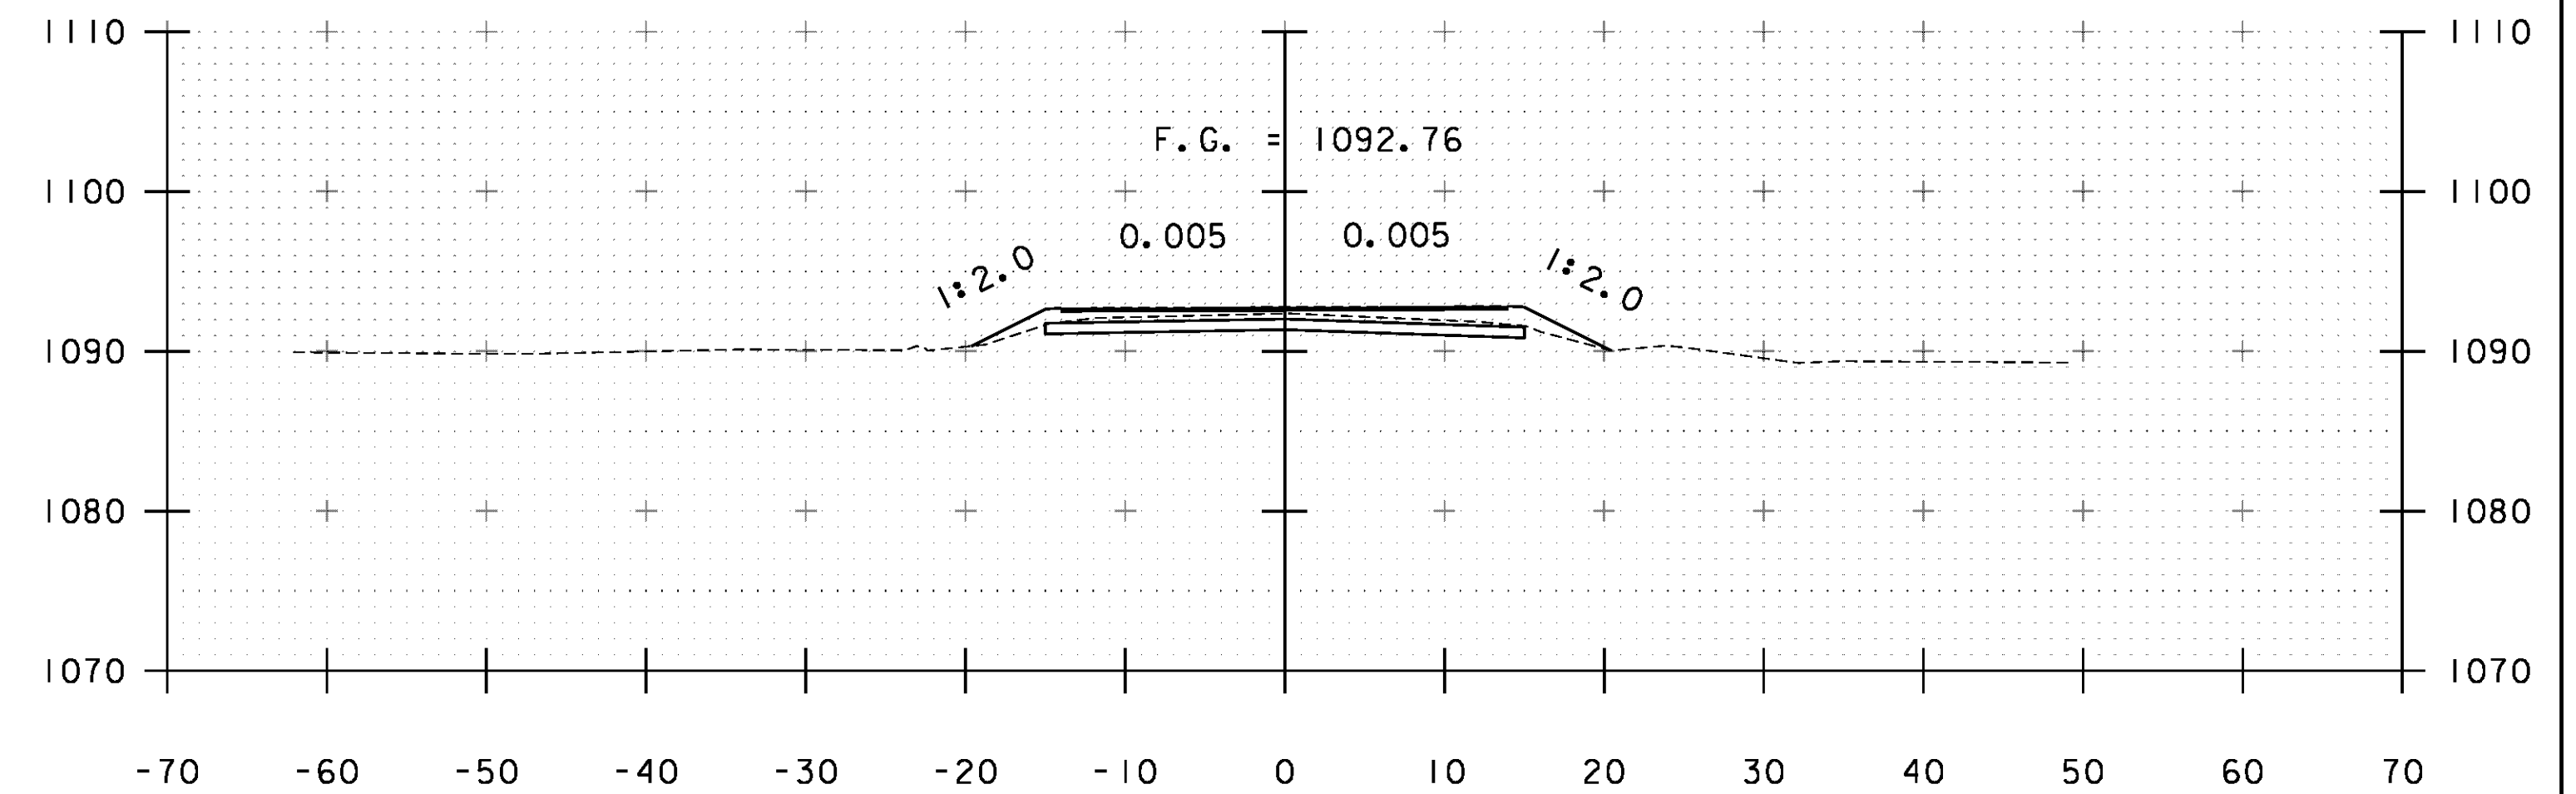


A 283+50
BEGIN BF 013-1 (22)

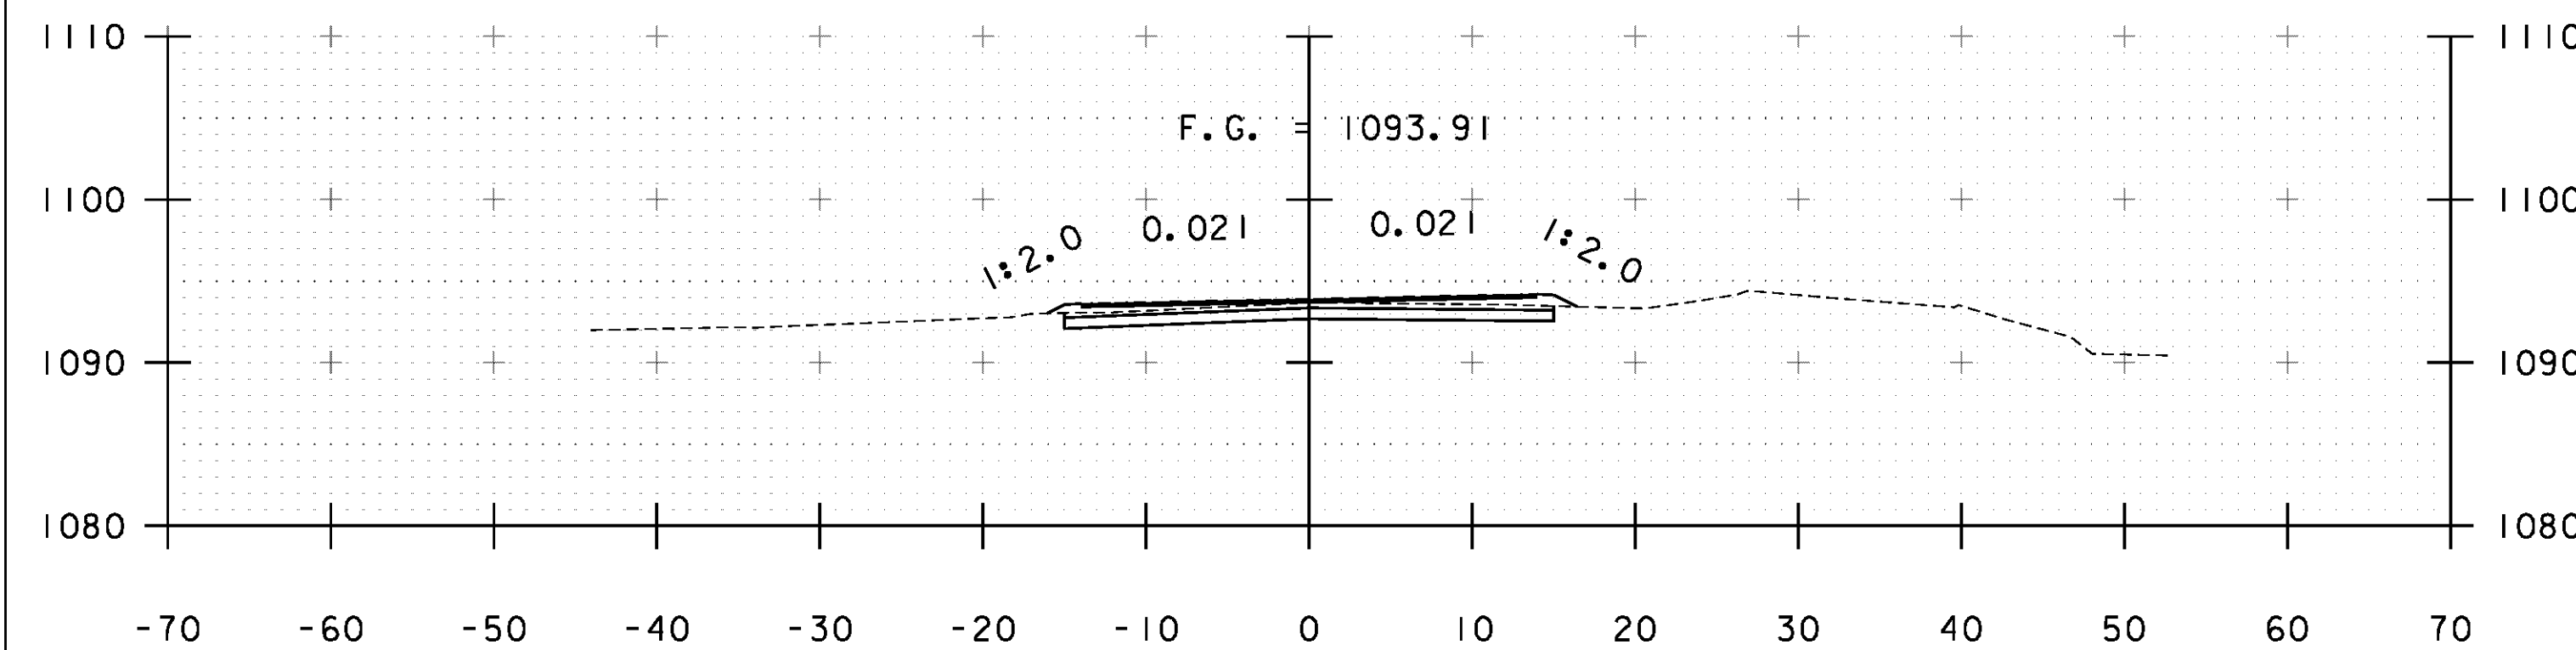


A 281+50

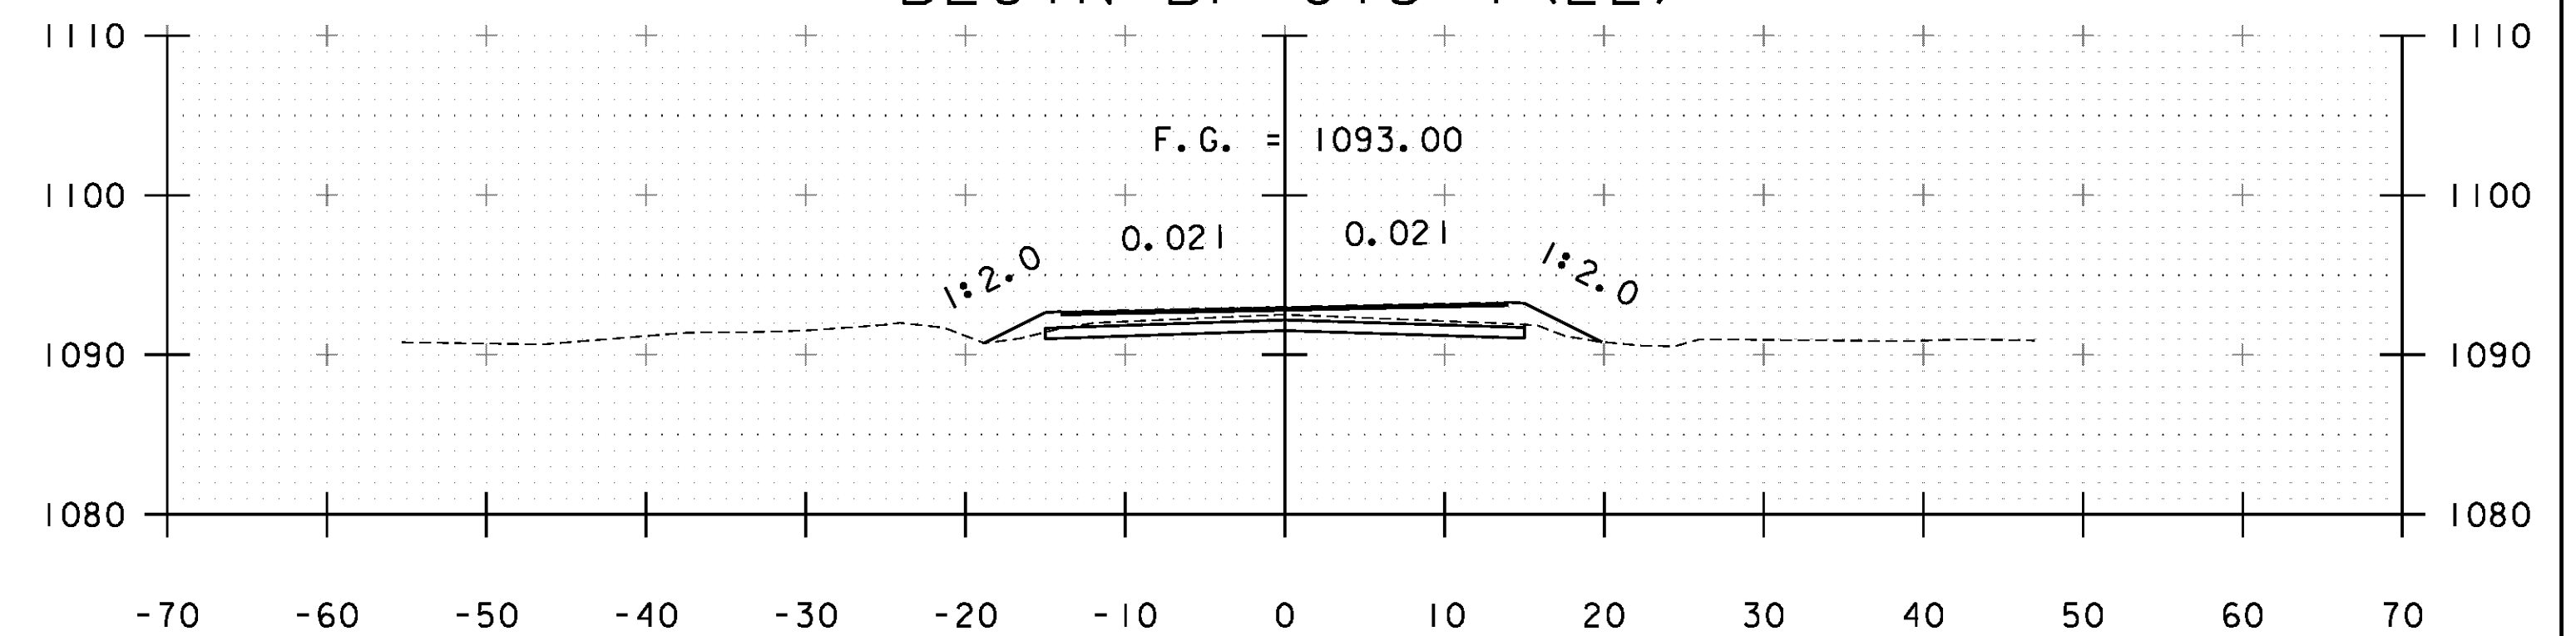

A 283+00

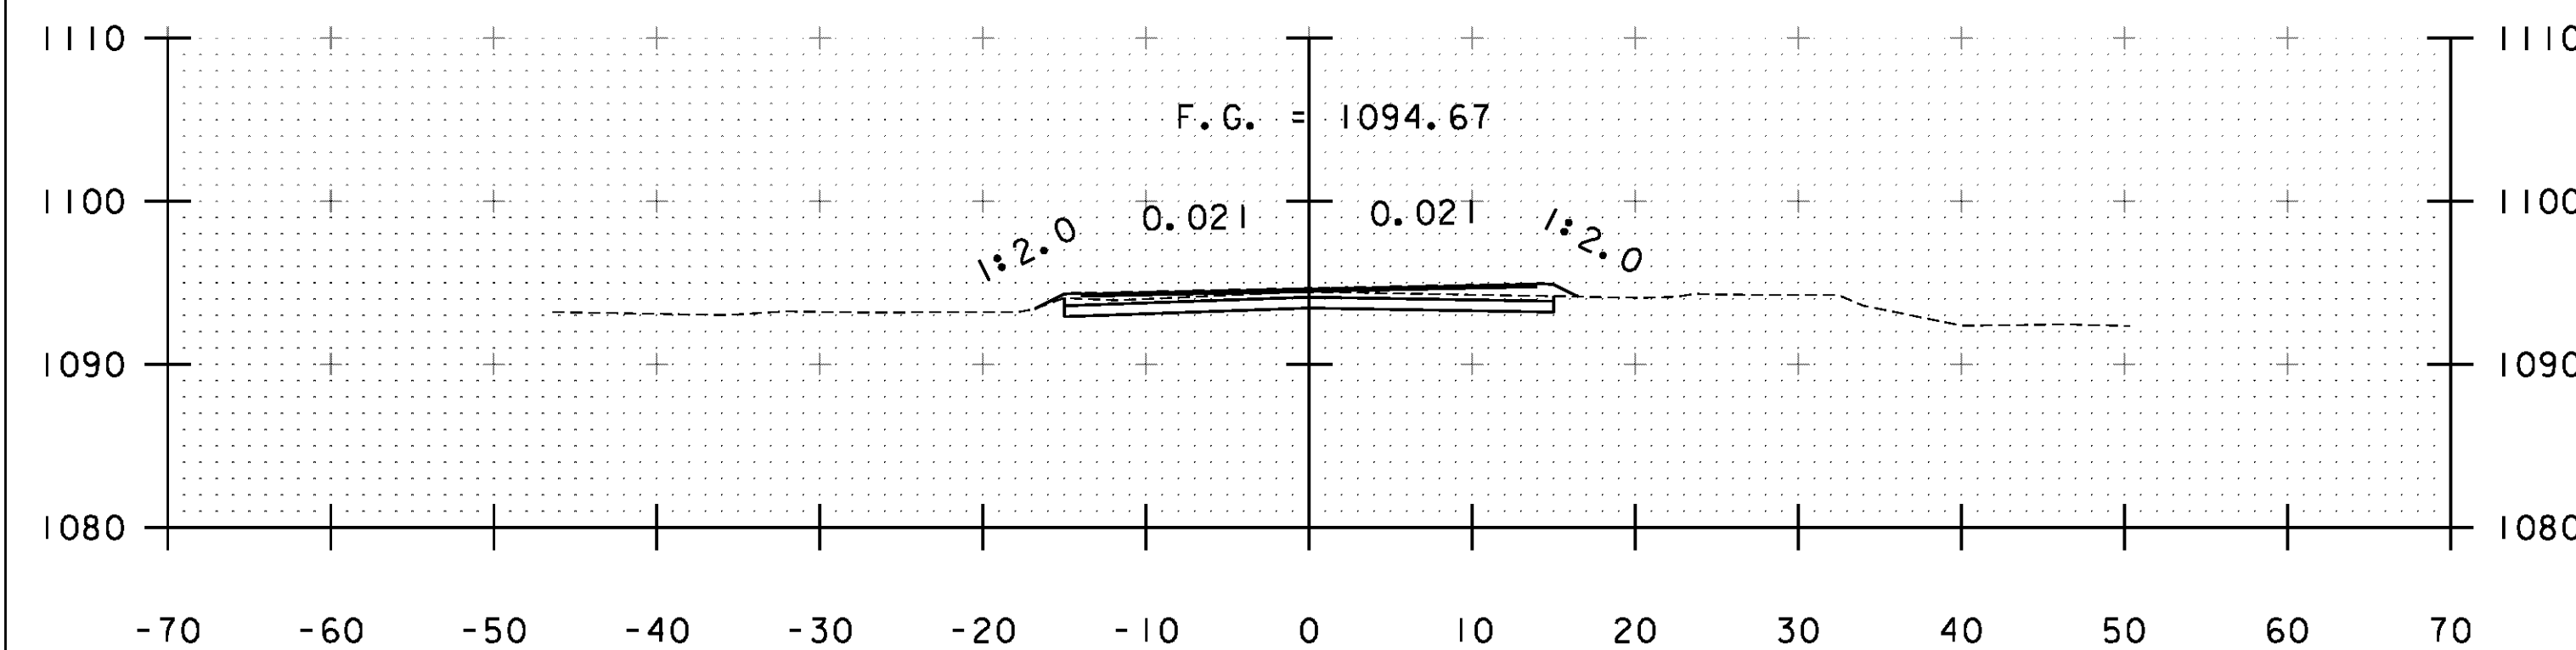

A 281+00

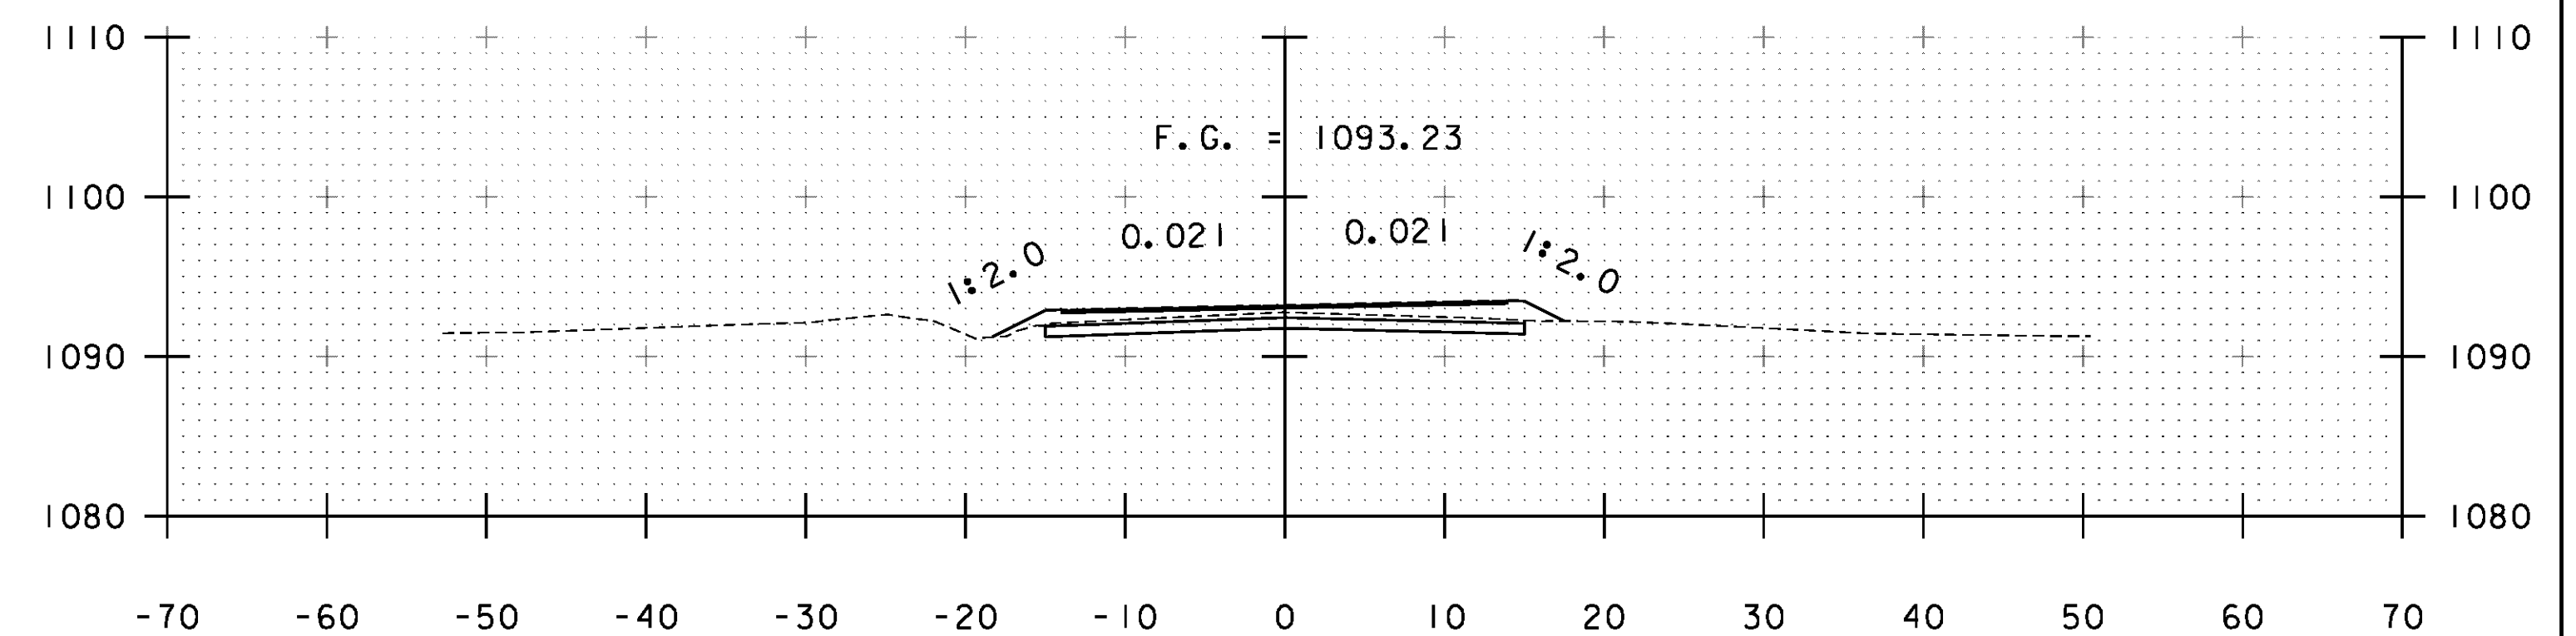

A 282+50

STA. A 281+00 TO STA. A 283+50

PROJECT NAME:	WARDSBORO-JAMAICA
PROJECT NUMBER:	ER STP 013-1(17)
FILE NAME:	xs_C73.dgn
PROJECT LEADER:	K. UPMAL
DESIGNED BY:	B. KIPP
CROSS SECTIONS	
PLOT DATE:	2/26/2014
DRAWN BY:	B. KIPP
CHECKED BY:	HSD
SHEET	287 OF 444