




A 298+24

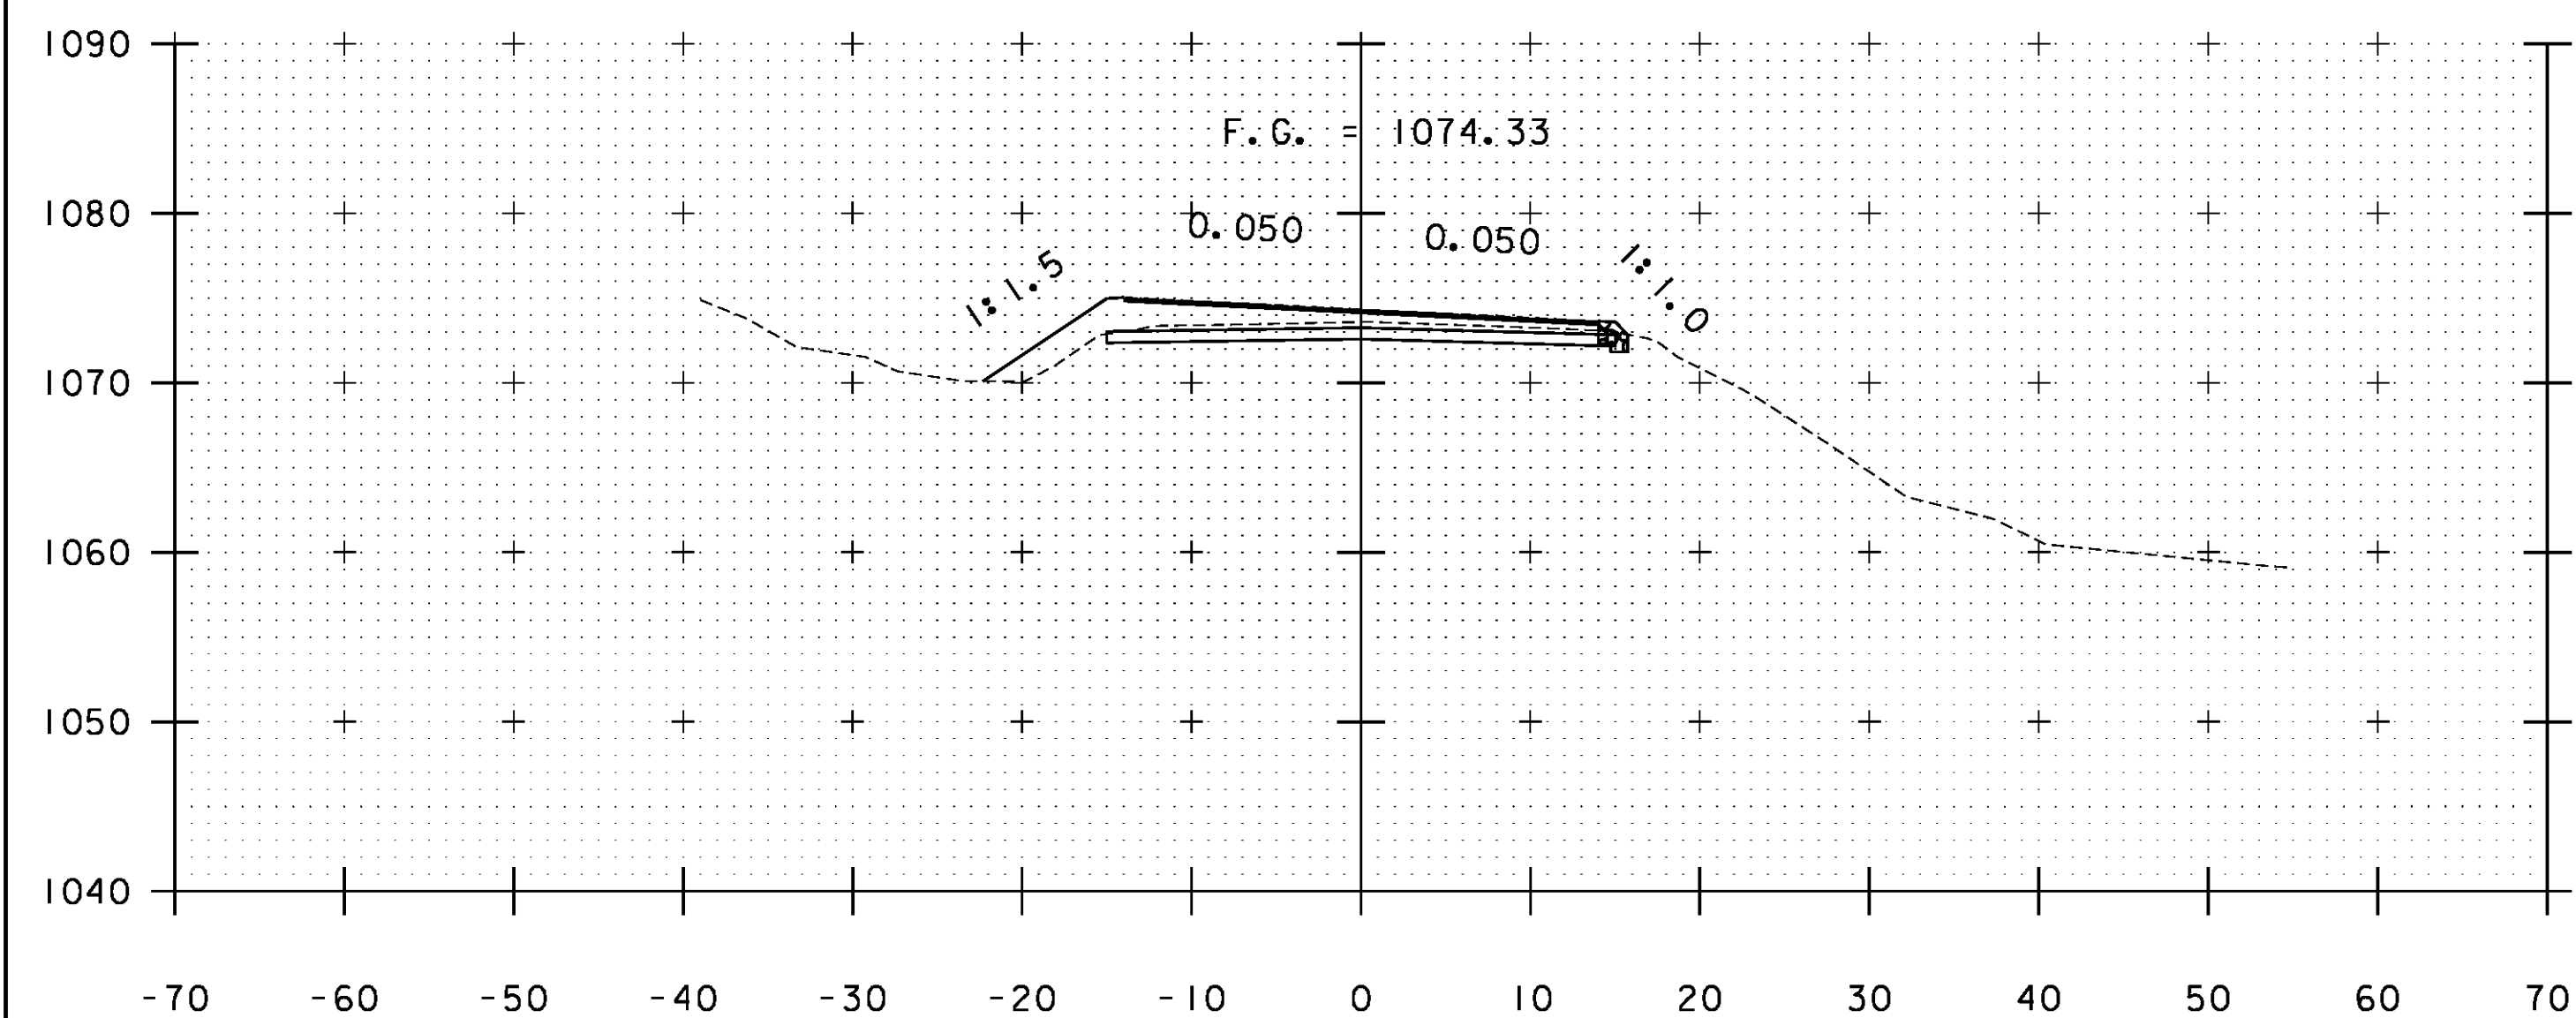

A 298+00

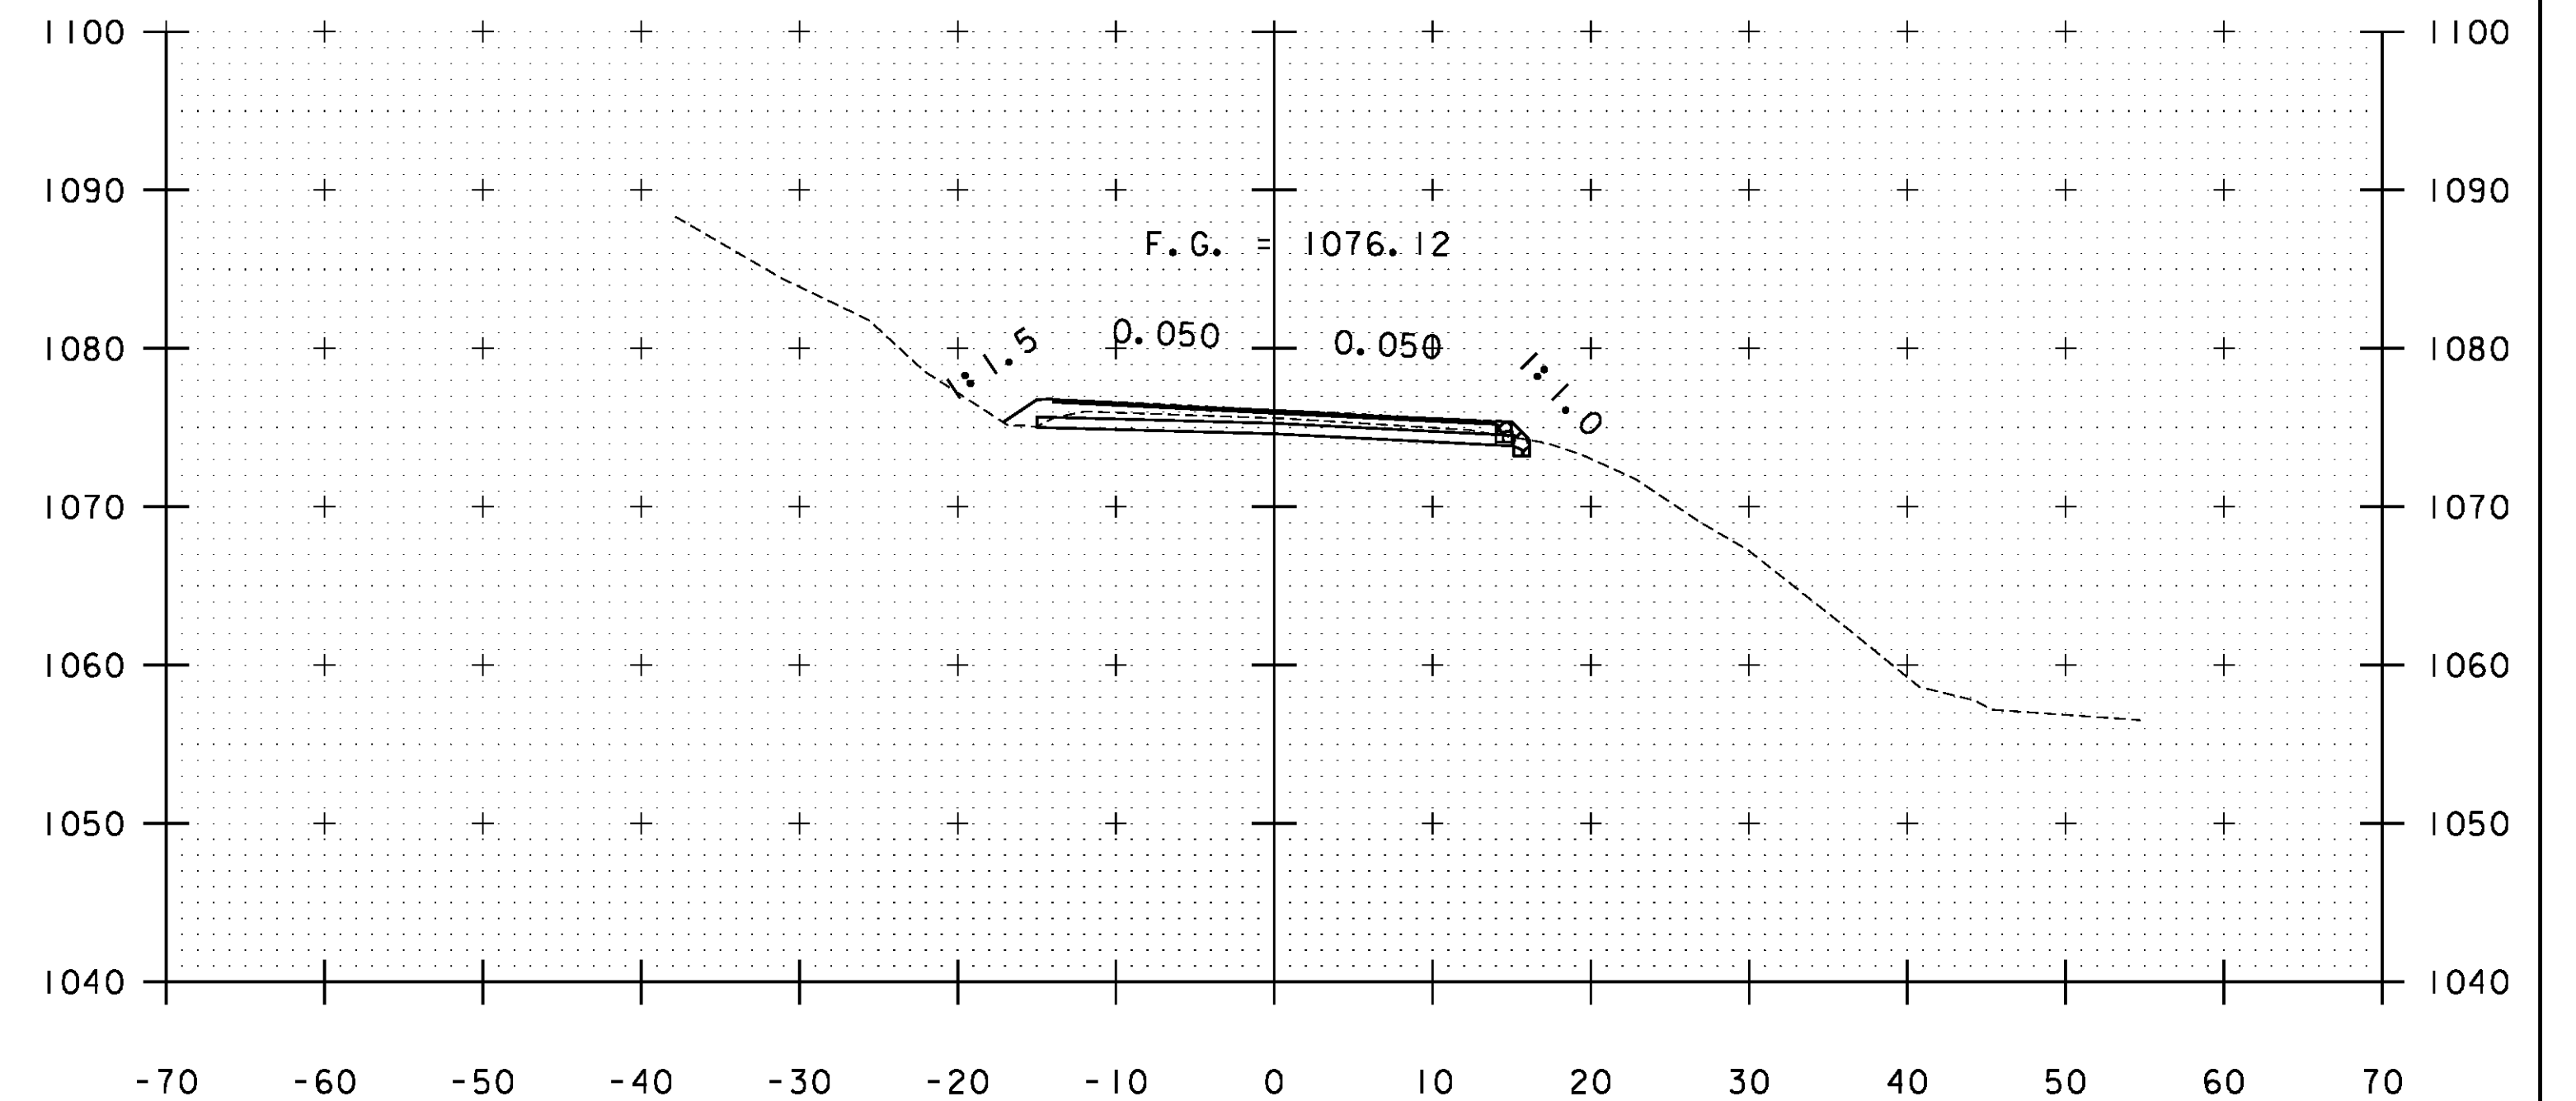

A 299+00

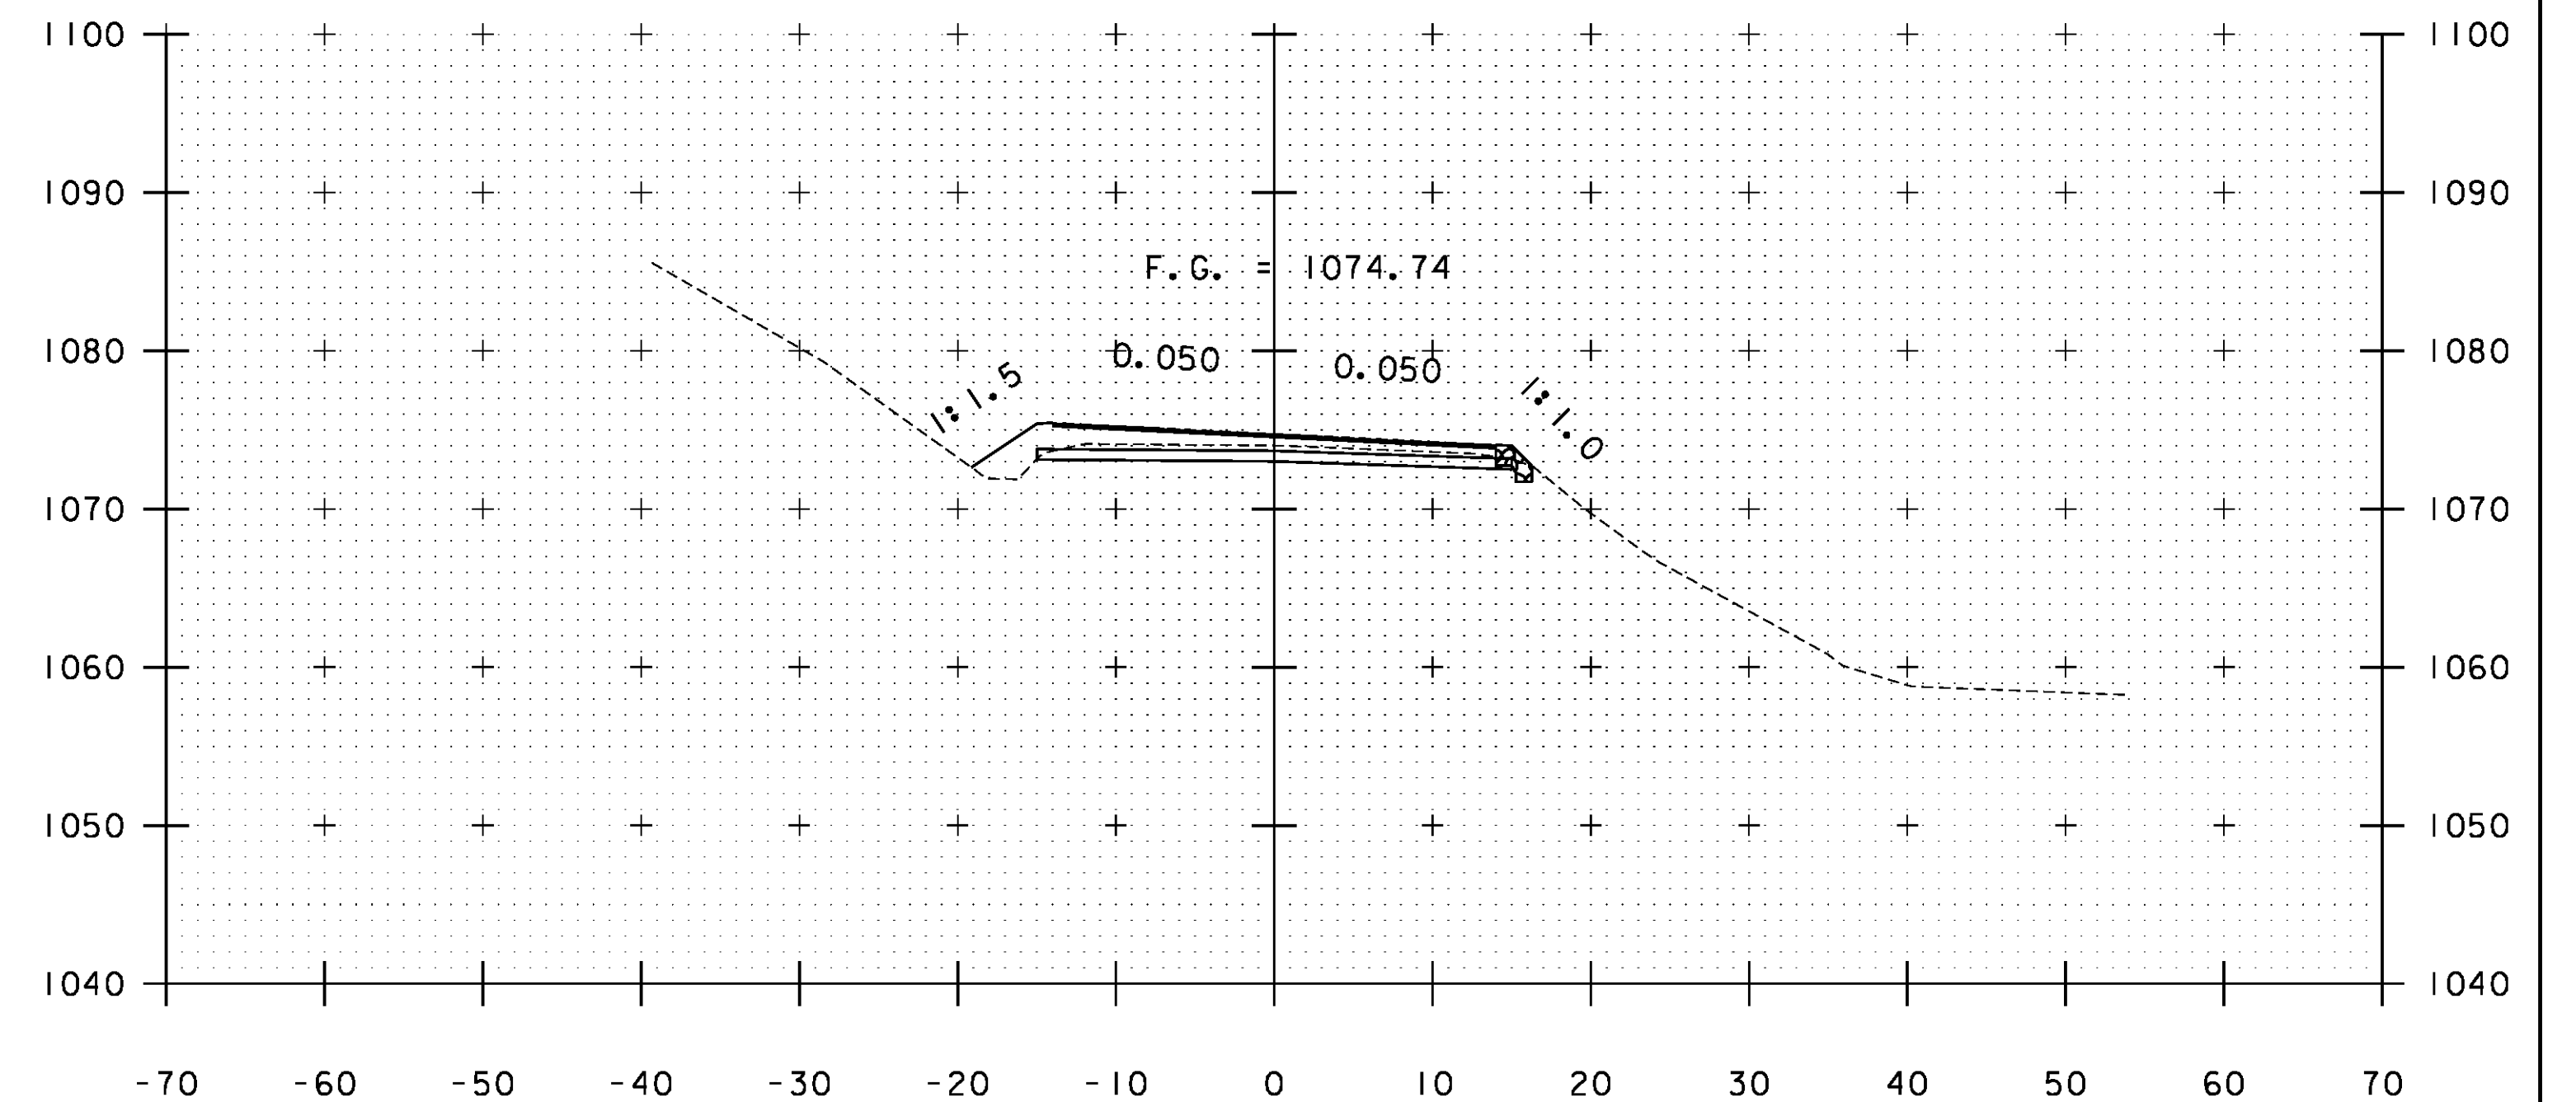

A 298+50

STA. A 298+00 TO STA. A 299+00

PROJECT NAME: WARDBORO-JAMAICA	PLOT DATE: 2/26/2014
PROJECT NUMBER: ER STP 013-1(17)	DRAWN BY: B. KIPP
FILE NAME: xs.dgn	CHECKED BY: HSD
PROJECT LEADER: K. UPMAL	SHEET 295 OF 444
DESIGNED BY: B. KIPP	
CROSS SECTIONS	