




A 306+00

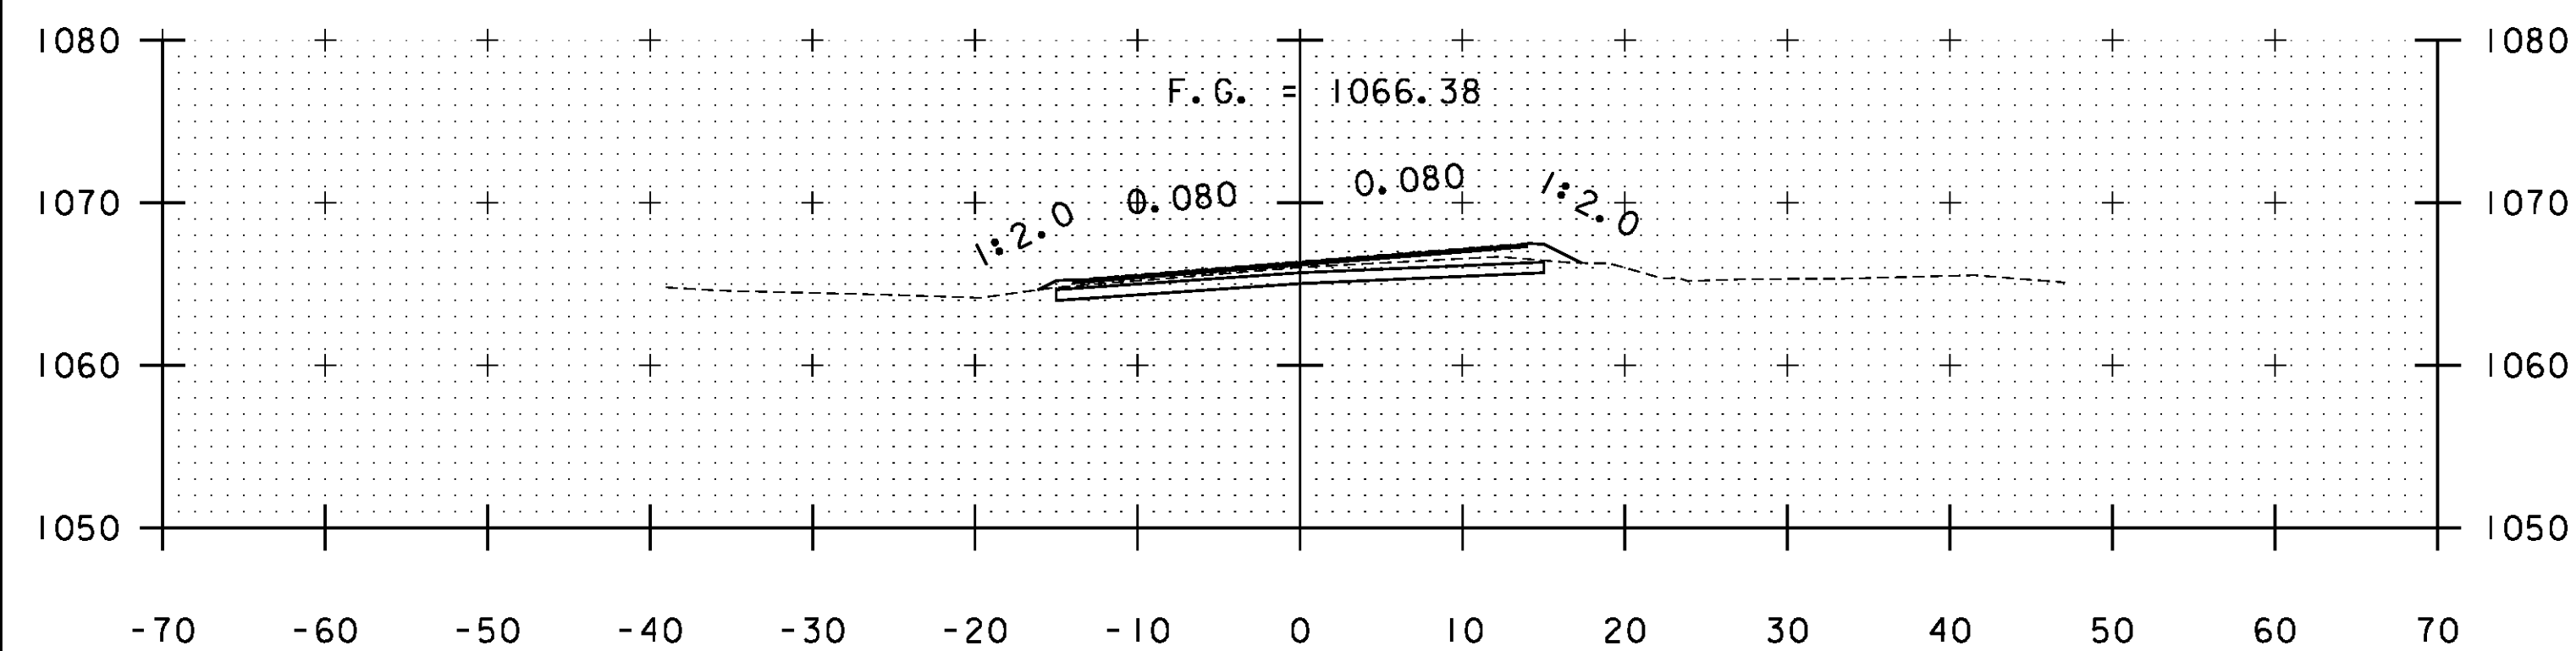


A 305+50

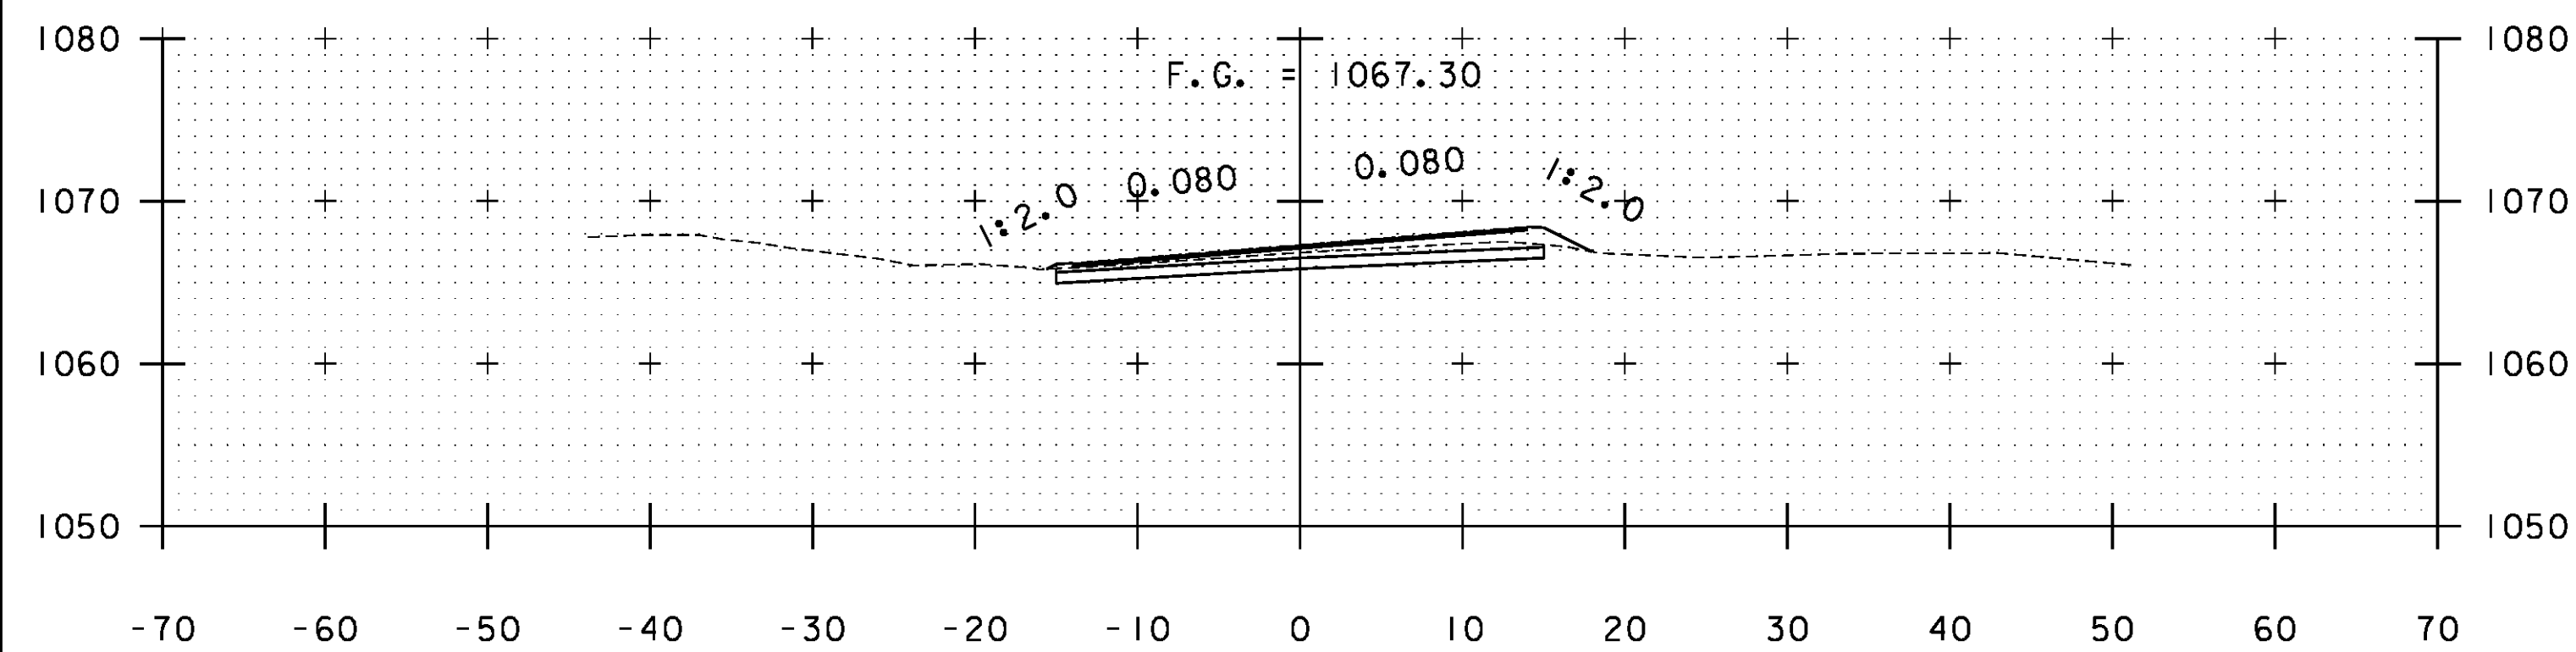


A 305+00

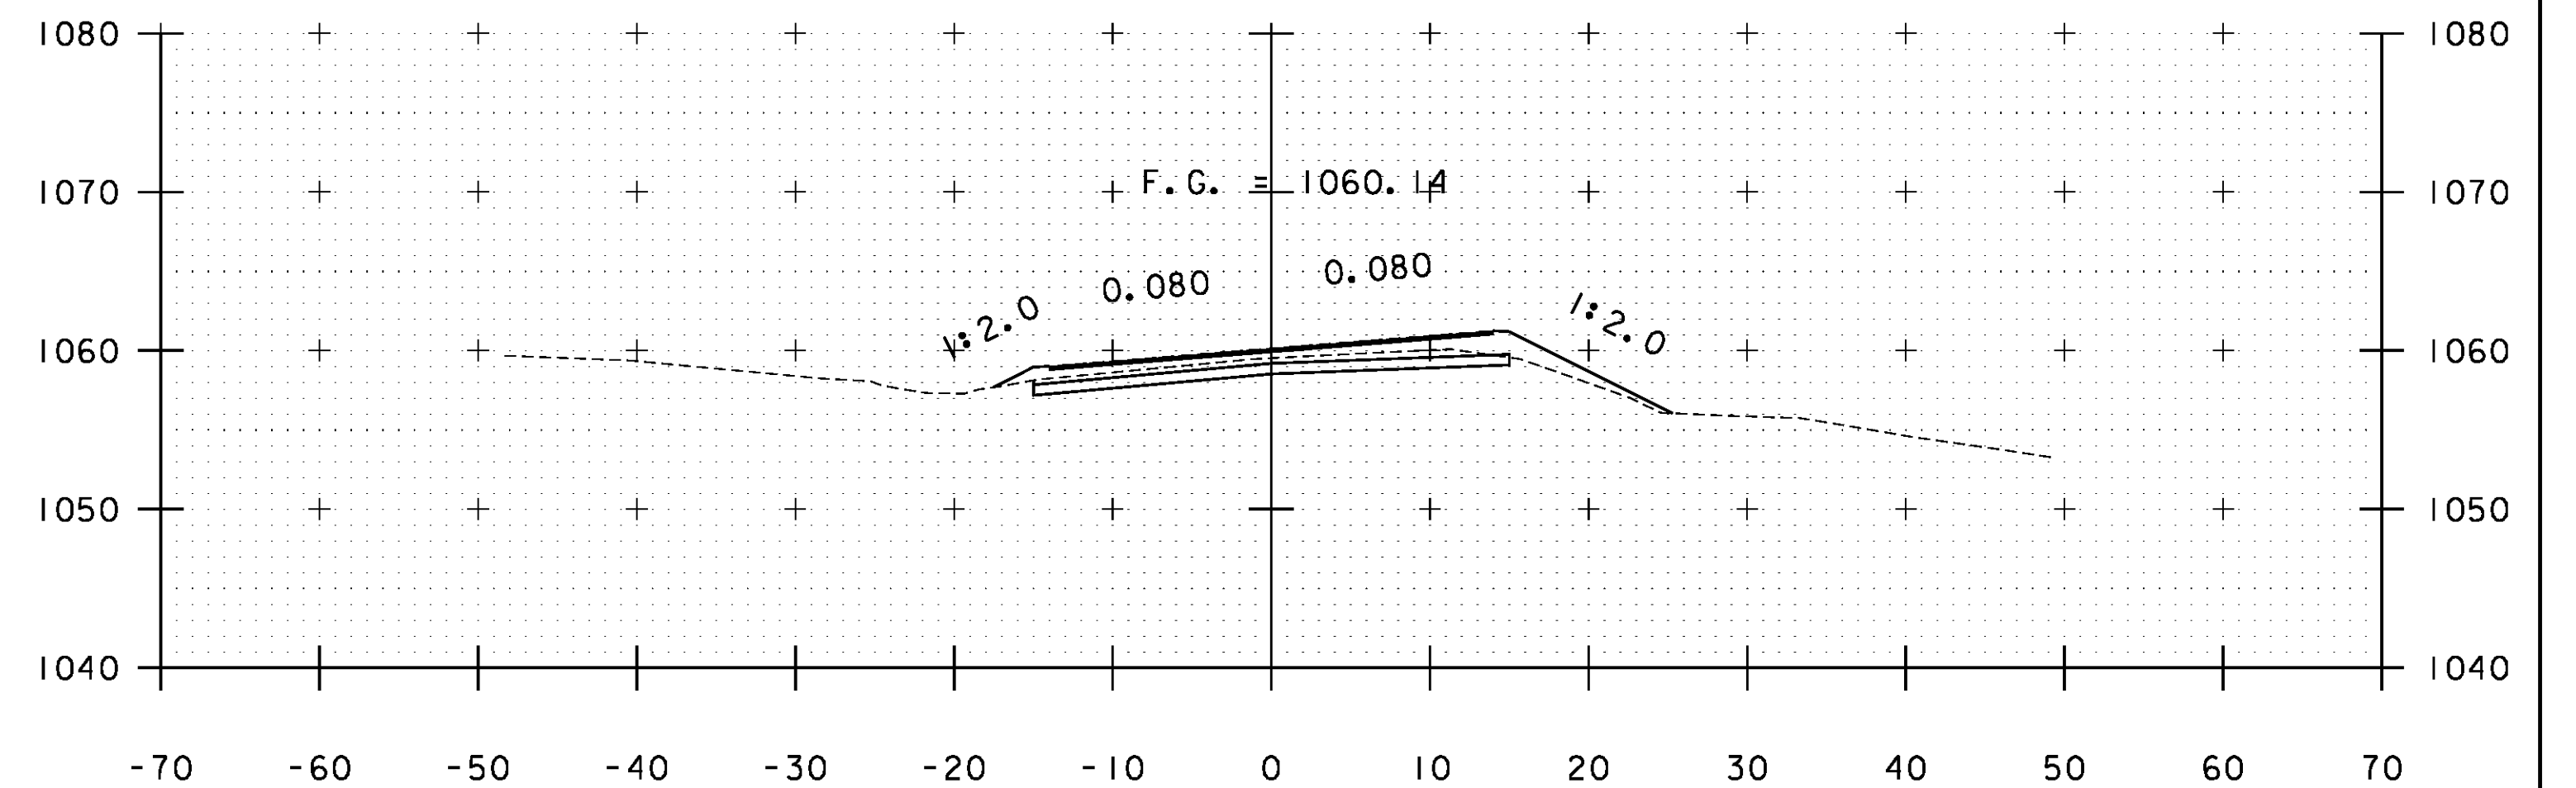

A 307+50

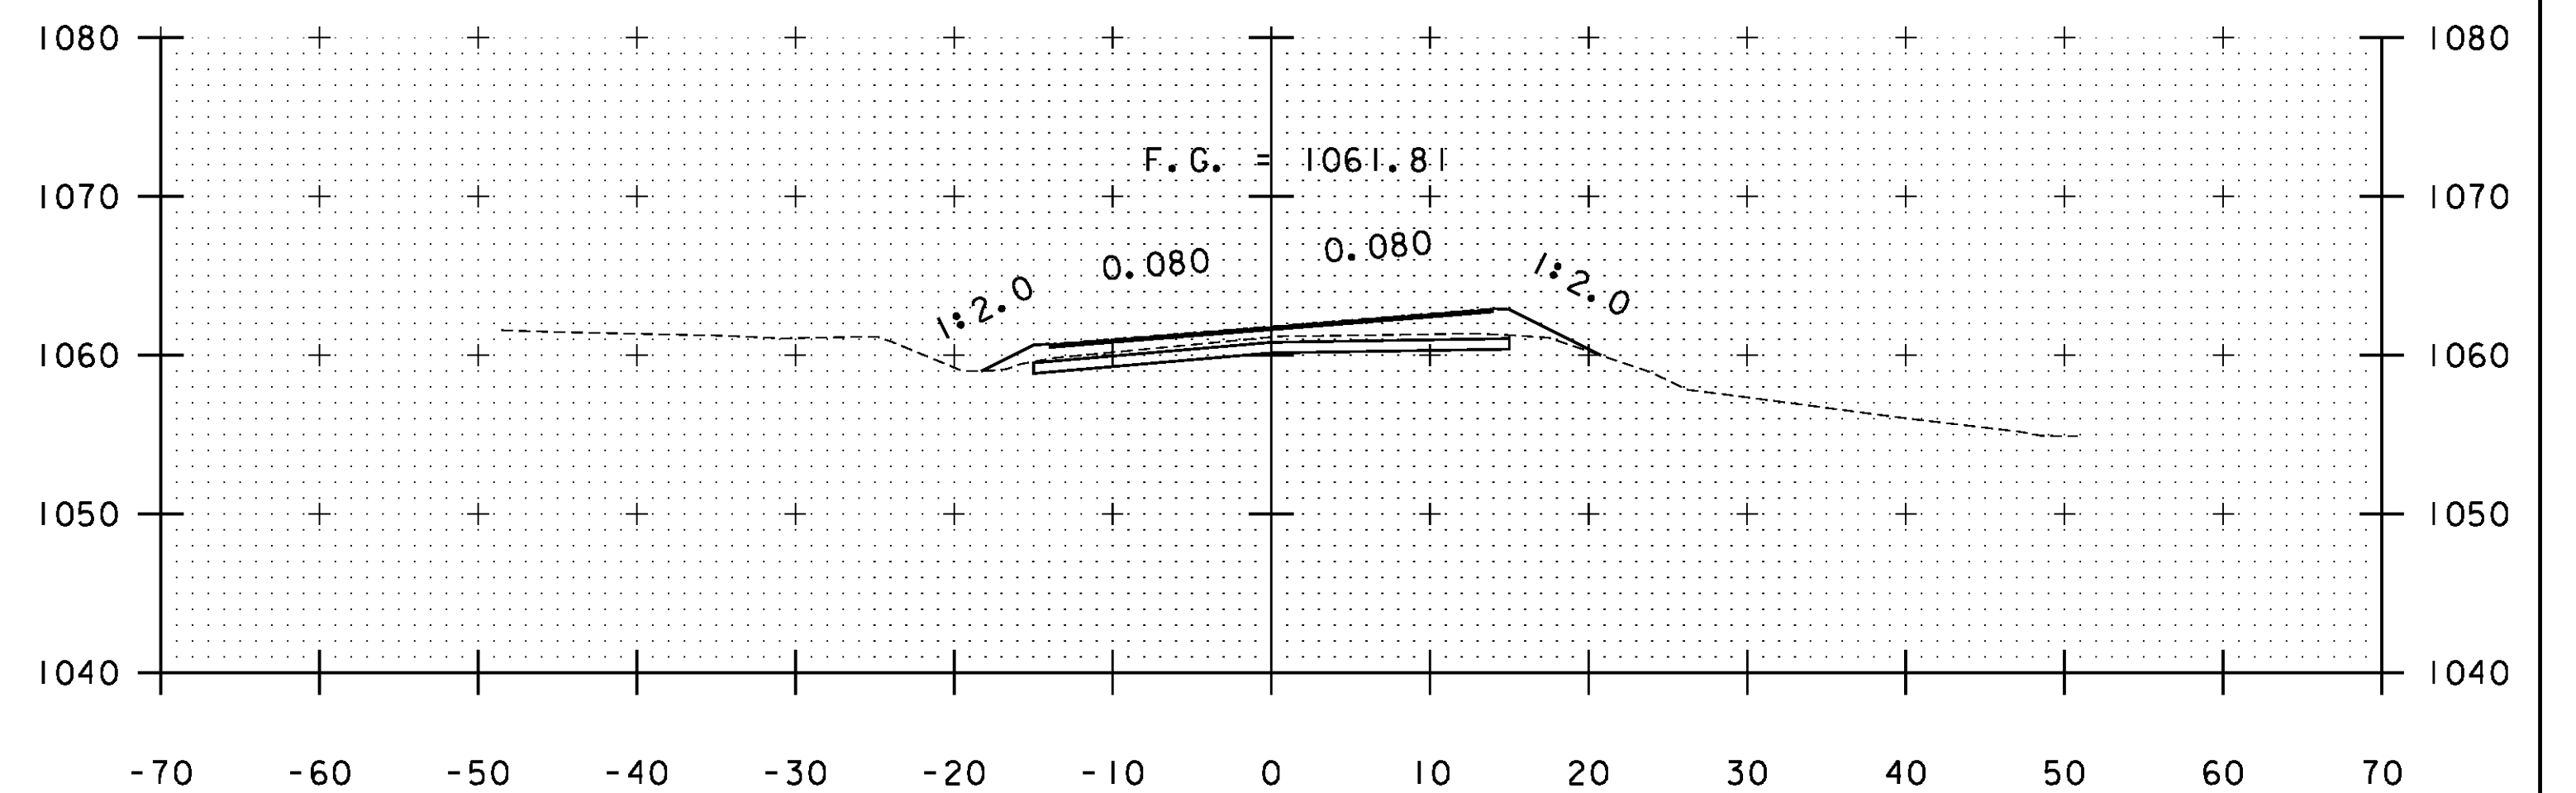

A 307+00

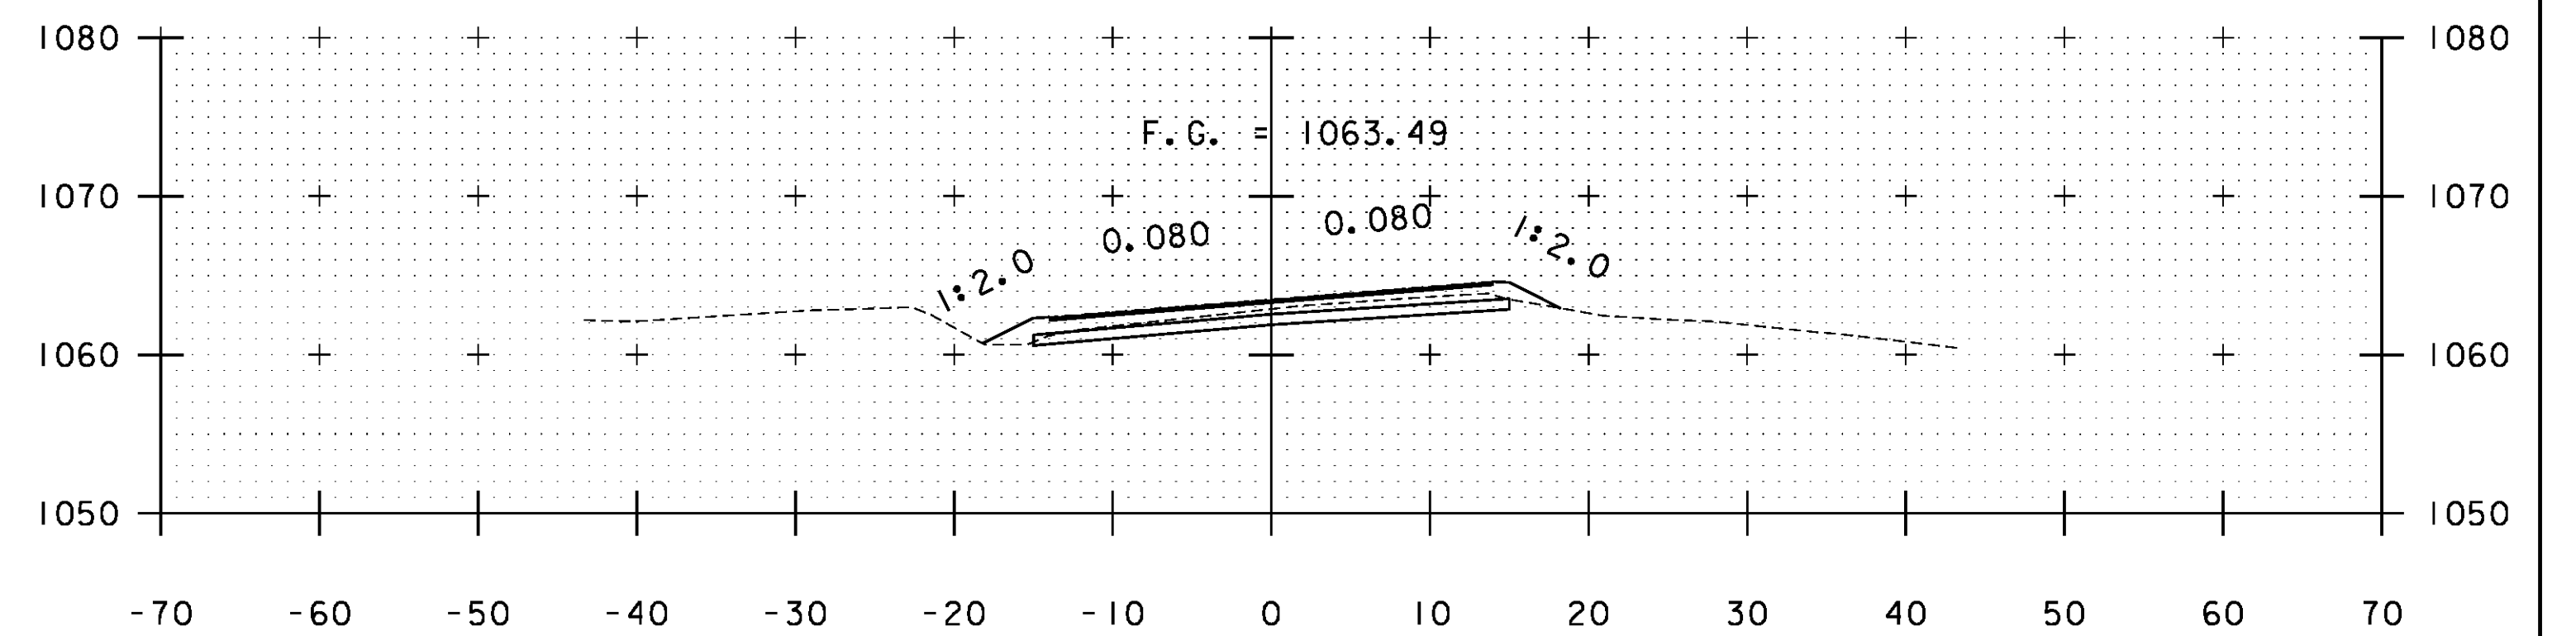

A 306+50

STA. A 305+00 TO STA. A 307+50

PROJECT NAME: WARDBORO-JAMAICA	PLOT DATE: 2/26/2014
PROJECT NUMBER: ER STP 013-1(17)	DRAWN BY: B. KIPP
FILE NAME: xs.dgn	CHECKED BY: HSD
PROJECT LEADER: K. UPMAL	SHEET 299 OF 444
DESIGNED BY: B. KIPP	
CROSS SECTIONS	