




A 309+00

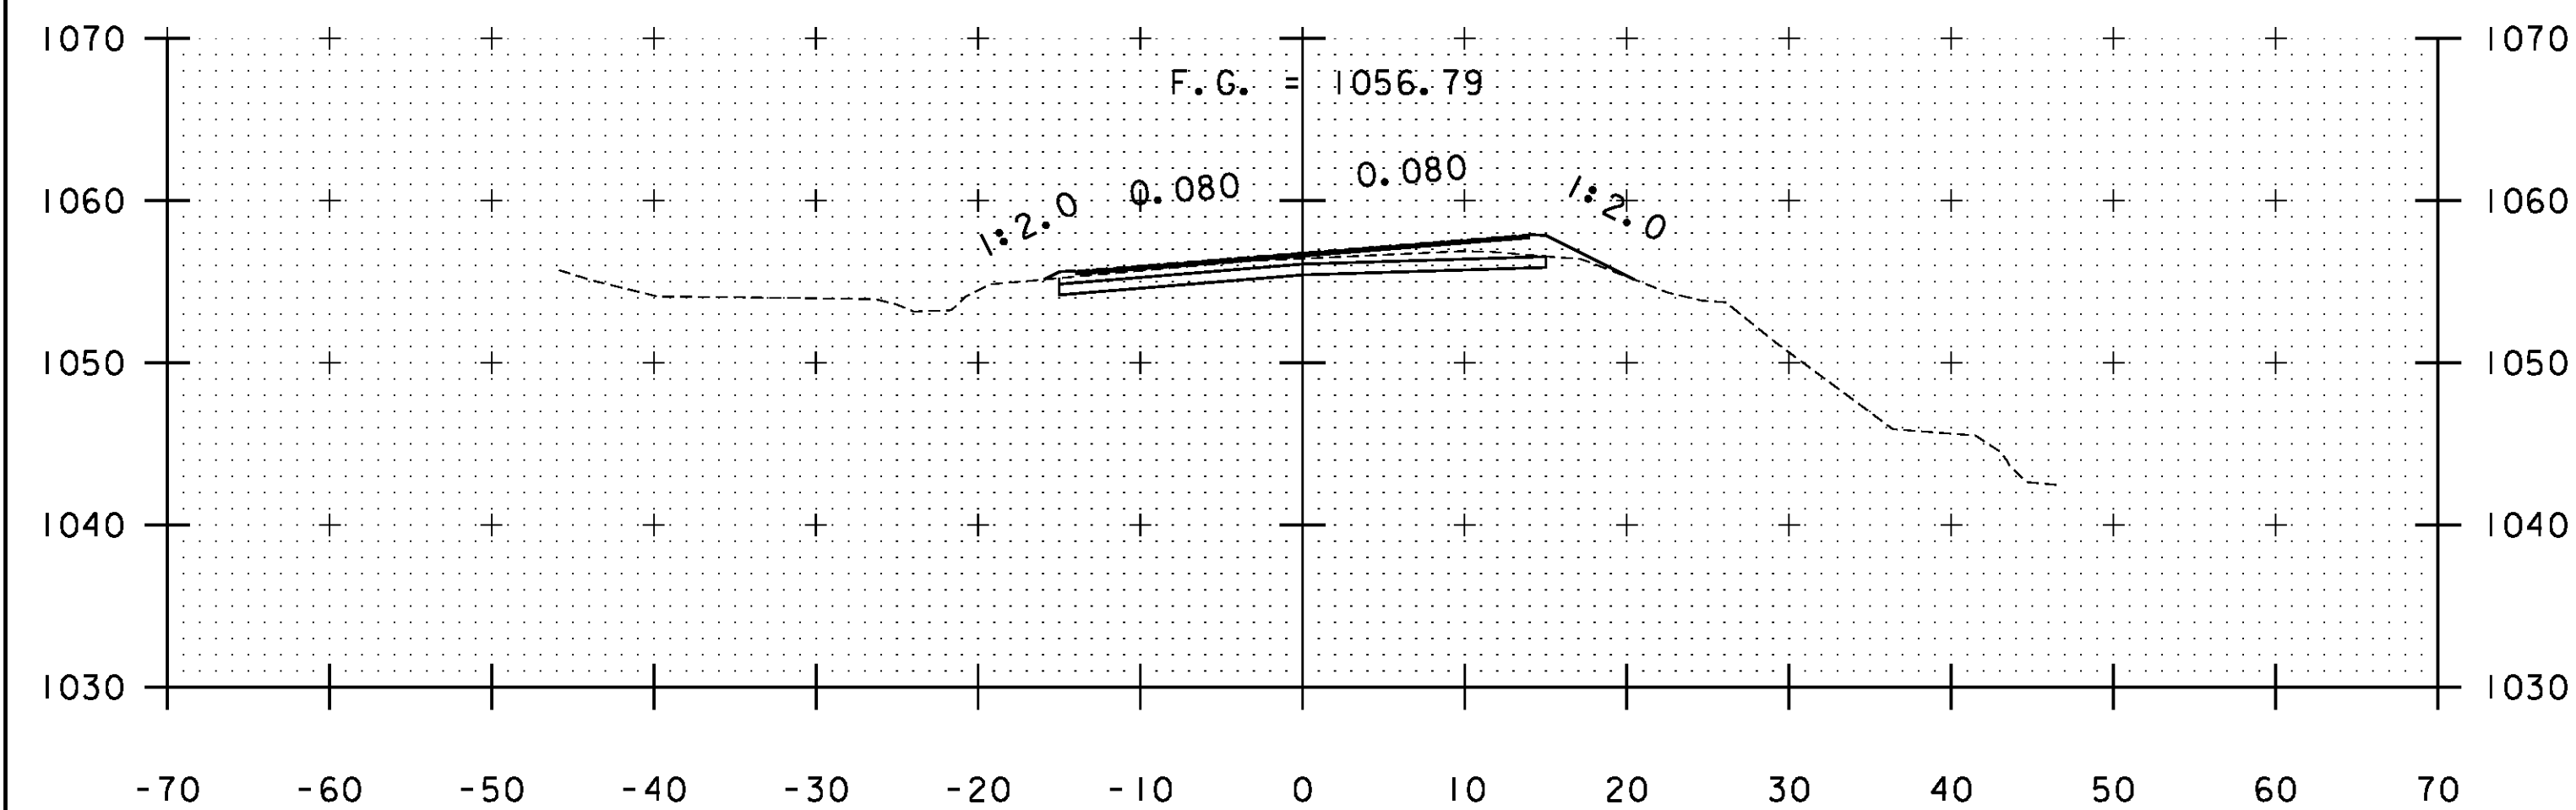


A 308+50

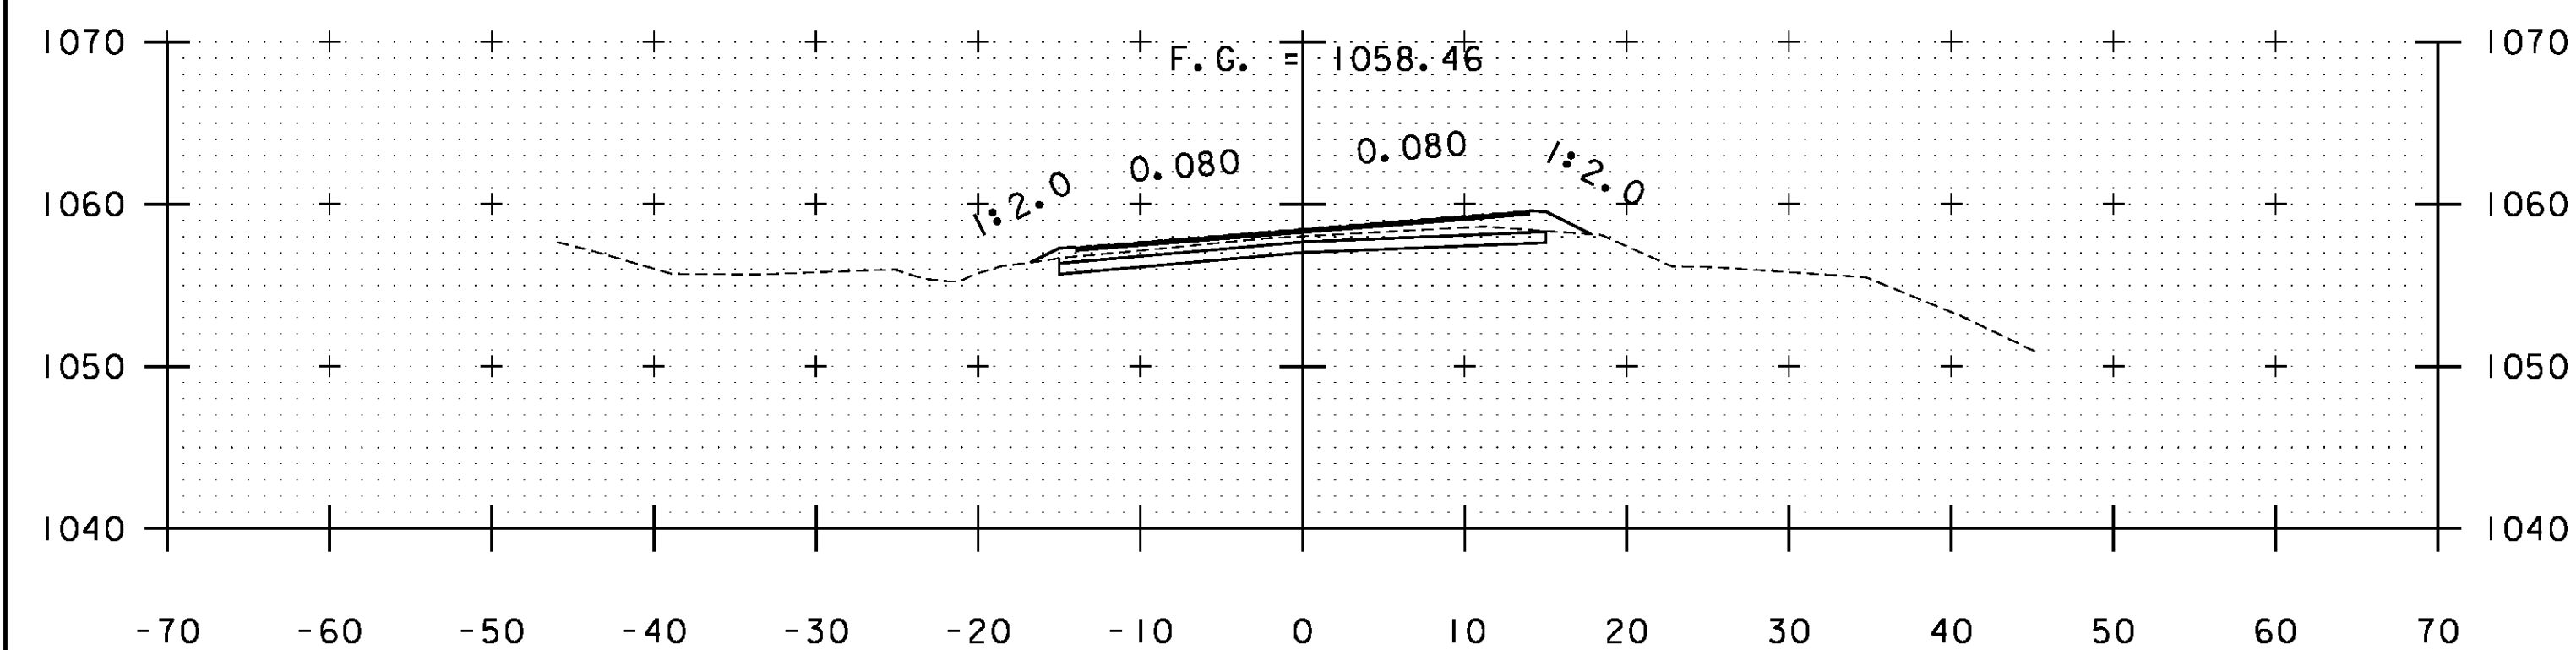

A 308+00

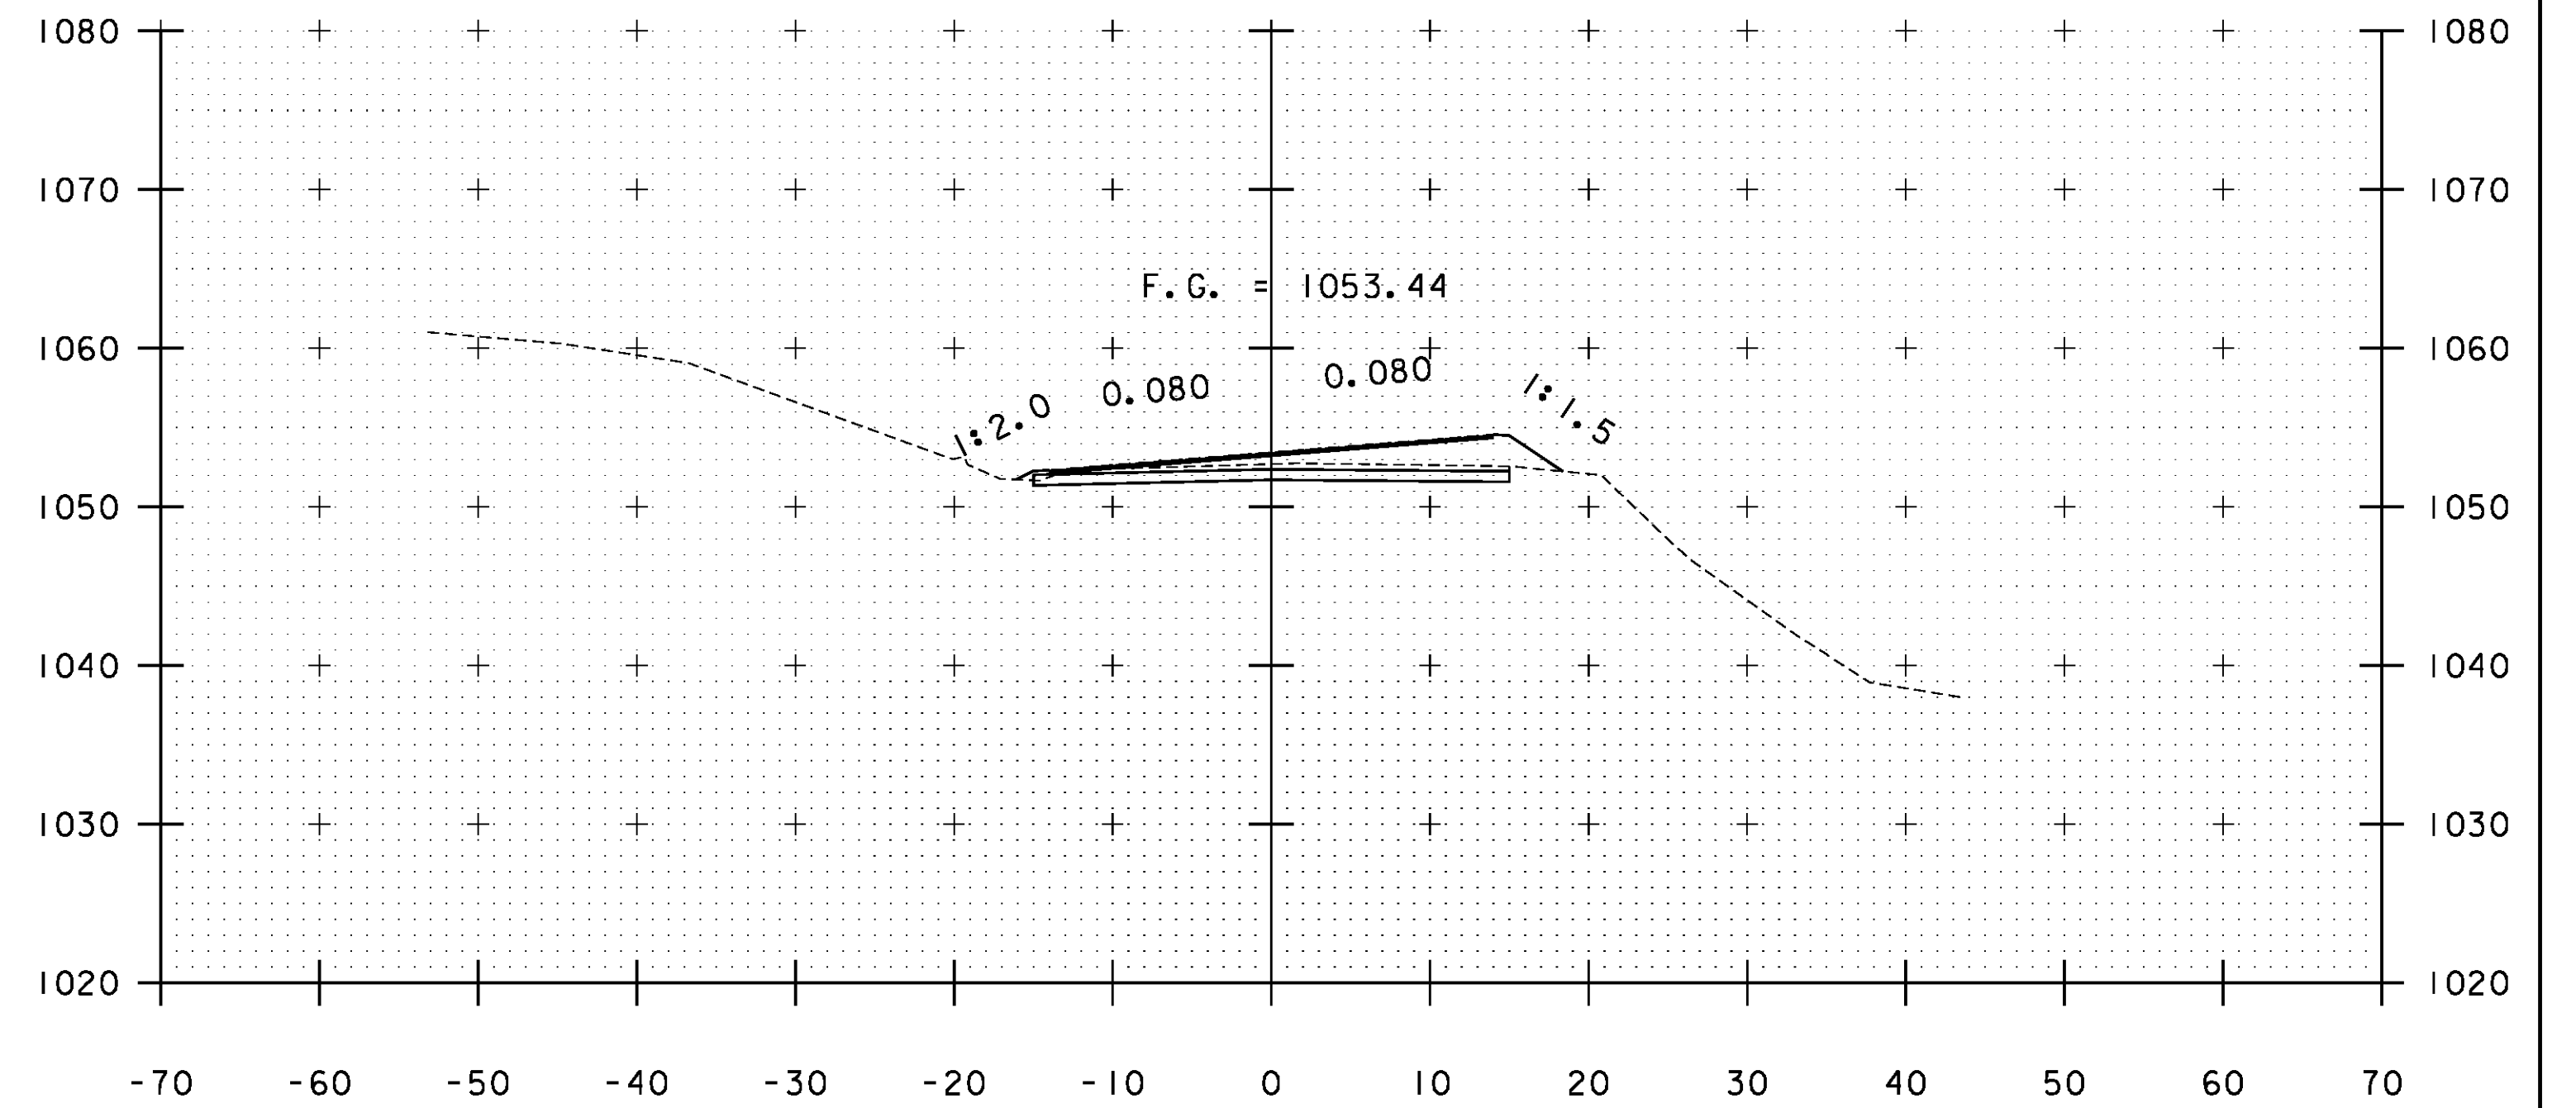

A 309+50

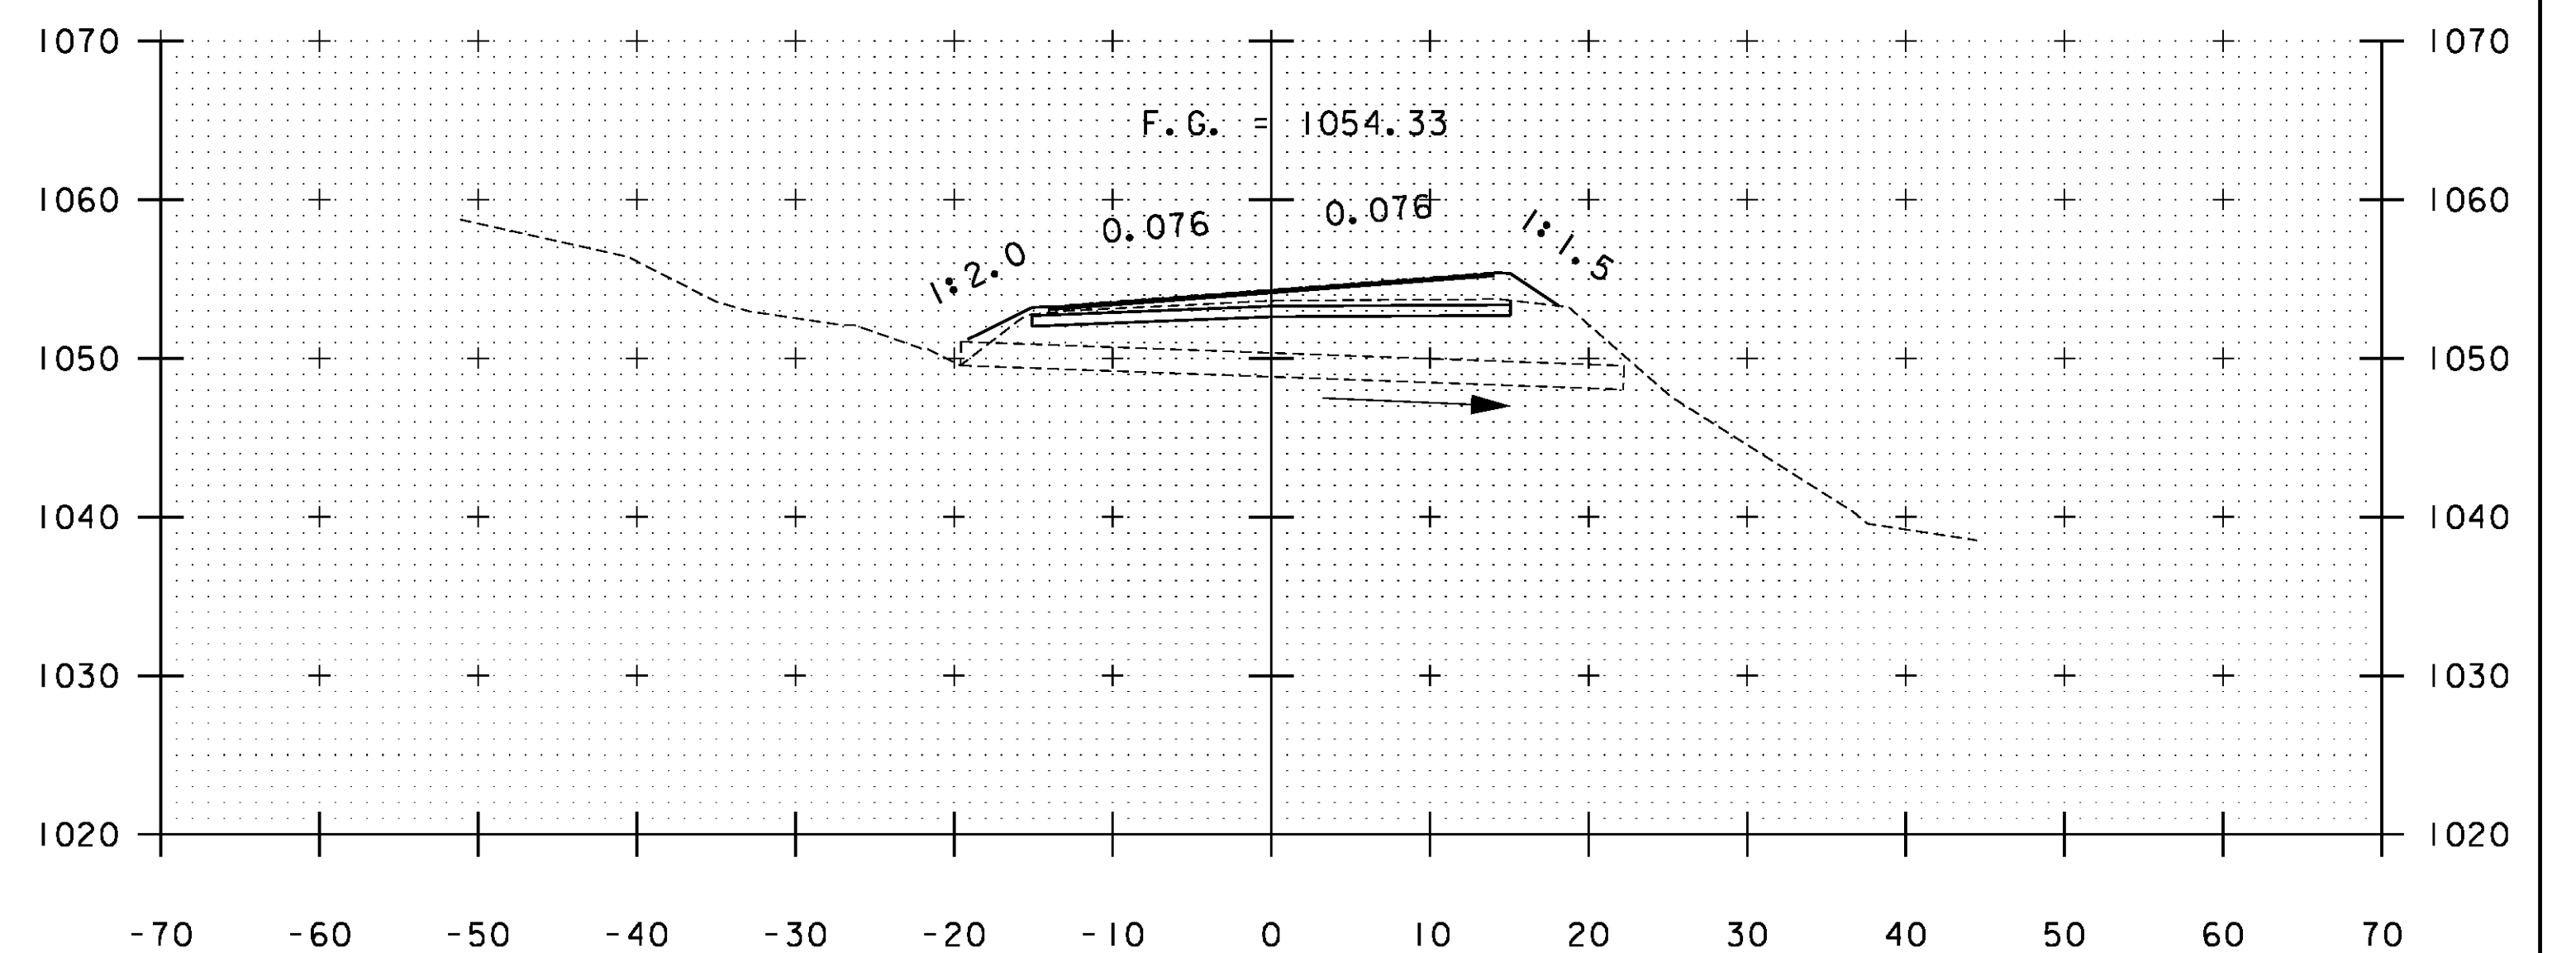

A 309+23

STA. A 308+00 TO STA. A 309+50

PROJECT NAME: WARDBORO-JAMAICA	PLOT DATE: 2/26/2014
PROJECT NUMBER: ER STP 013-1(17)	DRAWN BY: B. KIPP
FILE NAME: xs.dgn	CHECKED BY: HSD
PROJECT LEADER: K. UPMAL	SHEET 300 OF 444
DESIGNED BY: B. KIPP	
CROSS SECTIONS	