




A 310+50

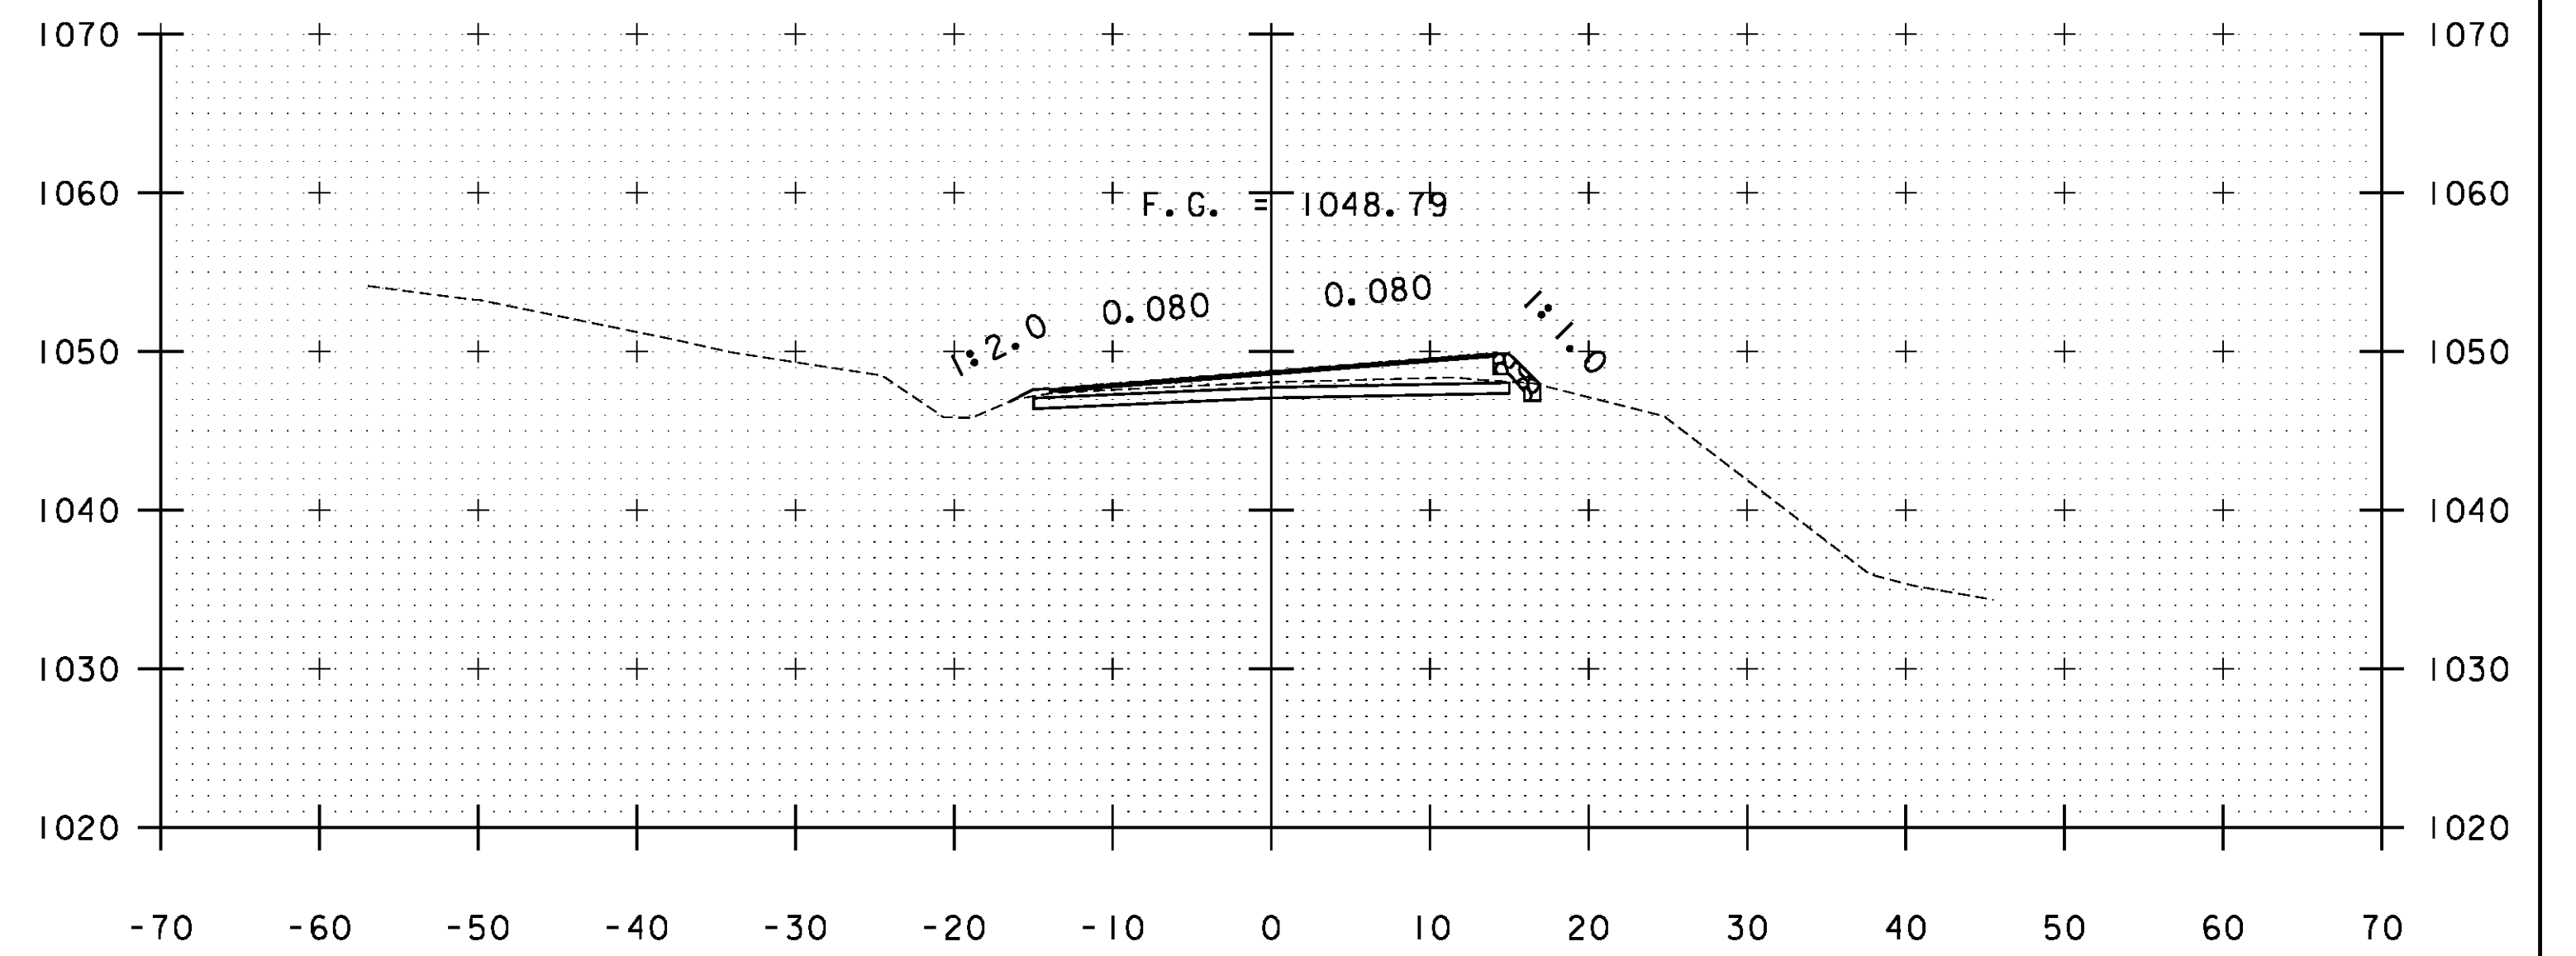

A 311+50

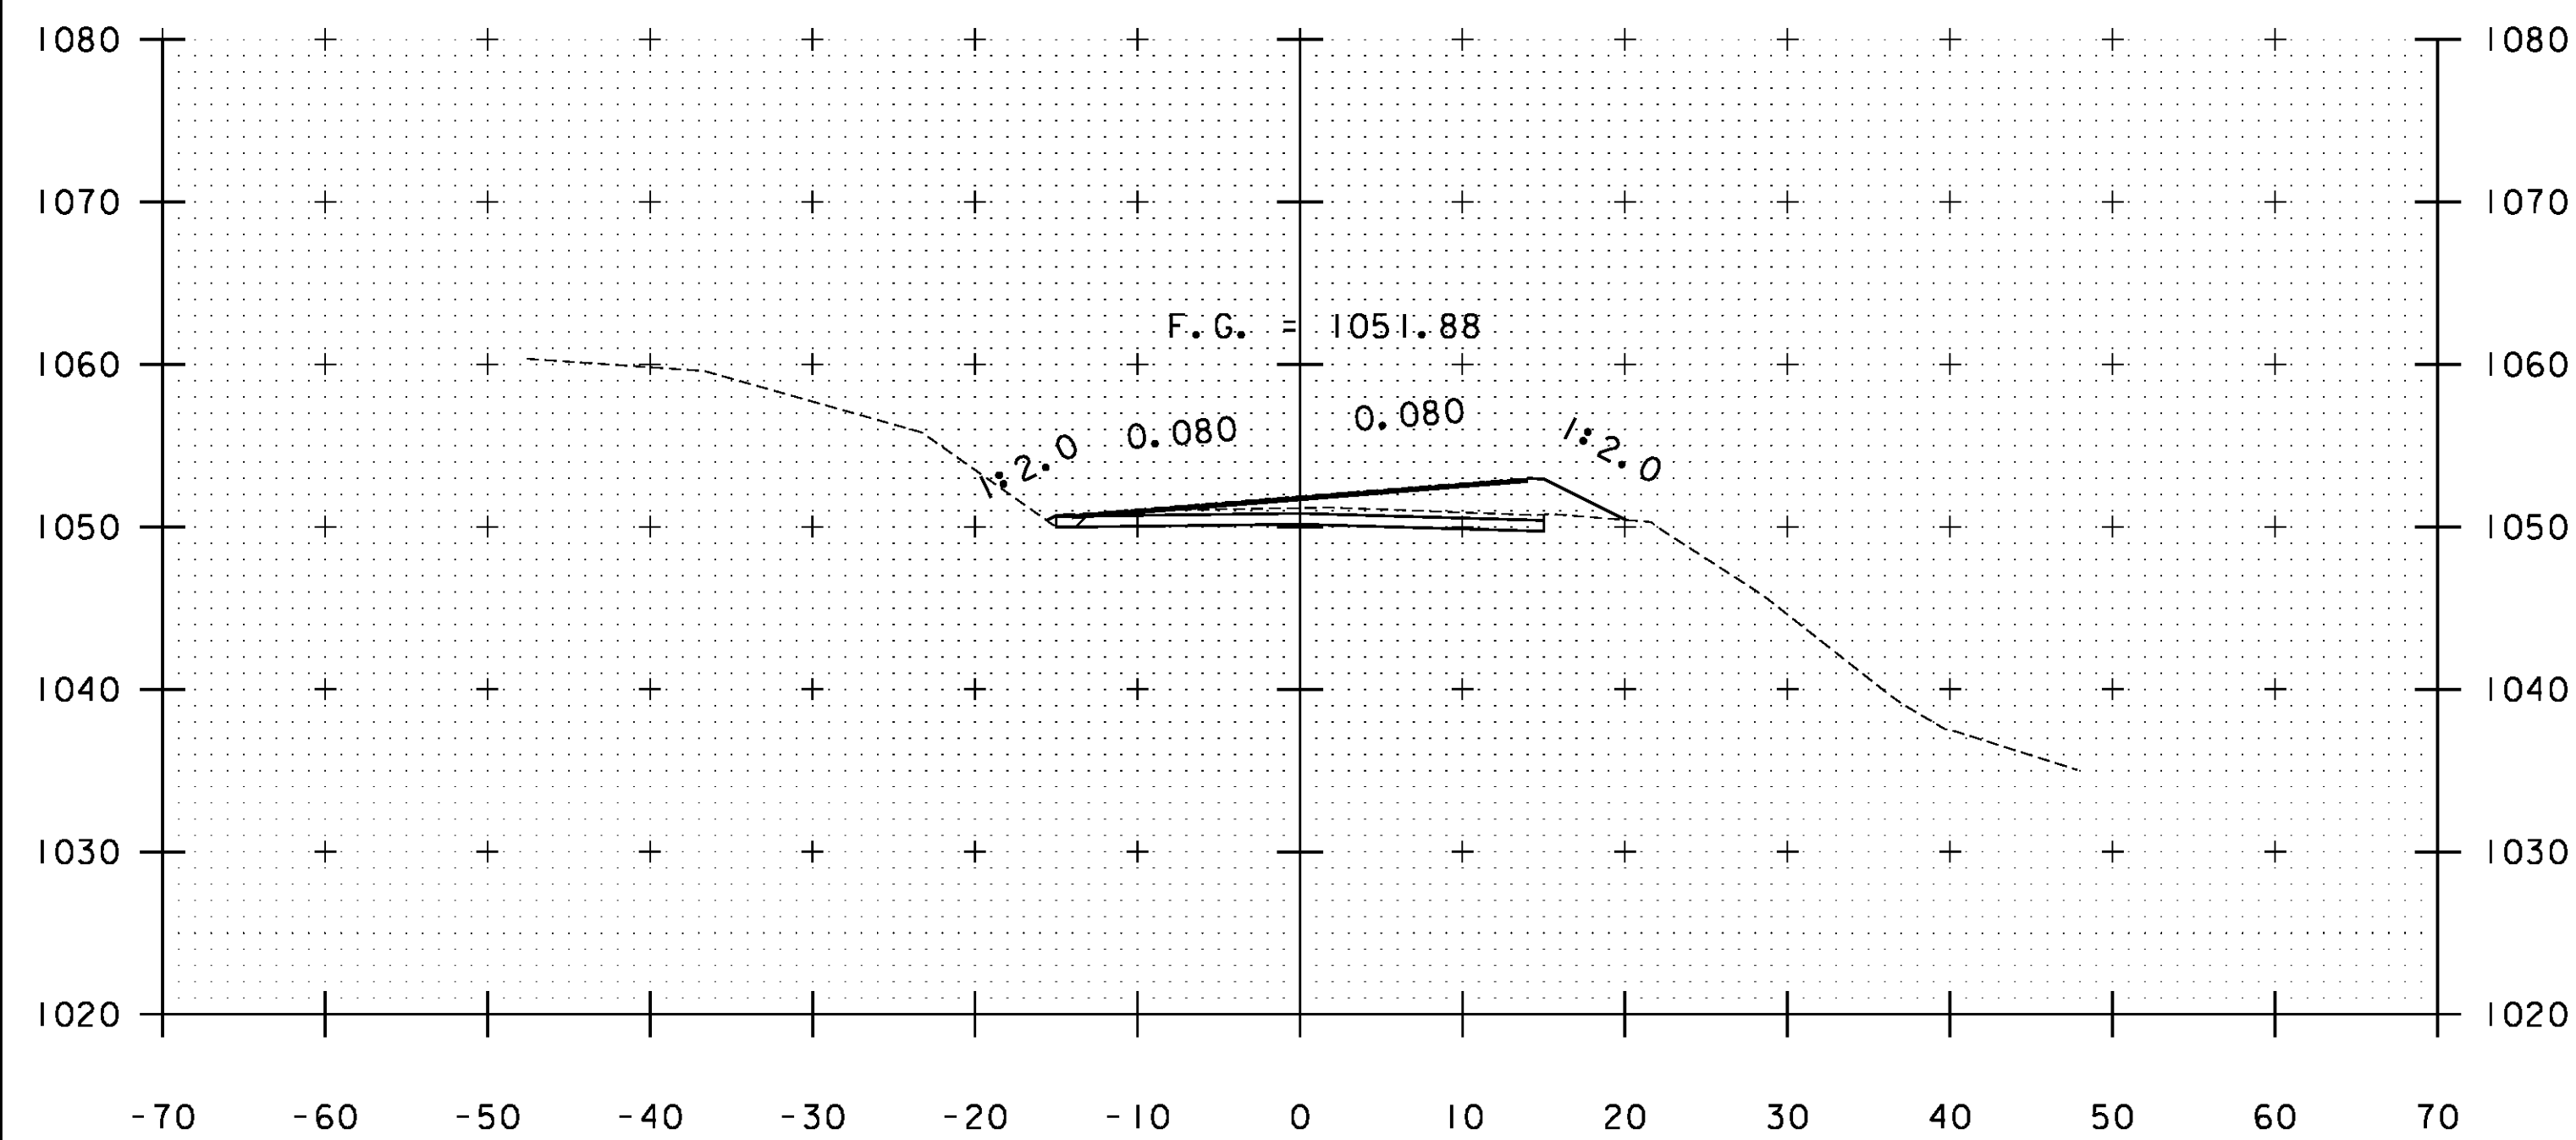

A 310+00

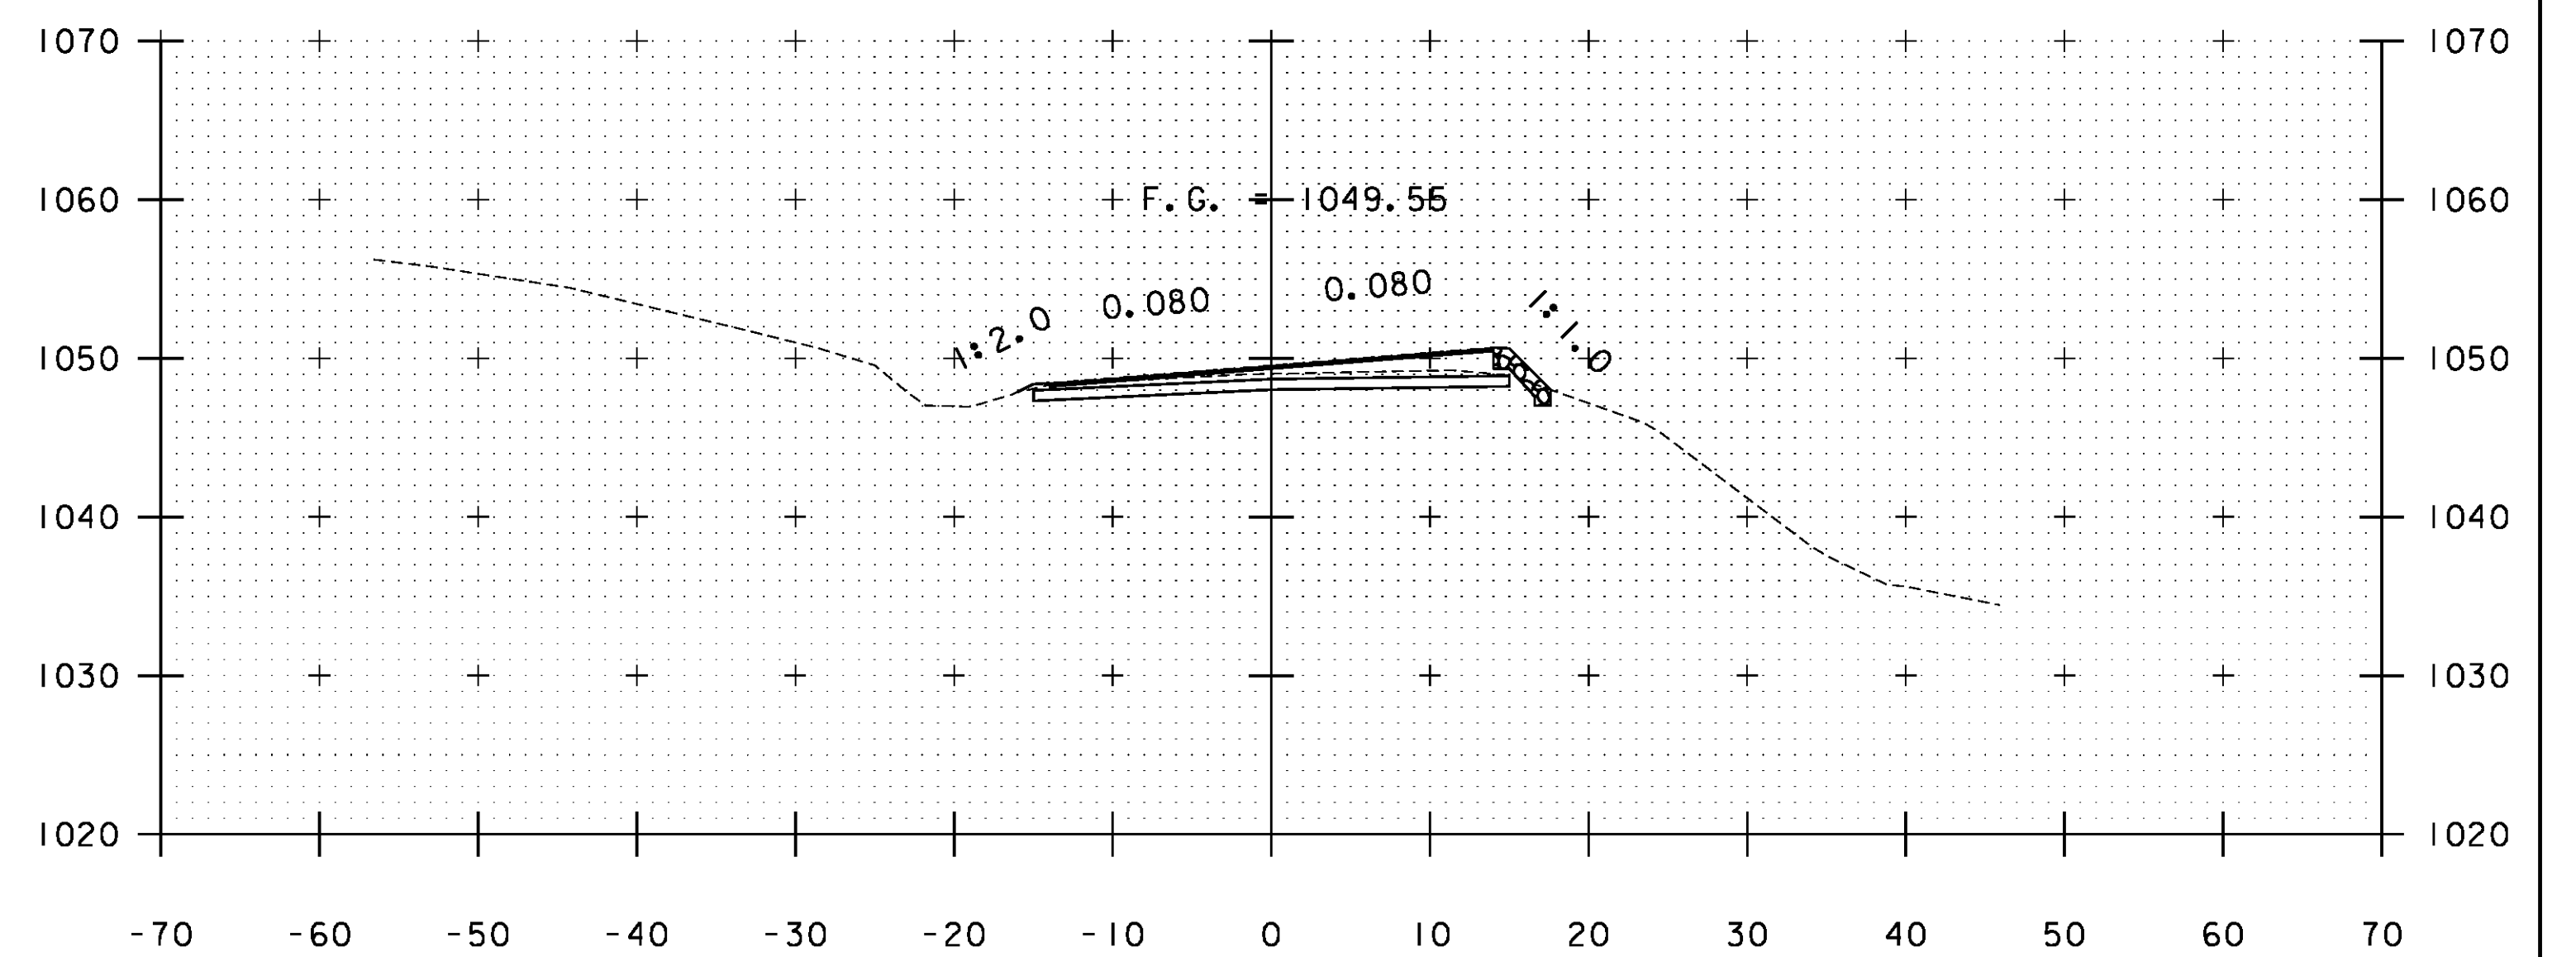

A 311+00

STA. A 310+00 TO STA. A 311+50

PROJECT NAME:	WARDSBORO-JAMAICA	PLOT DATE:	2/26/2014
PROJECT NUMBER:	ER STP 013-1(17)	DRAWN BY:	B. KIPP
FILE NAME:	xs.dgn	DESIGNED BY:	B. KIPP
PROJECT LEADER:	K. UPMAL	CHECKED BY:	HSD
CROSS SECTIONS		SHEET	301 OF 444