




A 315+00

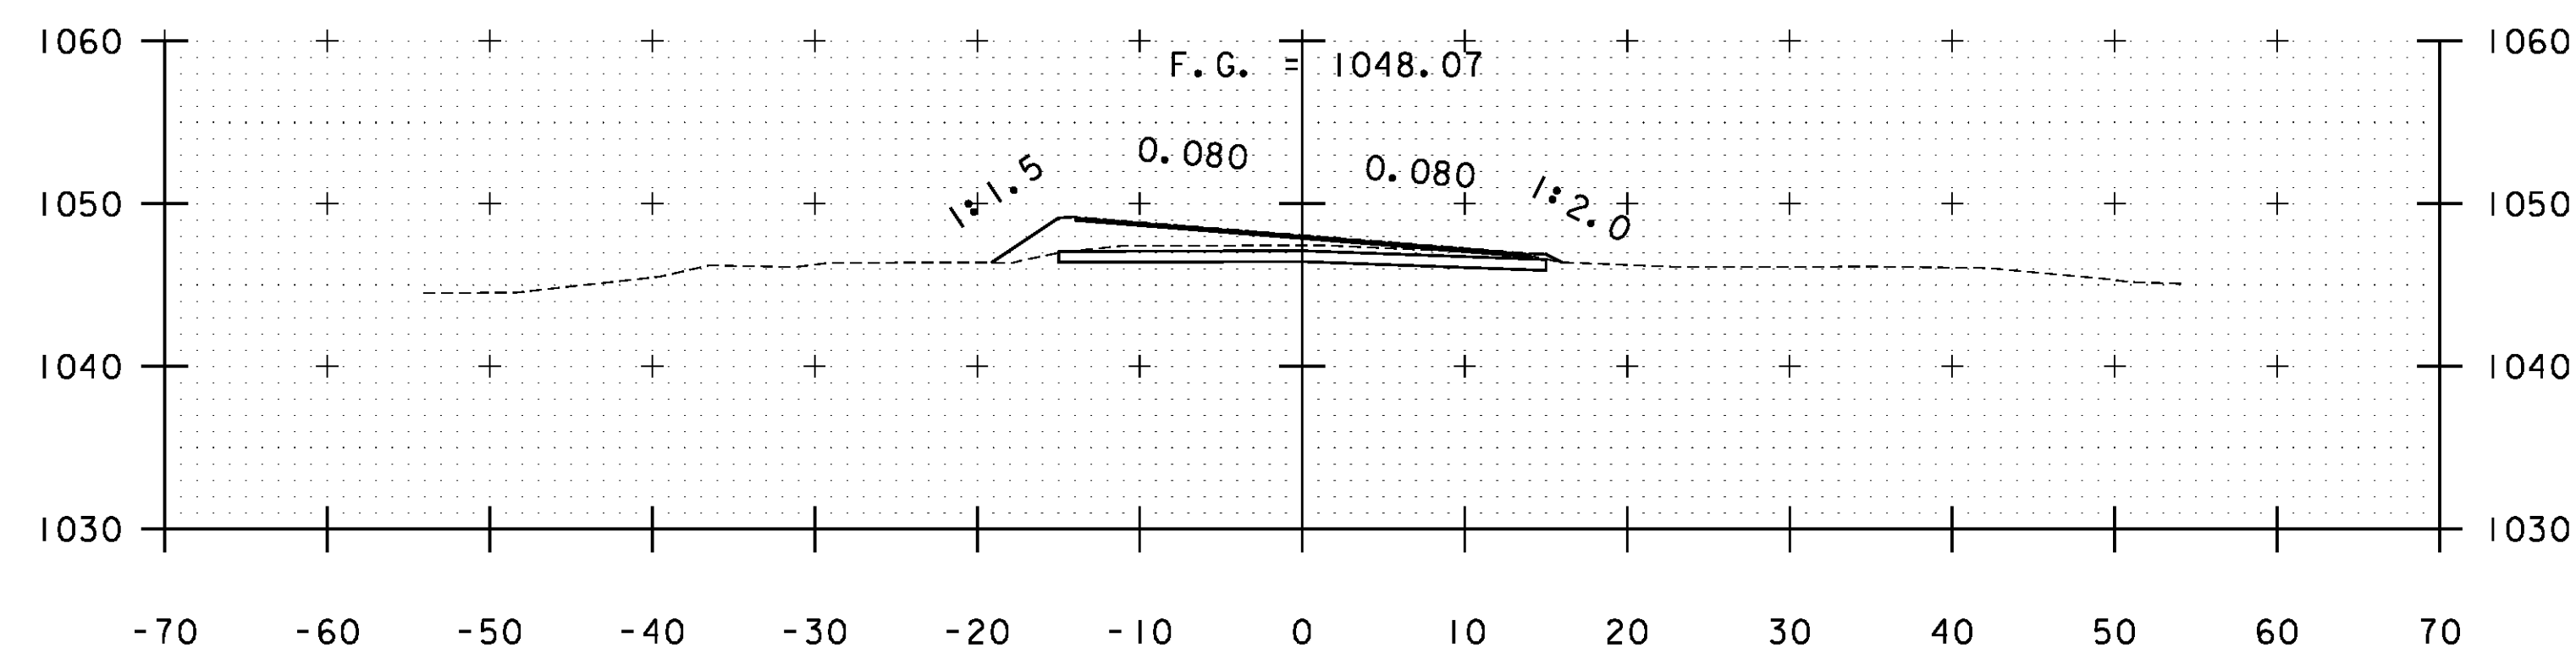


A 316+50

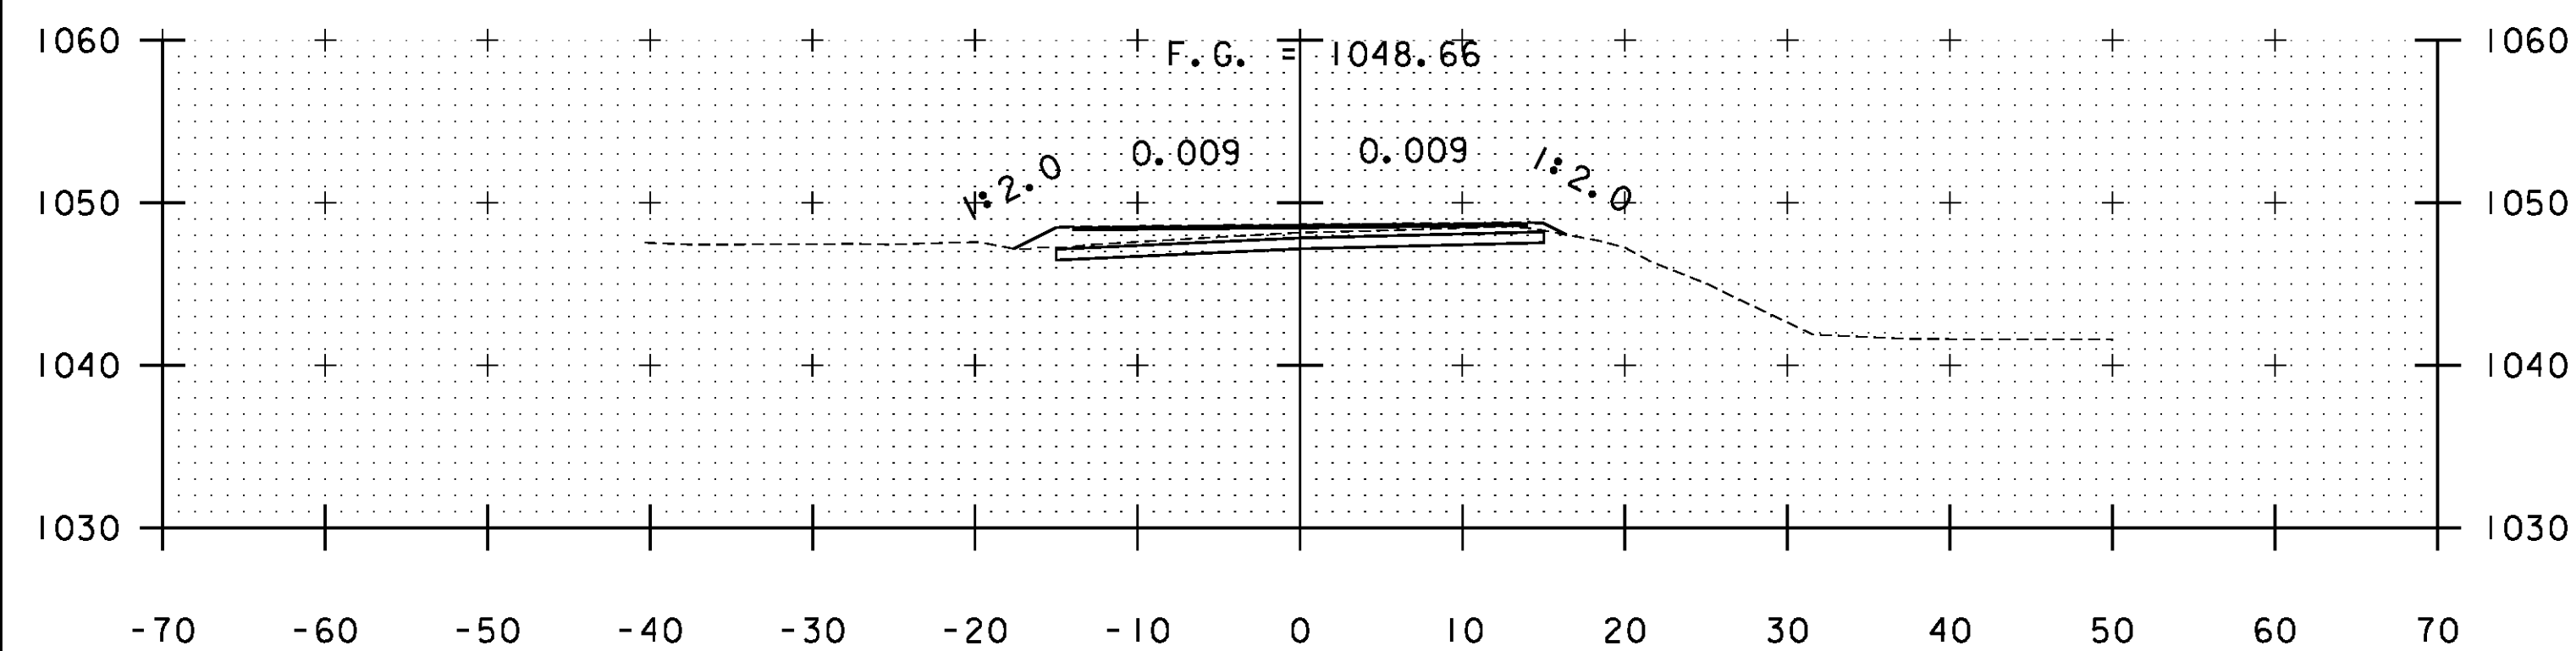


A 314+50

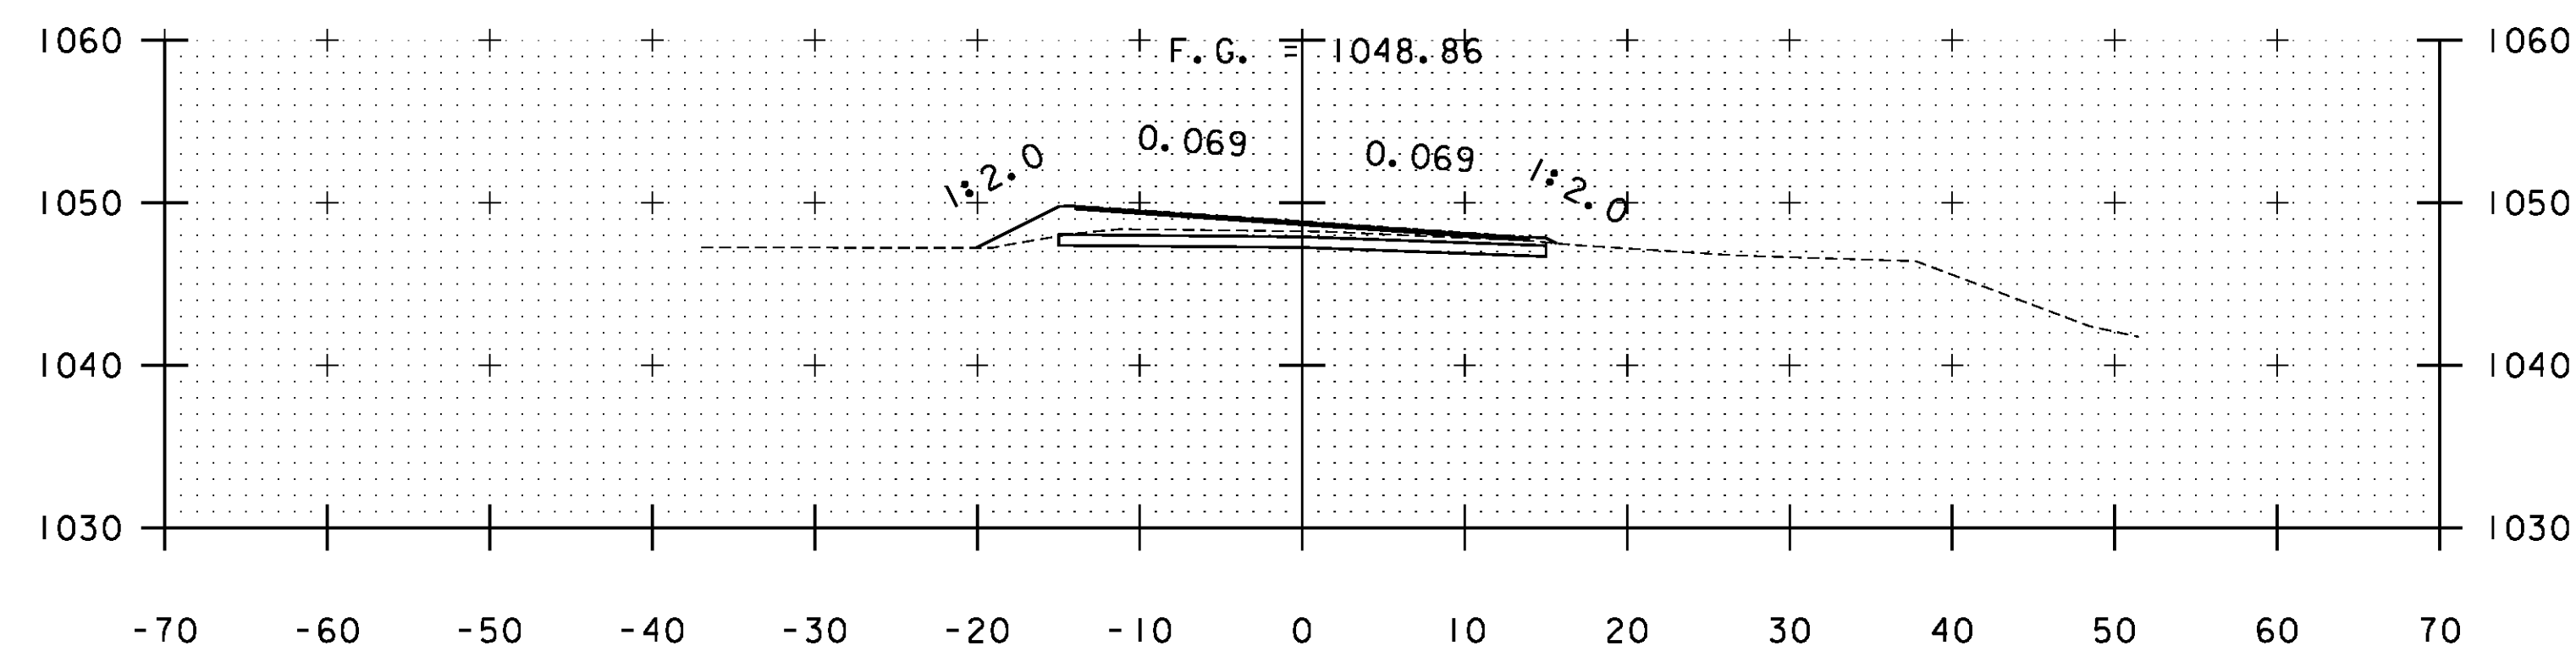

A 316+00

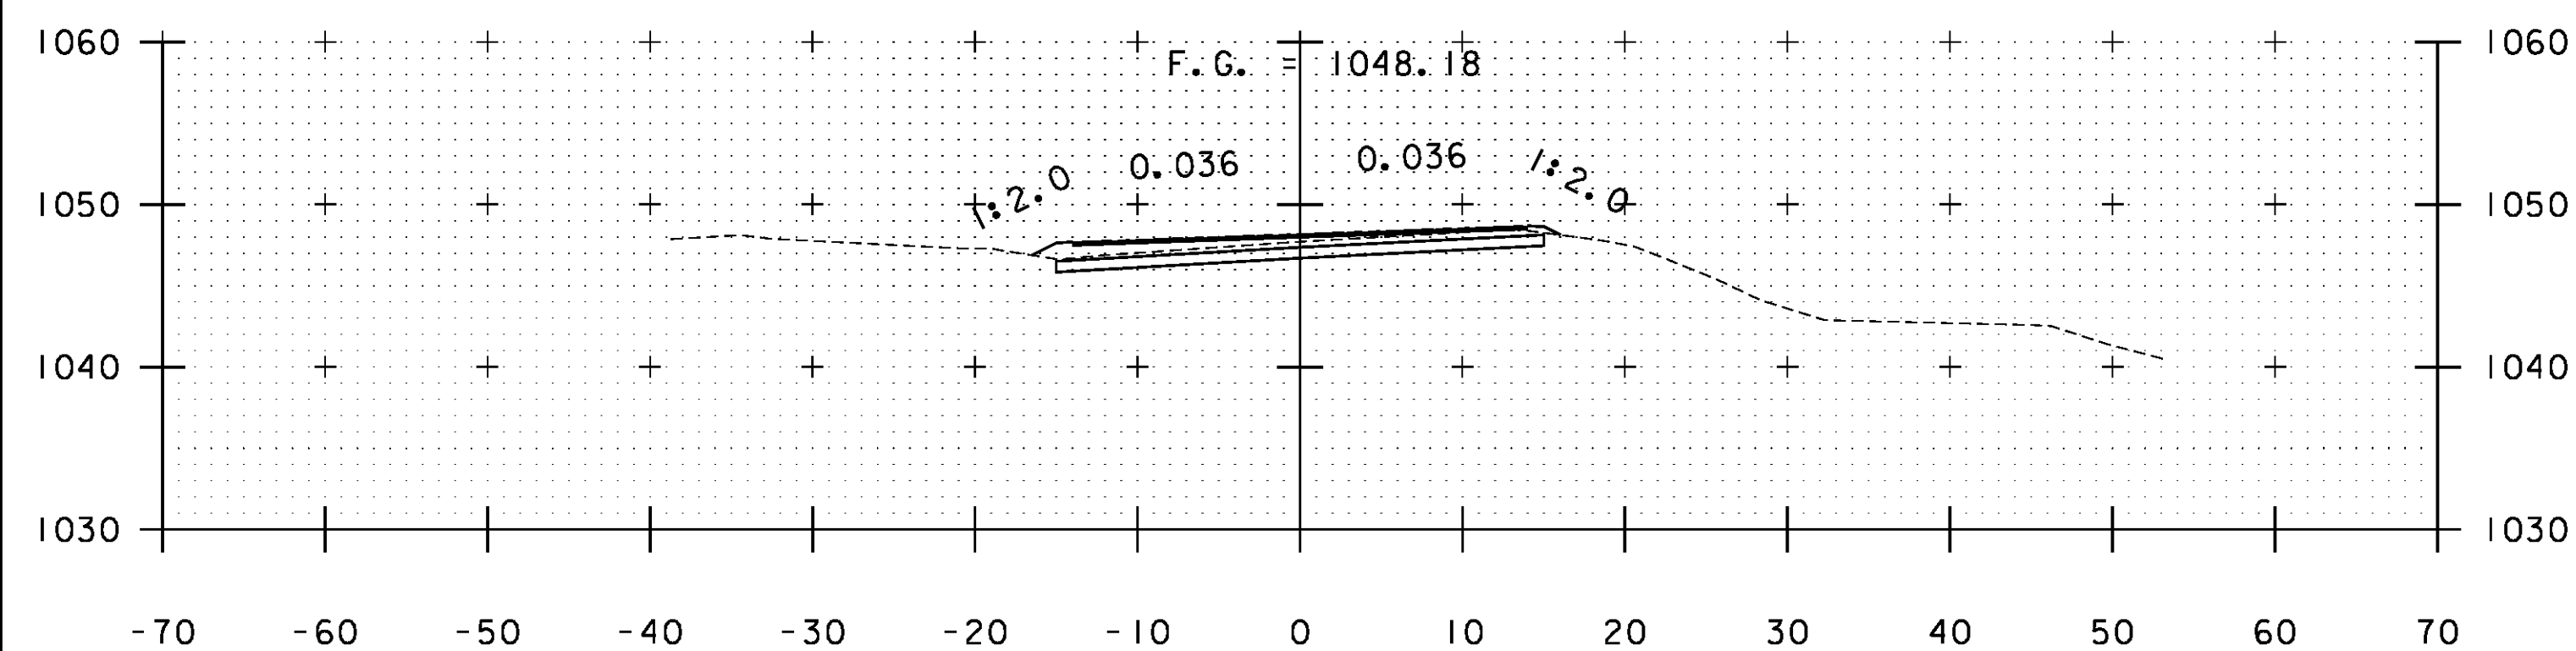

A 314+00

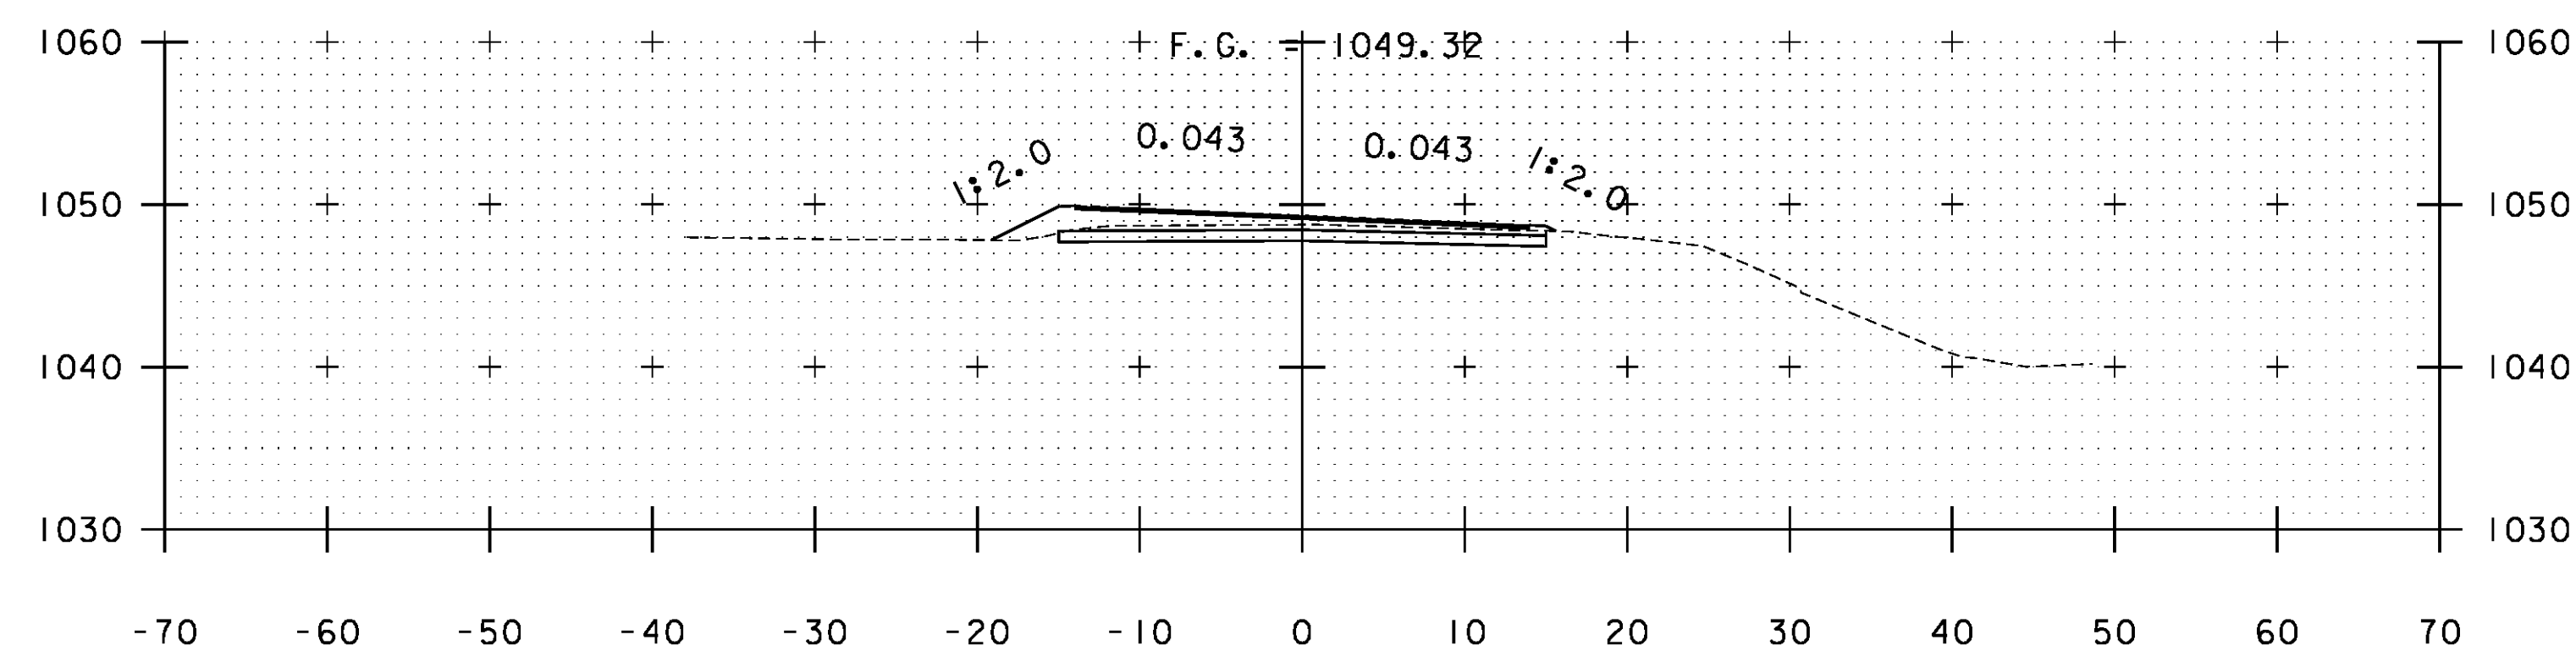

A 315+50

STA. A 314+00 TO STA. A 316+50

PROJECT NAME: WARDBORO-JAMAICA	PLOT DATE: 2/26/2014
PROJECT NUMBER: ER STP 013-1(17)	DRAWN BY: B. KIPP
FILE NAME: xs.dgn	CHECKED BY: HSD
PROJECT LEADER: K. UPMAL	SHEET 303 OF 444
DESIGNED BY: B. KIPP	
CROSS SECTIONS	