




A 318+00

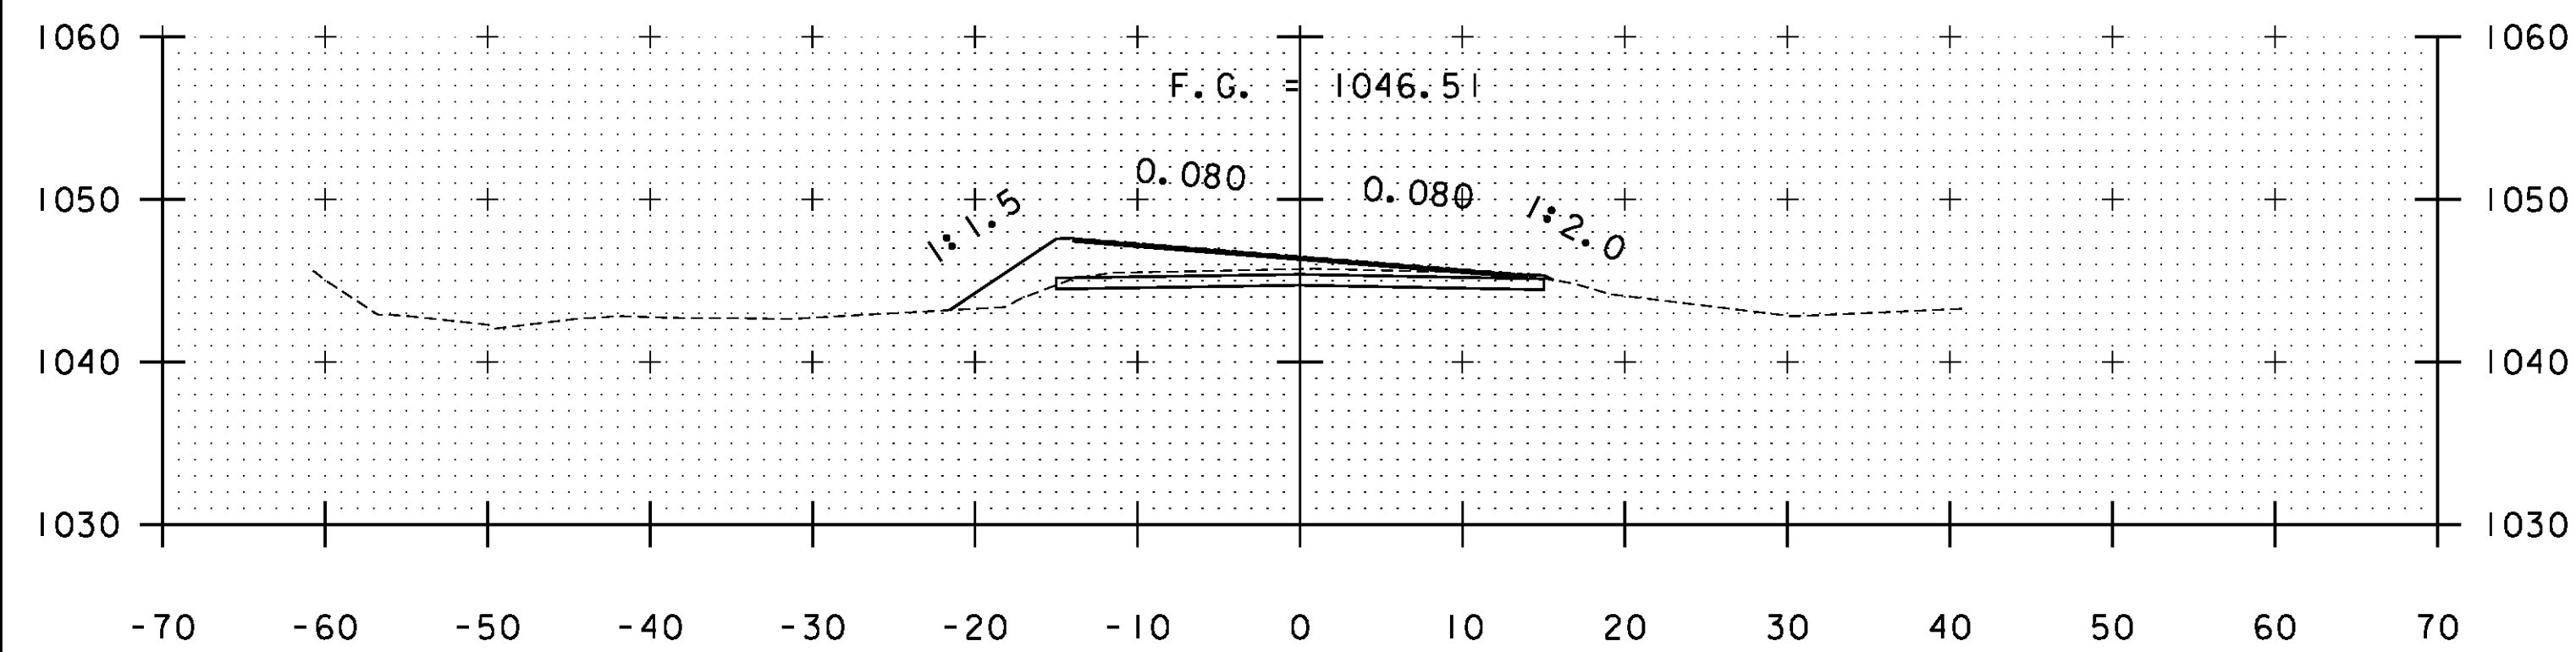


A 317+50

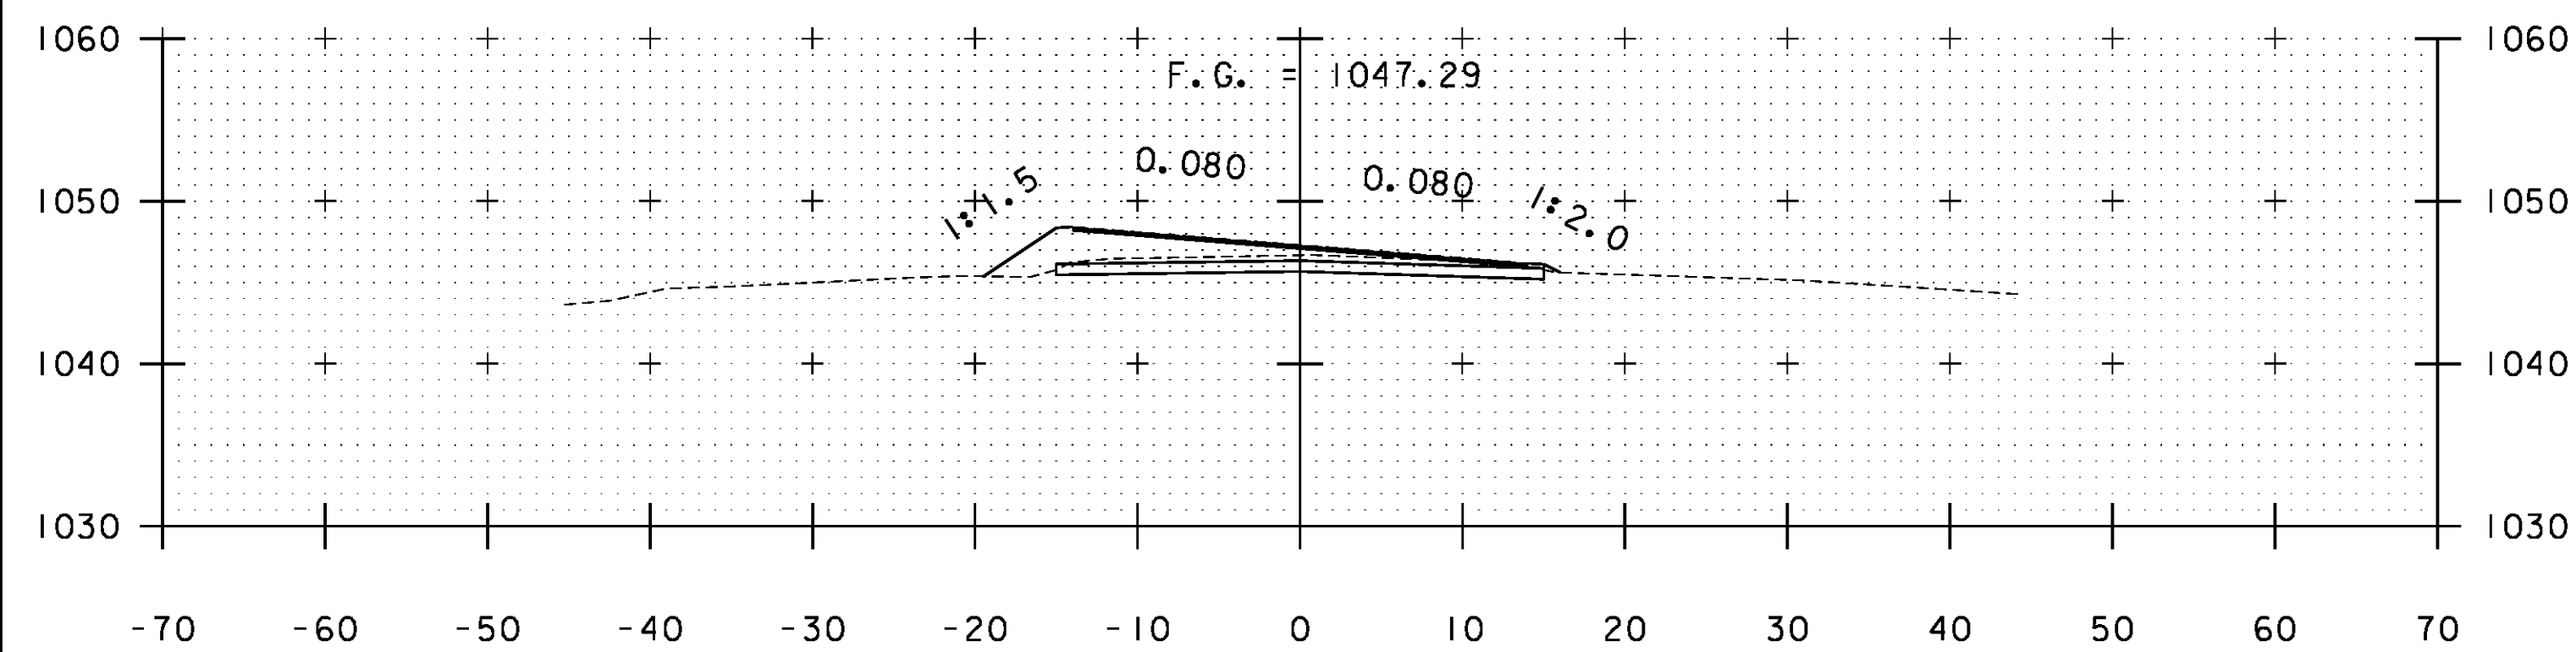

A 317+00

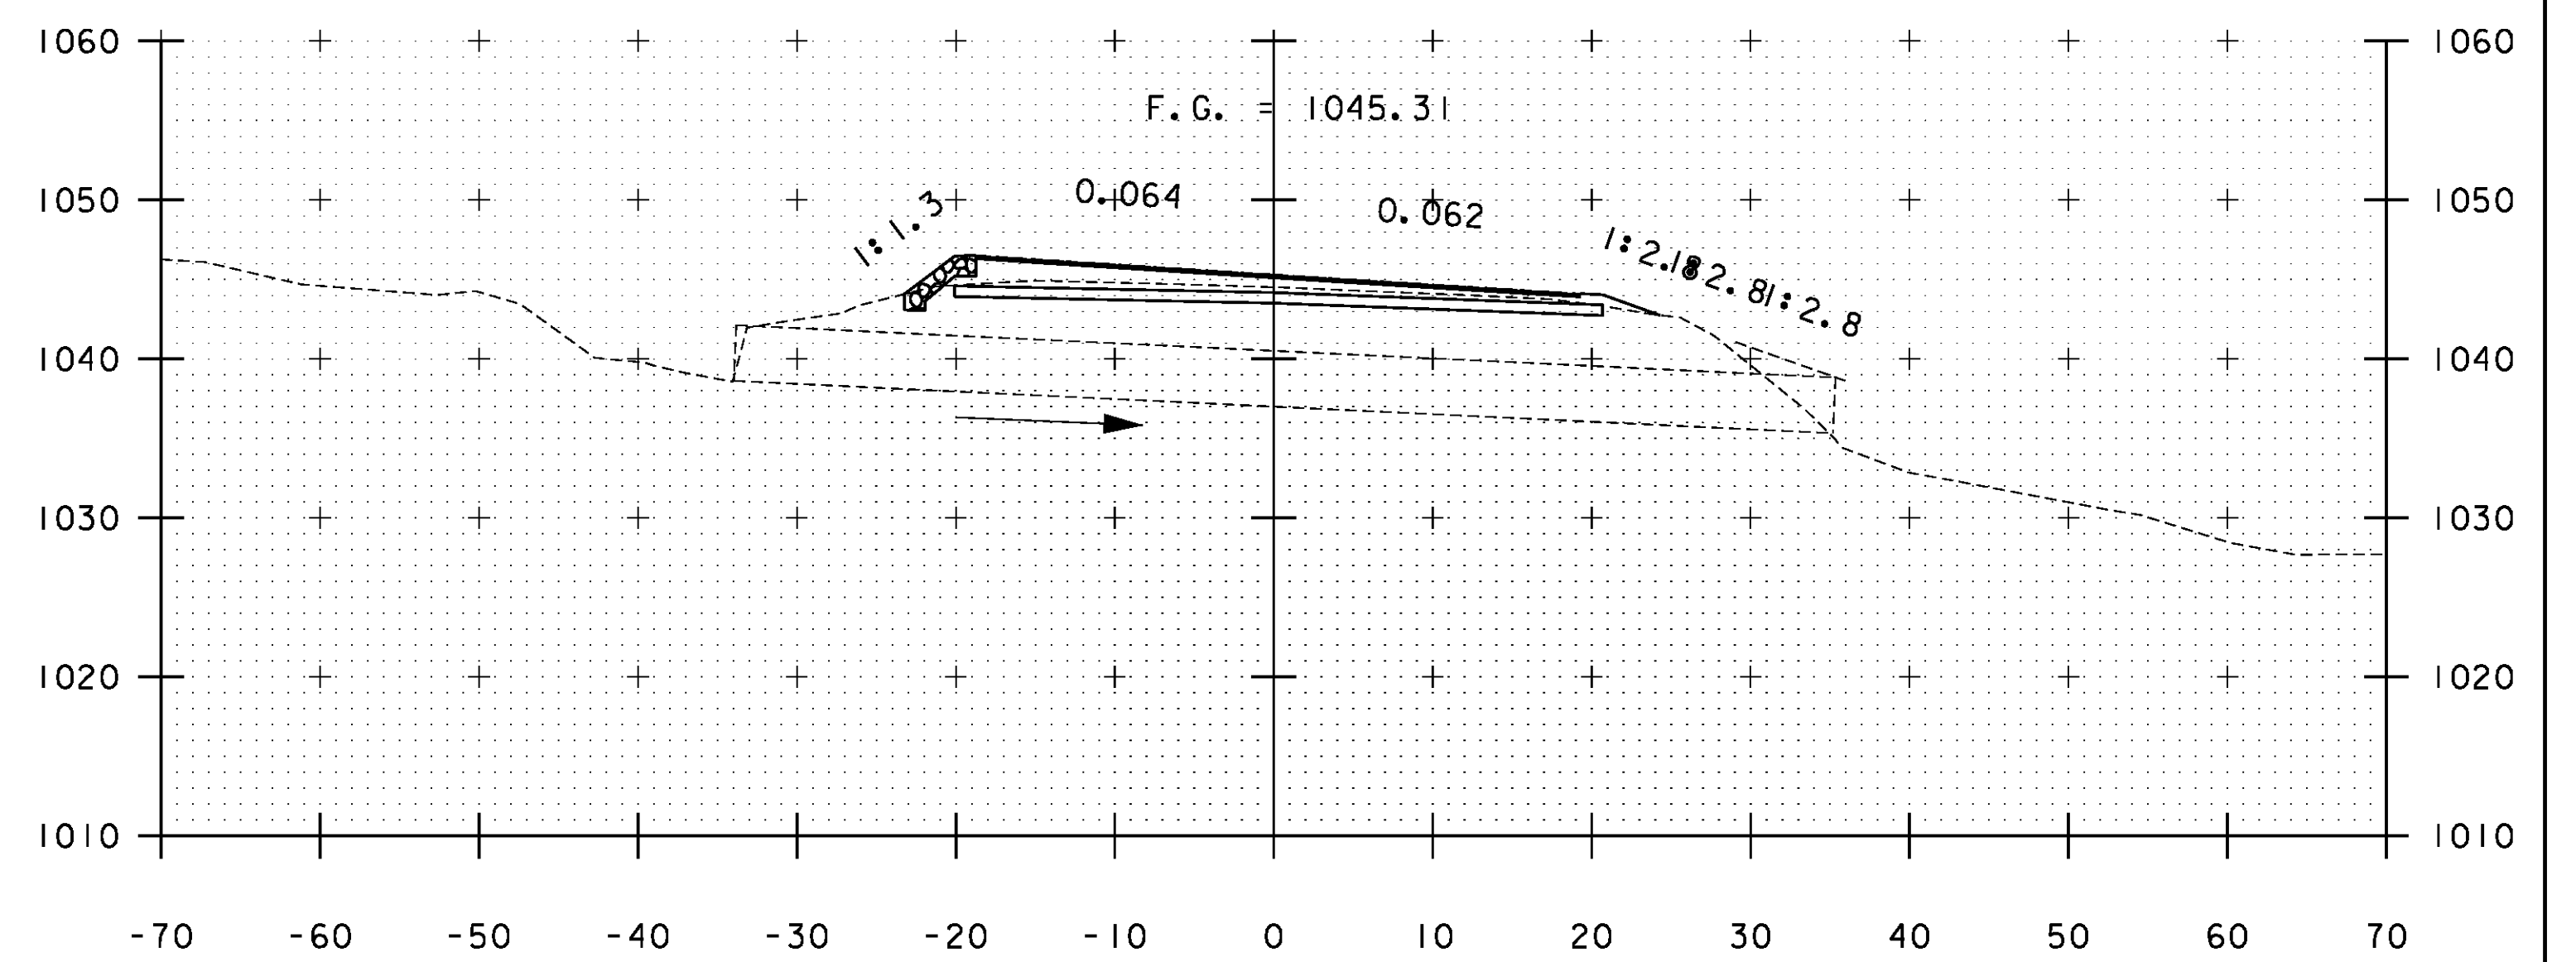

A 318+58

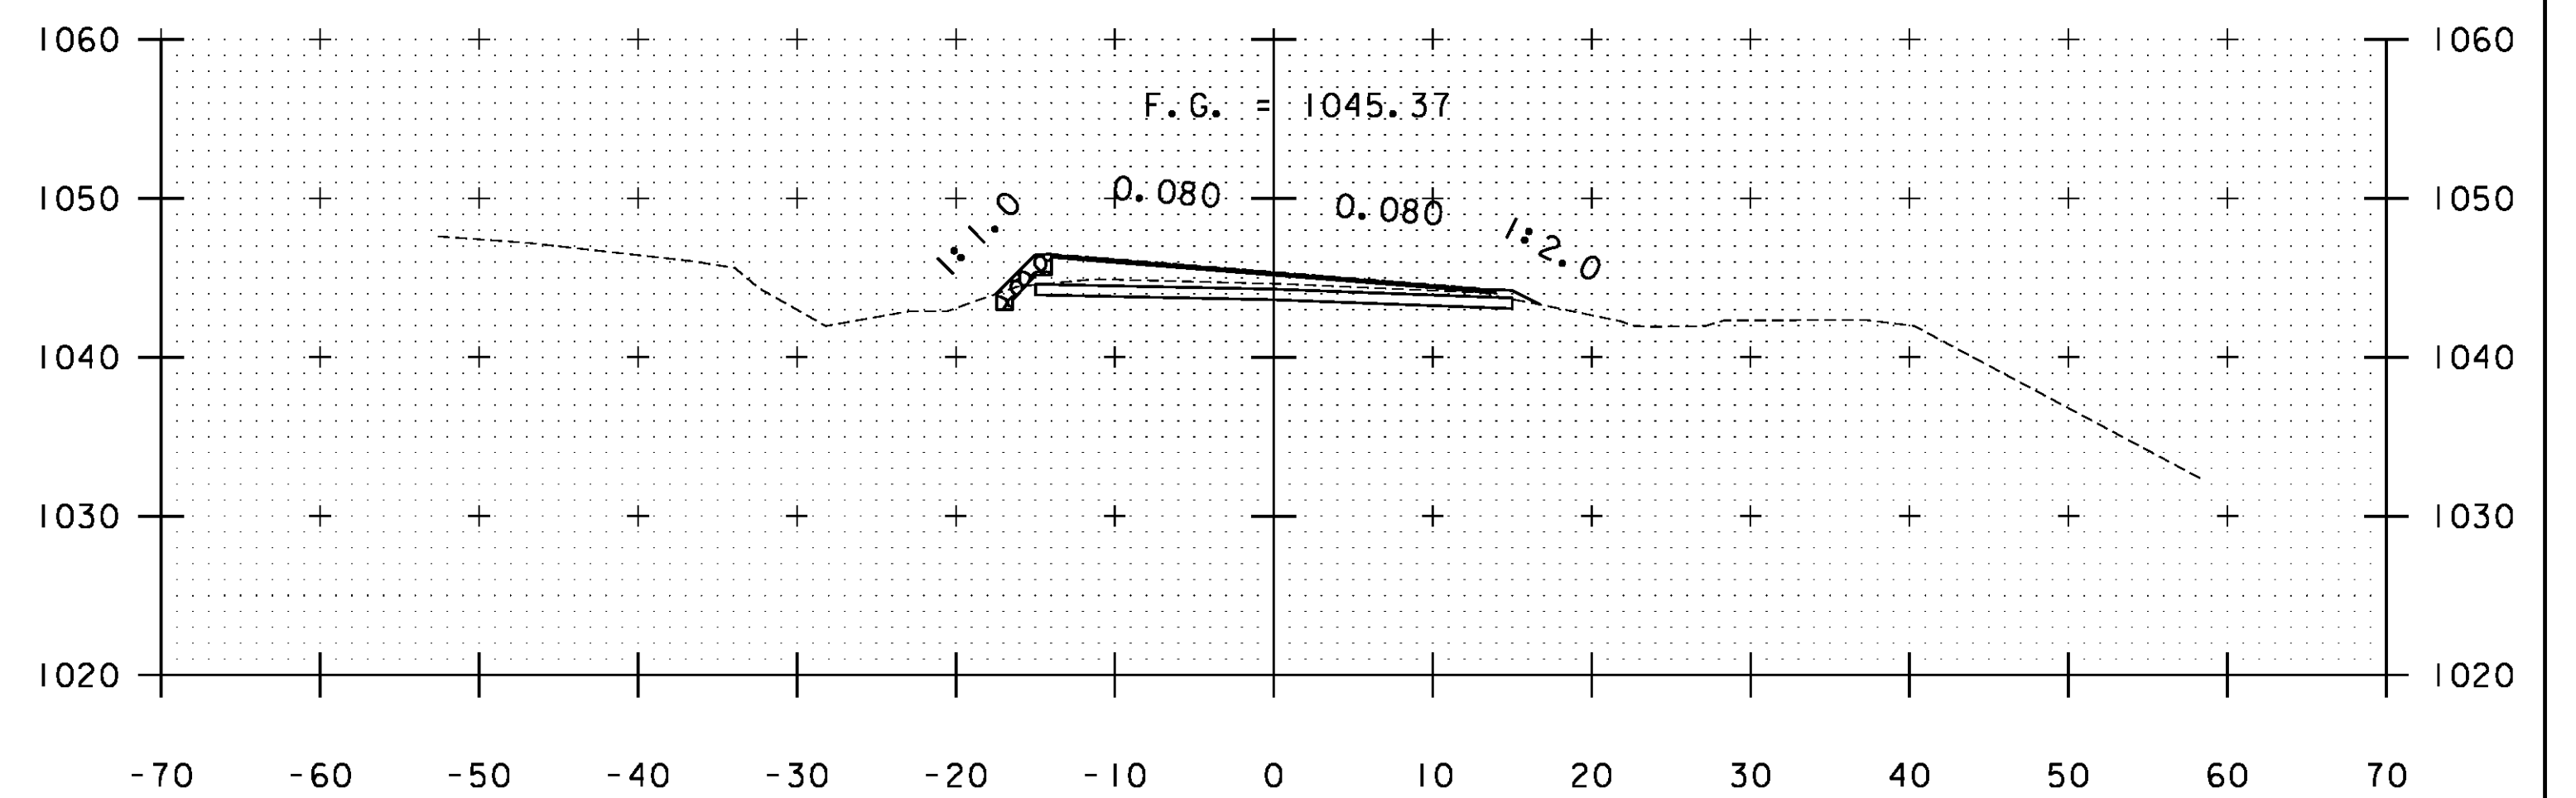

A 318+50

STA. A 317+00 TO STA. A 318+58

PROJECT NAME: WARDBORO-JAMAICA	PLOT DATE: 2/26/2014
PROJECT NUMBER: ER STP 013-1(17)	DRAWN BY: B. KIPP
FILE NAME: xs.dgn	CHECKED BY: HSD
PROJECT LEADER: K. UPMAL	SHEET 304 OF 444
DESIGNED BY: B. KIPP	
CROSS SECTIONS	