




A 331+50

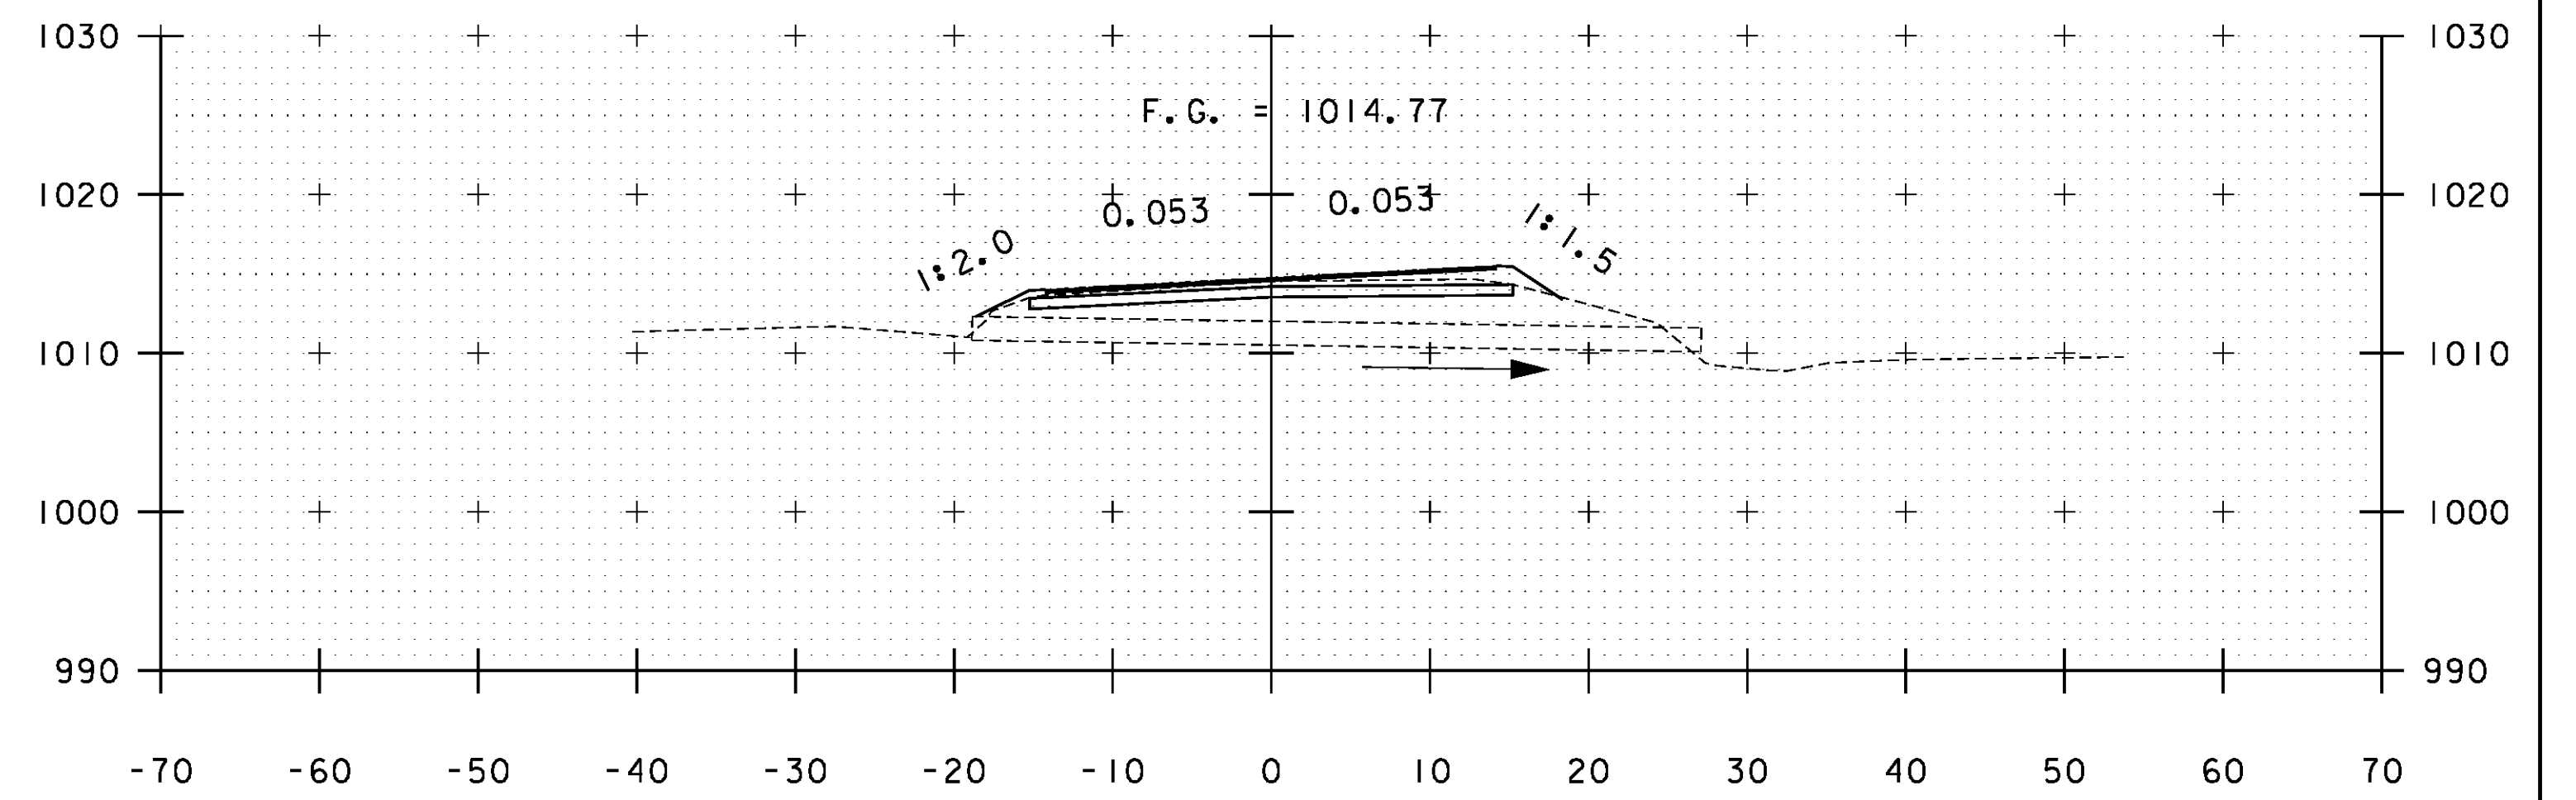


A 332+78

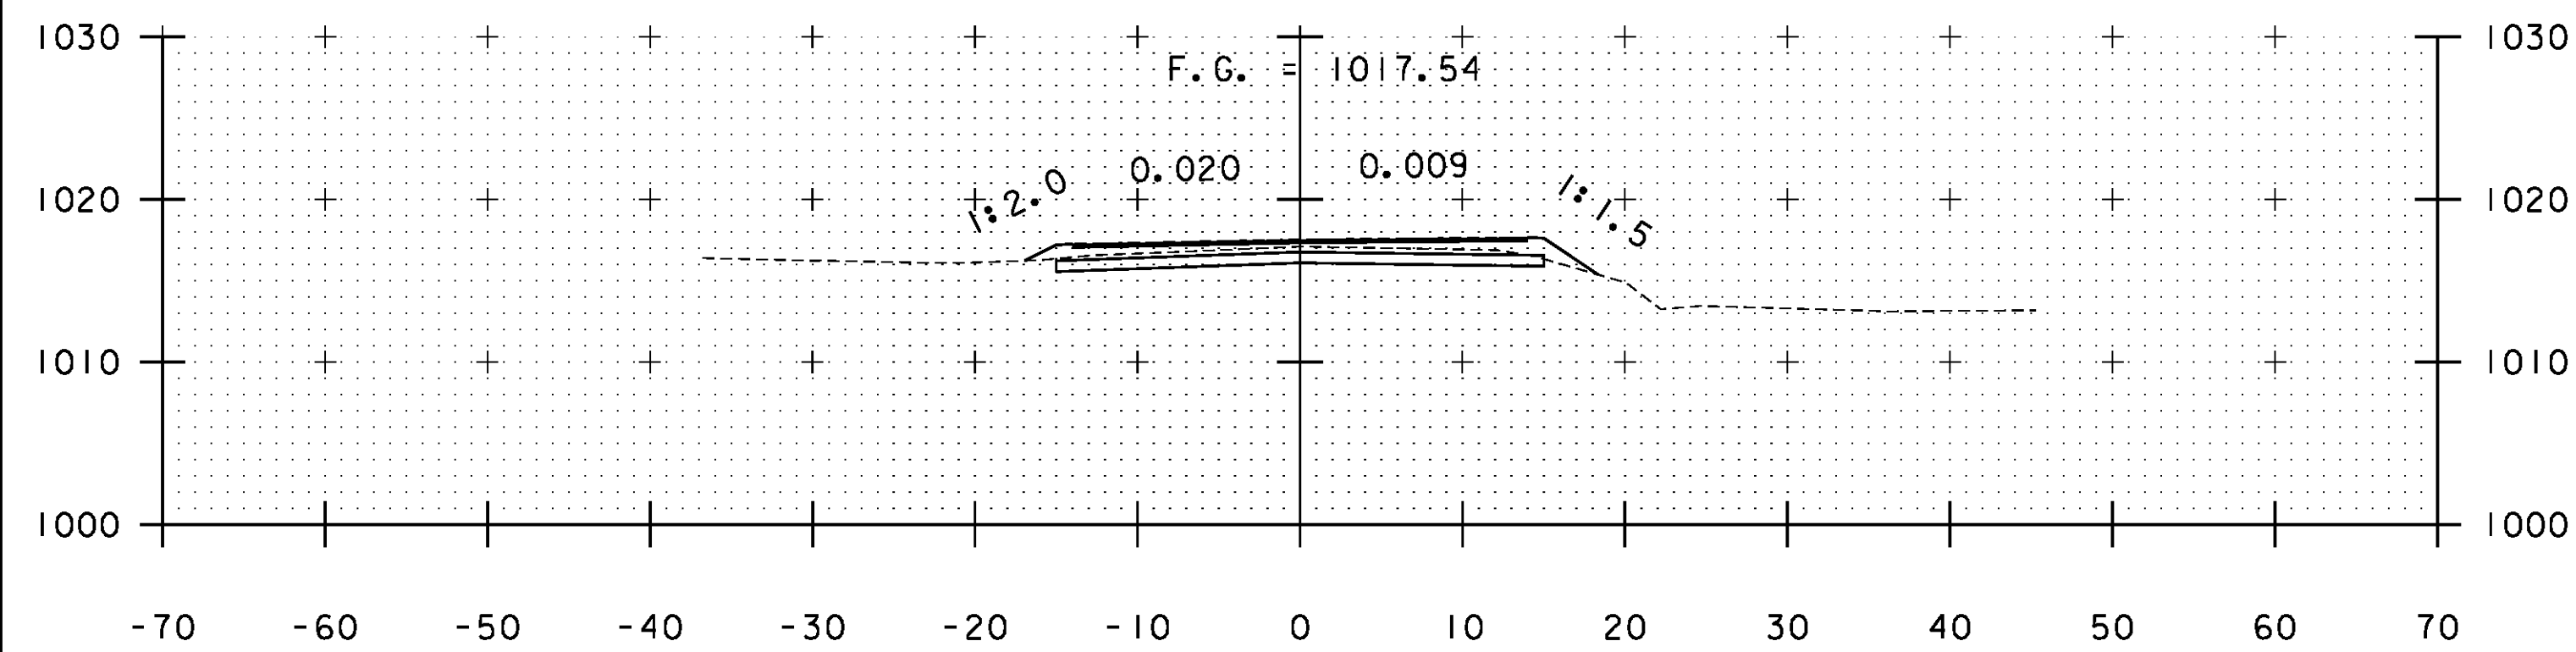


A 331+00

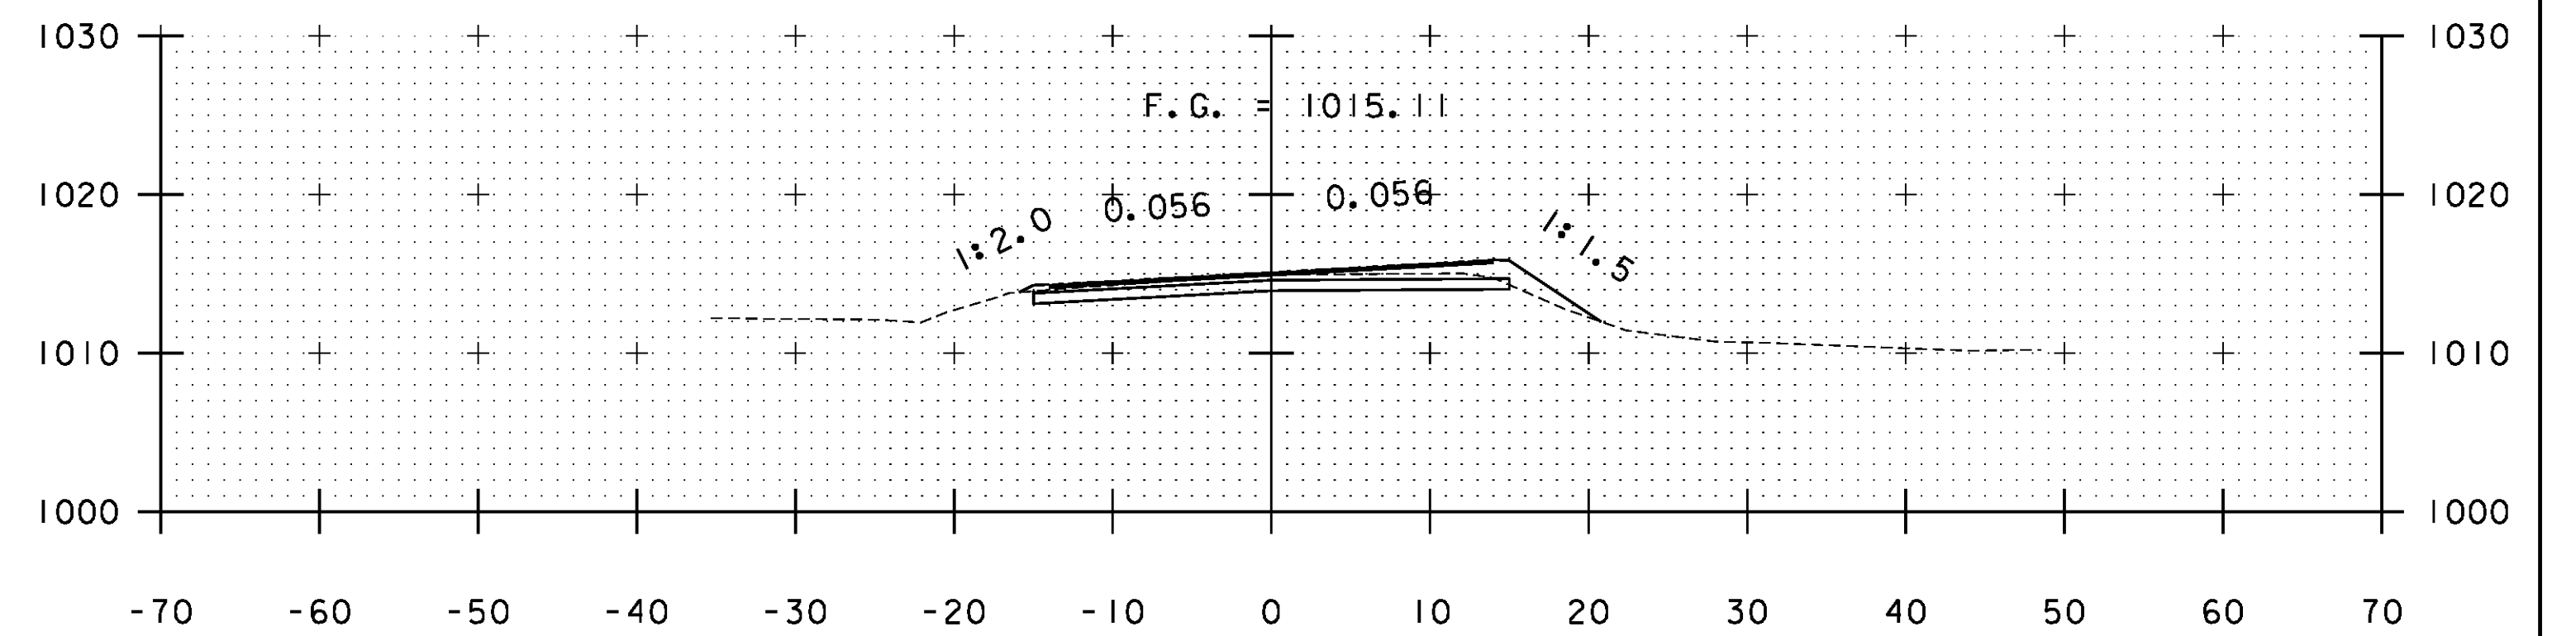

A 332+50

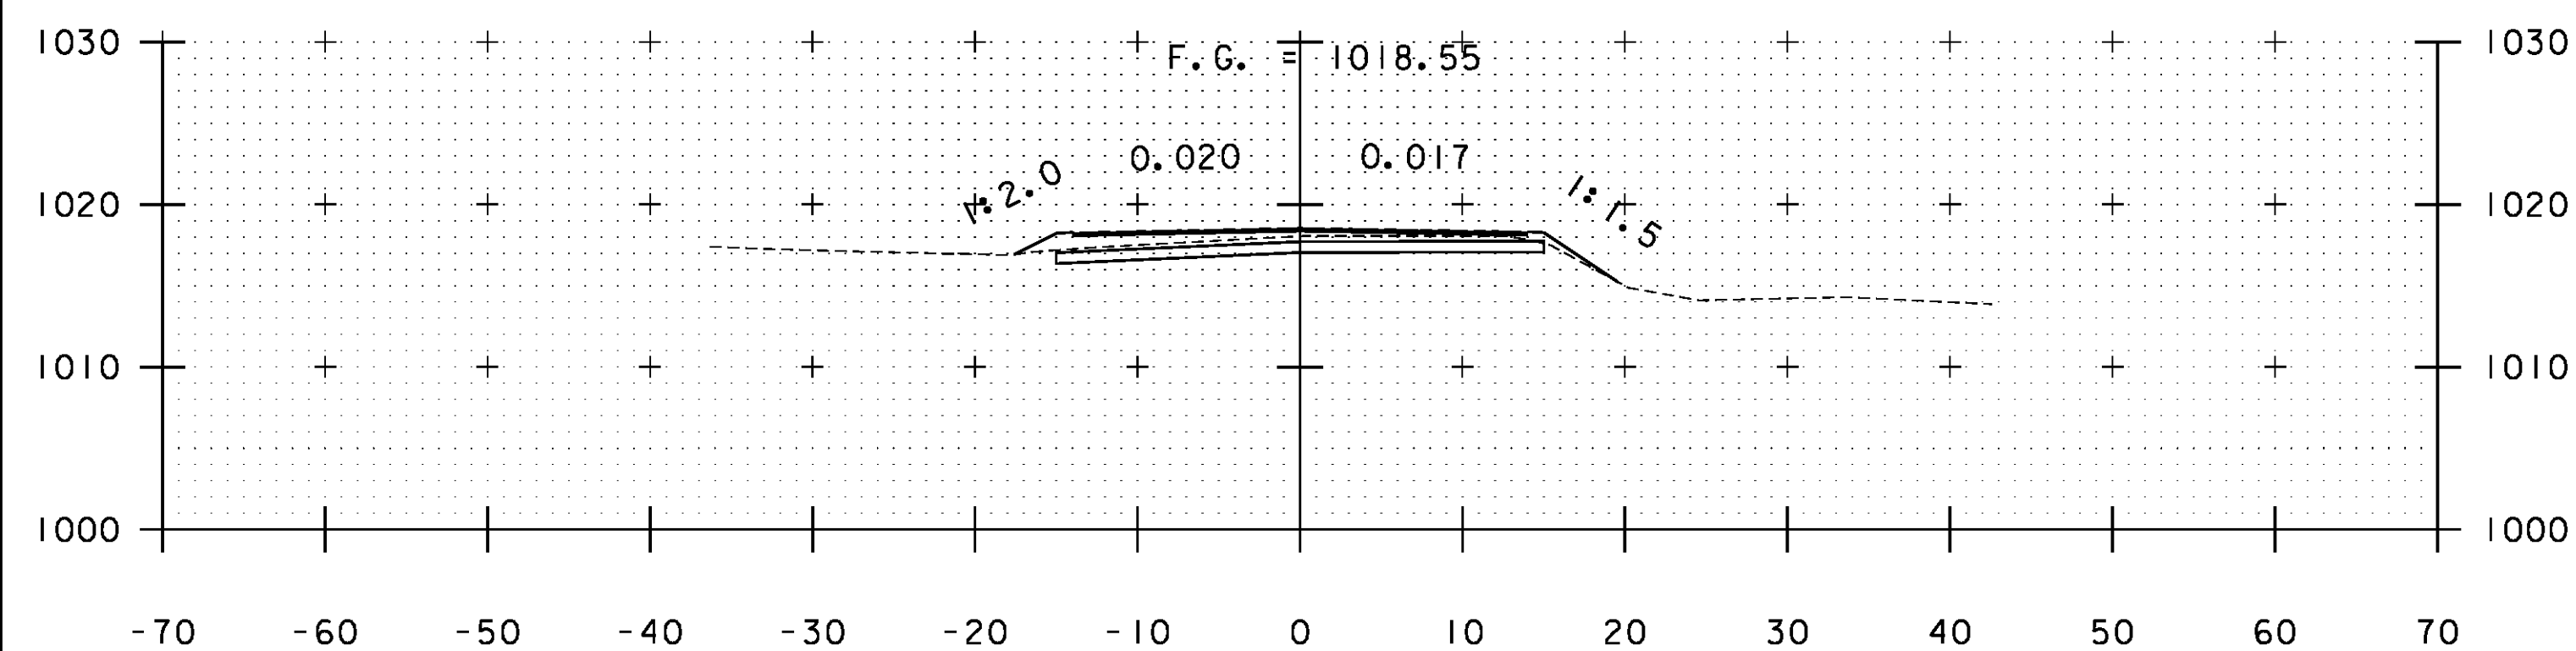

A 330+50

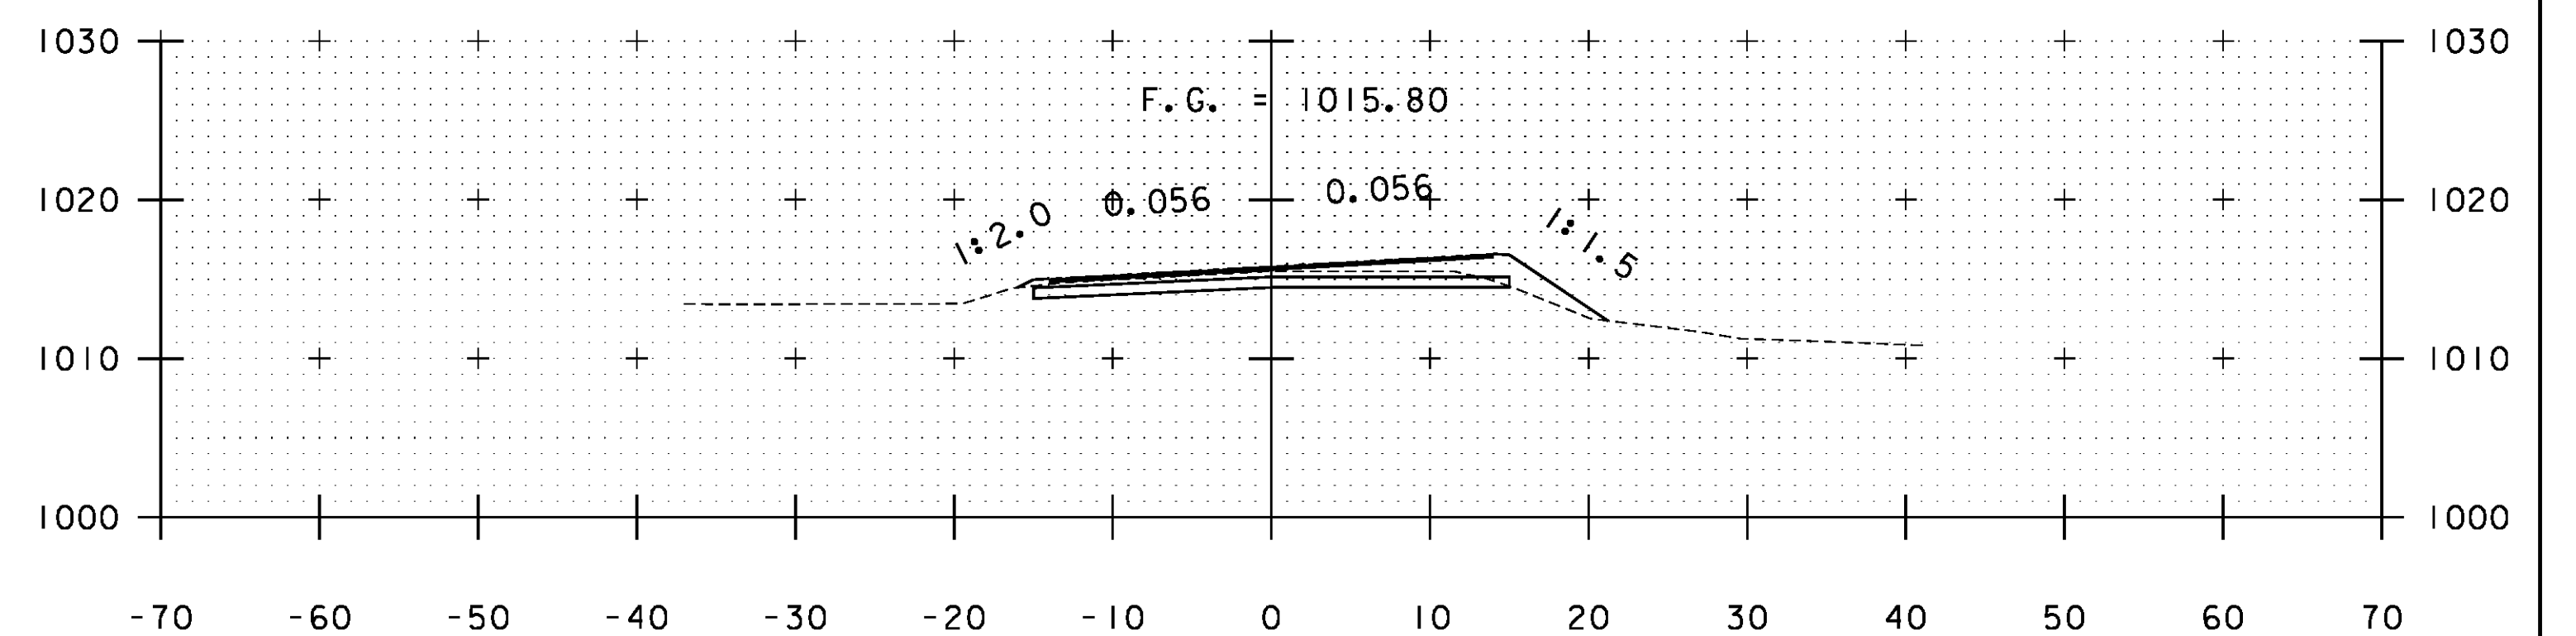

A 332+00

STA. A 330+50 TO STA. A 332+78

PROJECT NAME: WARDBORO-JAMAICA	
PROJECT NUMBER: ER STP 013-1(17)	
FILE NAME: xs.dgn	PLOT DATE: 2/26/2014
PROJECT LEADER: K. UPMAL	DRAWN BY: B. KIPP
DESIGNED BY: B. KIPP	CHECKED BY: HSD
CROSS SECTIONS	SHEET 311 OF 444