




A 368+50

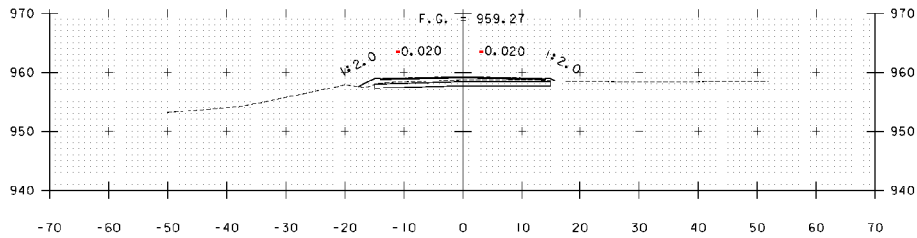


A 368+00

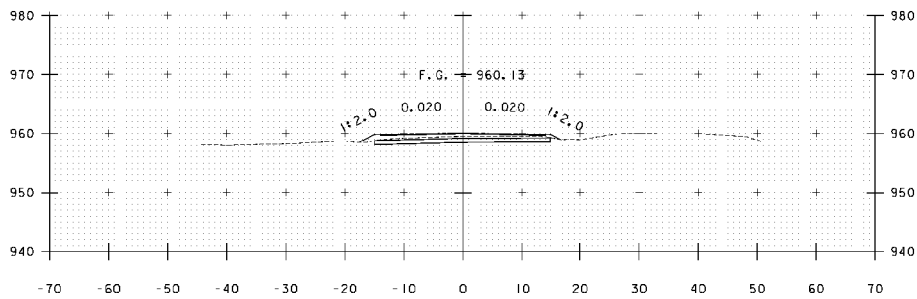


A 367+50

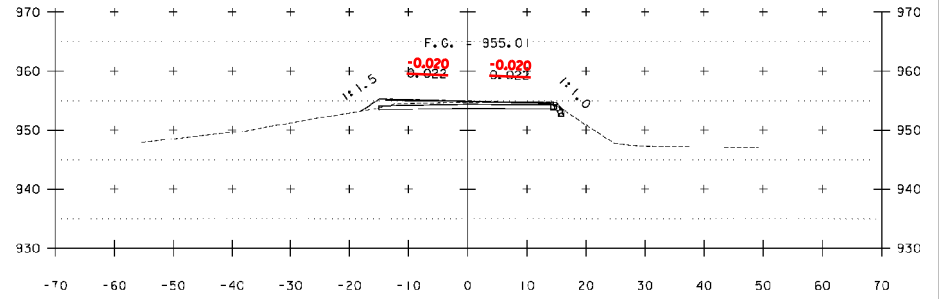

A 370+00

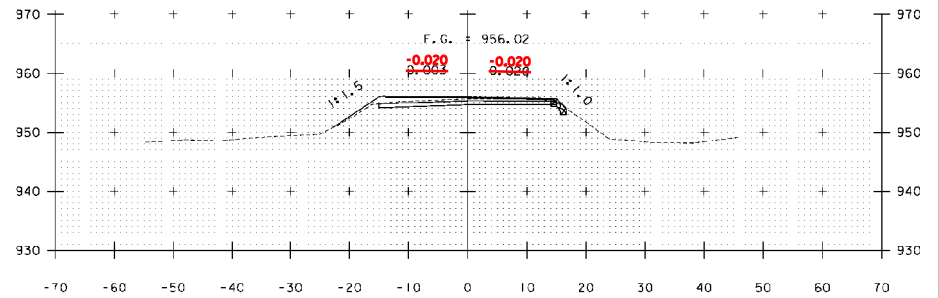

A 369+50

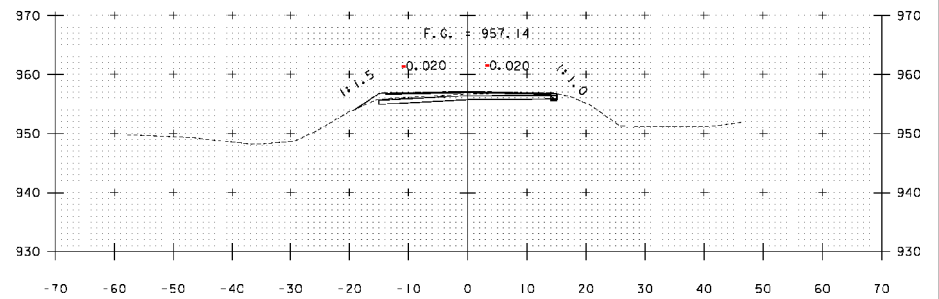

A 369+00

PROJECT NAME:	WARDSBORO-JAMAICA
PROJECT NUMBER:	ER STP 013-1(17)
FILE NAME:	xs.dgn
PROJECT LEADER:	K. UPWAL
DESIGNED BY:	E. KIPP
CHECKED BY:	HSD
CROSS SECTIONS	
PLLOT DATE:	2/26/2014
DRAWN BY:	B. KIPP
CHECKED BY:	HSD
SHEET	315 OF 444

STA. A 367+50 TO STA. A 370+00