




A 370+68

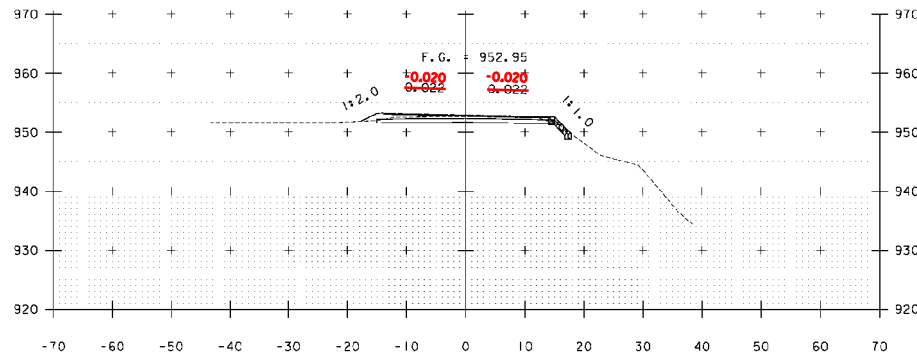

A 371+50

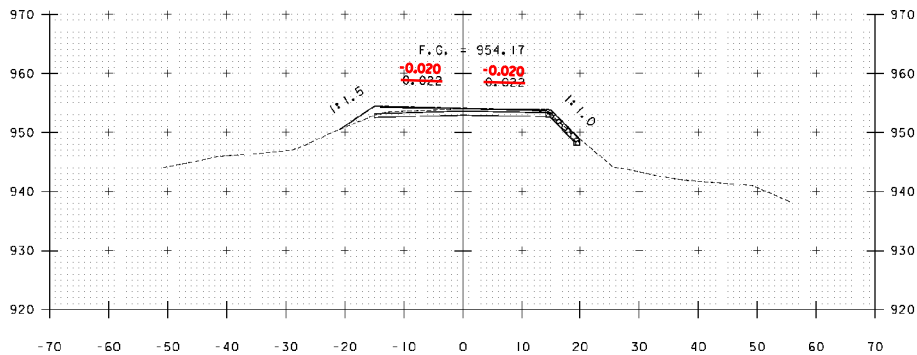

A 370+50

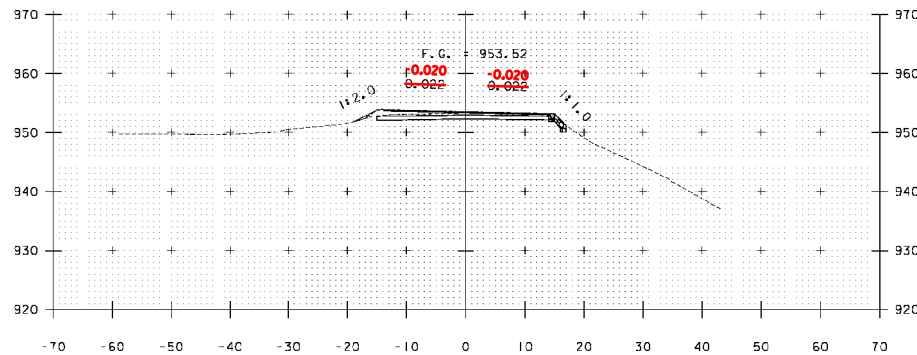

A 371+00

PROJECT NAME:	WARDSBORO-JAMAICA
PROJECT NUMBER:	ER STP 013-1(17)
FILE NAME:	xs.dgn
PROJECT LEADER:	K. LPMAL
DESIGNED BY:	E. KJPP
CHECKED BY:	HSD
CROSS SECTIONS	
PLOT DATE:	2/26/2014
DRAWN BY:	B. KPP
CHECKED BY:	HSD
SHEET	316 OF 444

STA. A 370+50 TO STA. A 371+50